
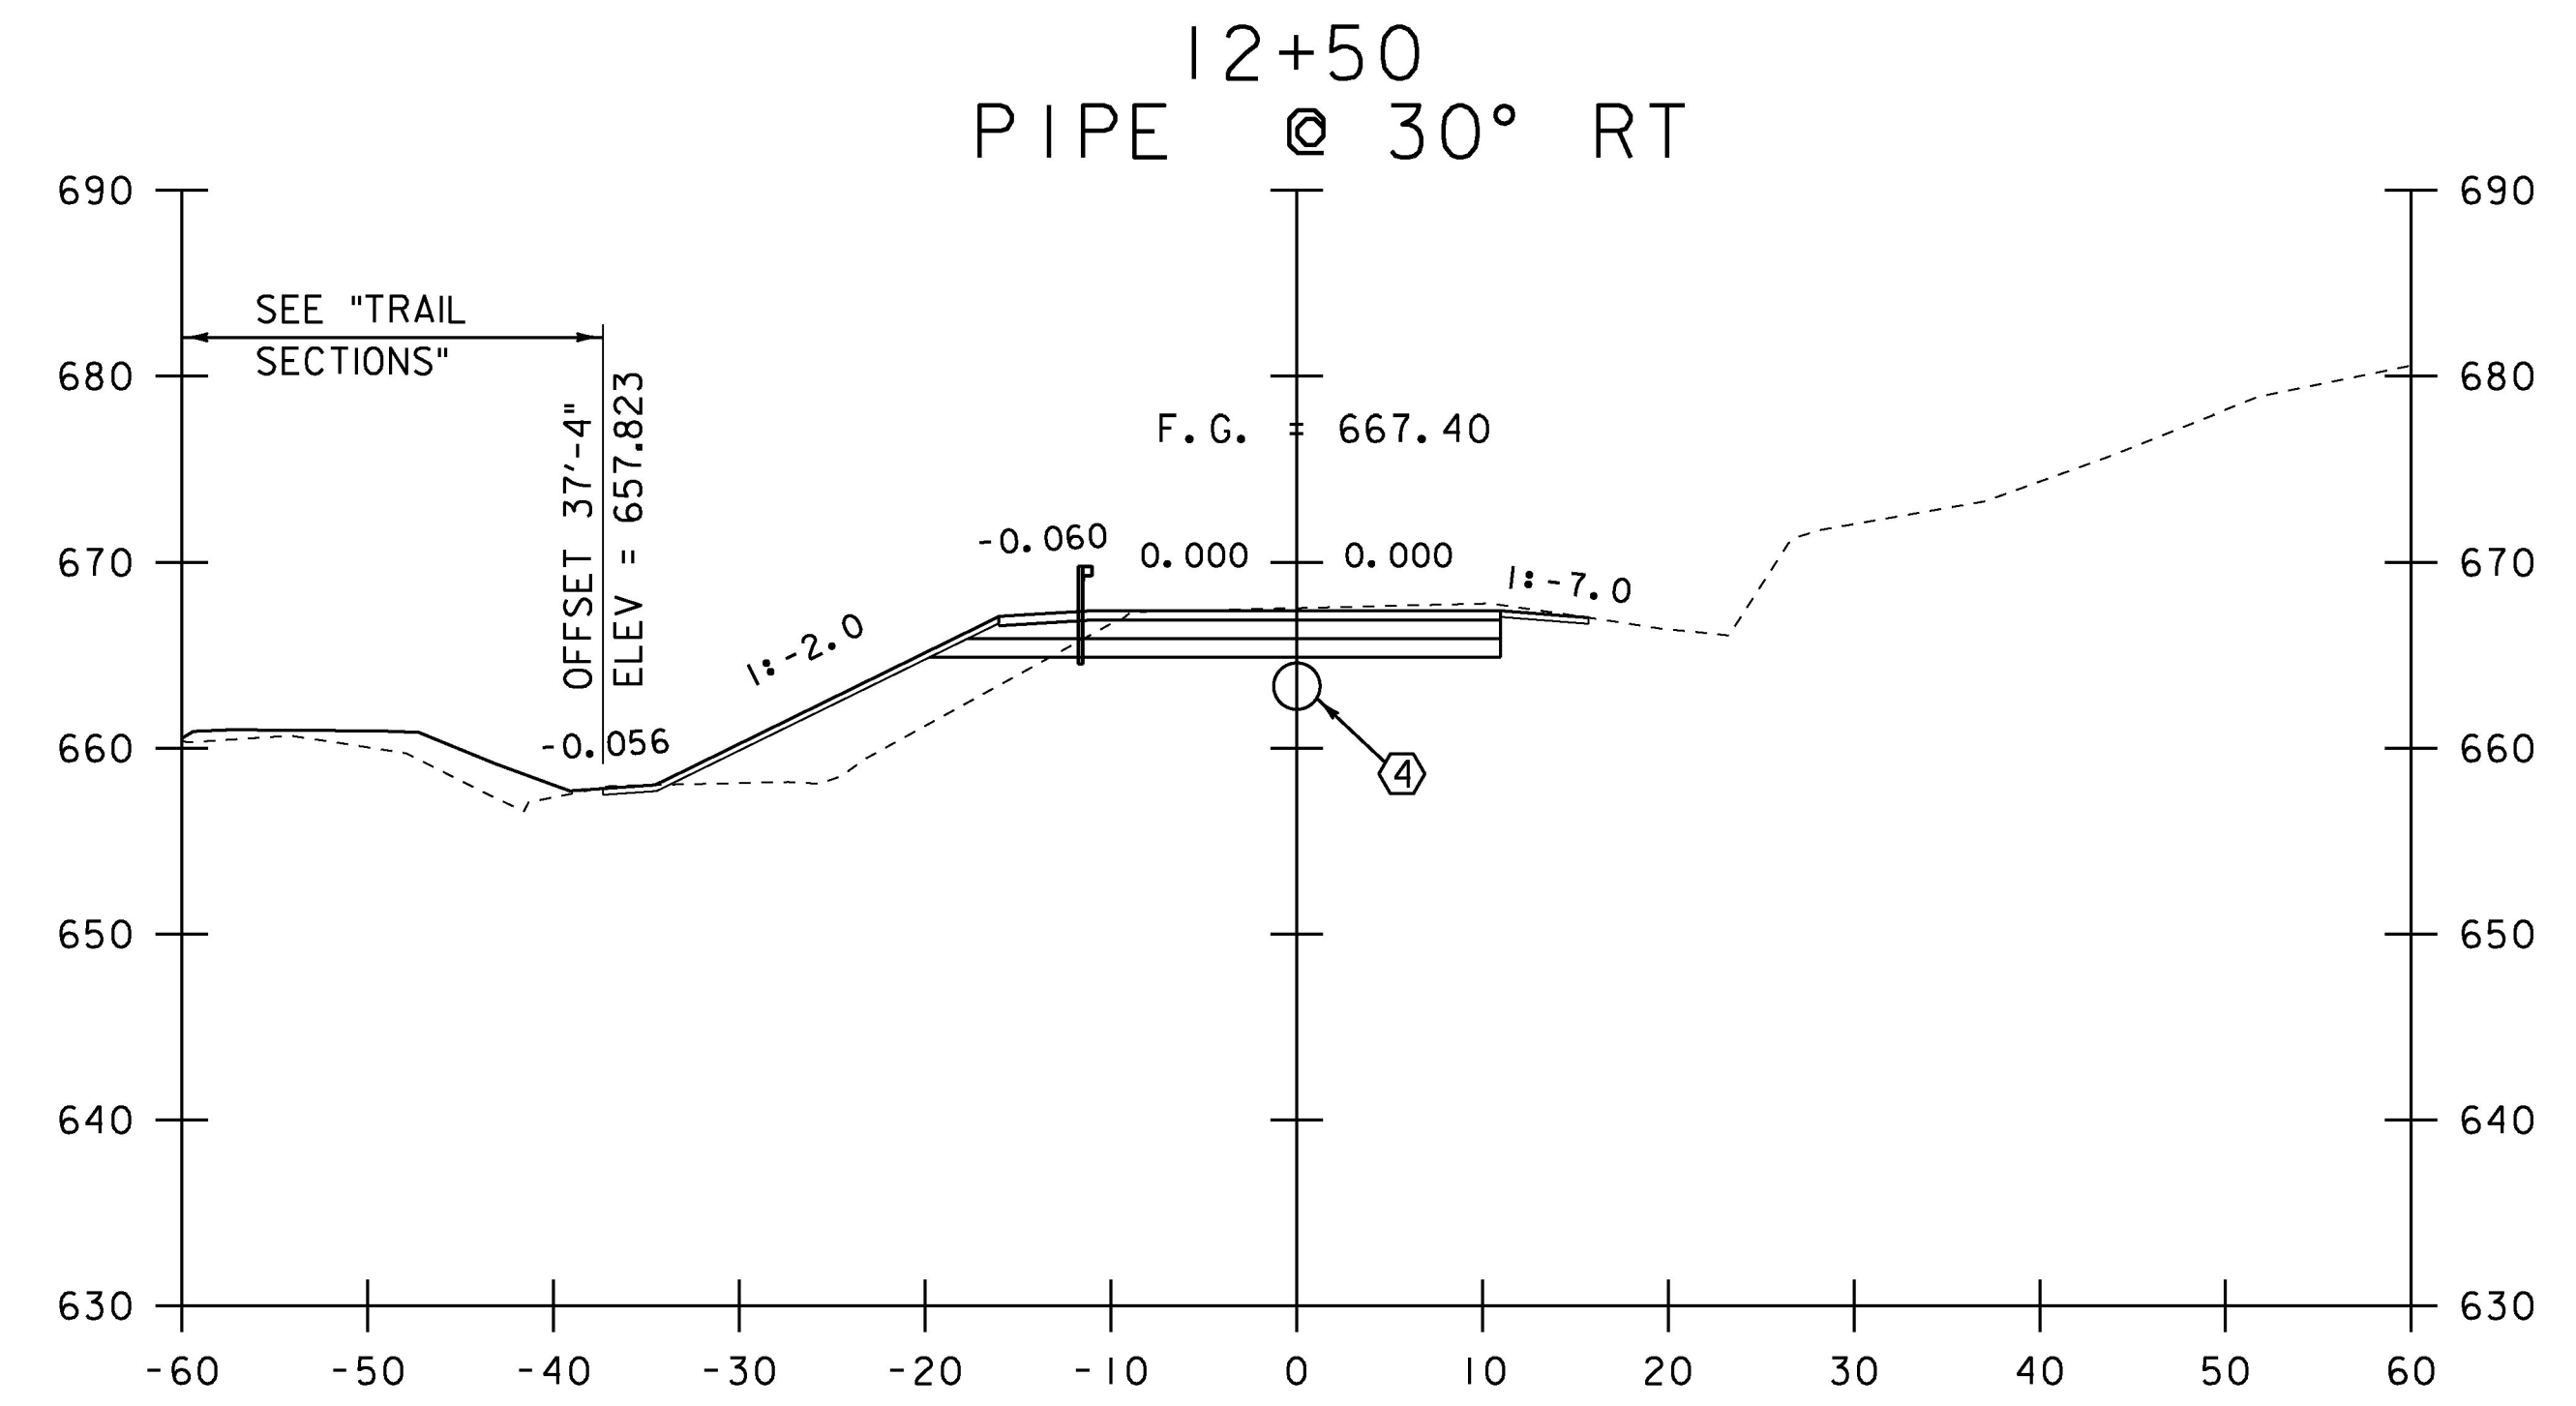
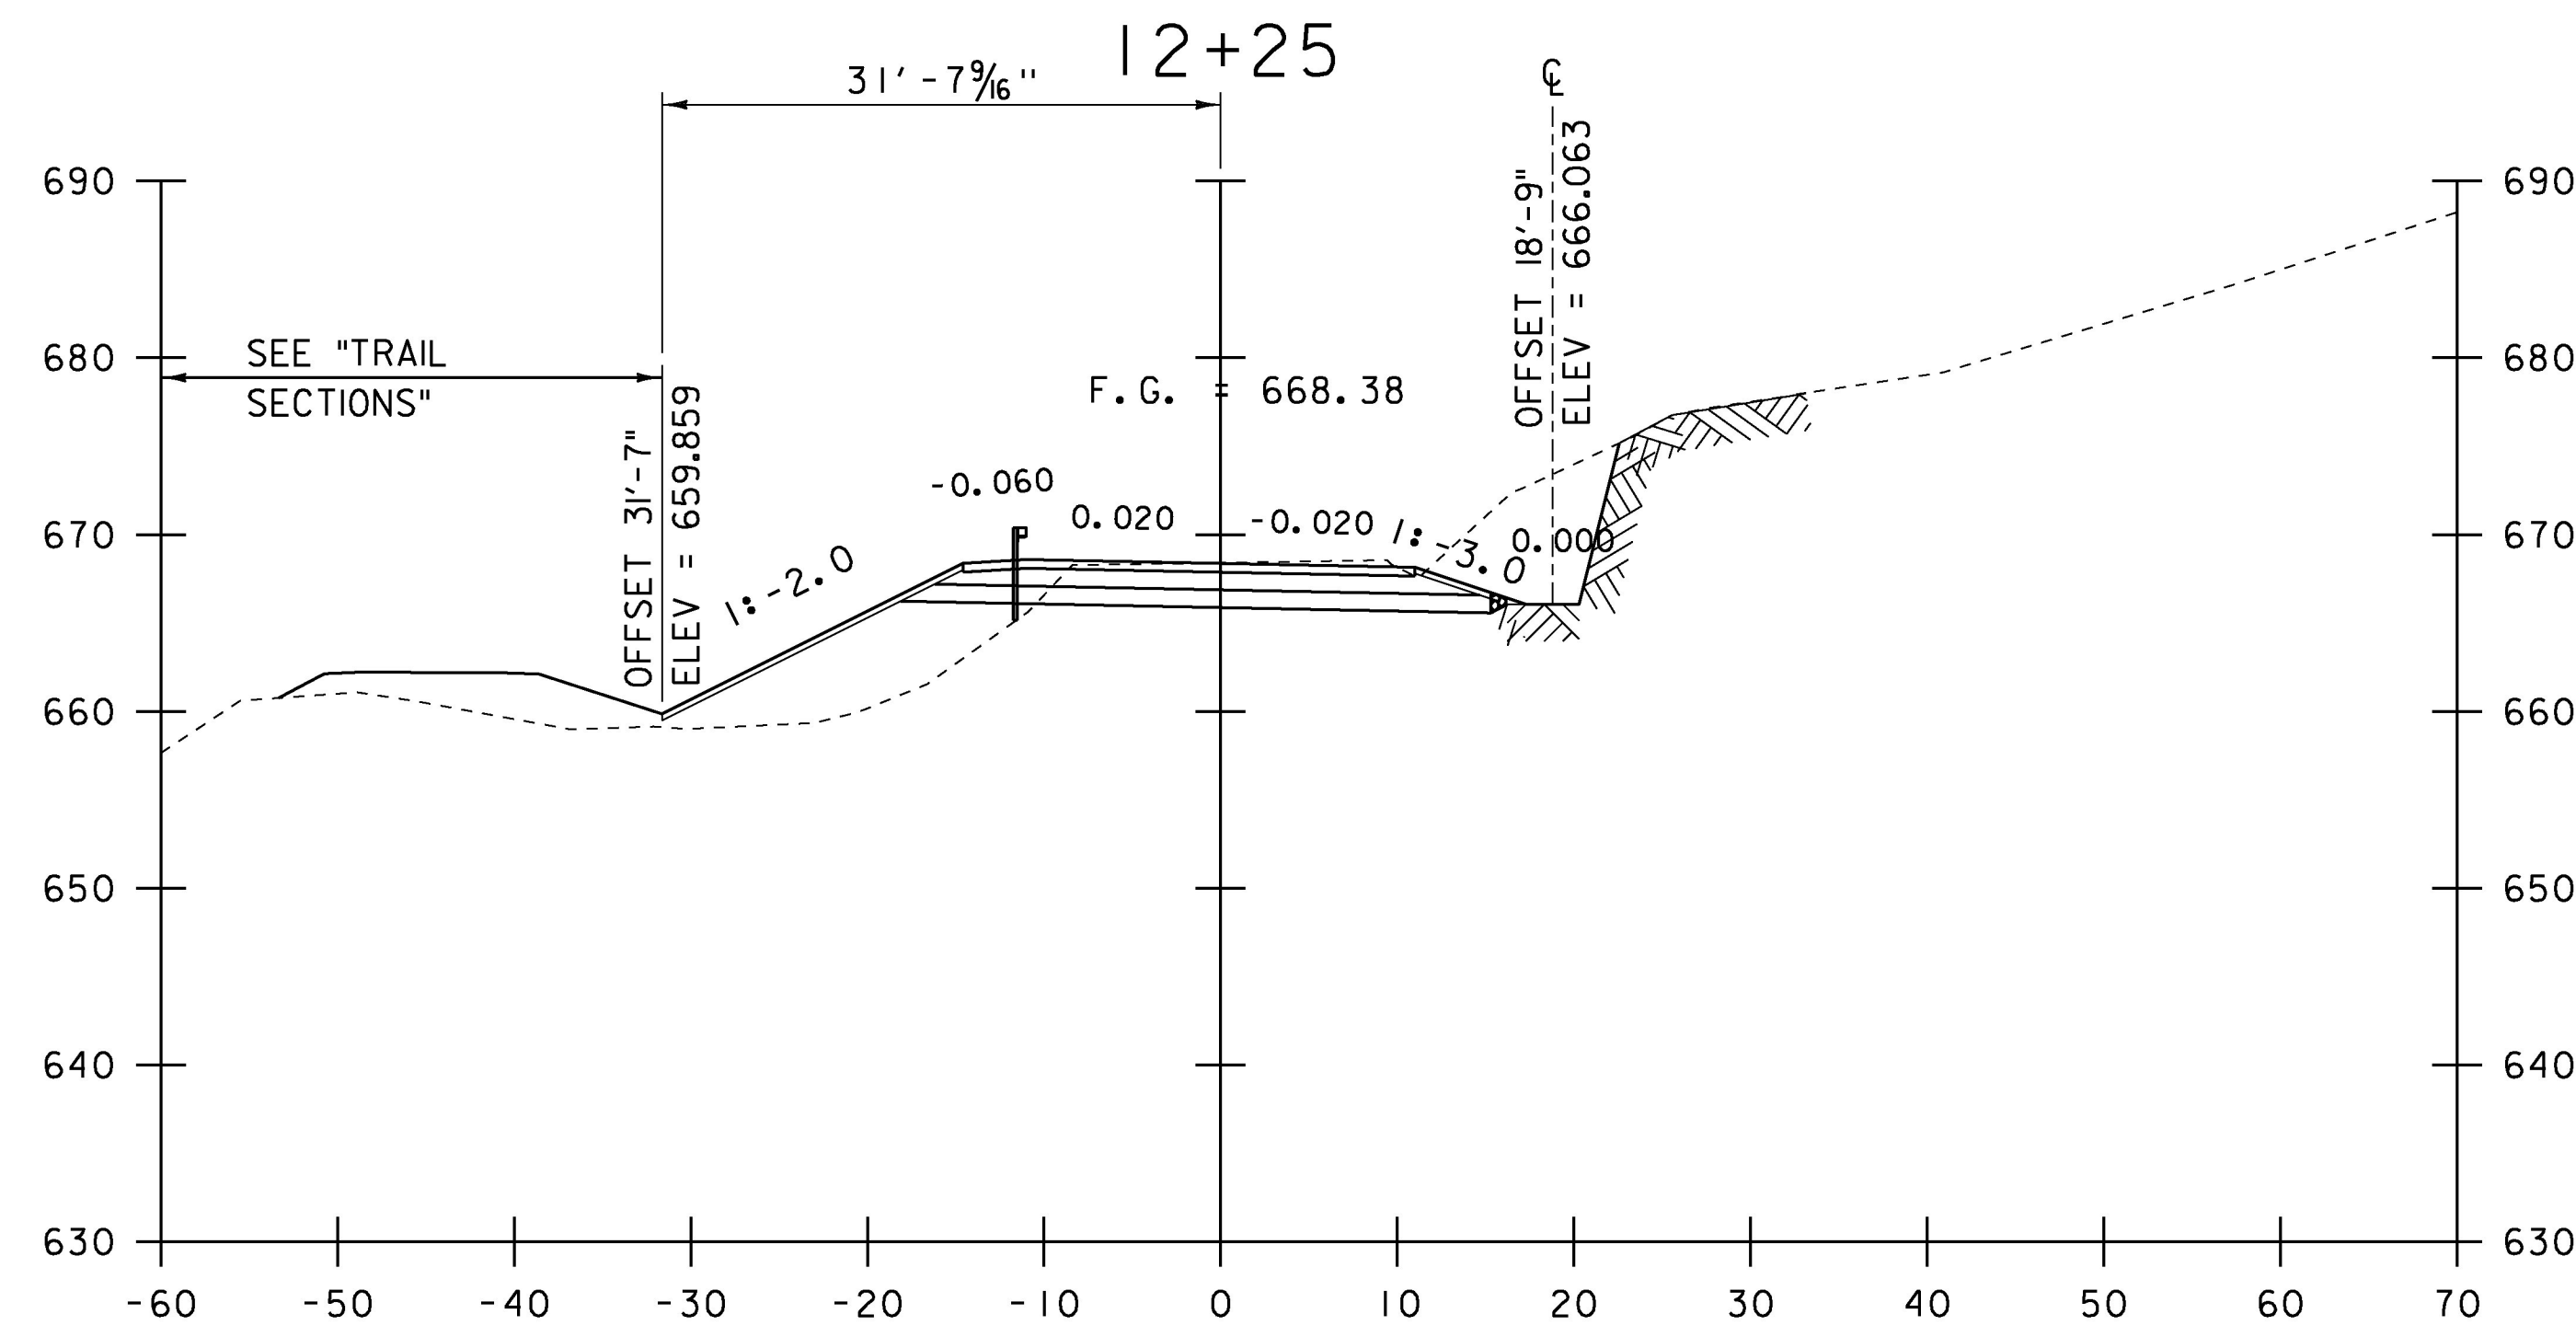
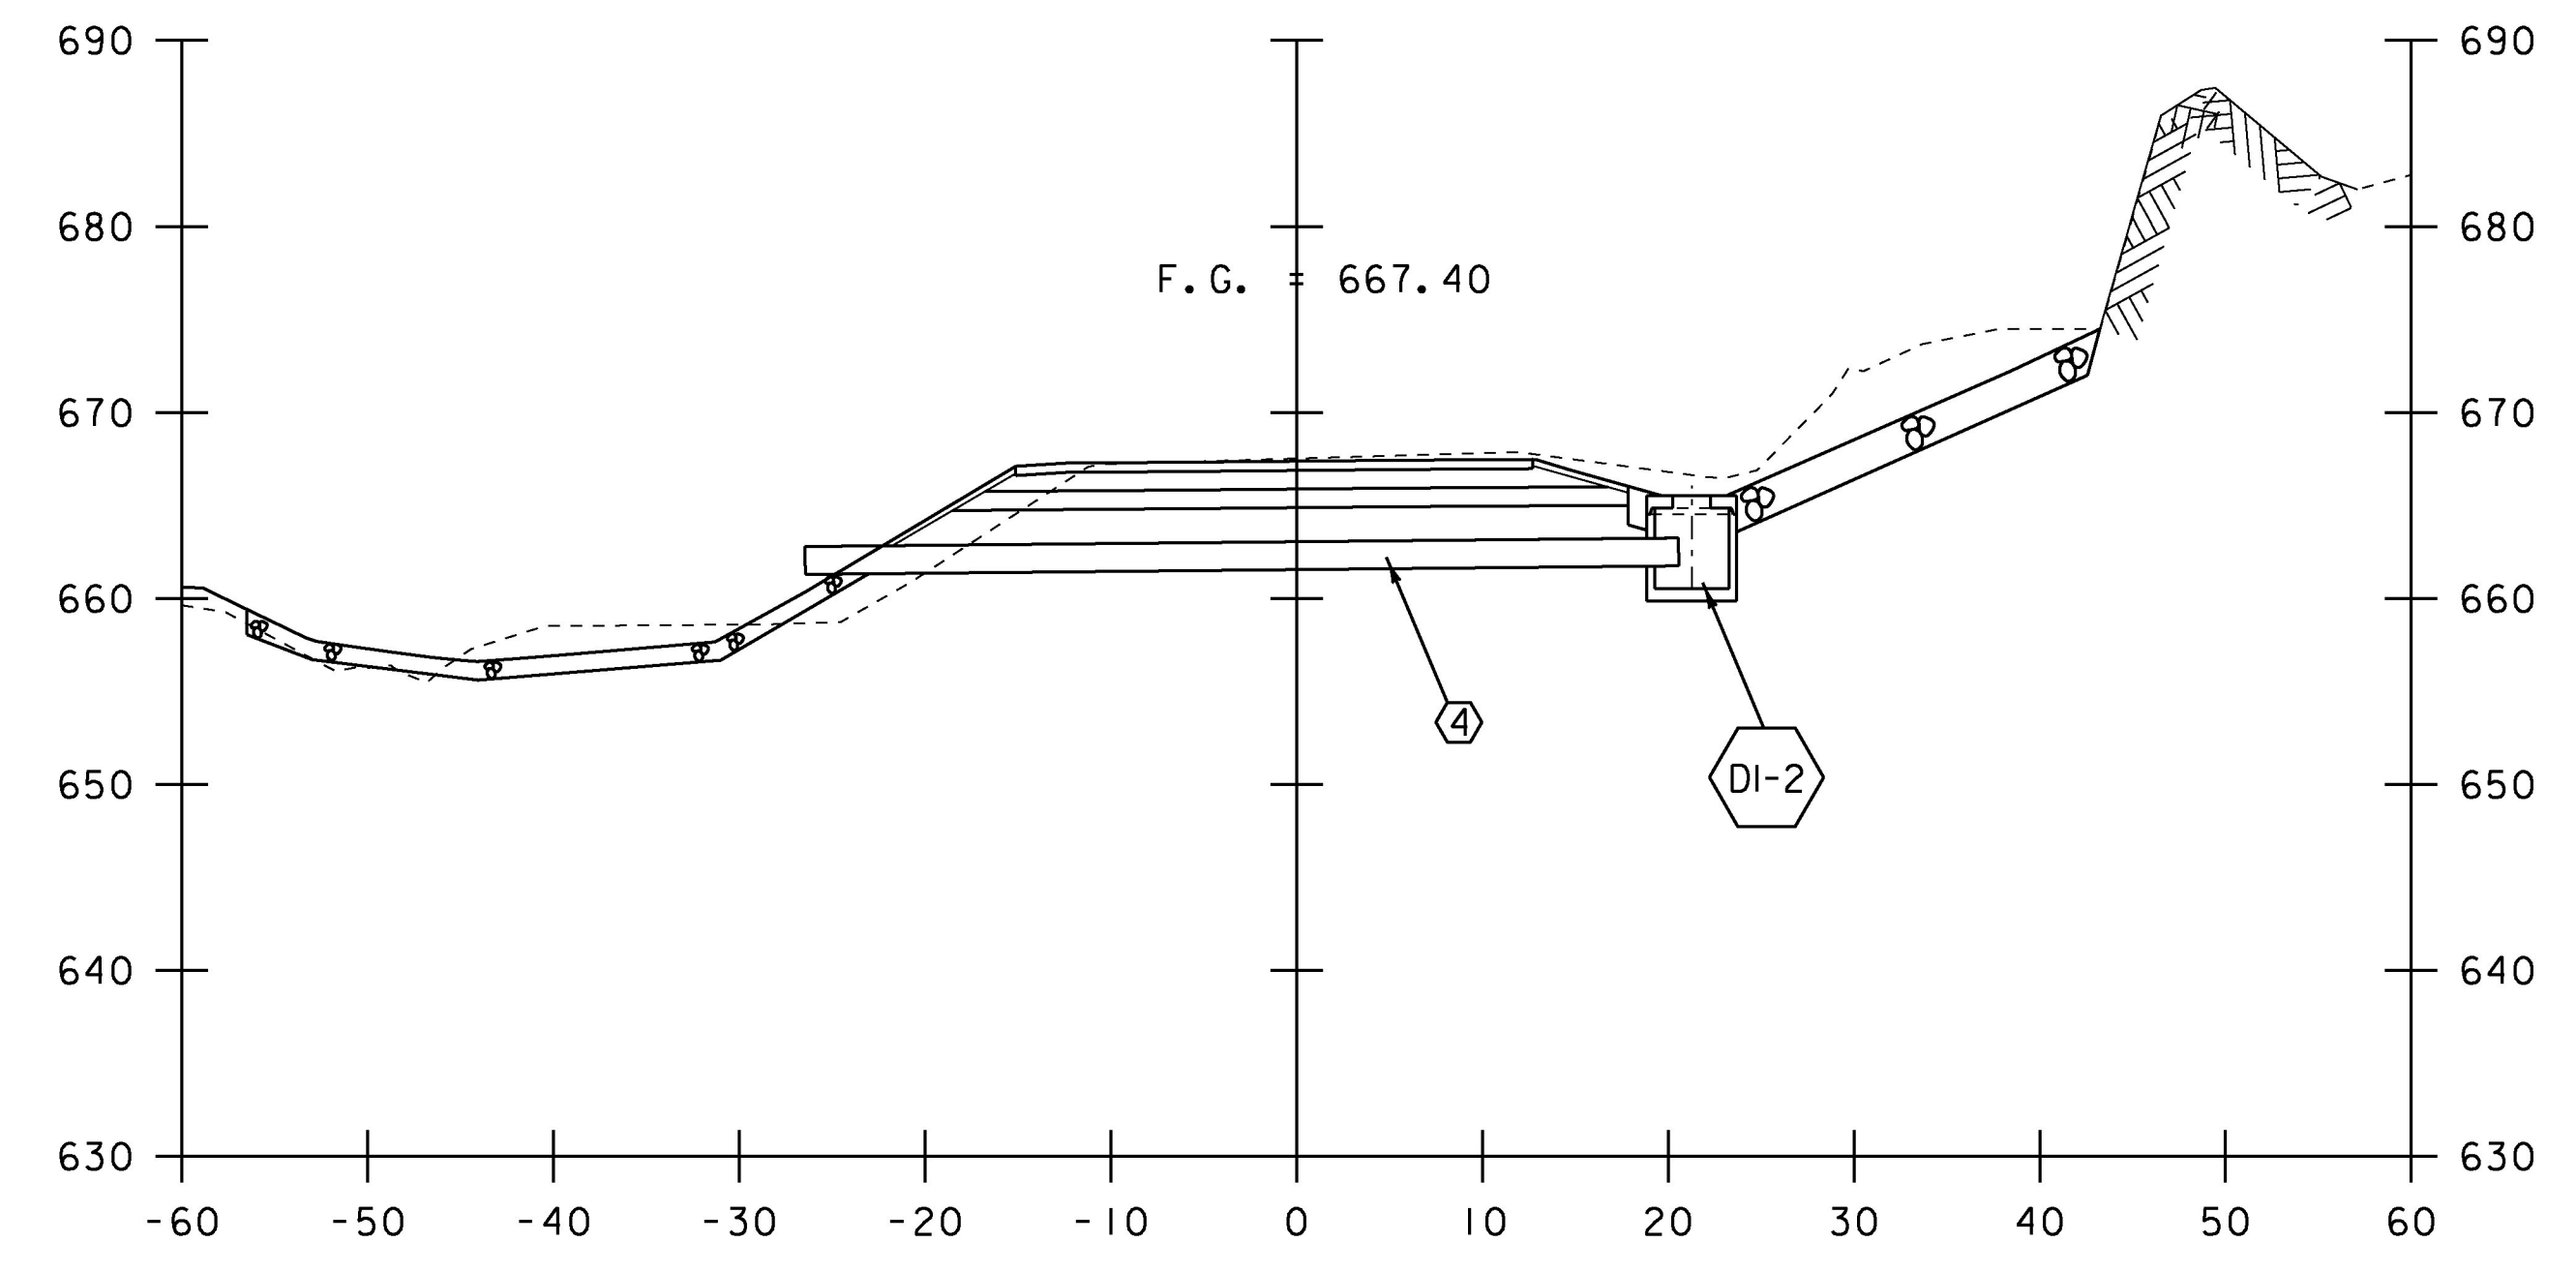


- DI-2 NEW 48 INCH DIA. PRECAST REINFORCED CONCRETE DROP INLET SEE "TH-22 AND TRAIL DRAINAGE PROFILE" ON THE "DRAINAGE SYSTEMS PROFILES" SHEET
- ④ 18" PIPE SEE "TH-22 AND TRAIL DRAINAGE PROFILE" ON THE "DRAINAGE SYSTEMS PROFILES" SHEET

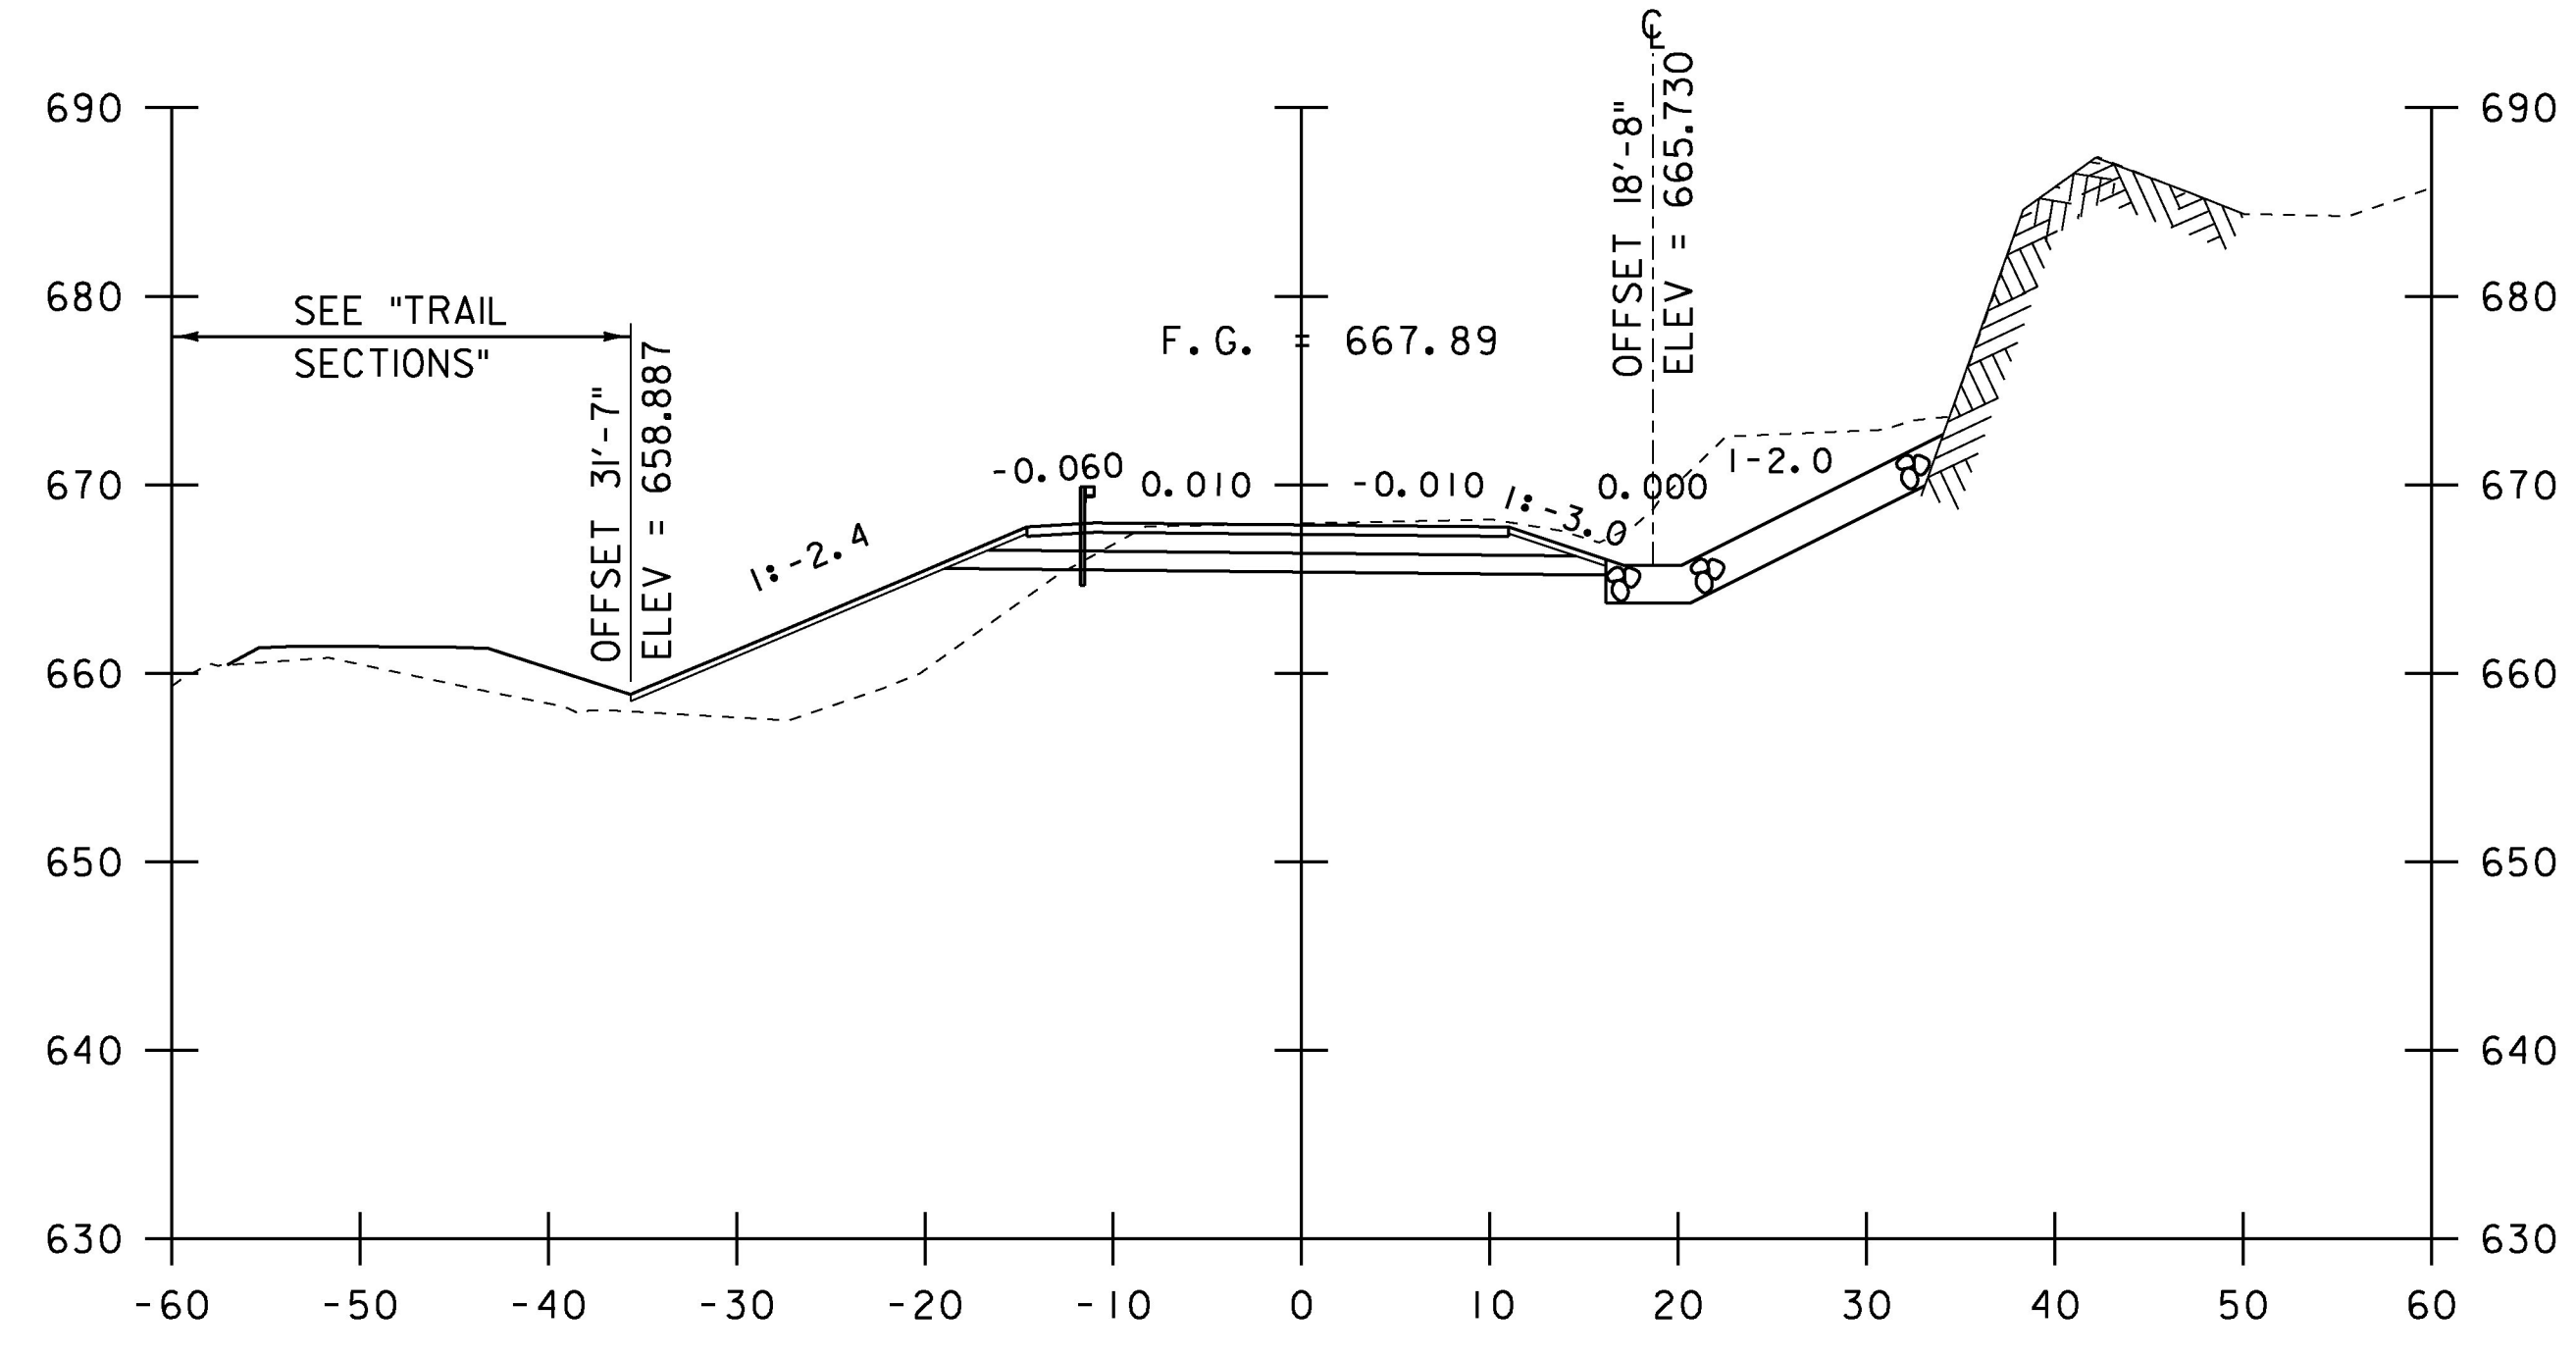

12+00

12+50

STA. 12+00 TO STA. 12+50

PROJECT NAME:	MORRISTOWN
PROJECT NUMBER:	BRS 0240(3)S/STP HES 030-2(28)
FILE NAME:	s78f329xs.dgn
PROJECT LEADER:	C. CARLSON
DESIGNED BY:	C. BURRALL
TH 22 SECTIONS SHEET 3	
PLOT DATE:	12-APR-2017
DRAWN BY:	G. ROKES
CHECKED BY:	J. LACROIX
SHEET	124 OF 175