




58+00

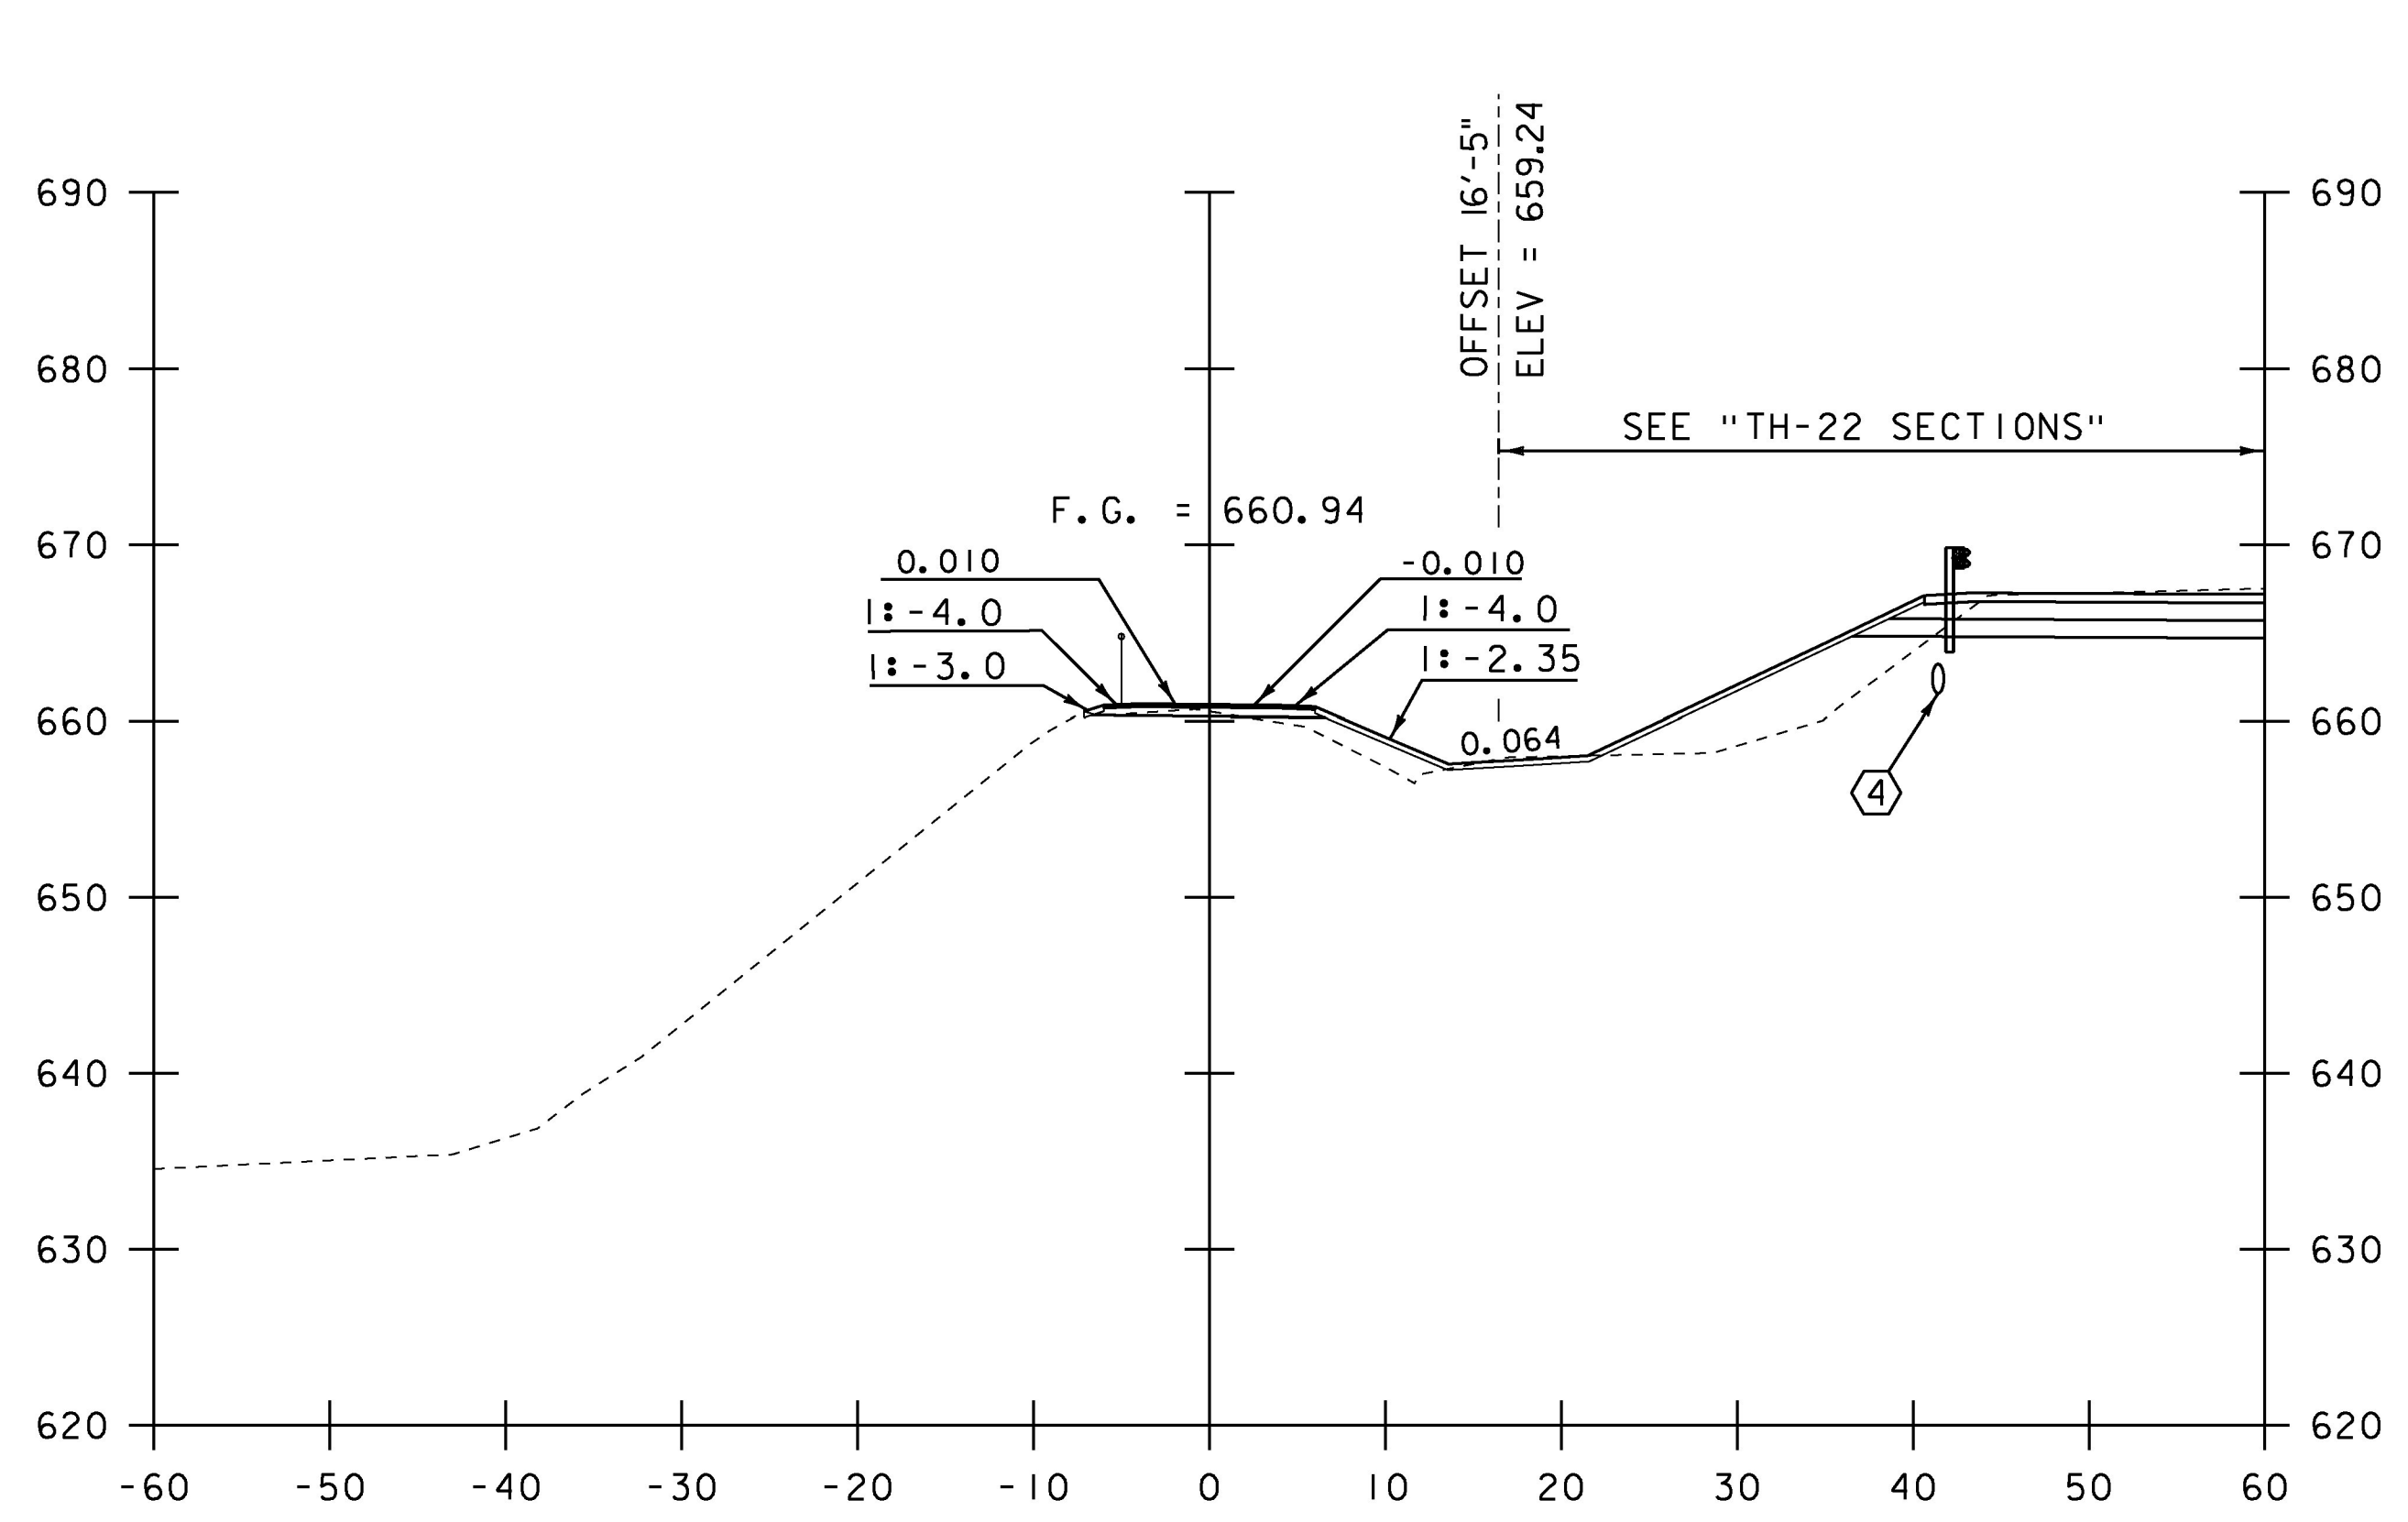

58+89

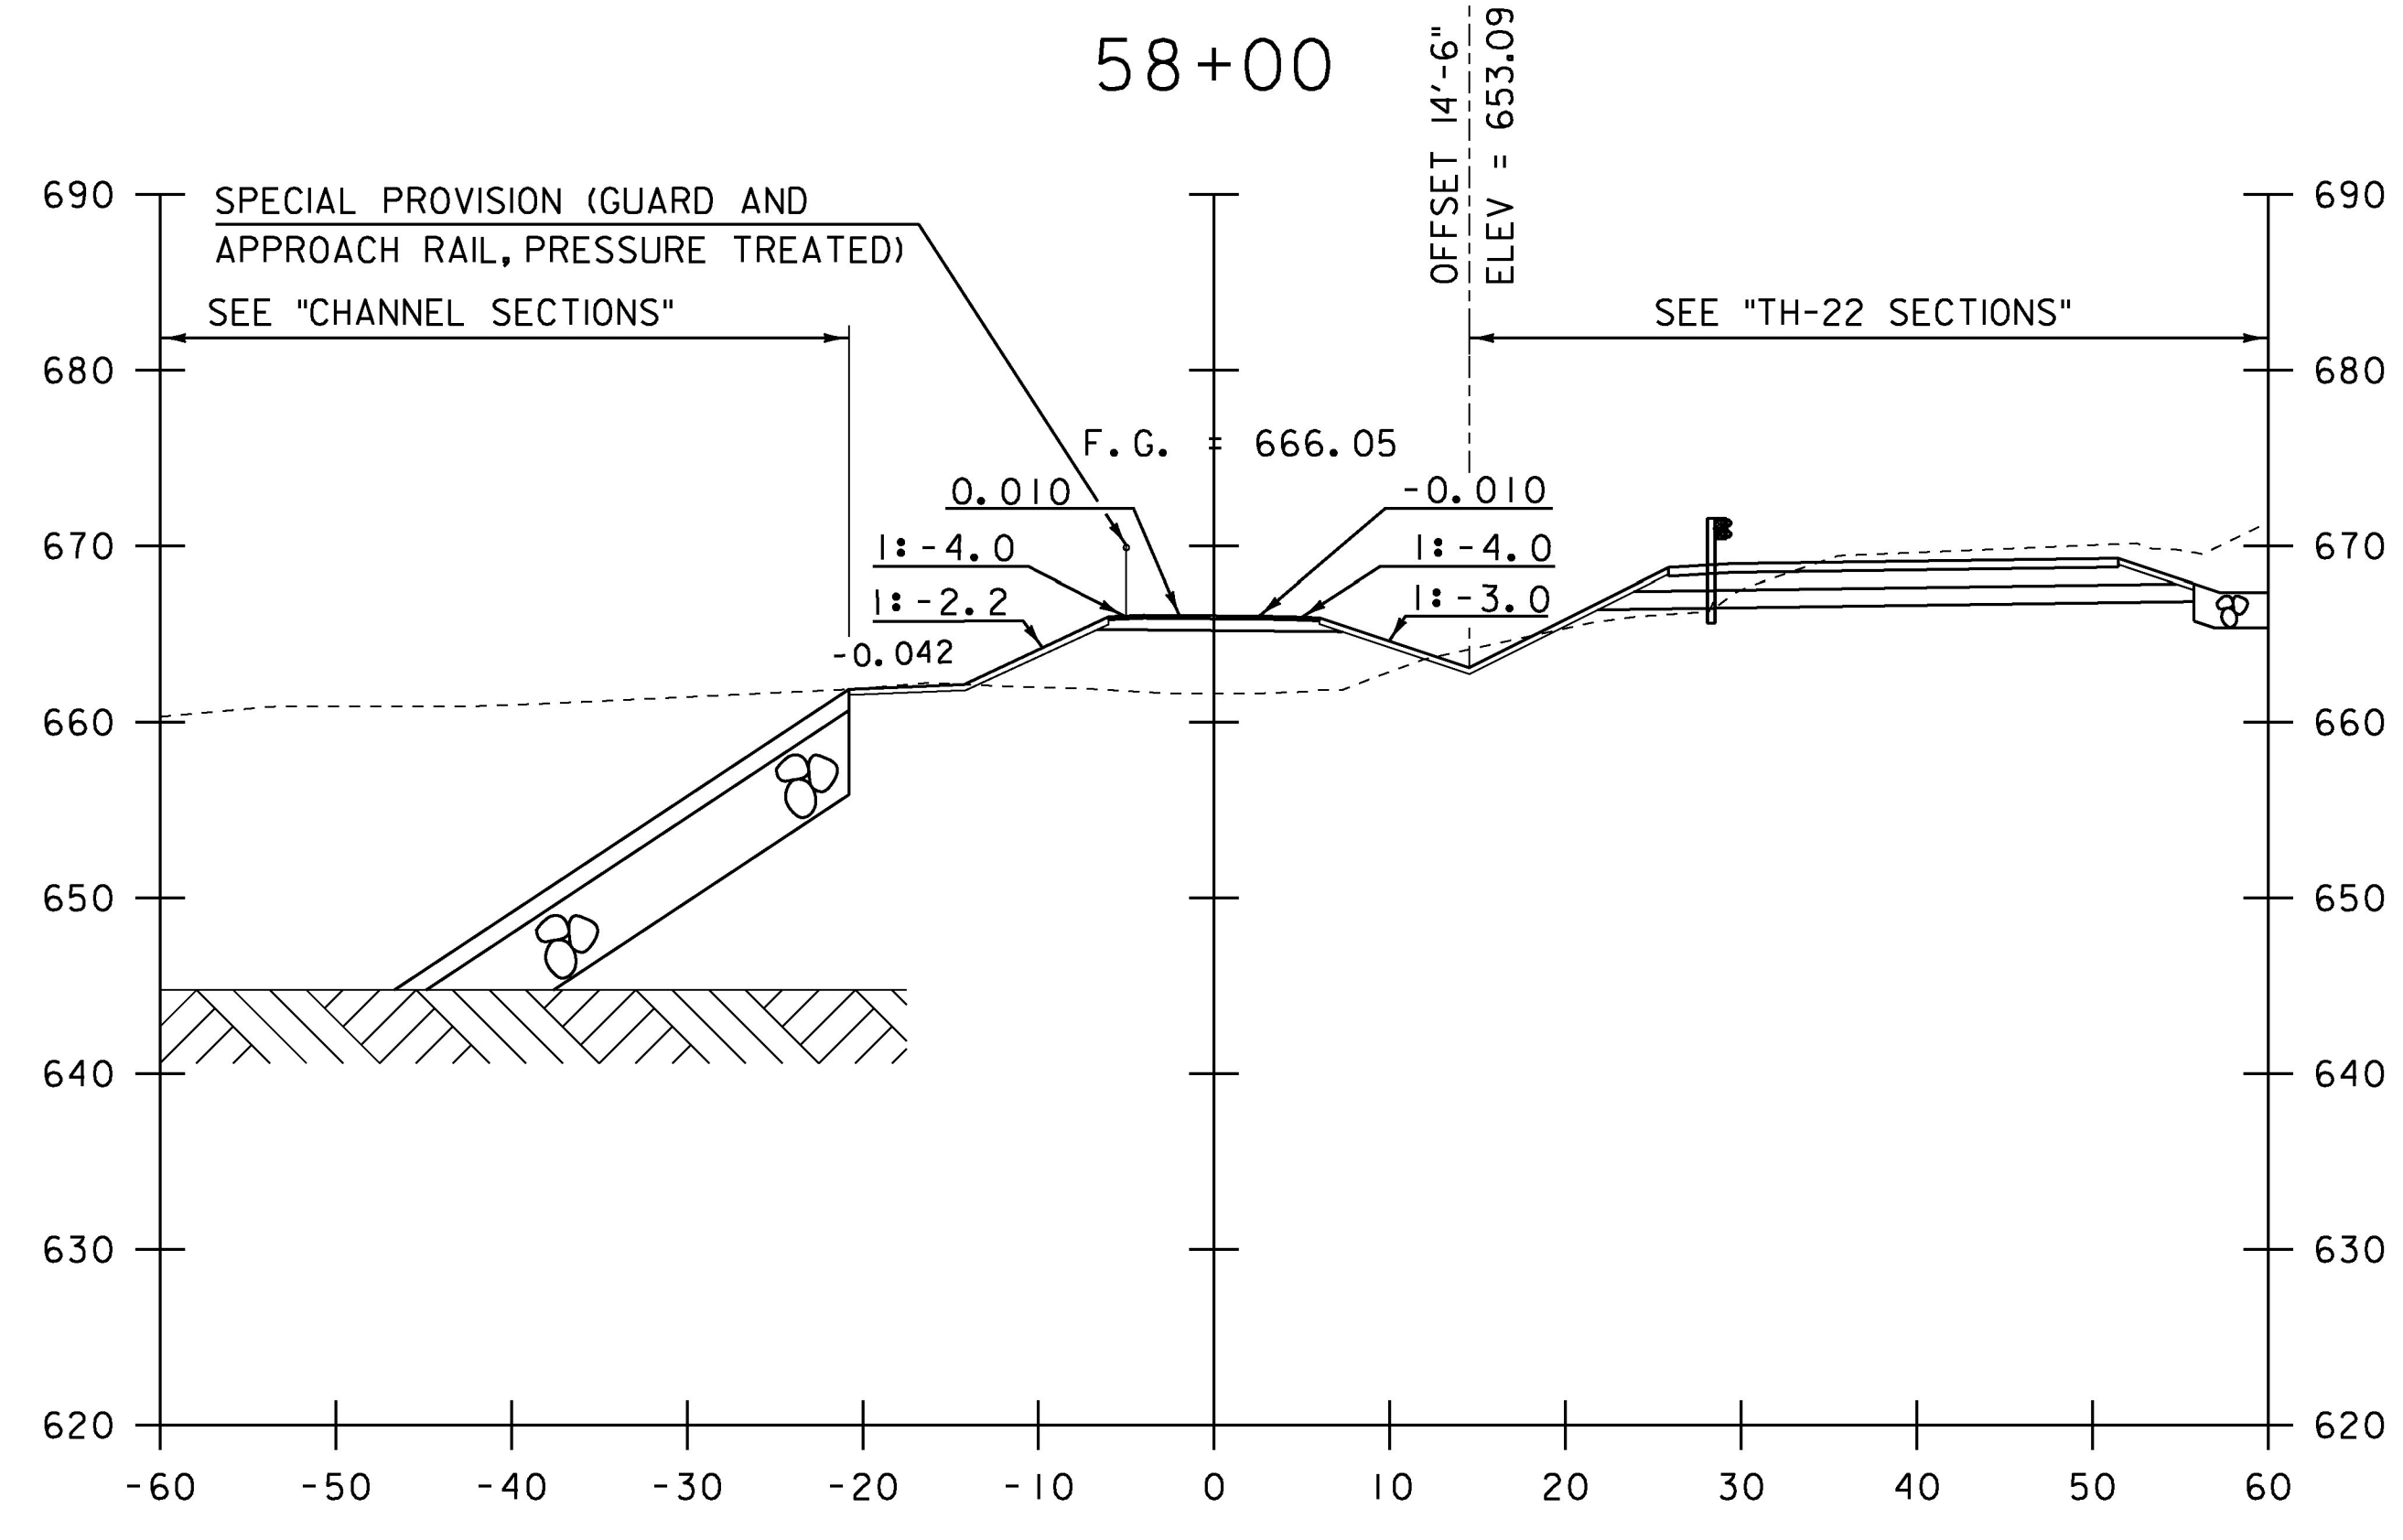

57+50

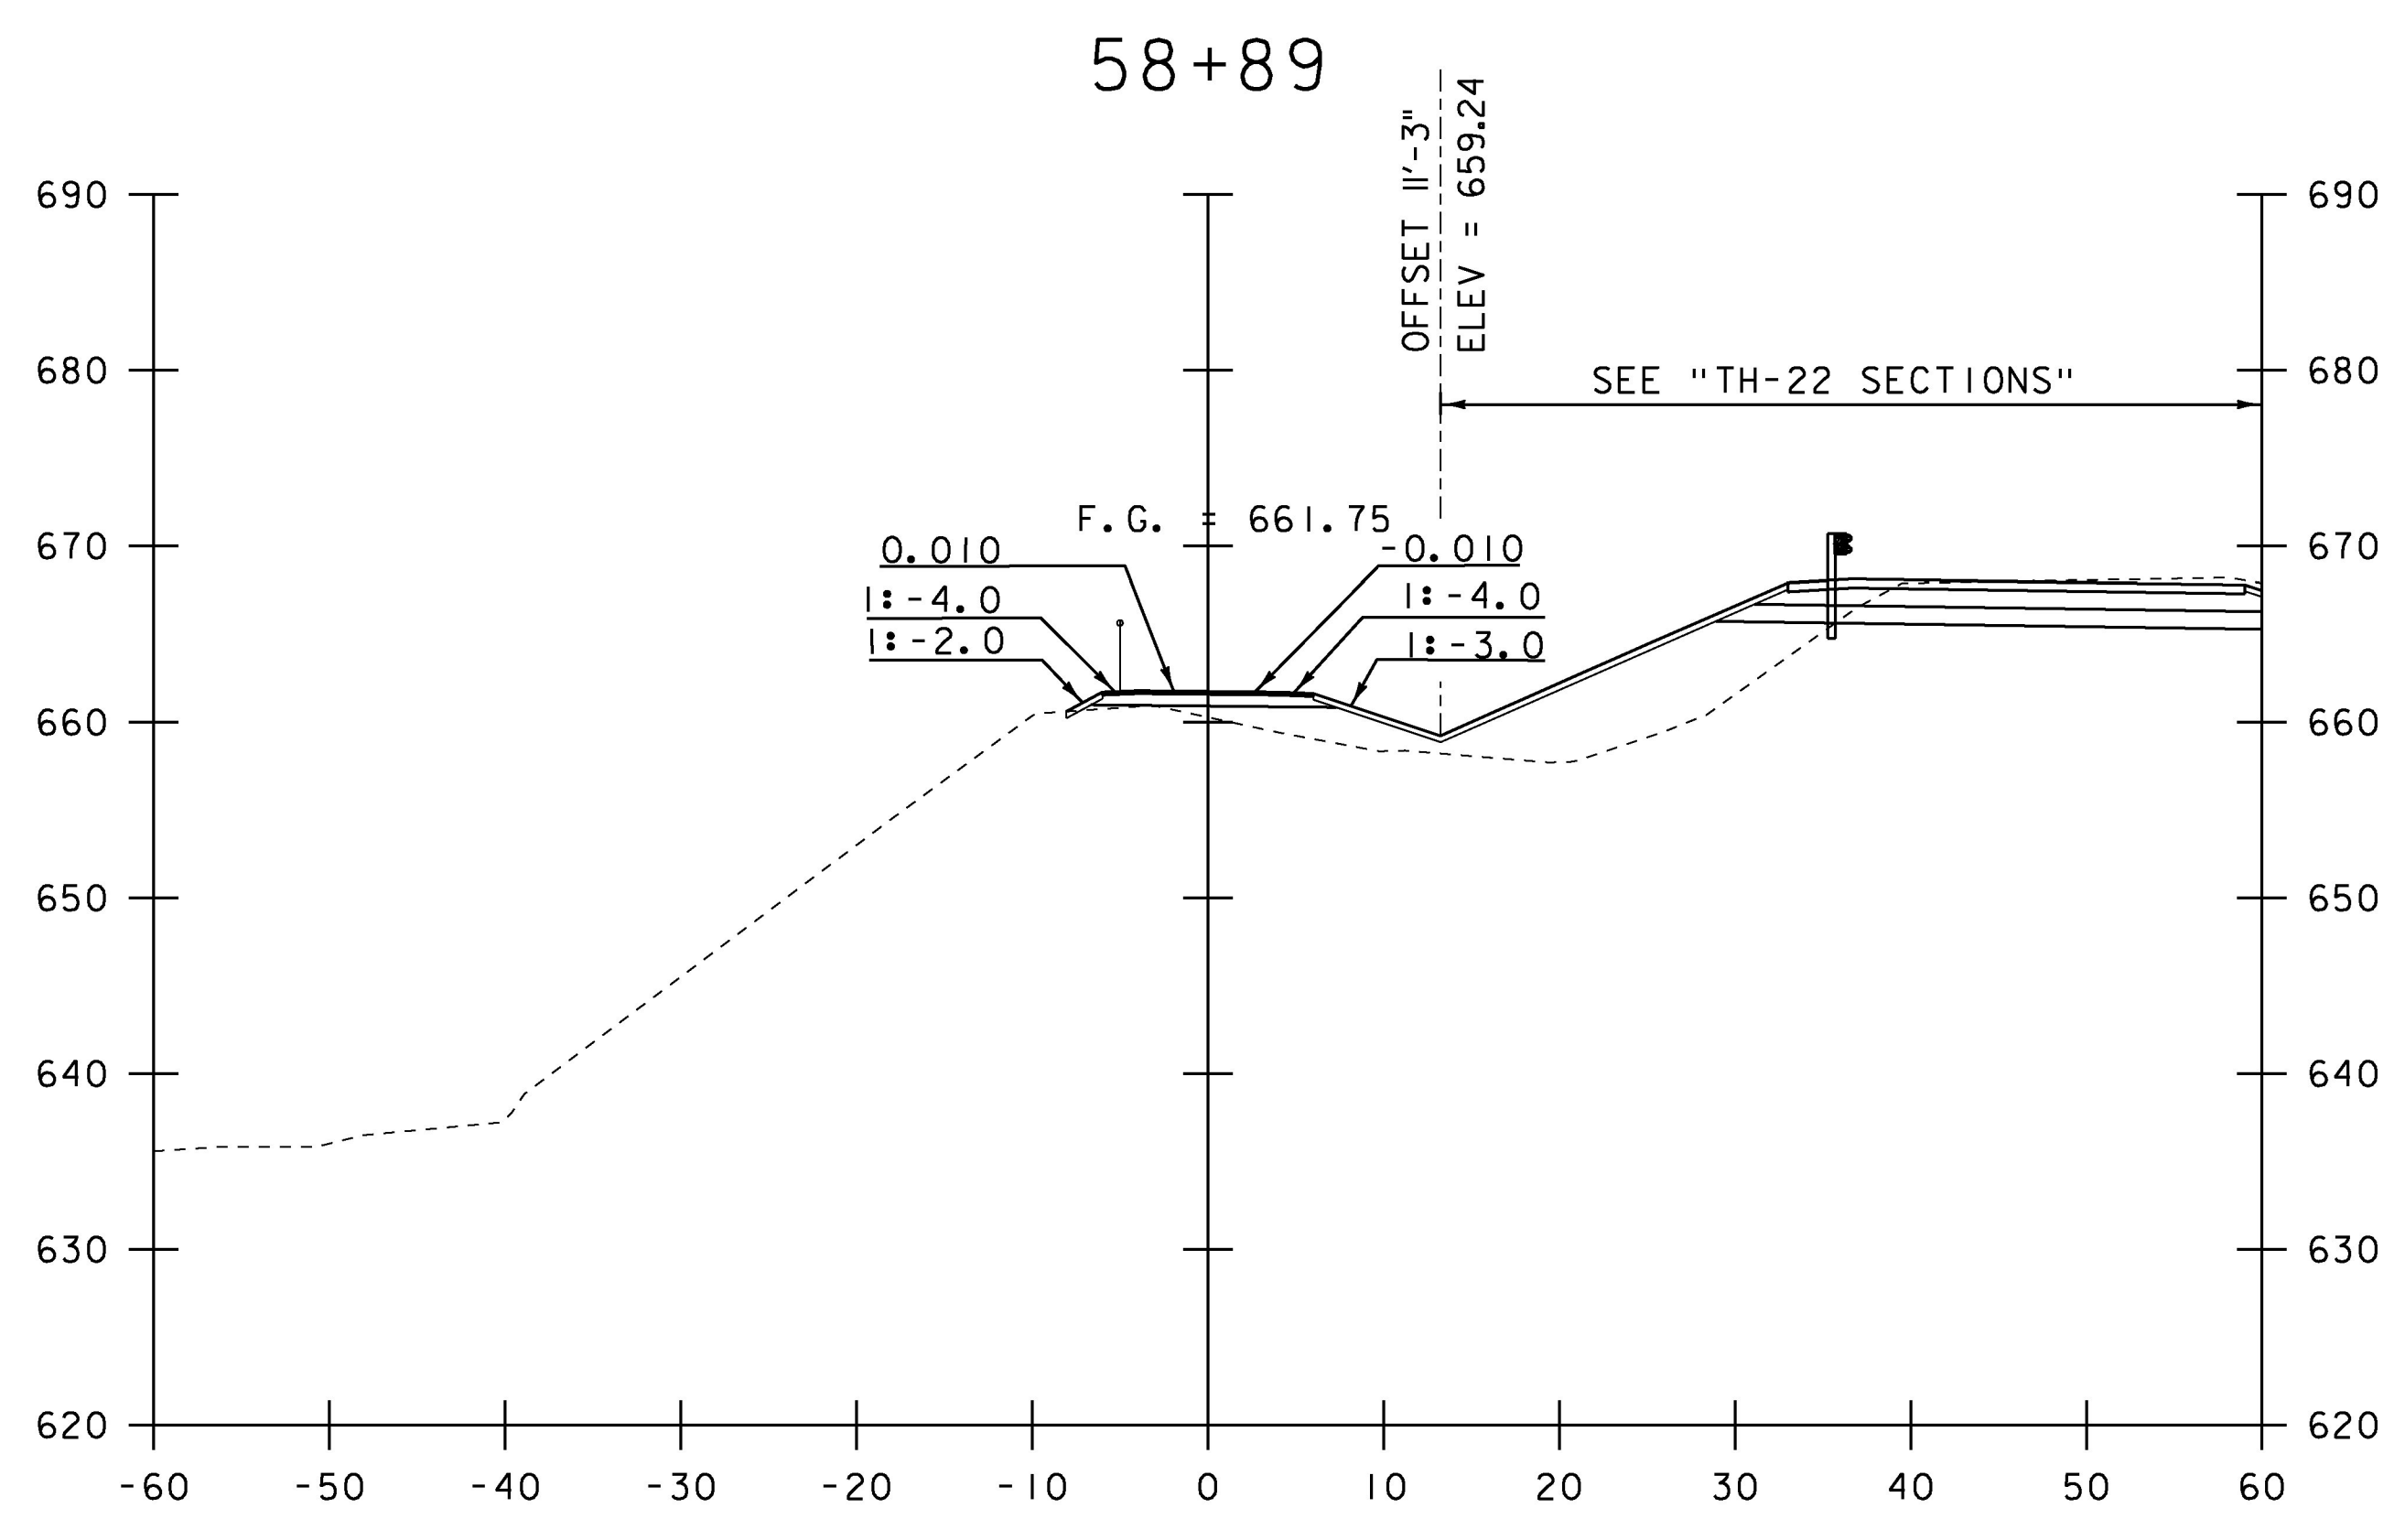

58+50

④ NEW 18 INCH DIA. PIPE
SEE "TH-22 AND TRAIL DRAINAGE PROFILE"
ON THE "DRAINAGE SYSTEMS PROFILE" SHEET

STA. 57+50 TO STA. 58+89

PROJECT NAME: MORRISTOWN	
PROJECT NUMBER: BRS 0240(3)S/STP HES 030-2(28)	
FILE NAME: s78f329xs.dgn	PLOT DATE: 12-APR-2017
PROJECT LEADER: C. CARLSON	DRAWN BY: G. ROKES
DESIGNED BY: C. BURRALL	CHECKED BY: J. LACROIX
TRAIL SECTIONS SHEET 5	SHEET 129 OF 175