


59+71

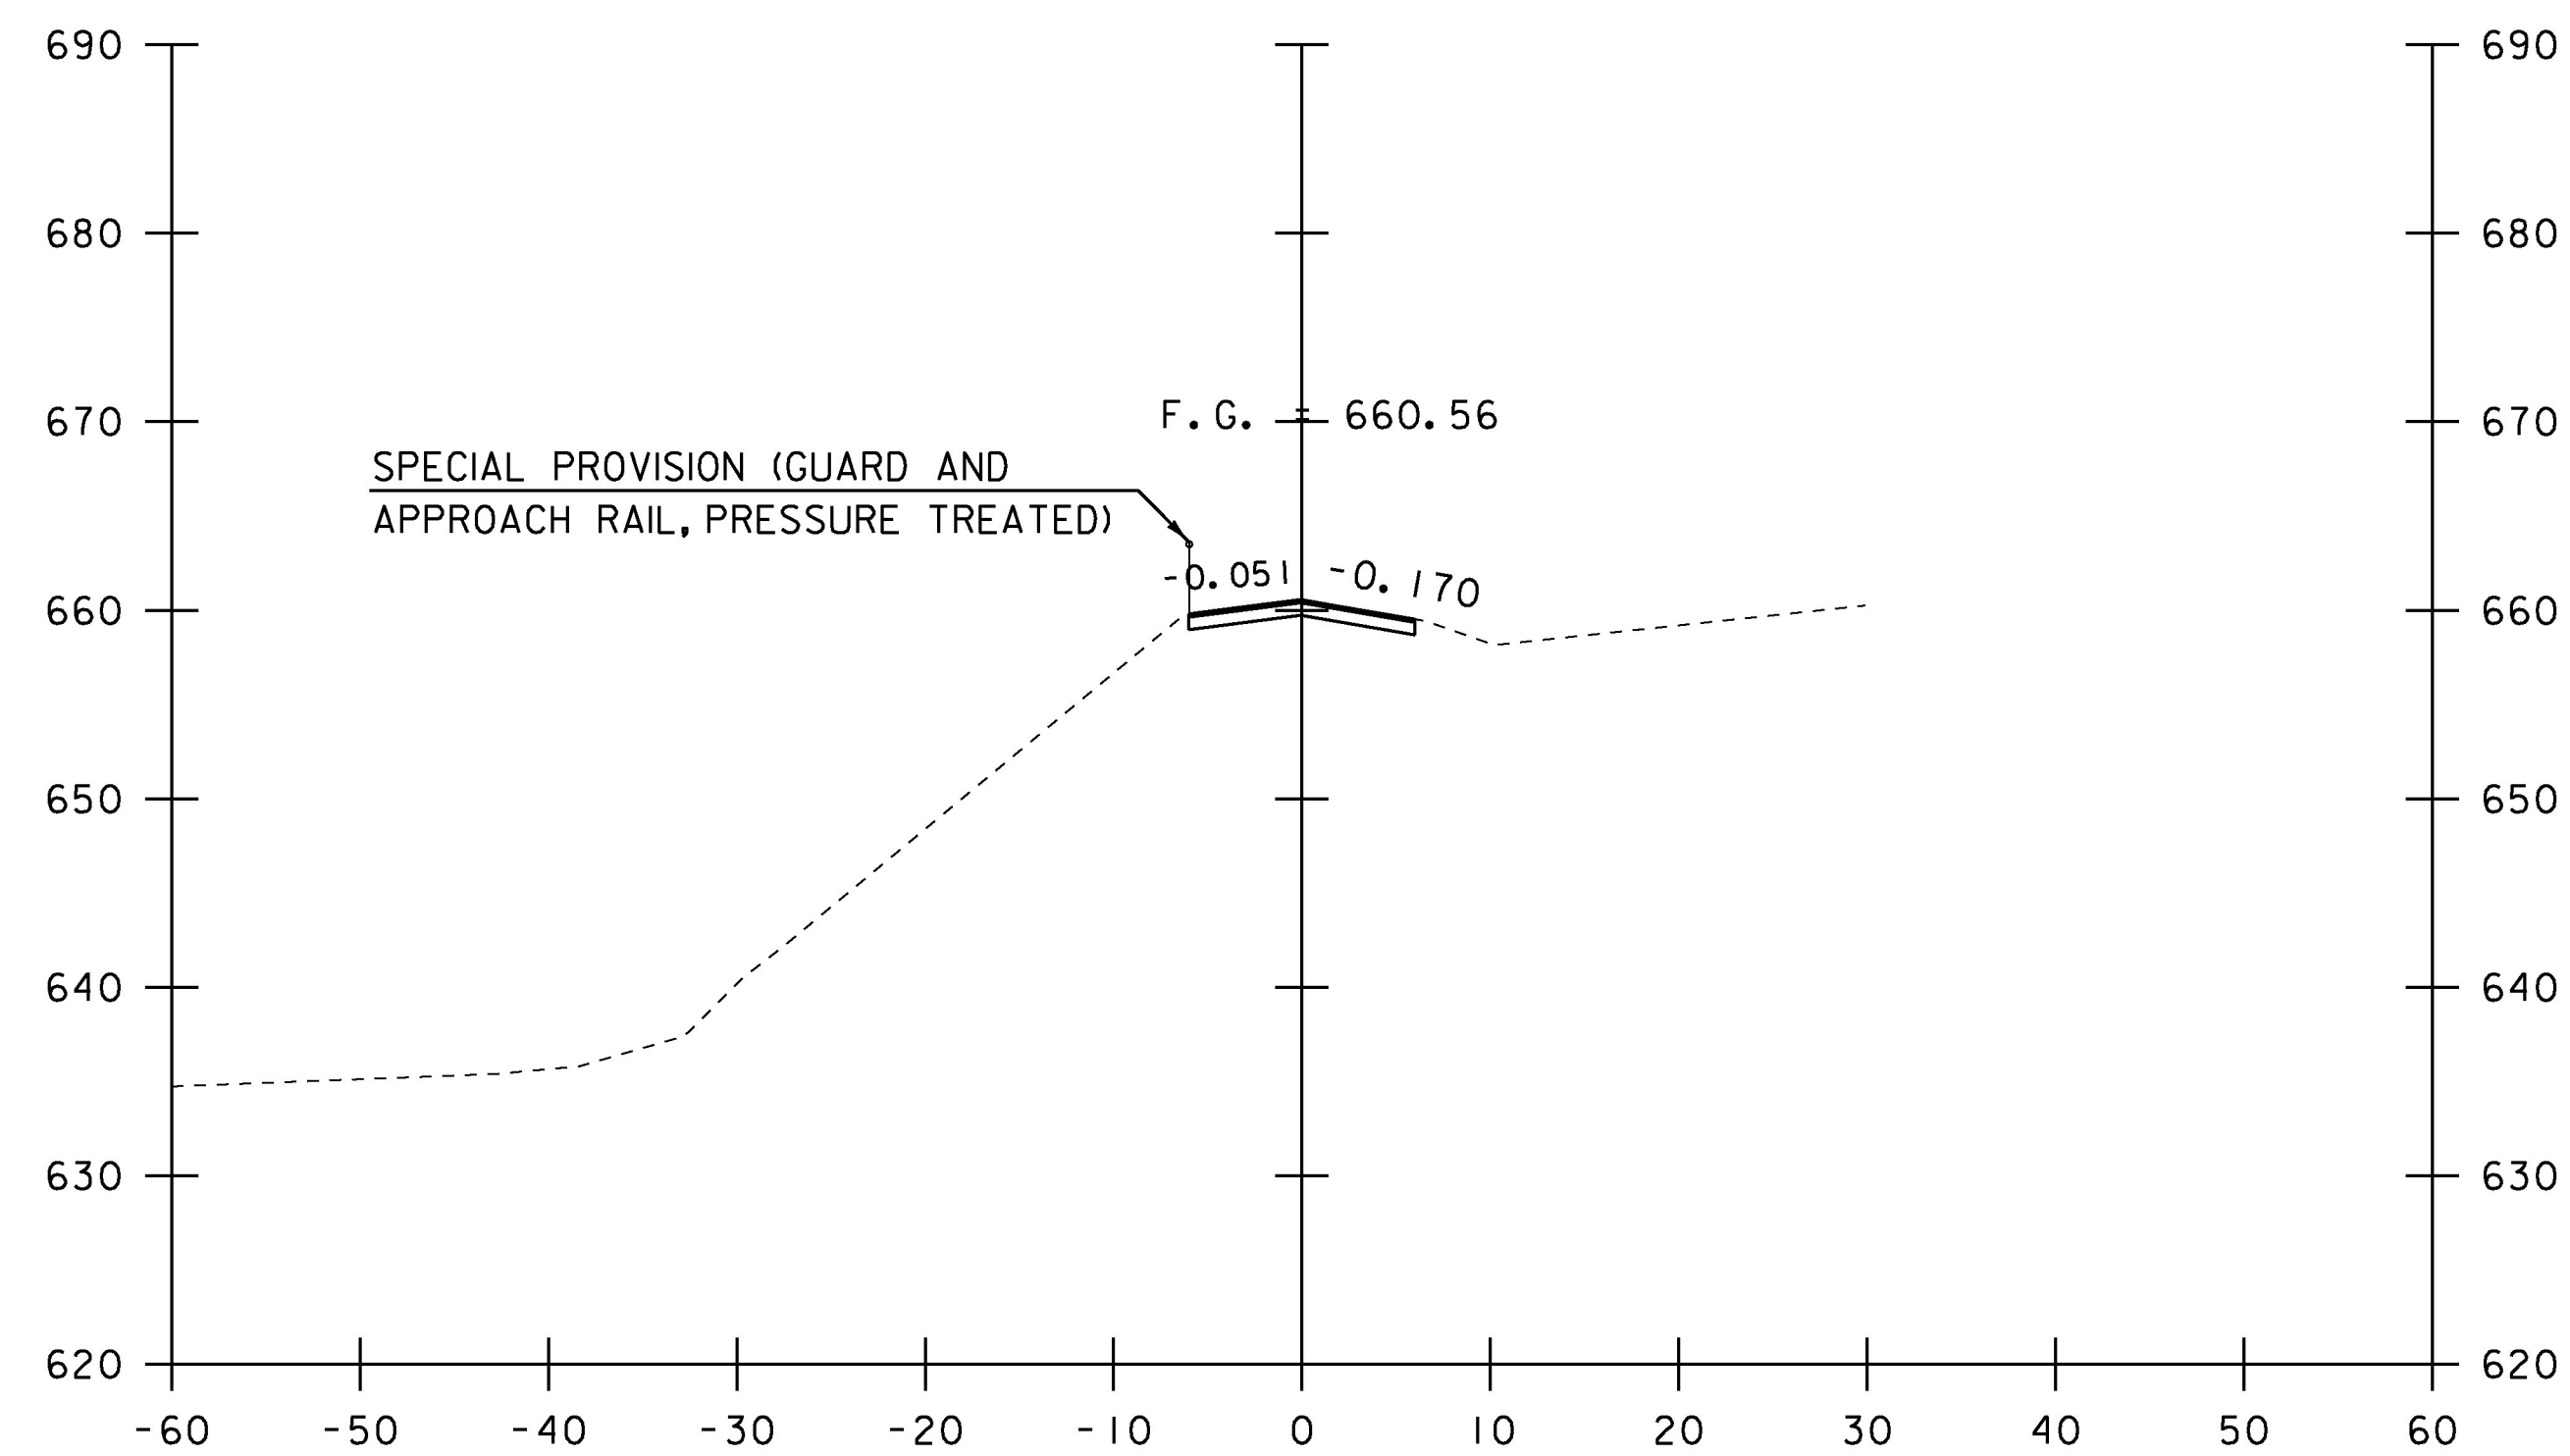

59+50 END TRAIL =  
RAIL VAL STA. 2471+63.97  
MATCH EXISTING

STA. 59+50 TO STA. 59+71

PROJECT NAME:	MORRISTOWN
PROJECT NUMBER:	BRS 0240(3)S/STP HES 030-2(28)
FILE NAME:	s78f329xs.dgn
PROJECT LEADER:	C. CARLSON
DESIGNED BY:	C. BURRALL
TRAIL SECTIONS SHEET	7
PLOT DATE:	12-APR-2017
DRAWN BY:	G. ROKES
CHECKED BY:	J. LACROIX
SHEET	131 OF 175