




20+50

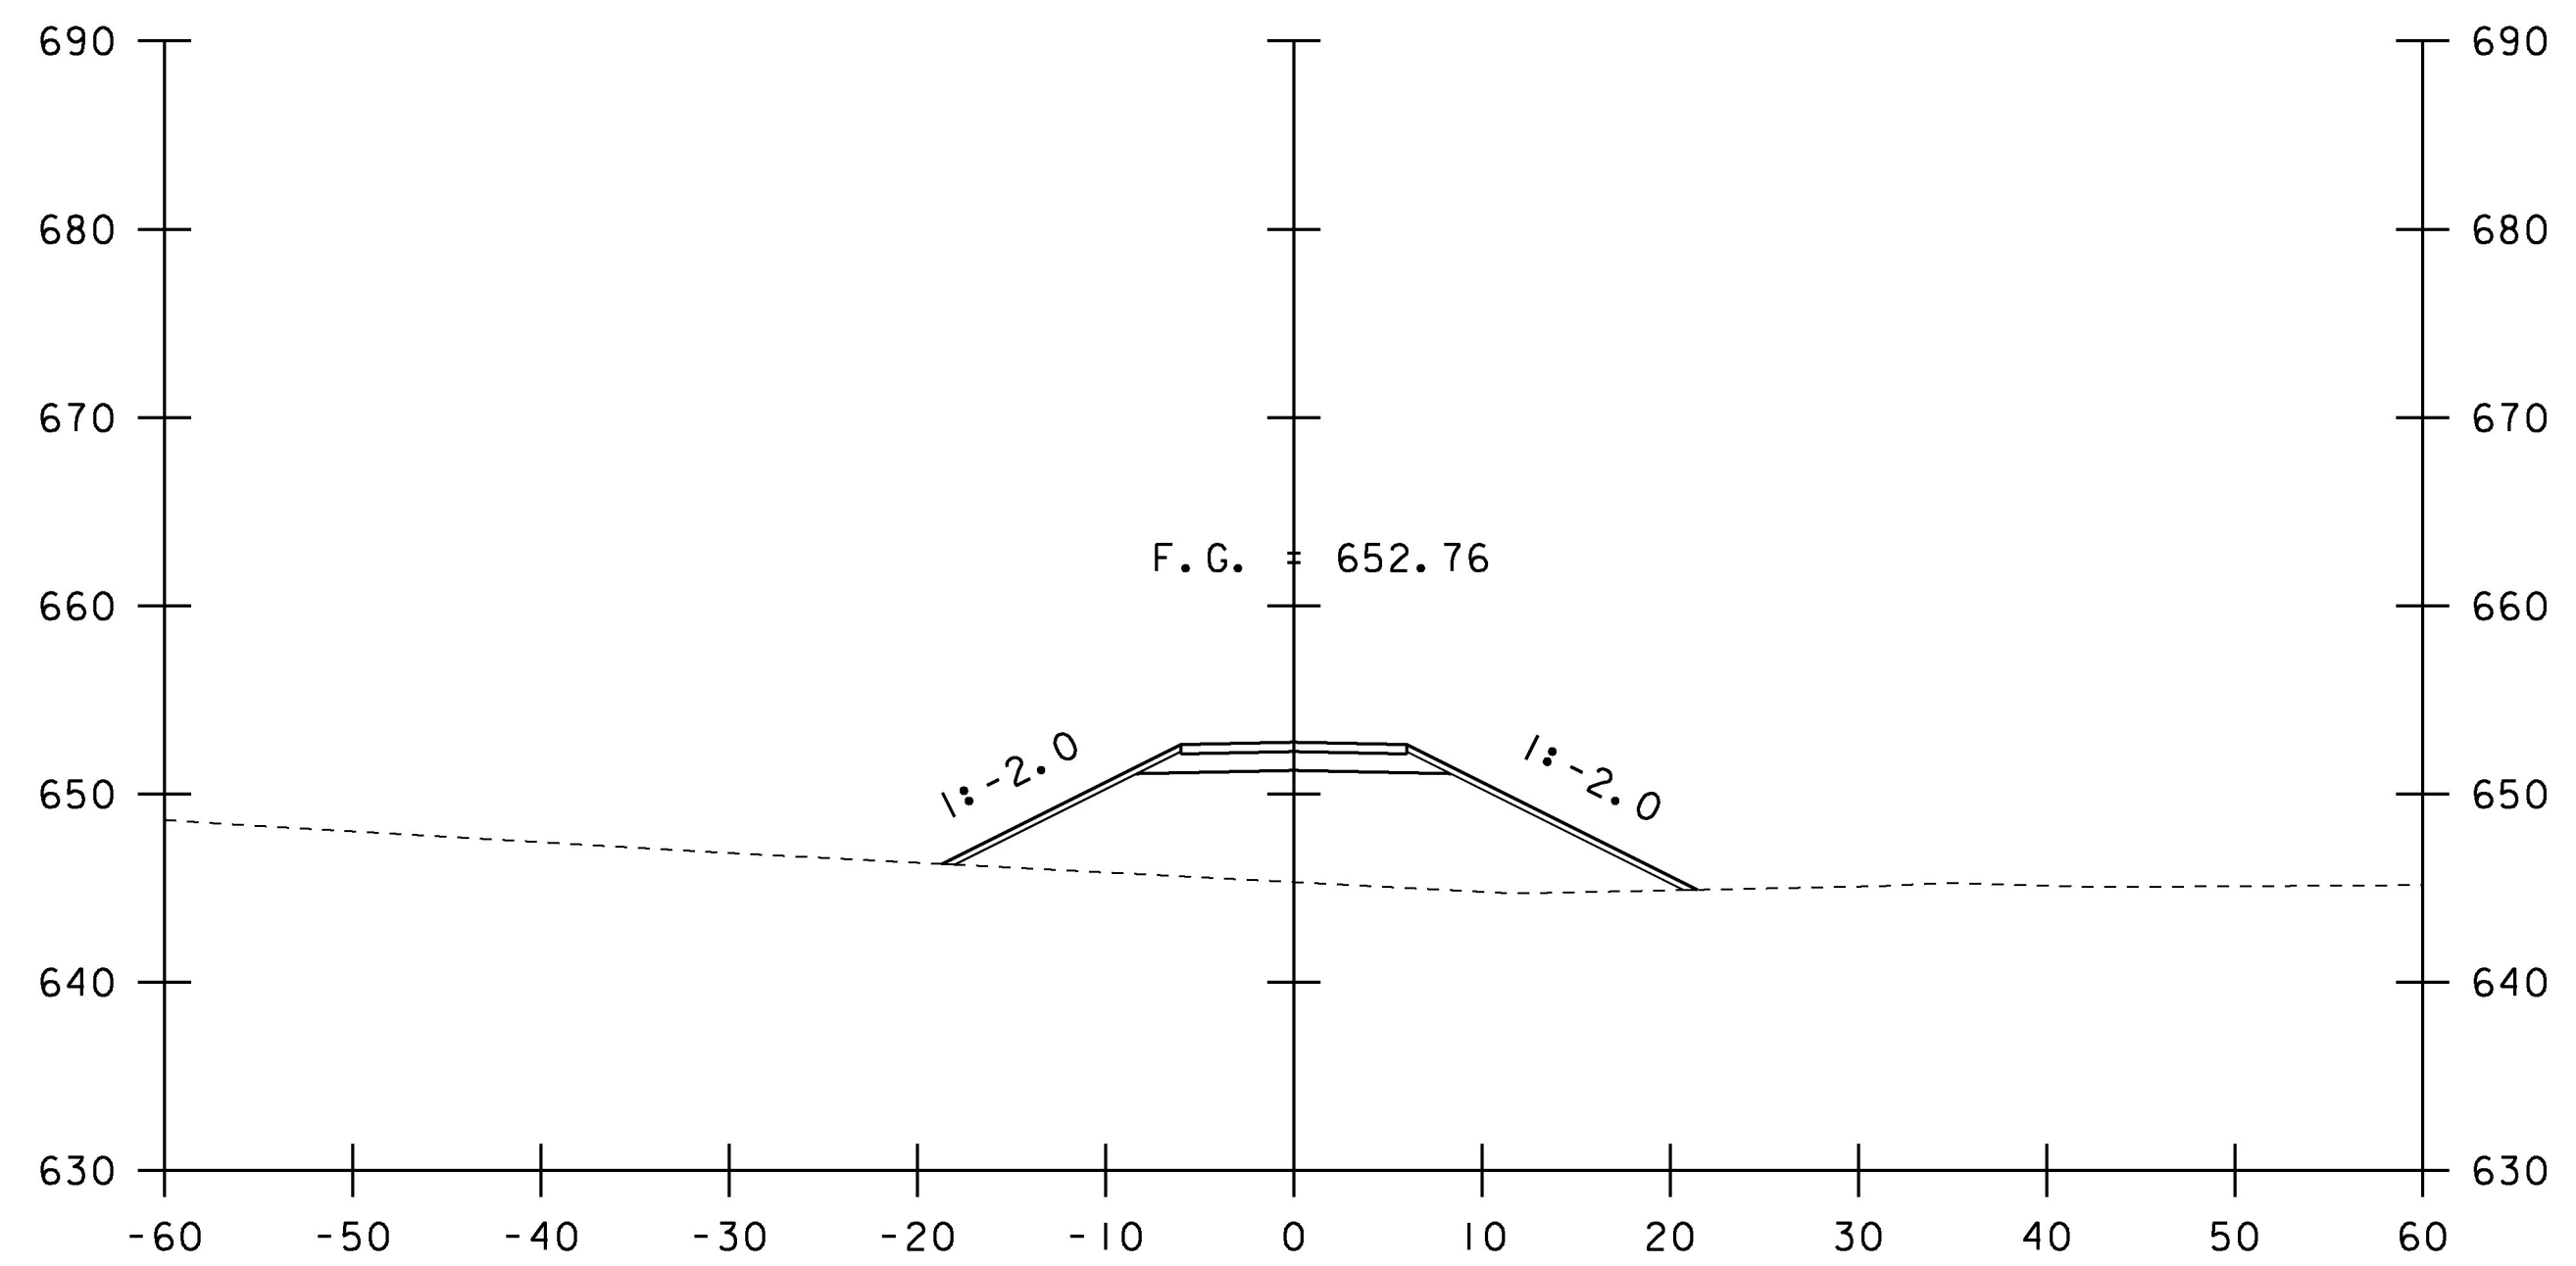

21+50

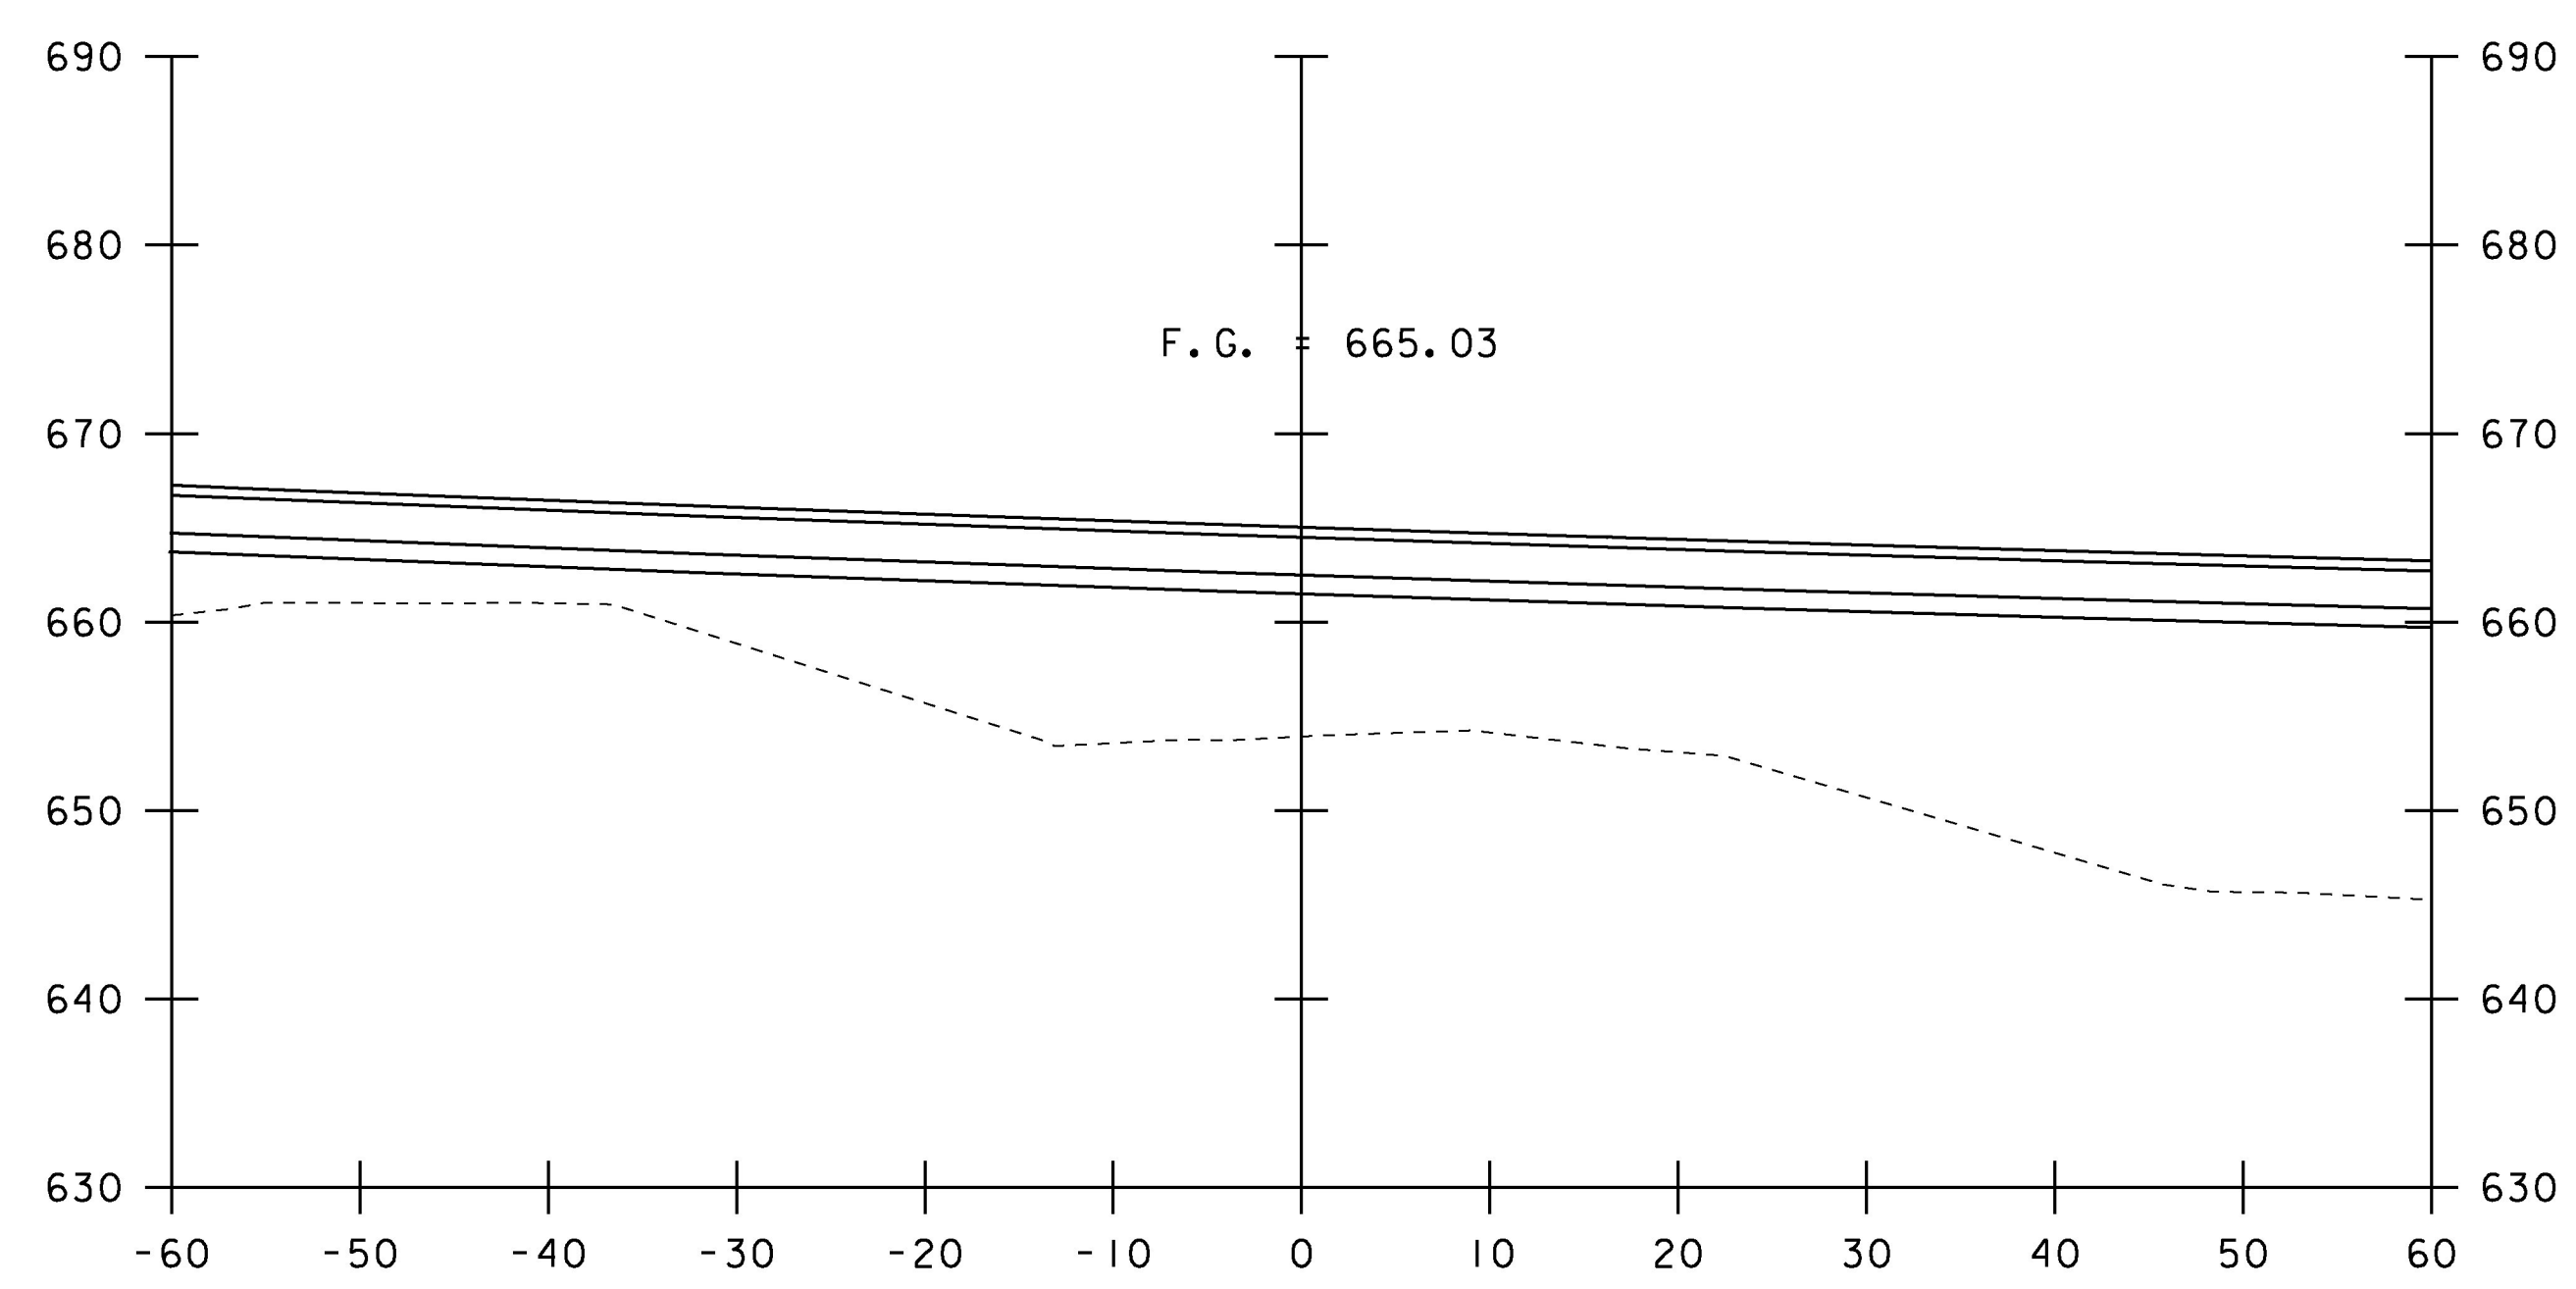

20+15
EDGE OF VT-15A

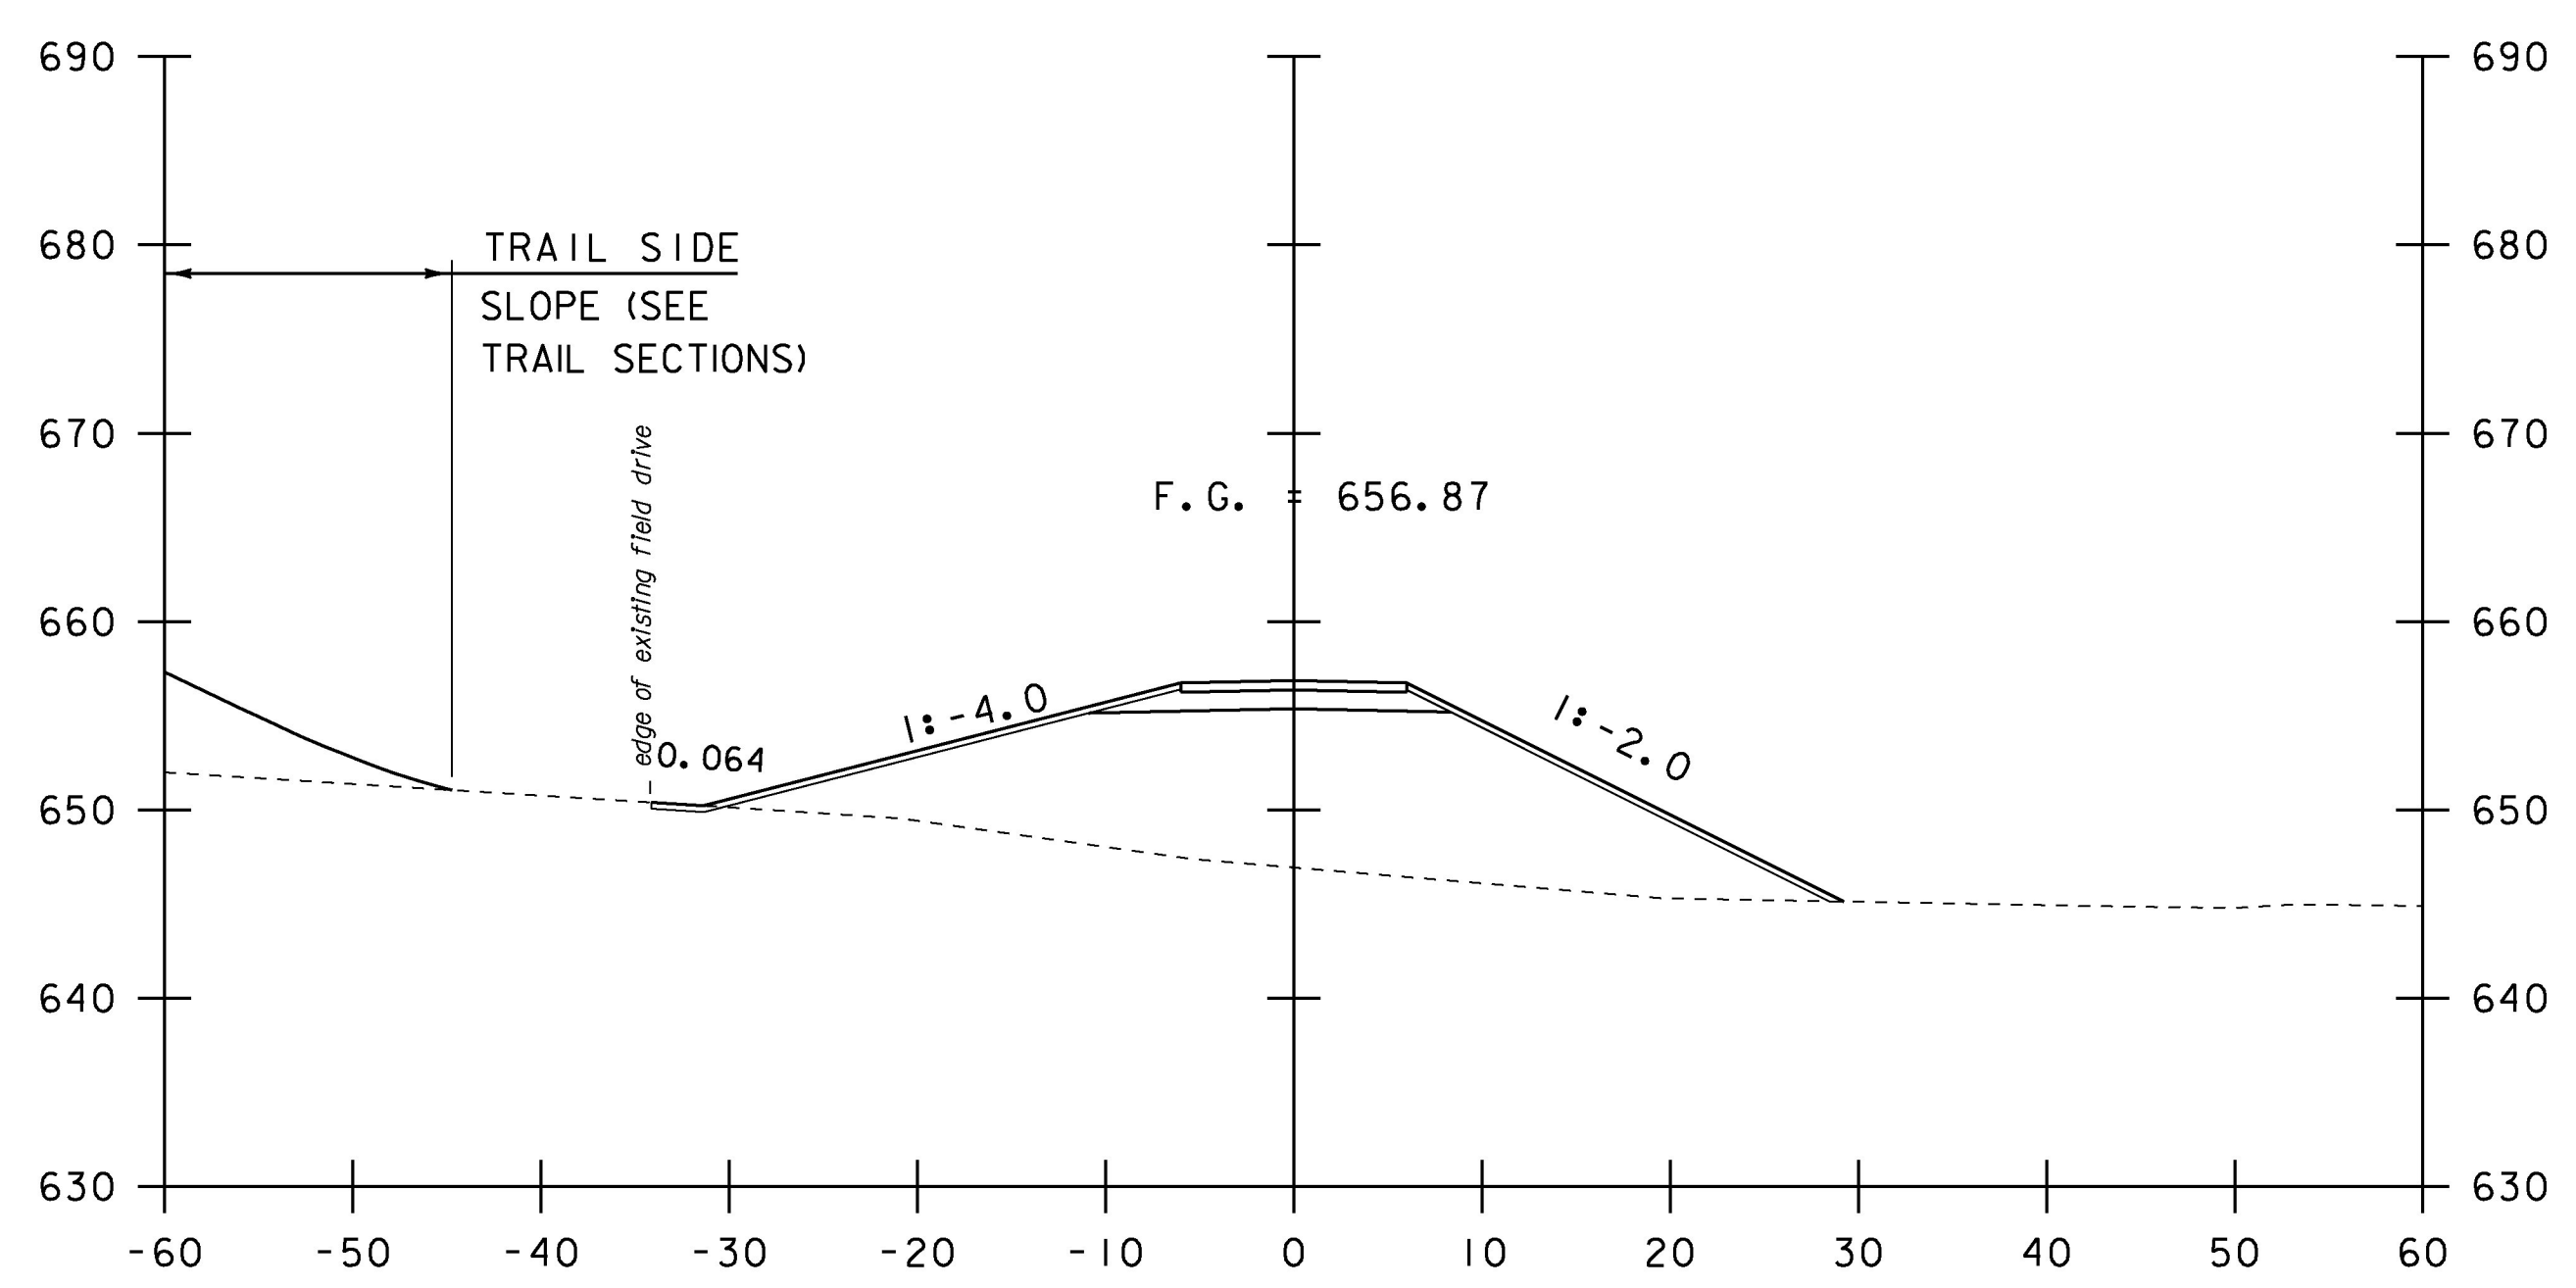

21+00

STA. 20+15 TO STA. 21+50

PROJECT NAME:	MORRISTOWN
PROJECT NUMBER:	BRS 0240(3)S/STP HES 030-2(28)
FILE NAME:	s78f329xs.dgn
PROJECT LEADER:	C. CARLSON
DESIGNED BY:	C. BURRALL
FIELD DRIVE 1 SECTIONS SHEET 1	
PLOT DATE:	12-APR-2017
DRAWN BY:	G. ROKES
CHECKED BY:	J. LACROIX
SHEET	132 OF 175