



22+50

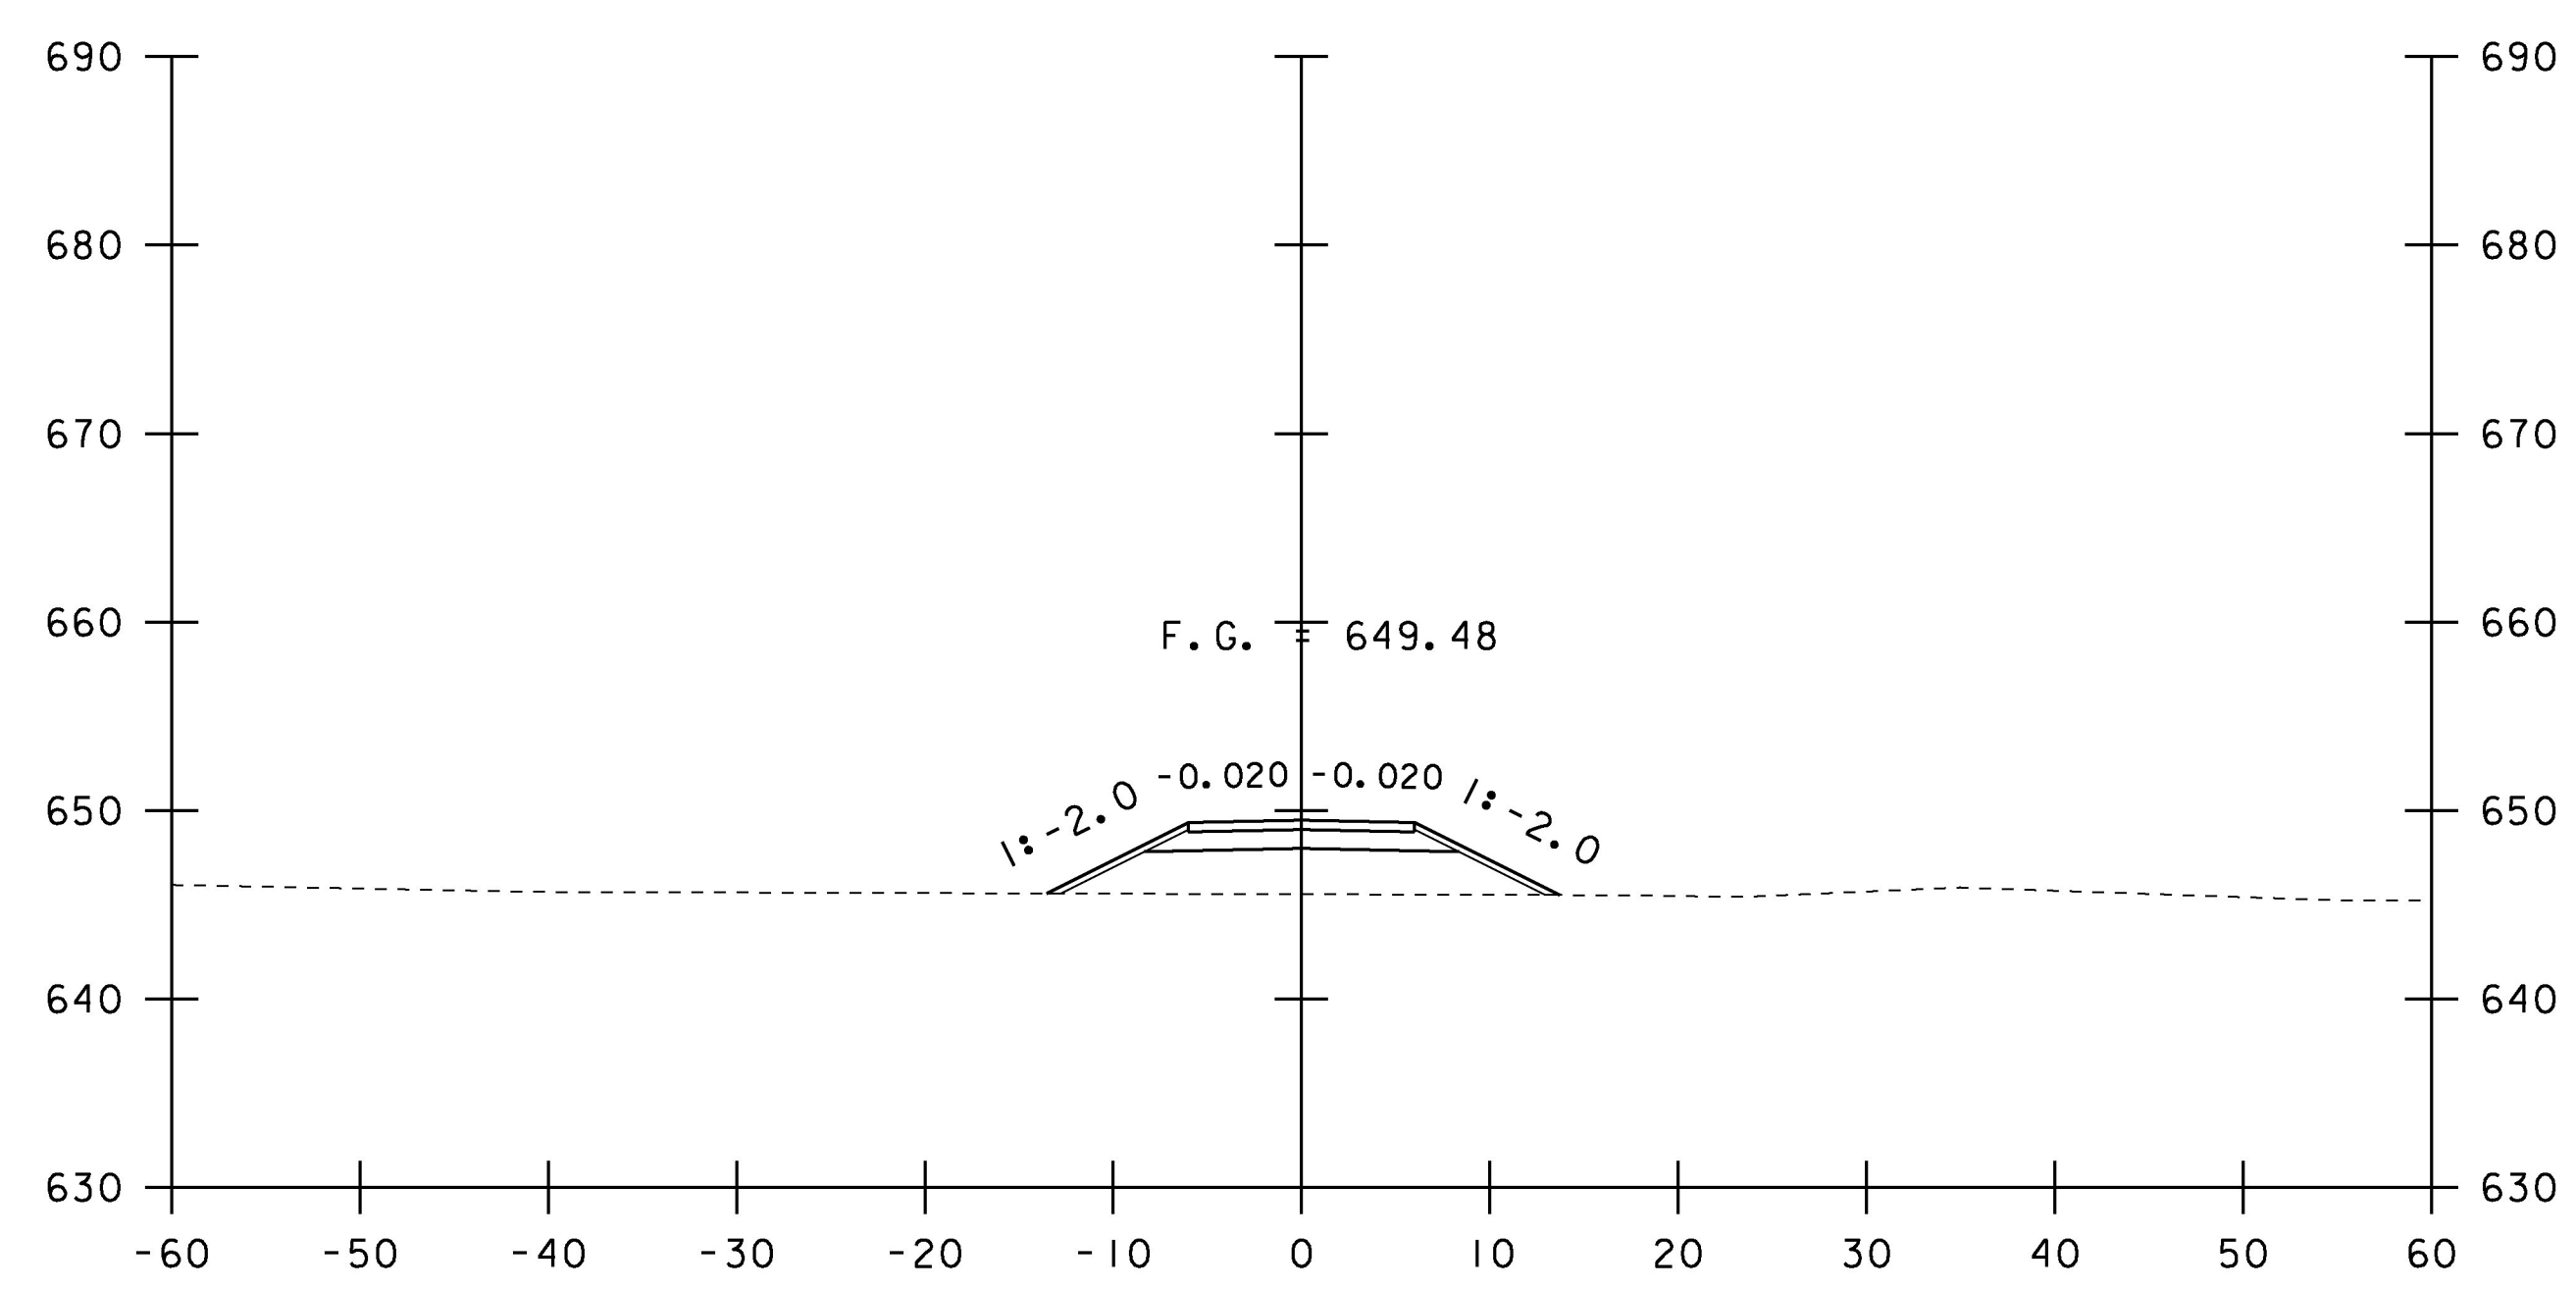

22+00

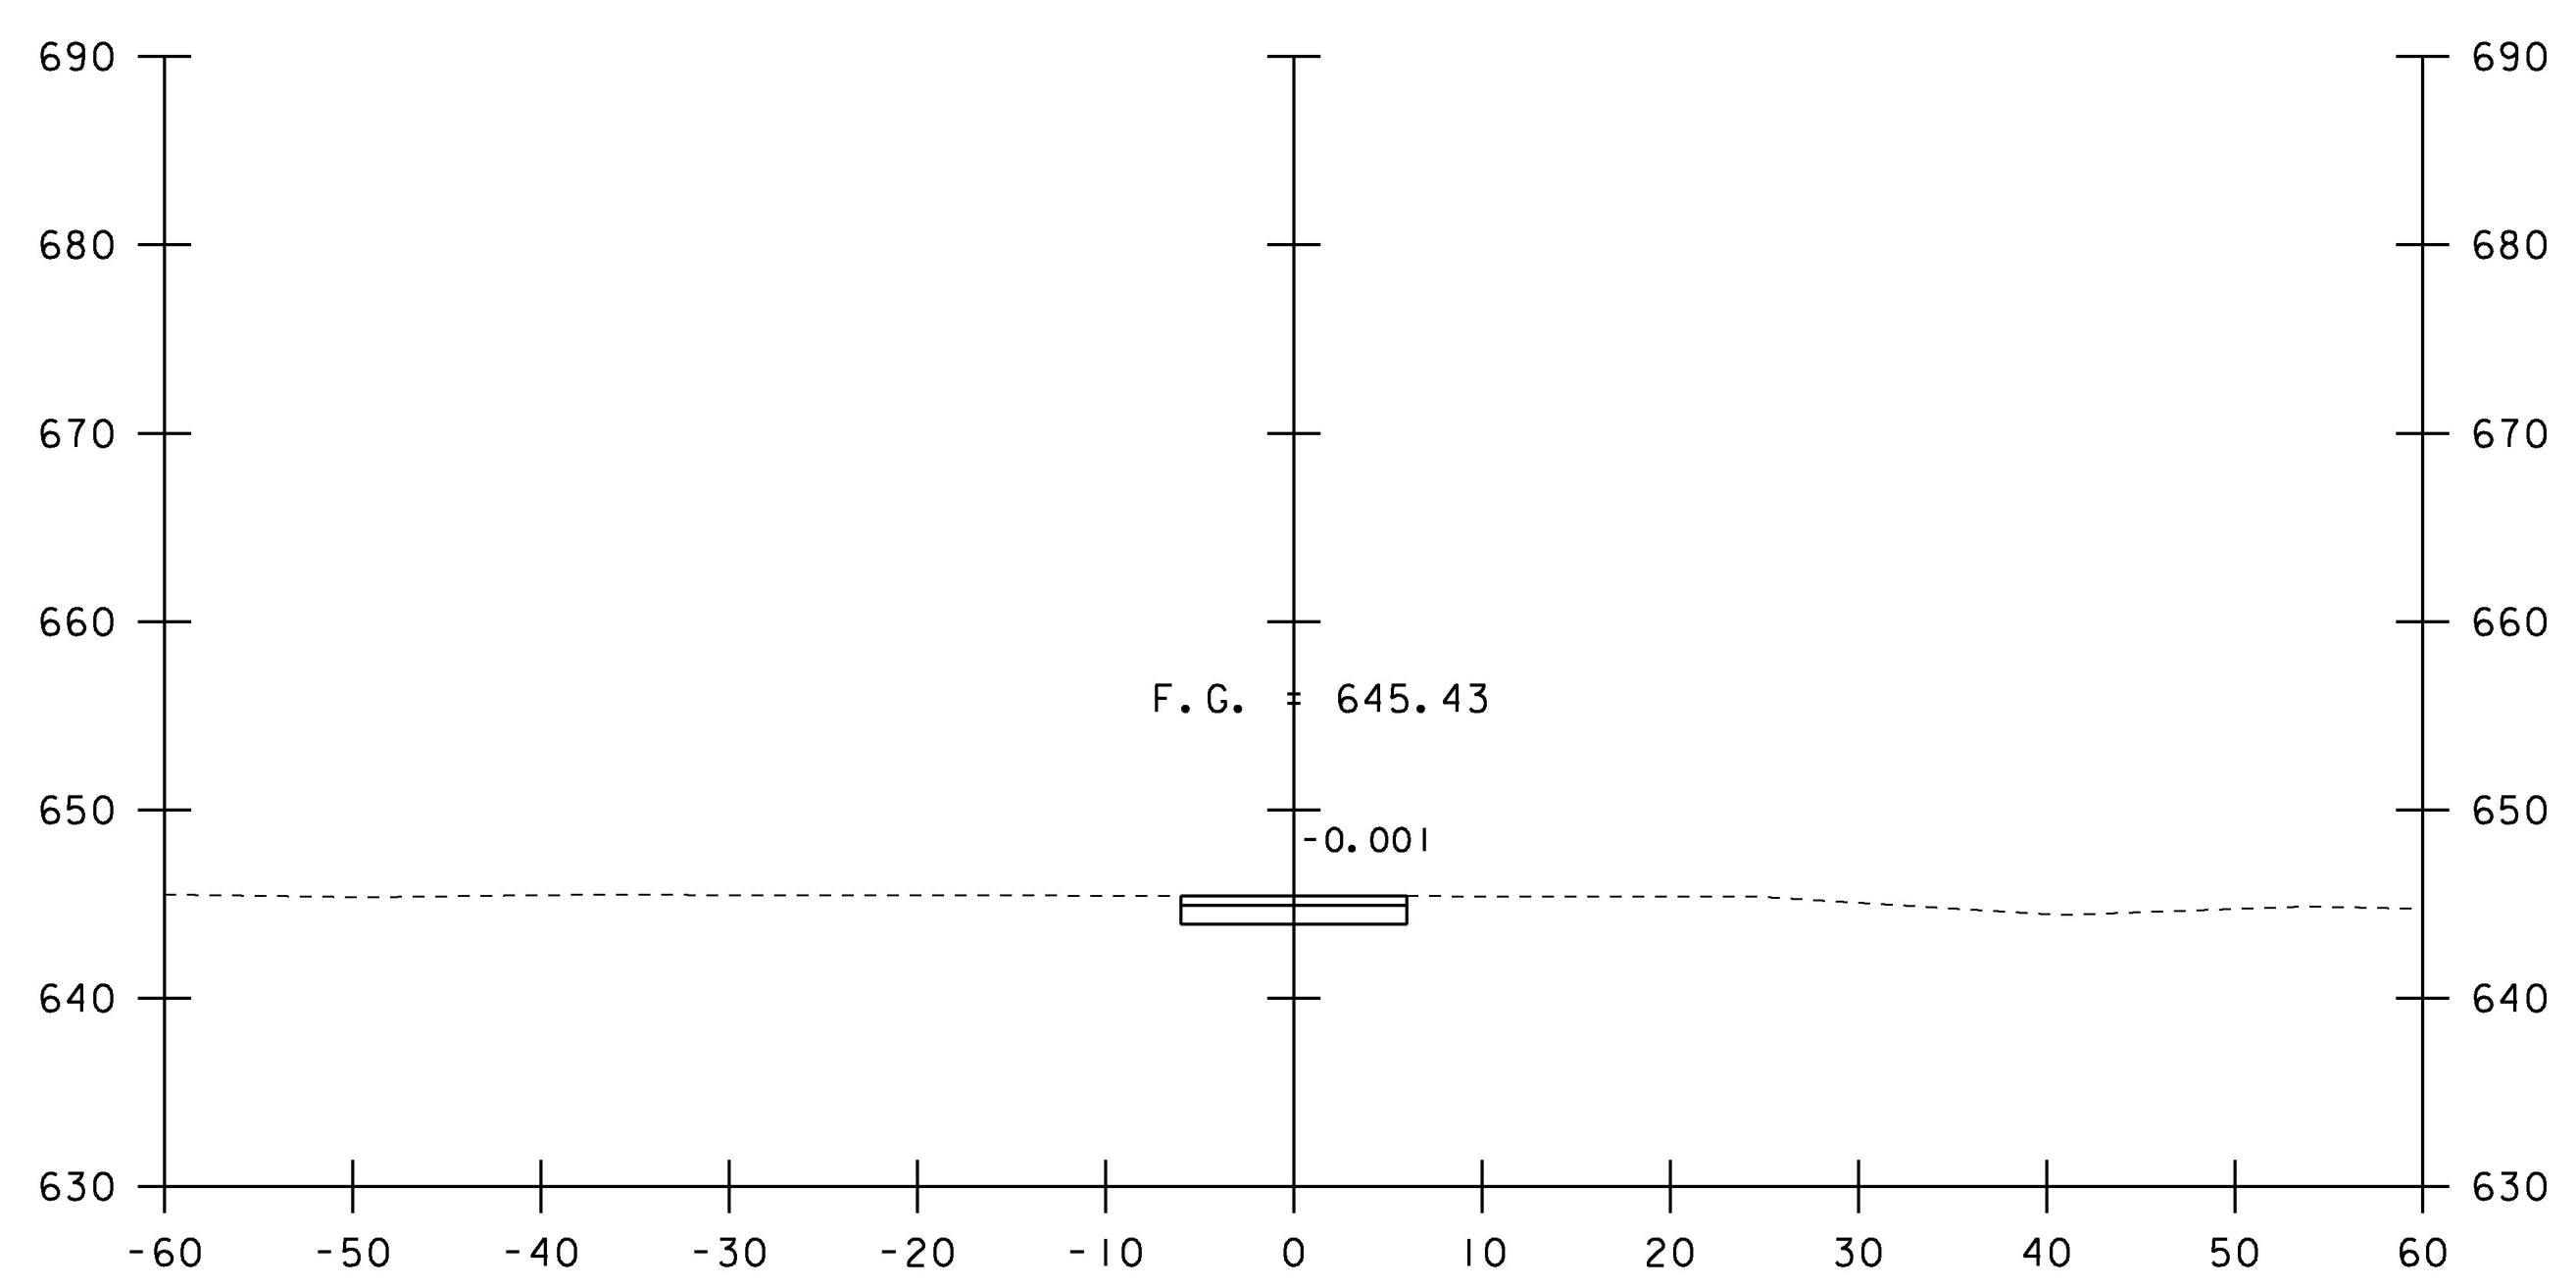

23+00  
END FIELD DRIVE

STA. 22+00 TO STA. 23+00

PROJECT NAME: MORRISTOWN	PLOT DATE: 12-APR-2017
PROJECT NUMBER: BRS 0240(3)S/STP HES 030-2(28)	DRAWN BY: G. ROKES
FILE NAME: s78f329xs.dgn	CHECKED BY: J. LACROIX
PROJECT LEADER: C. CARLSON	SHEET 133 OF 175
DESIGNED BY: C. BURRALL	
FIELD DRIVE 1 SECTIONS SHEET 2	