




I+50

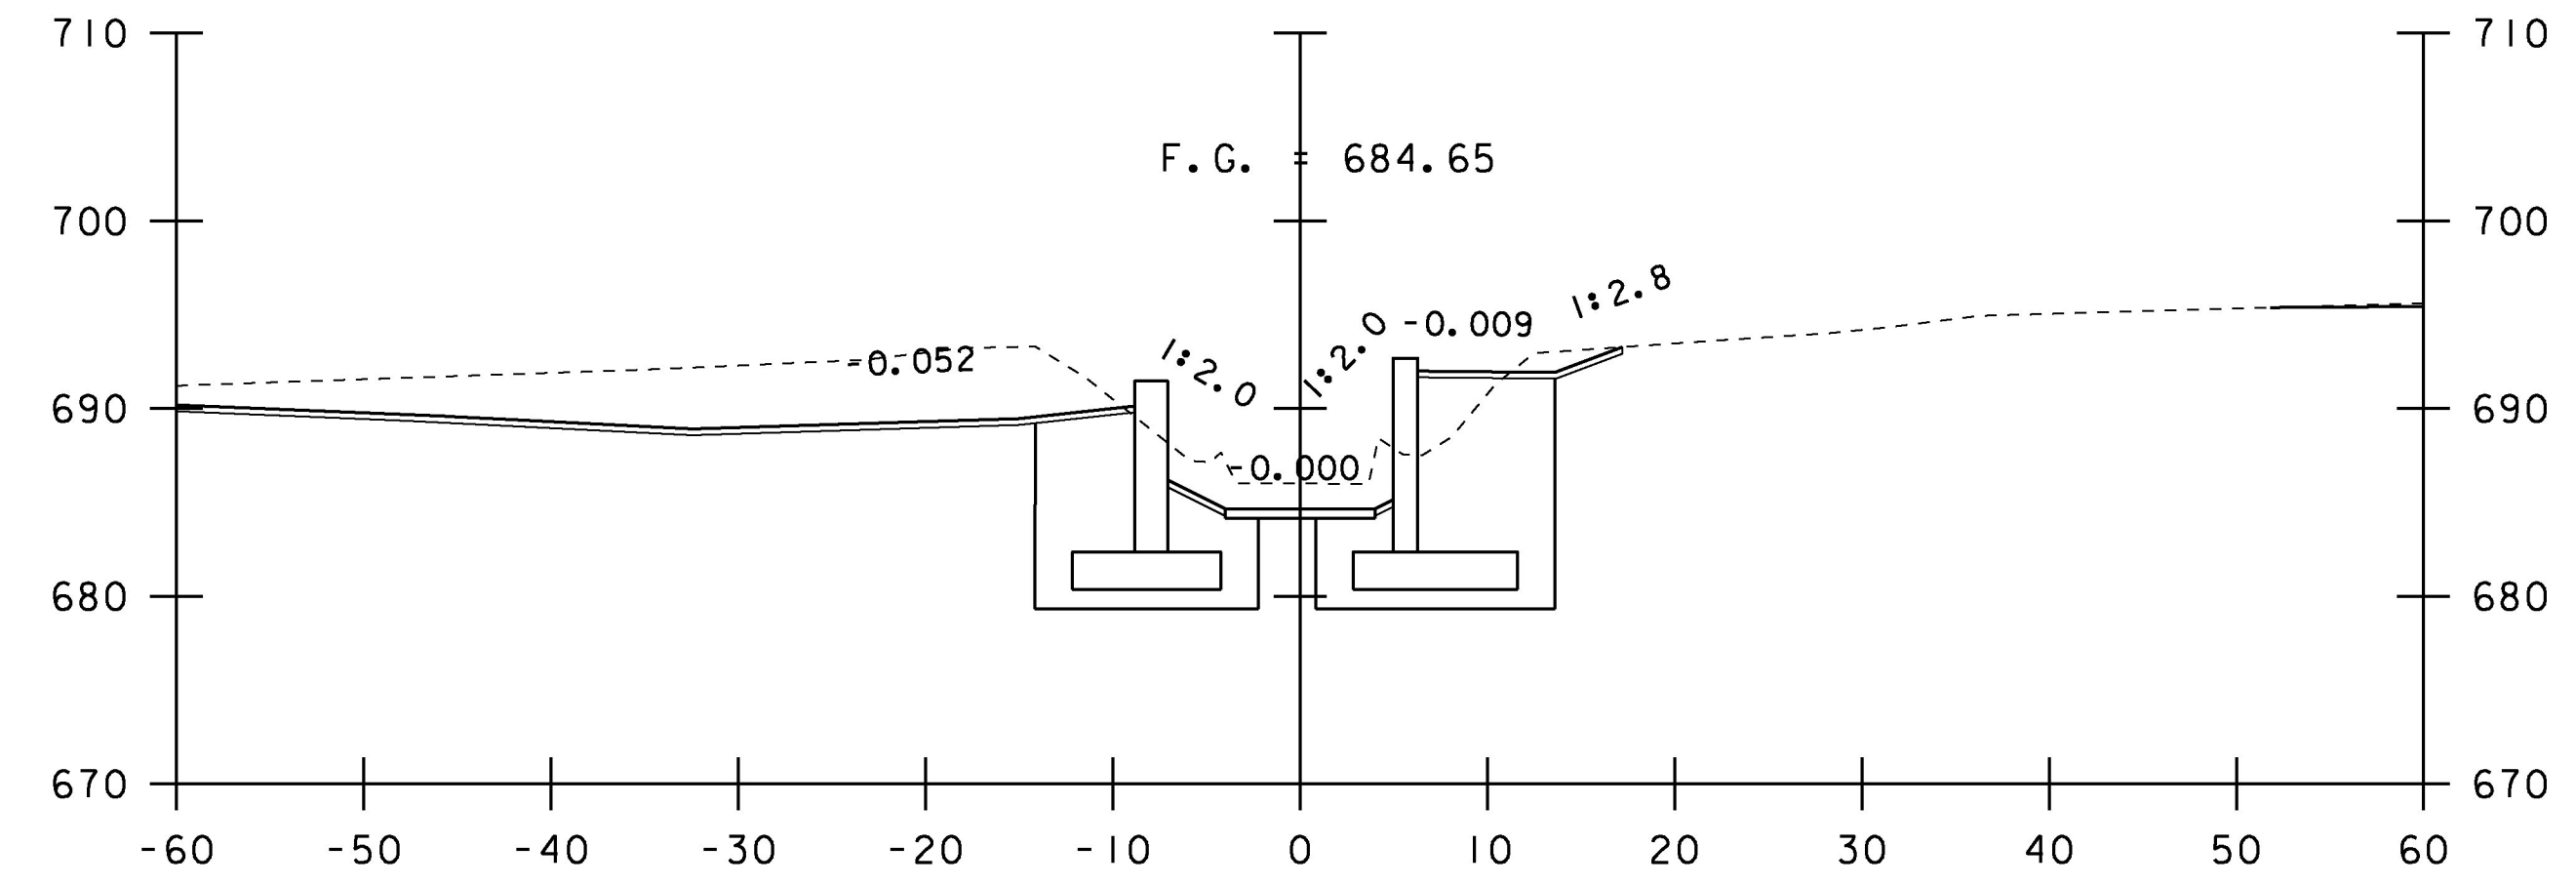


I+75

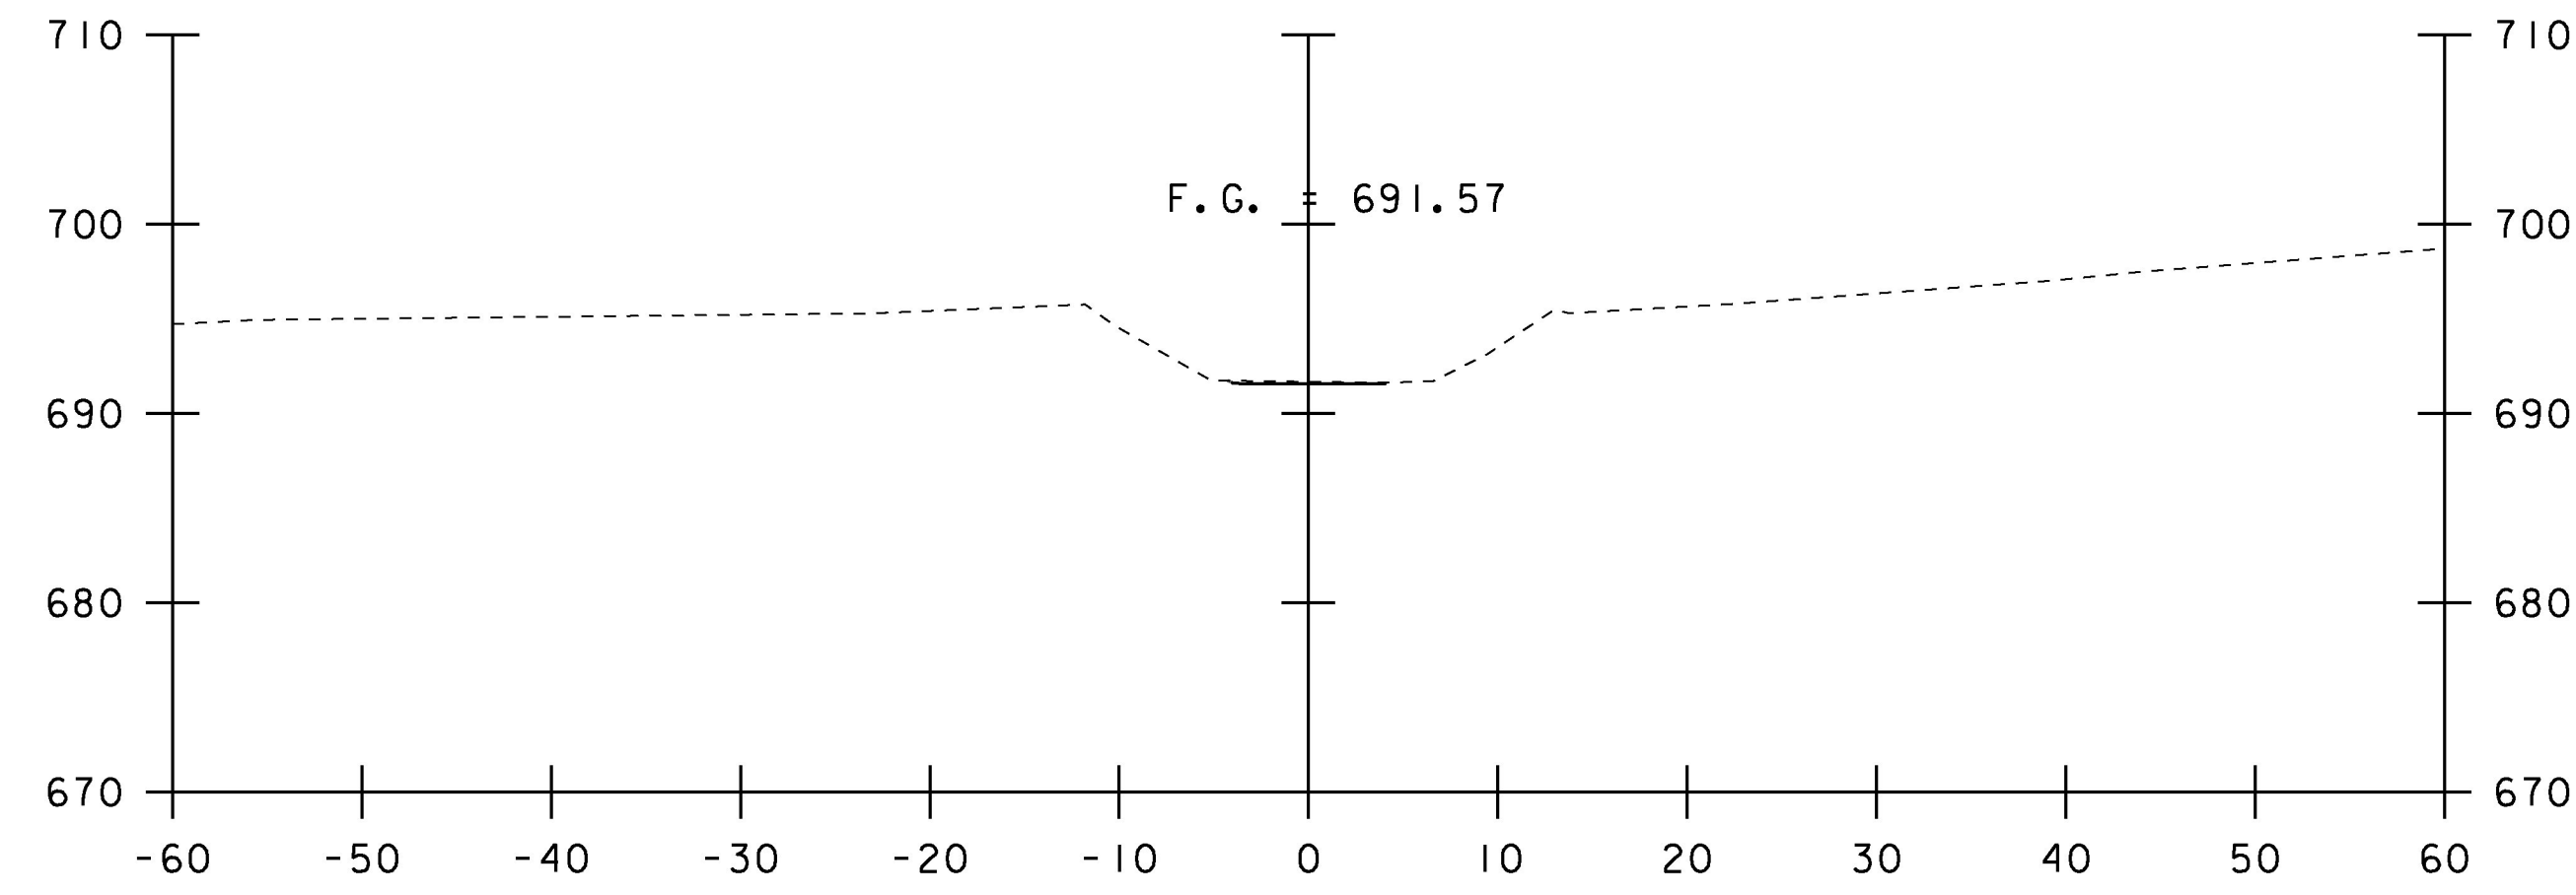


I+47

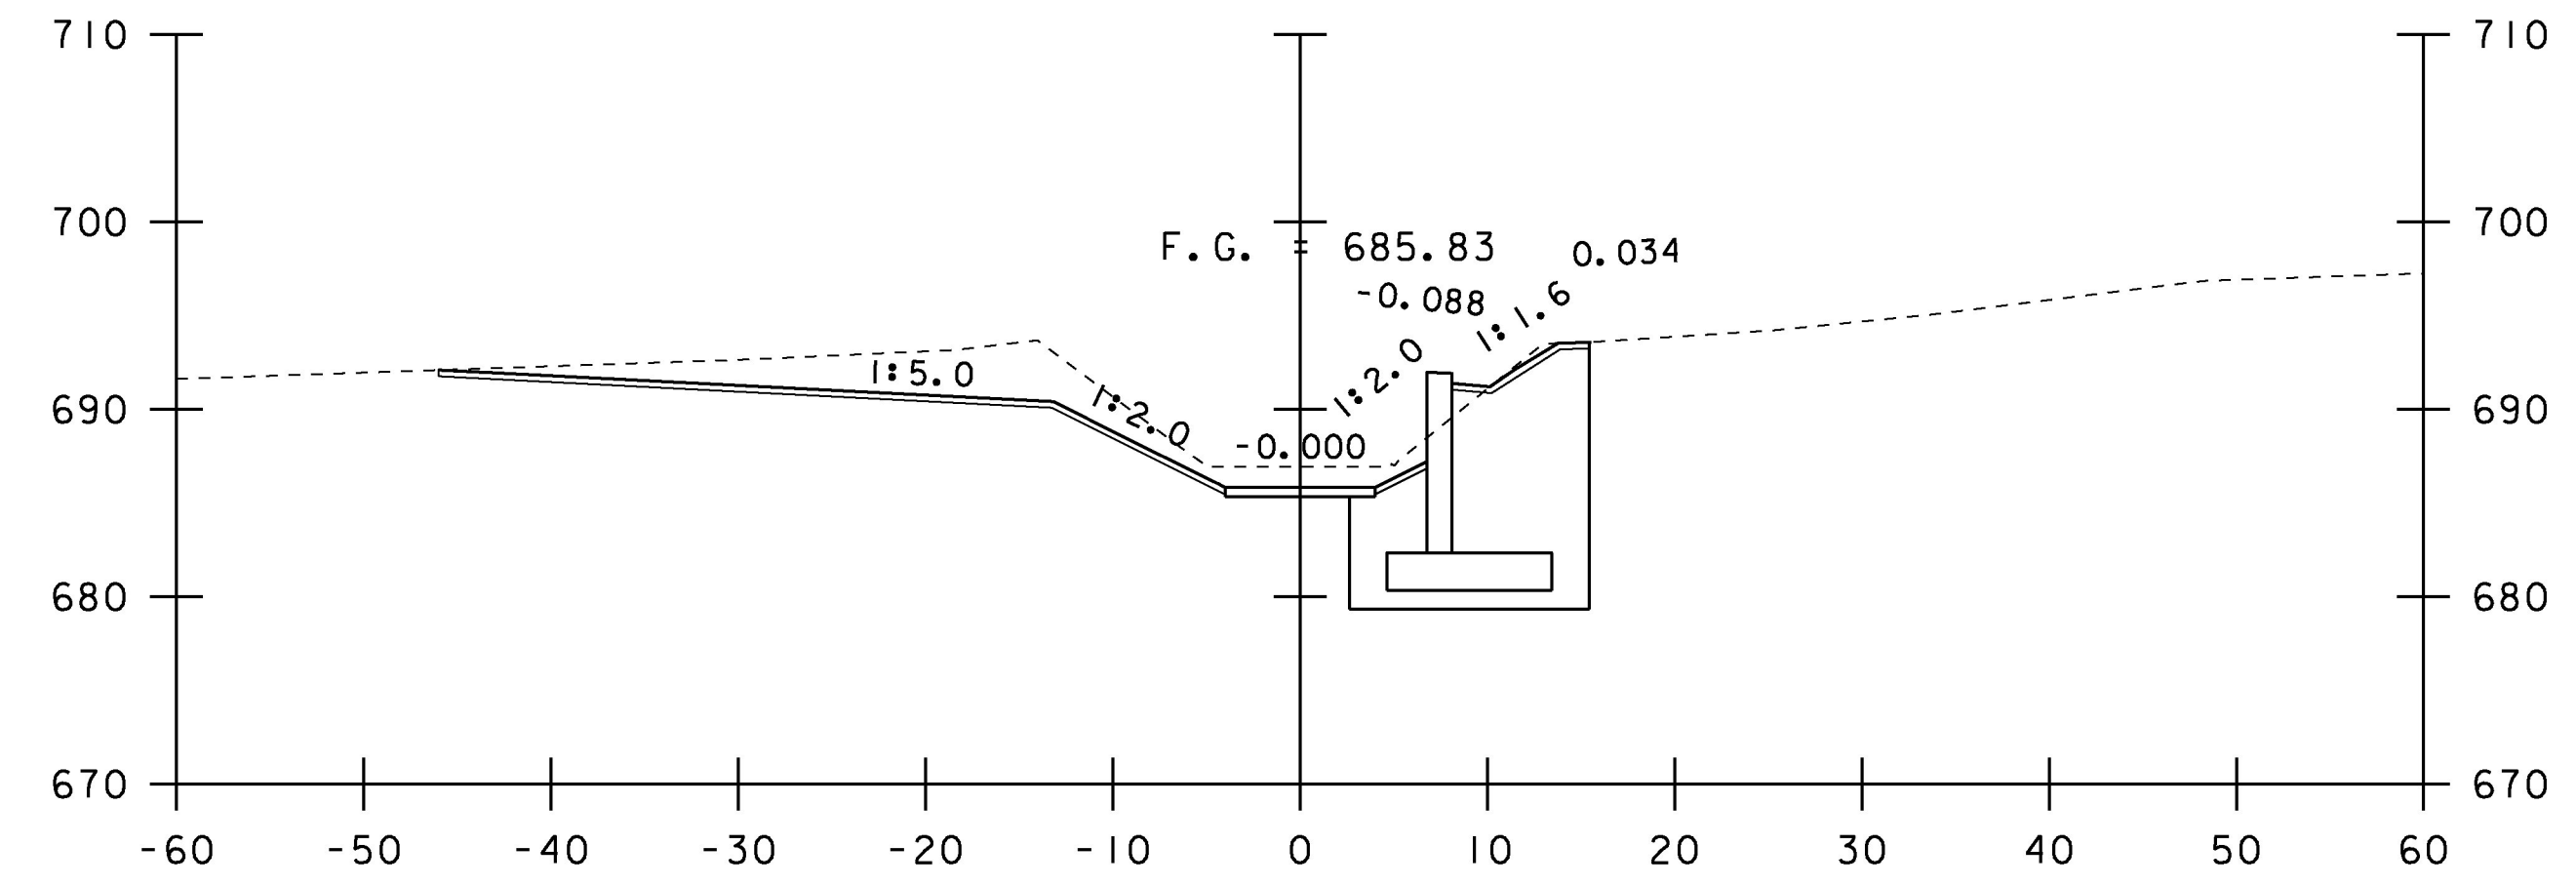

I+70

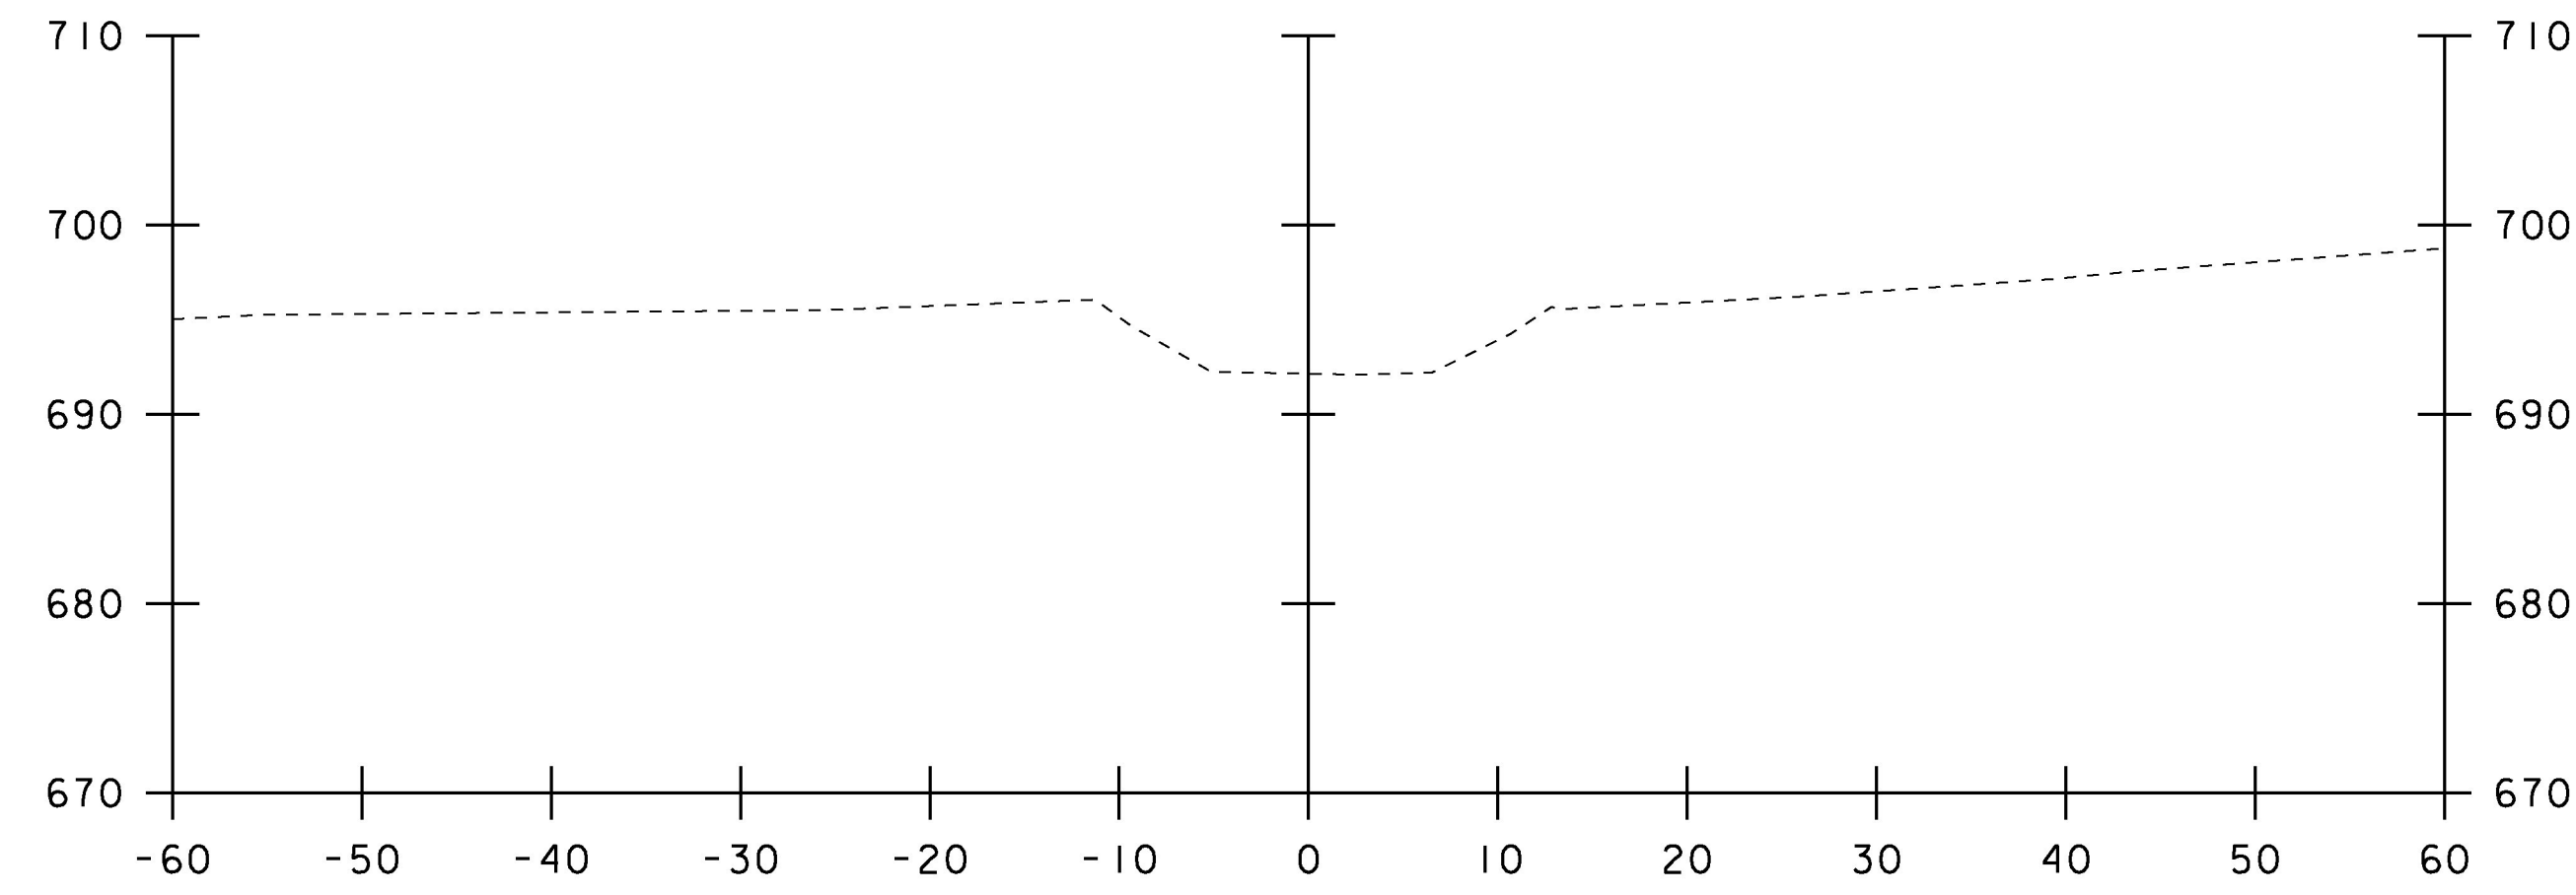

I+45

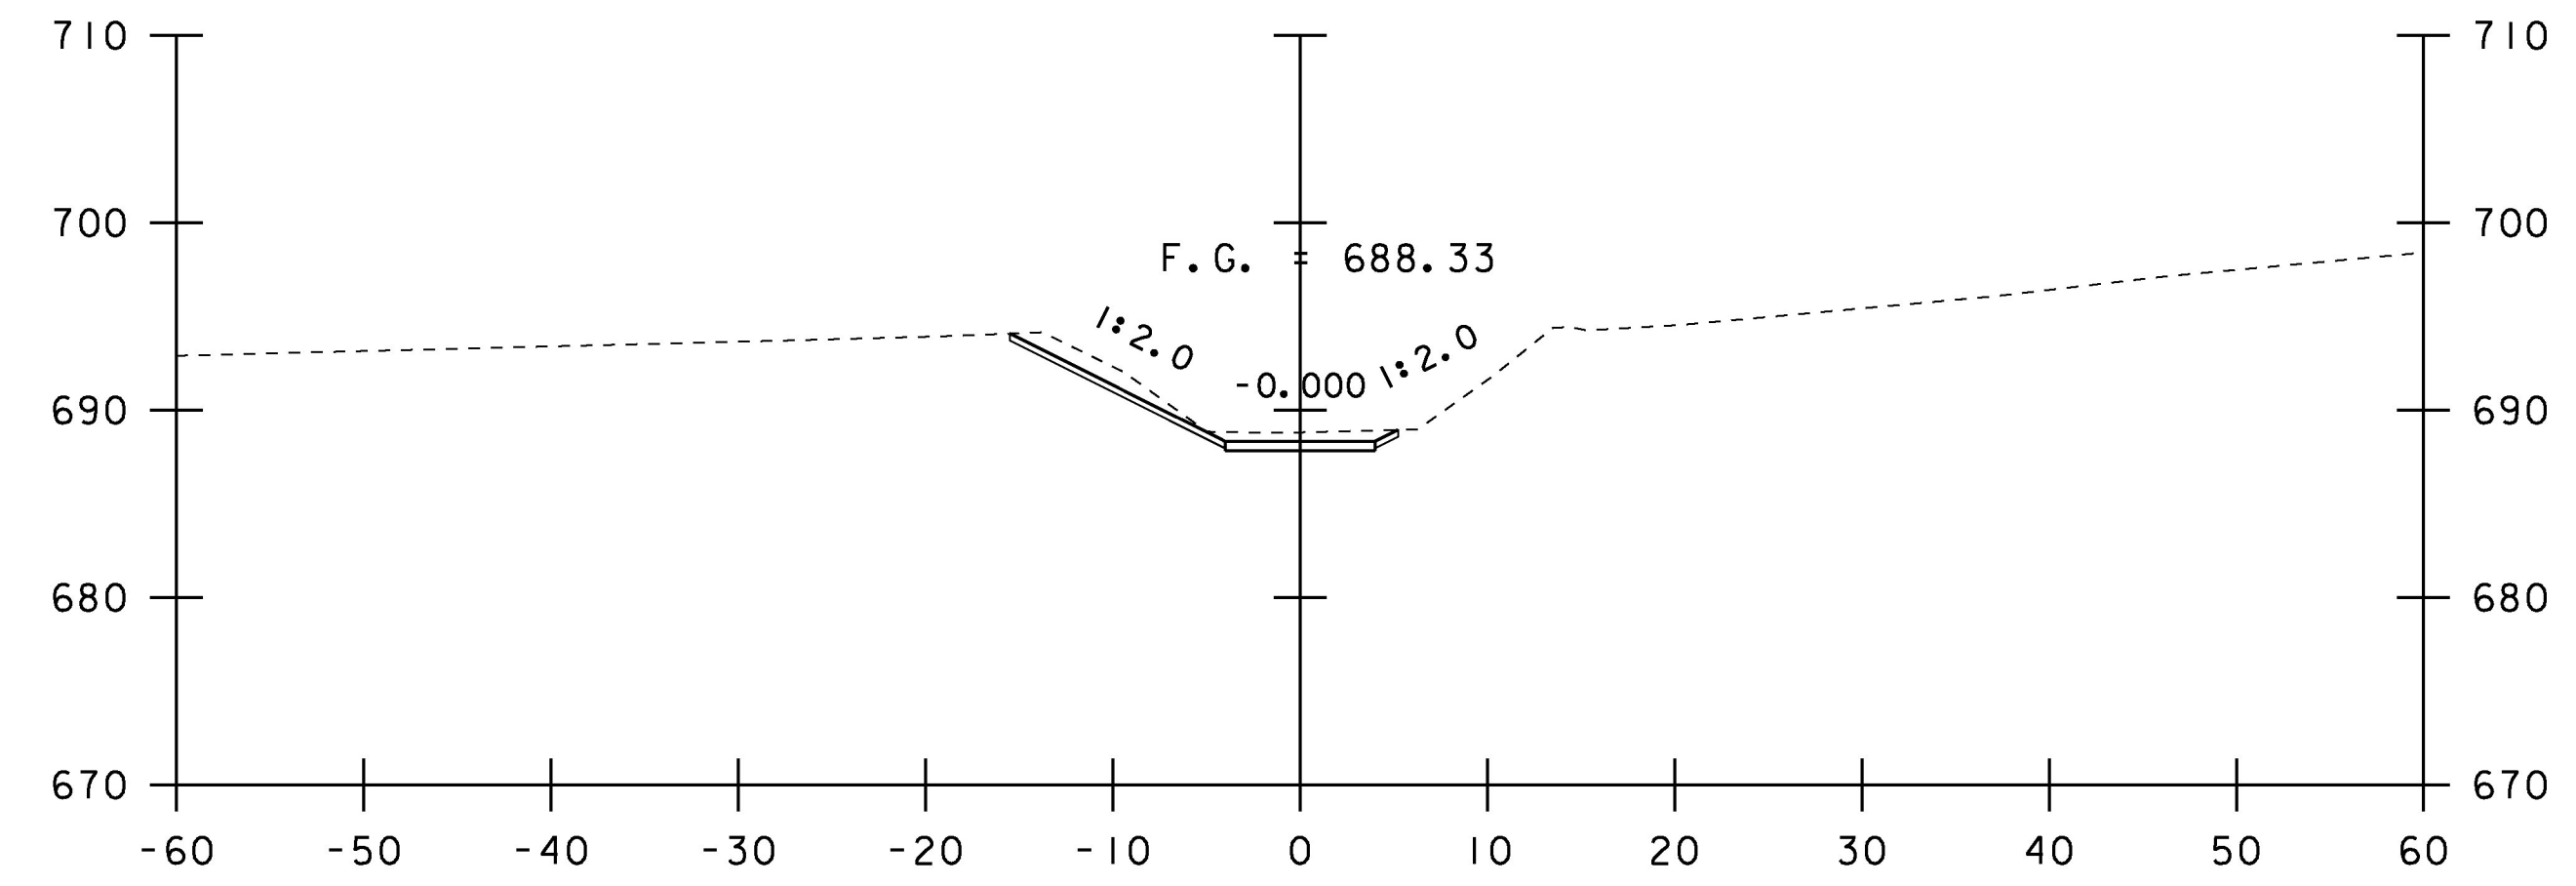

I+60

STA. I+45 TO STA. I+75

PROJECT NAME:	MORRISTOWN
PROJECT NUMBER:	BRS 0240(3)S/STP HES 030-2(28)
FILE NAME:	s78f329xs.dgn
PROJECT LEADER:	C. CARLSON
DESIGNED BY:	C. BURRALL
PRECAST CATTLE PASS SECTIONS SHEET I	SHEET 134 OF 175
PLOT DATE:	12-APR-2017
DRAWN BY:	G. ROKES
CHECKED BY:	J. LACROIX