




401+20

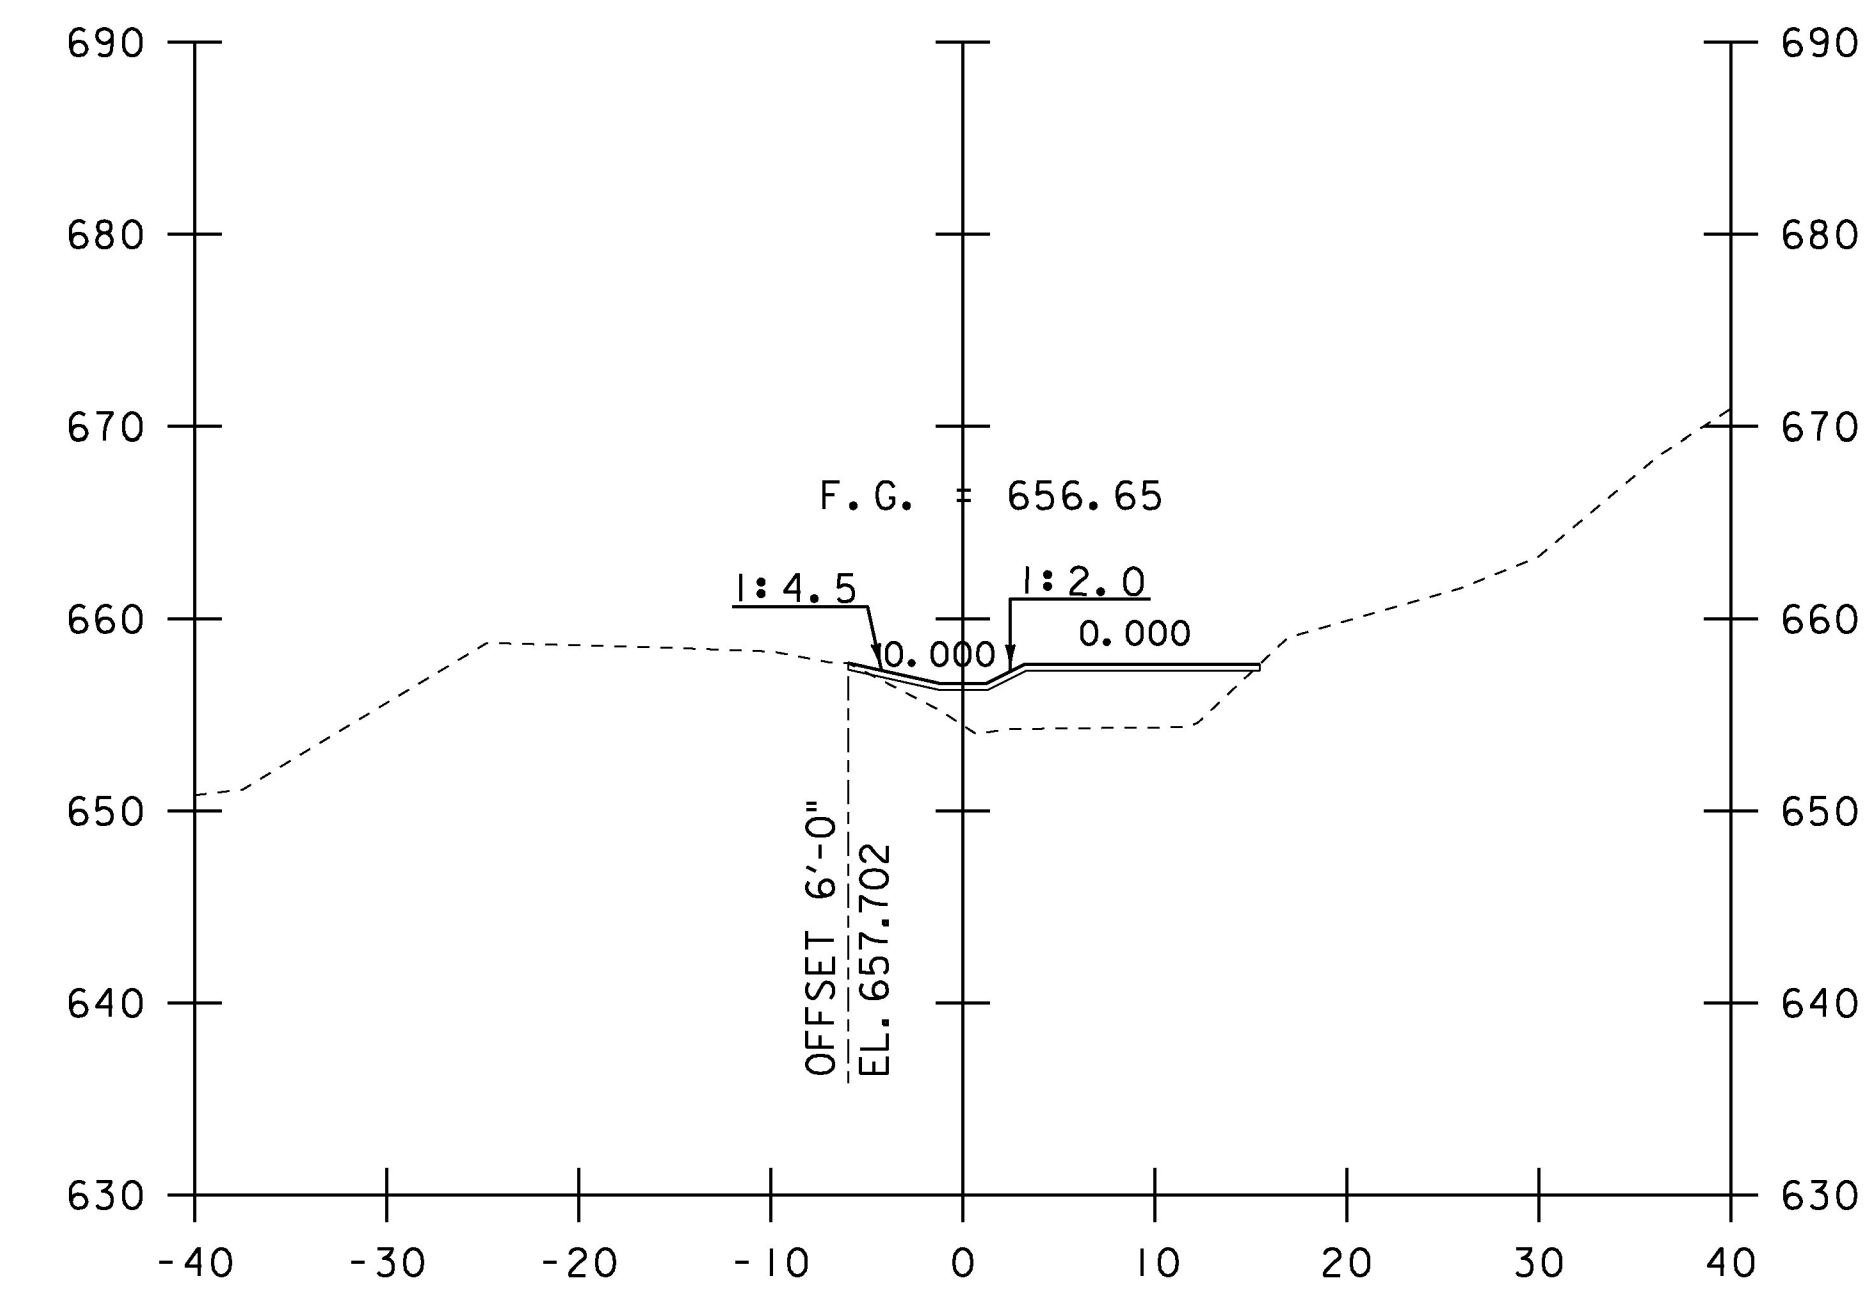


401+50

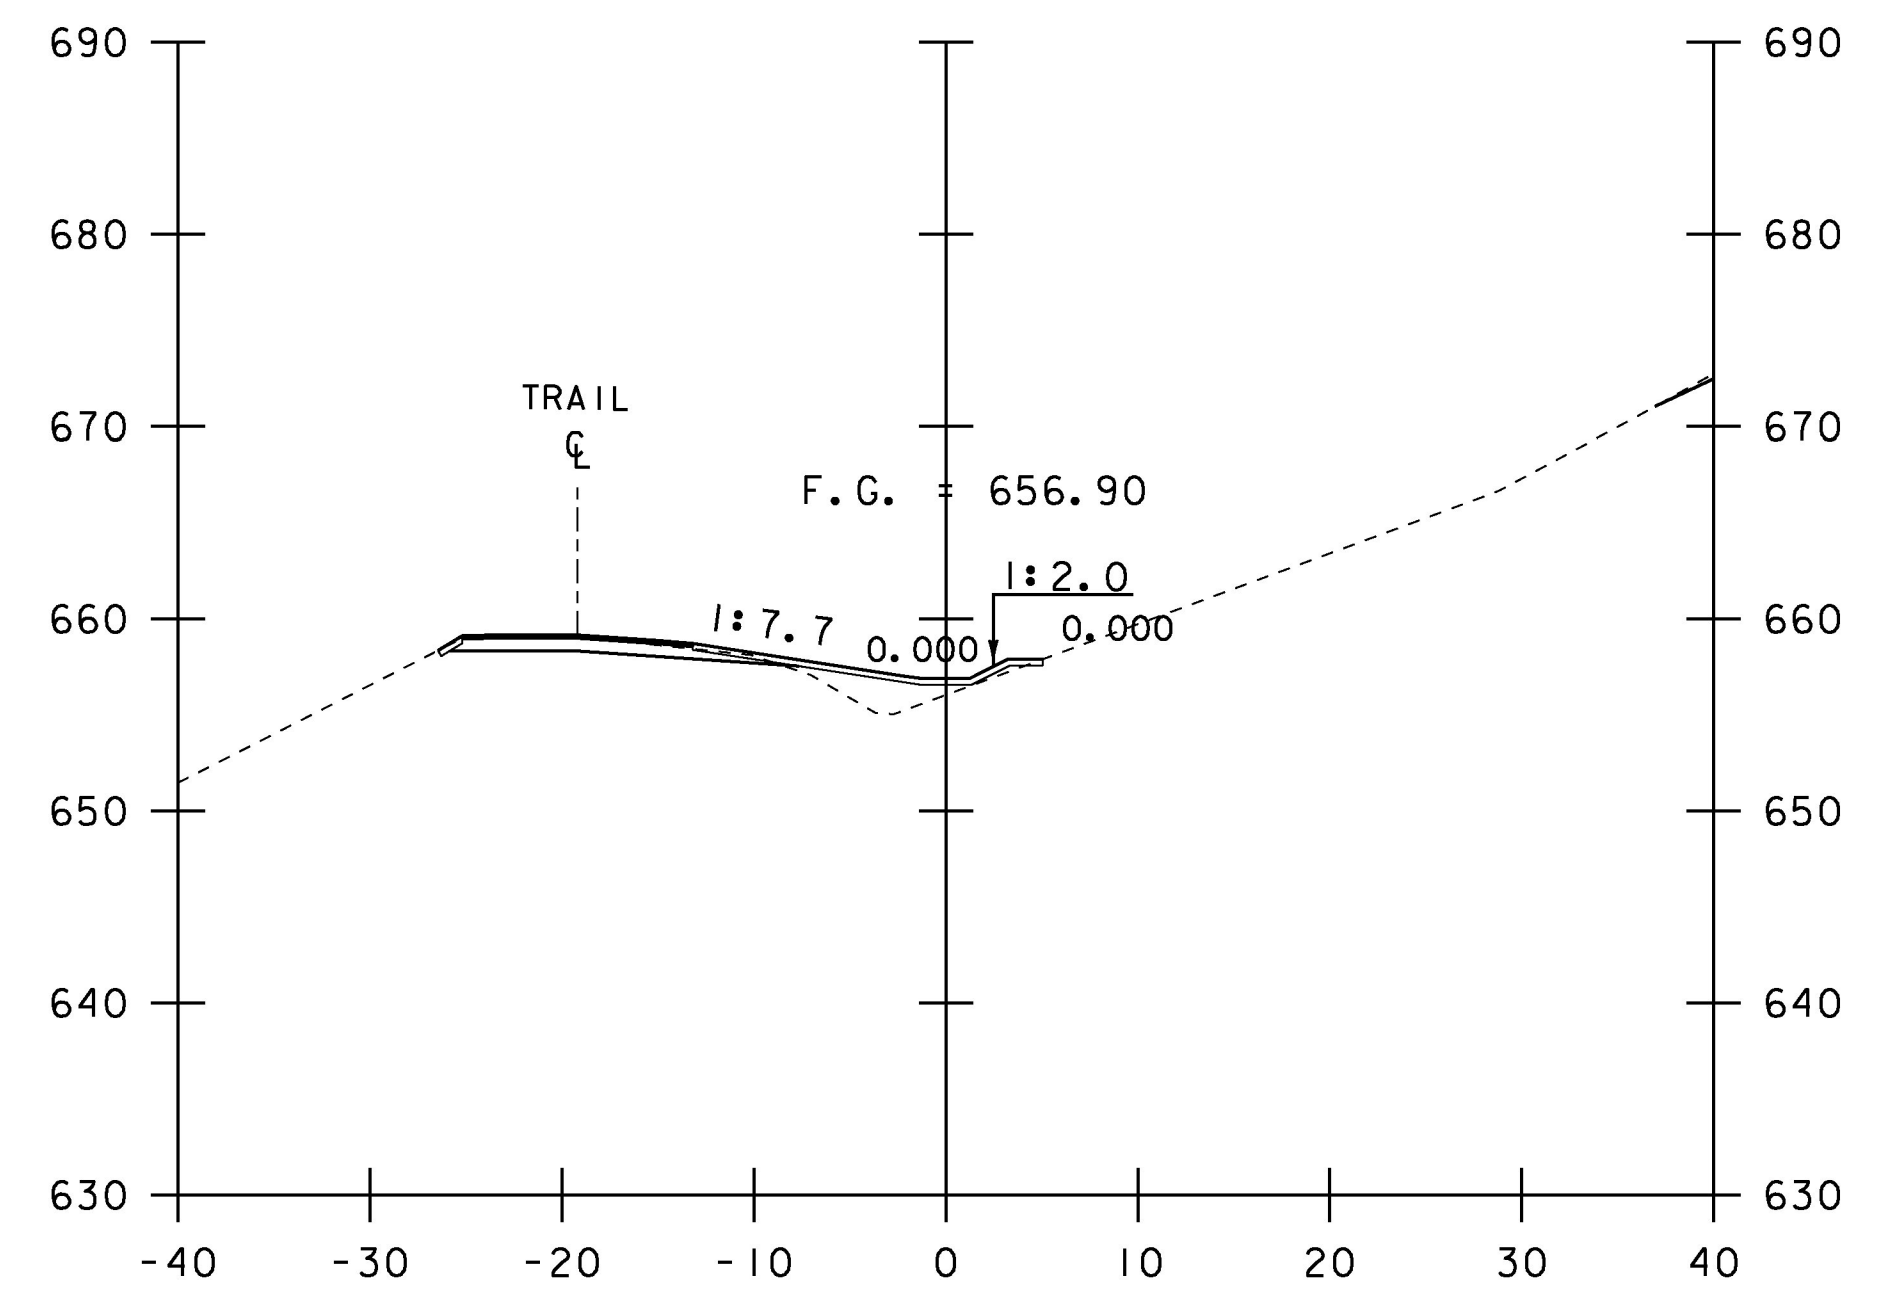


402+00

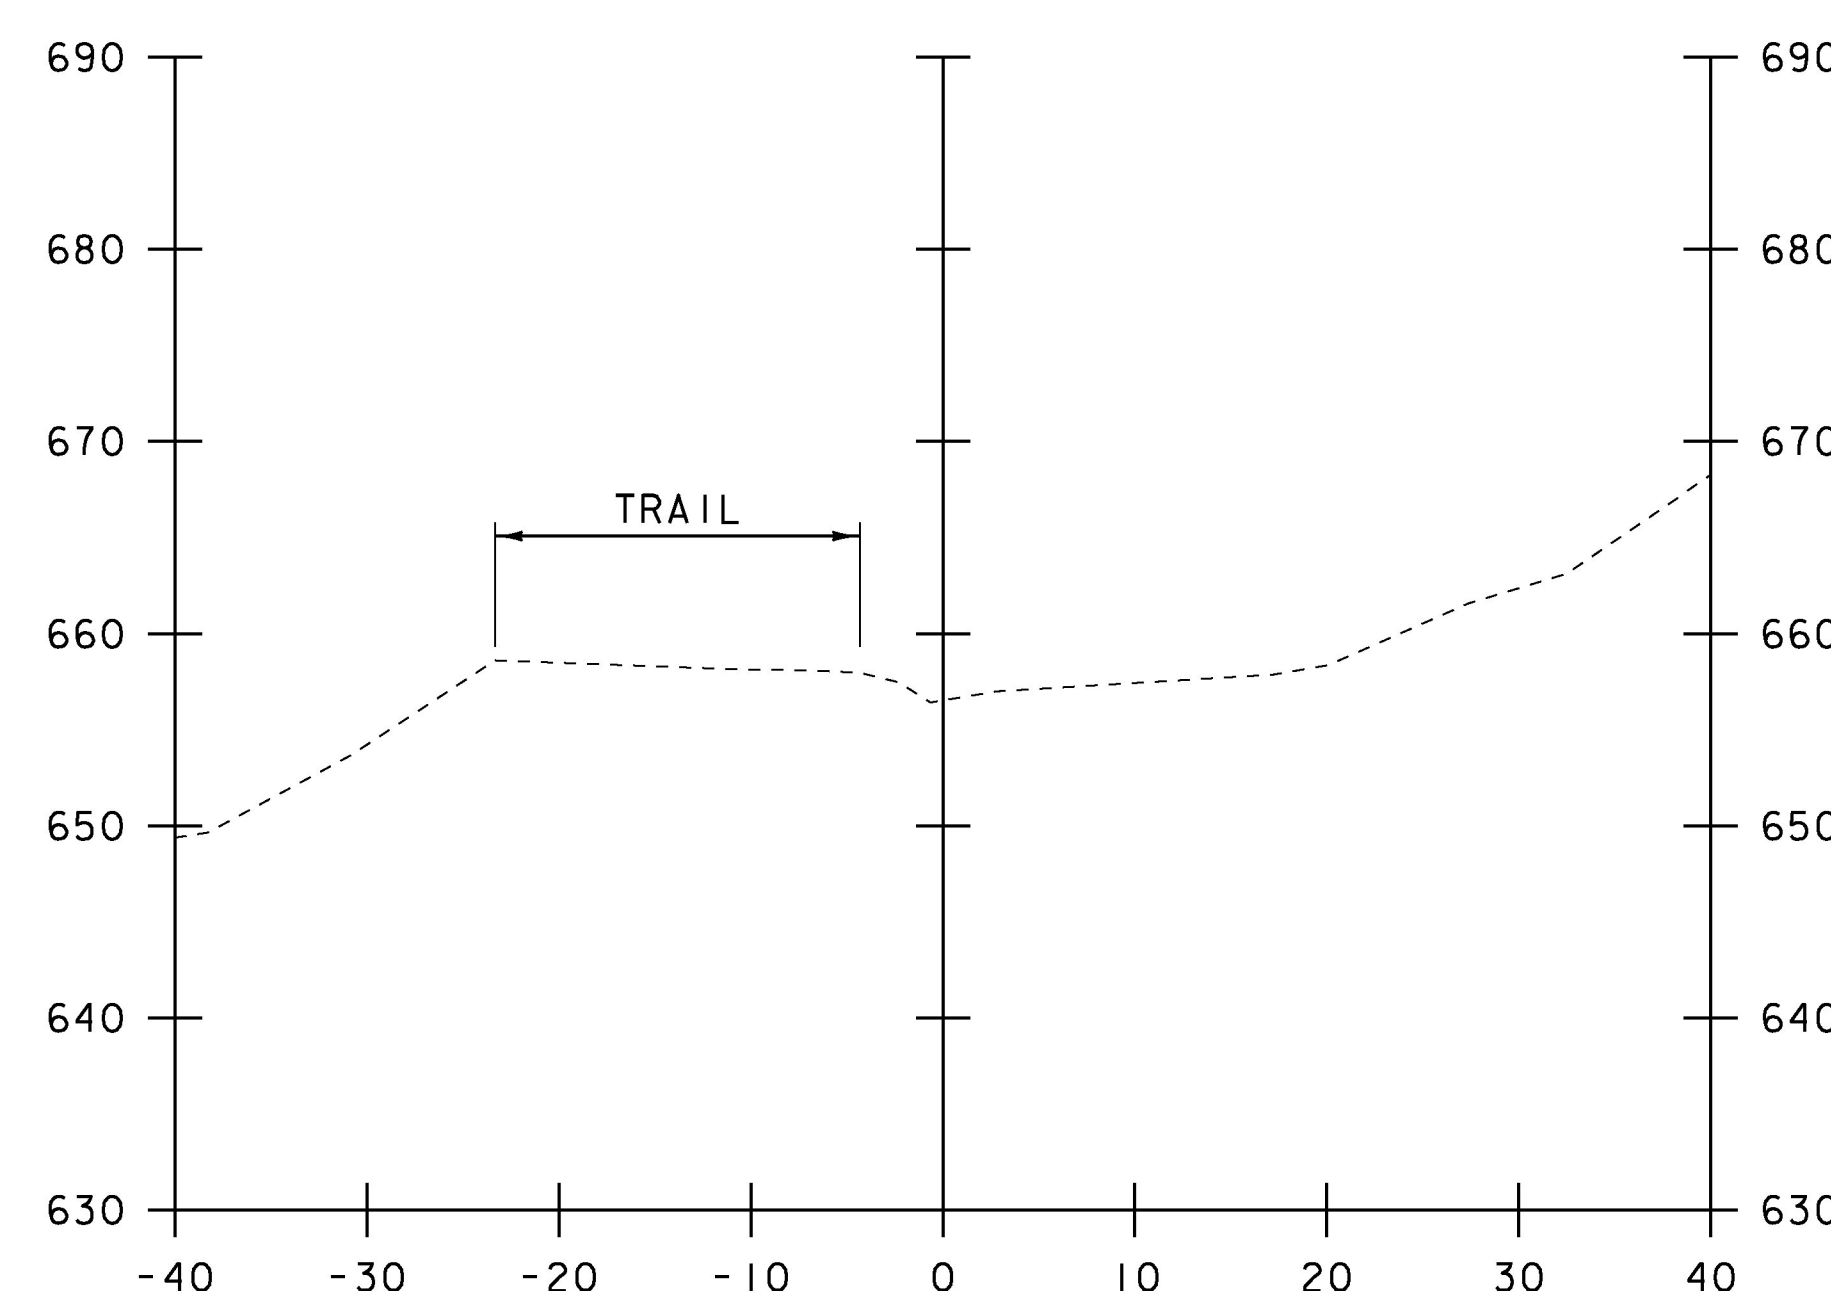

401+10

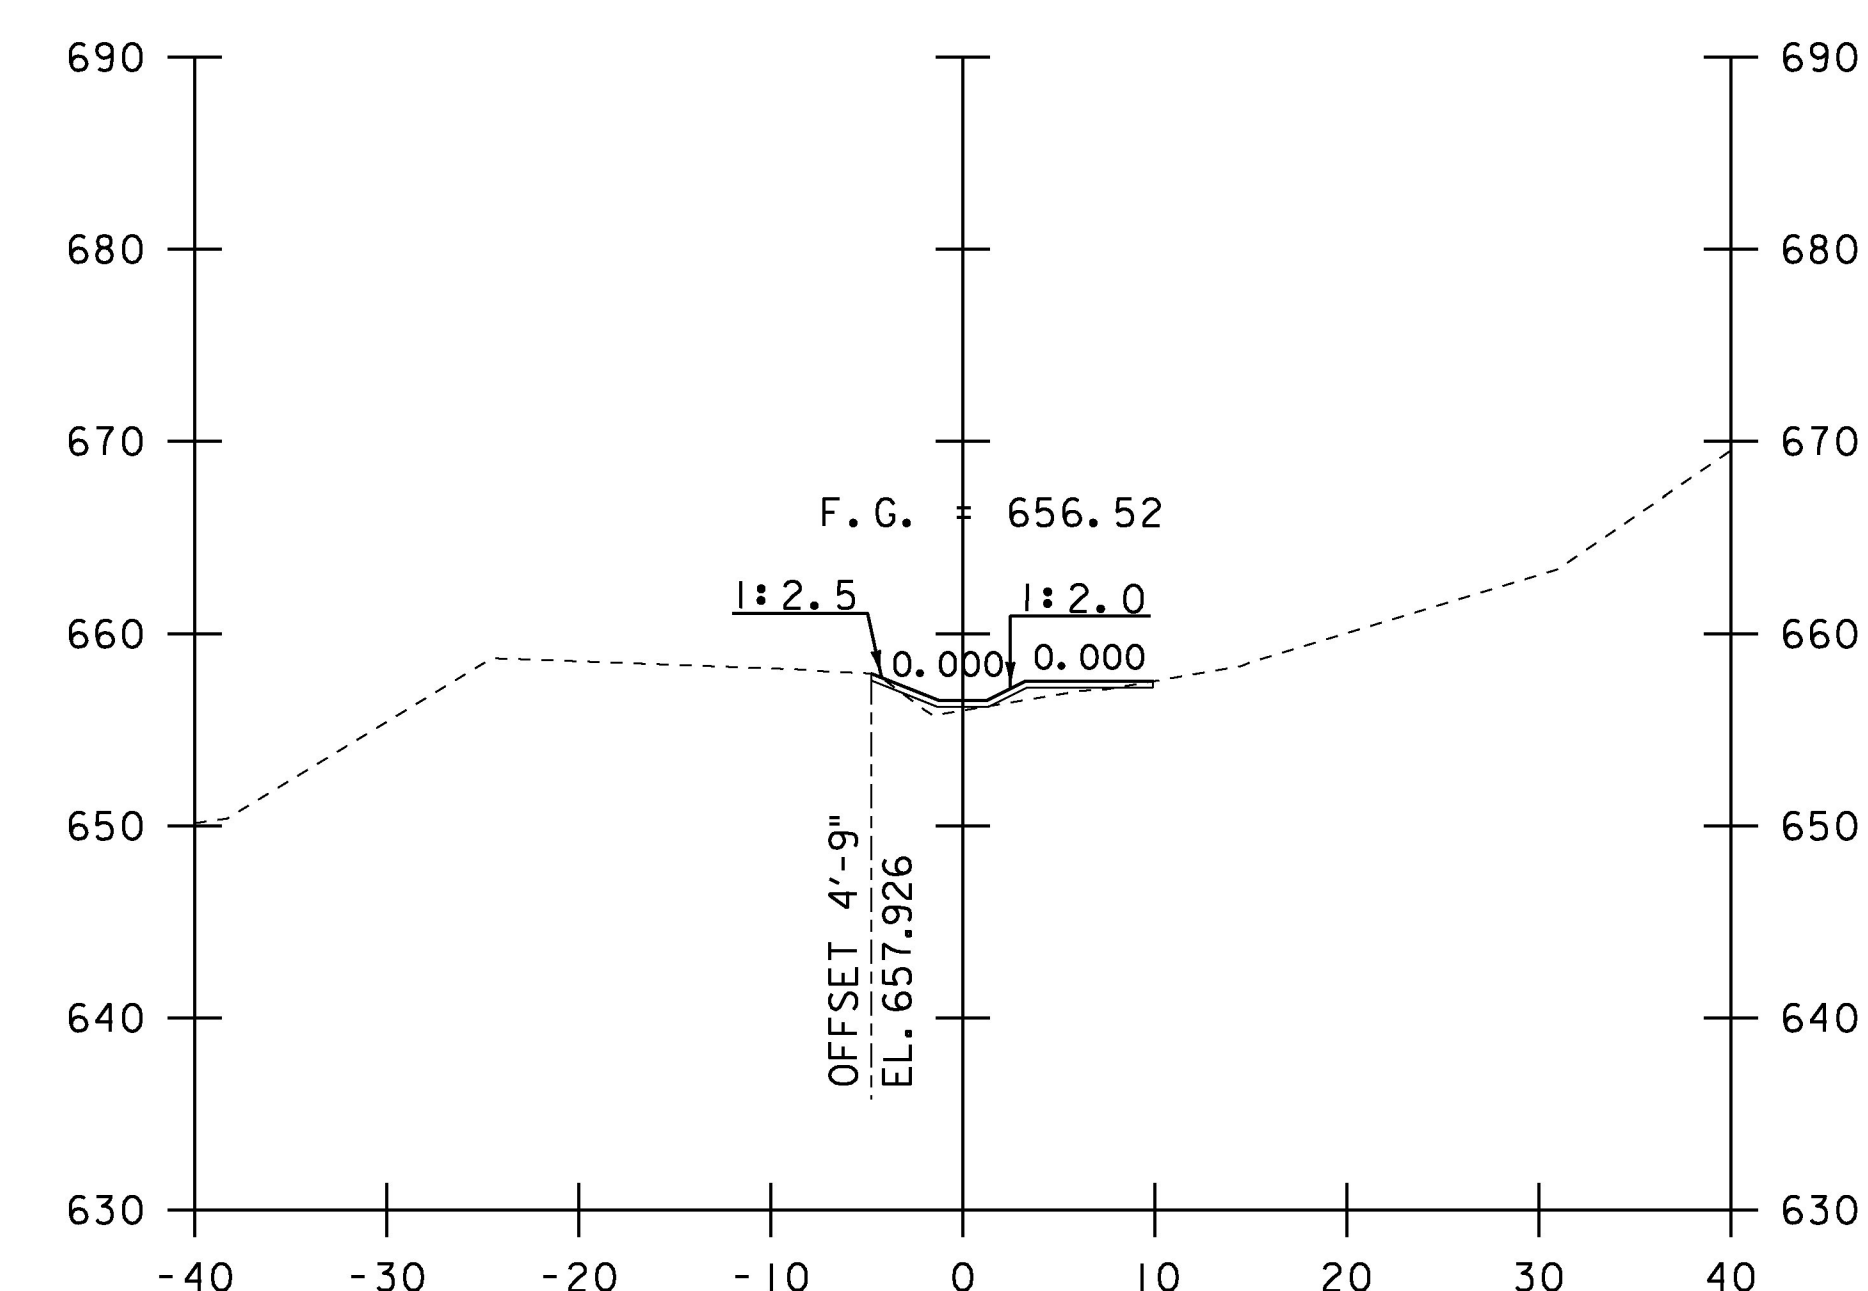

401+25

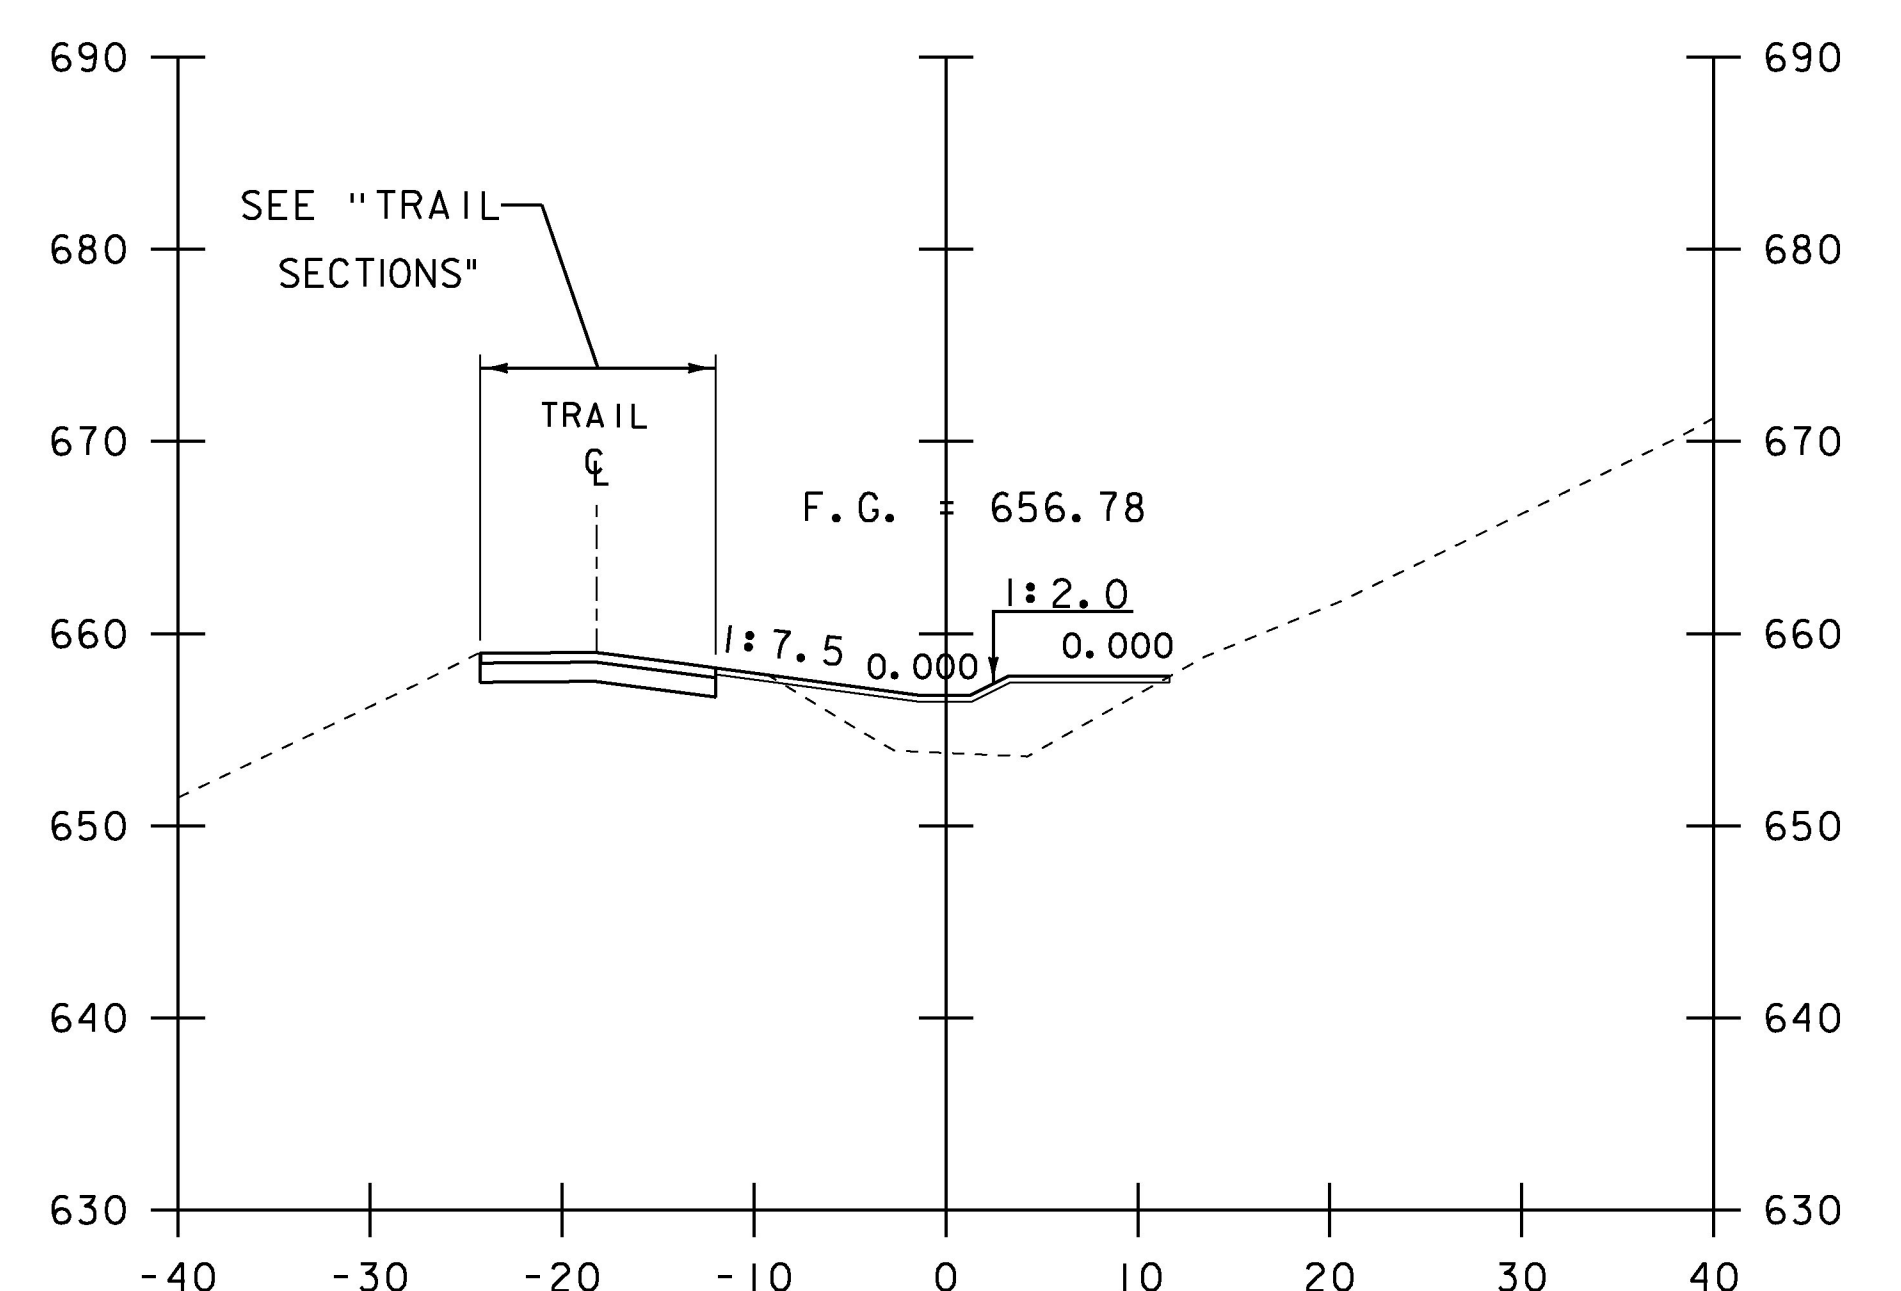

401+75

STA. 401+10 TO STA. 402+00

PROJECT NAME:	MORRISTOWN
PROJECT NUMBER:	BRS 0240(3)S/STP HES 030-2(28)
FILE NAME:	s78f329xs.dgn
PROJECT LEADER:	C. CARLSON
DESIGNED BY:	C. BURRALL
PLOT DATE:	12-APR-2017
DRAWN BY:	G. ROKES
CHECKED BY:	J. LACROIX
GRASS TREATMENT SWALE SECTIONS SHEET	1 SHEET 137 OF 175