




402+50

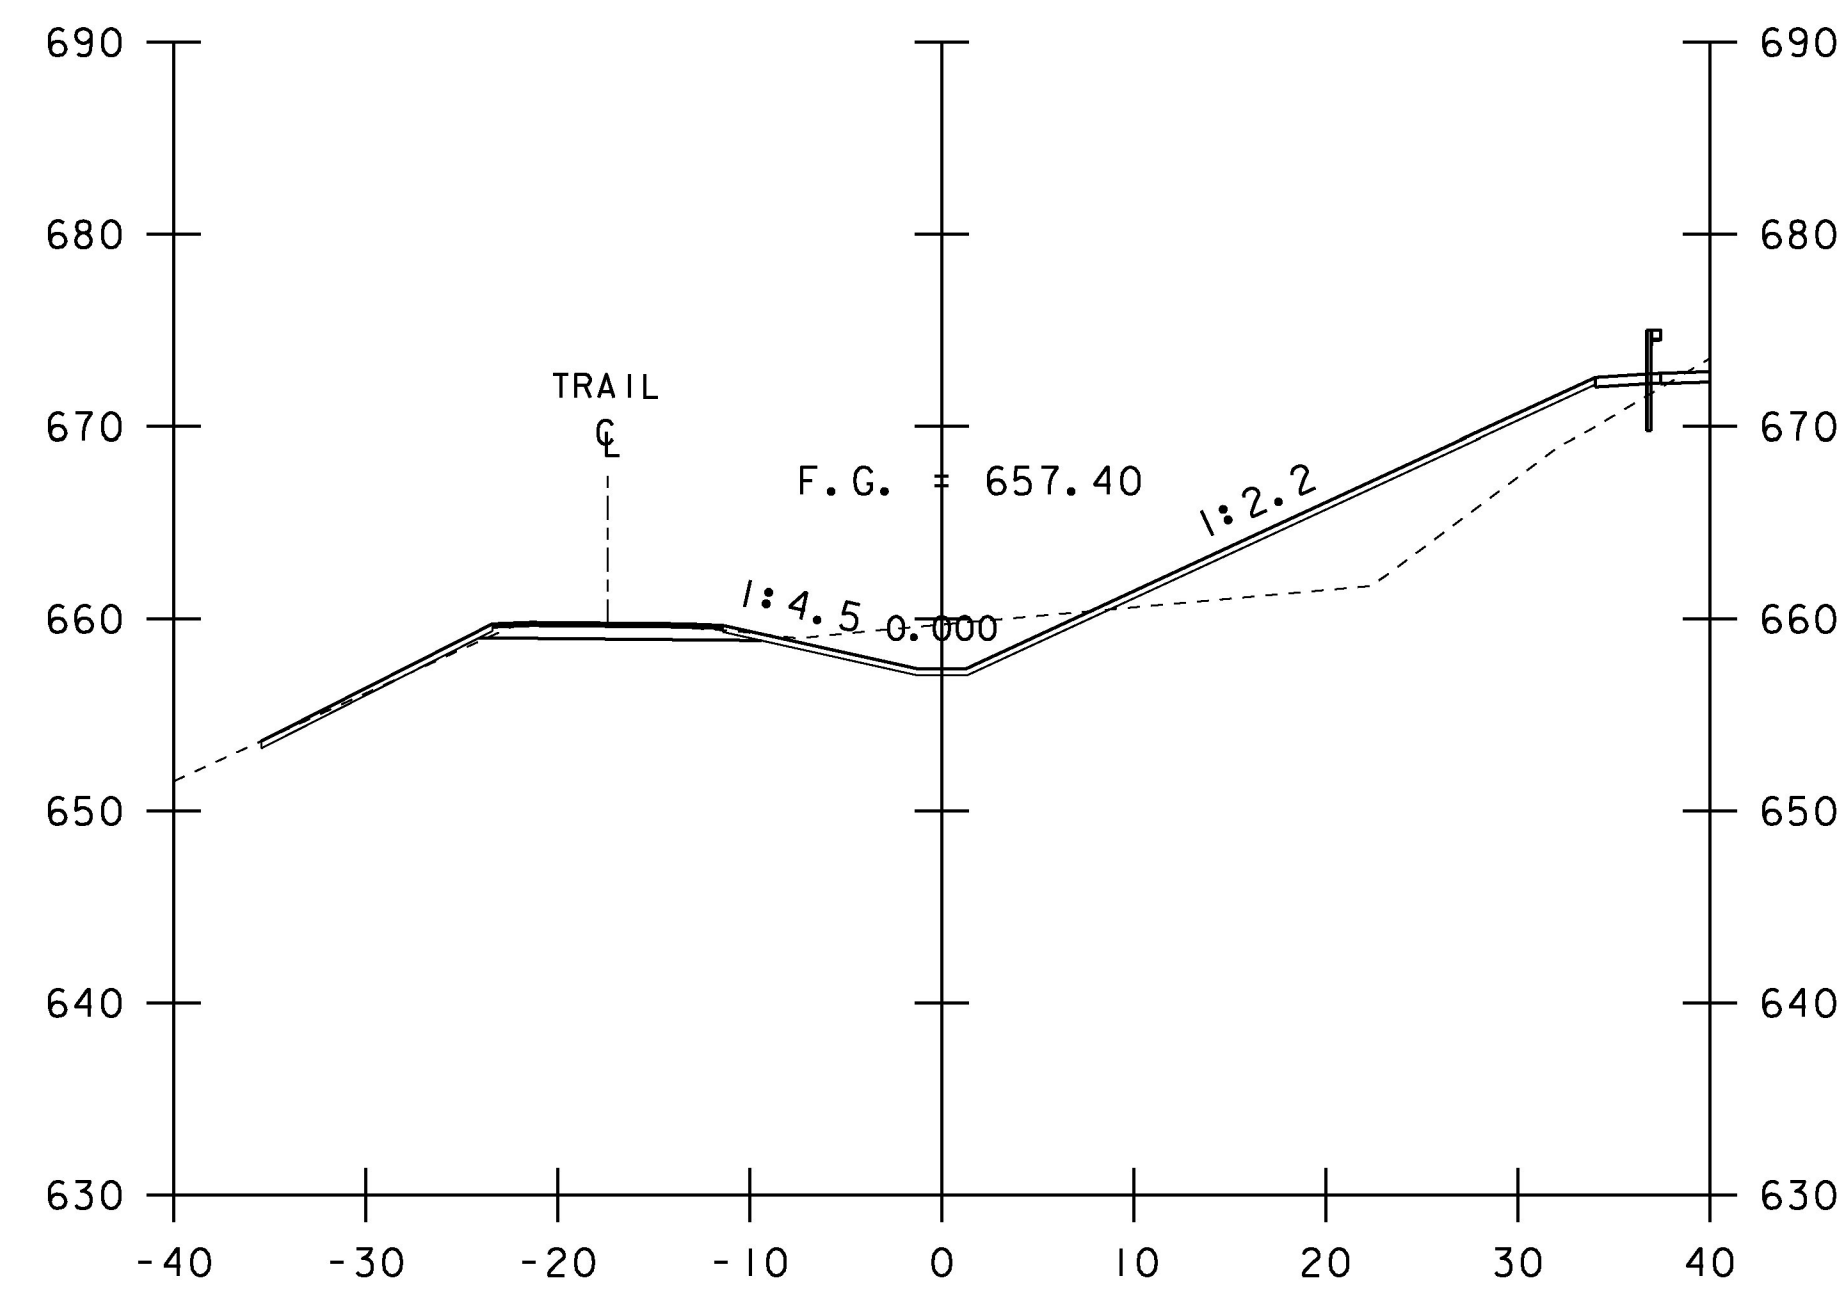


403+00

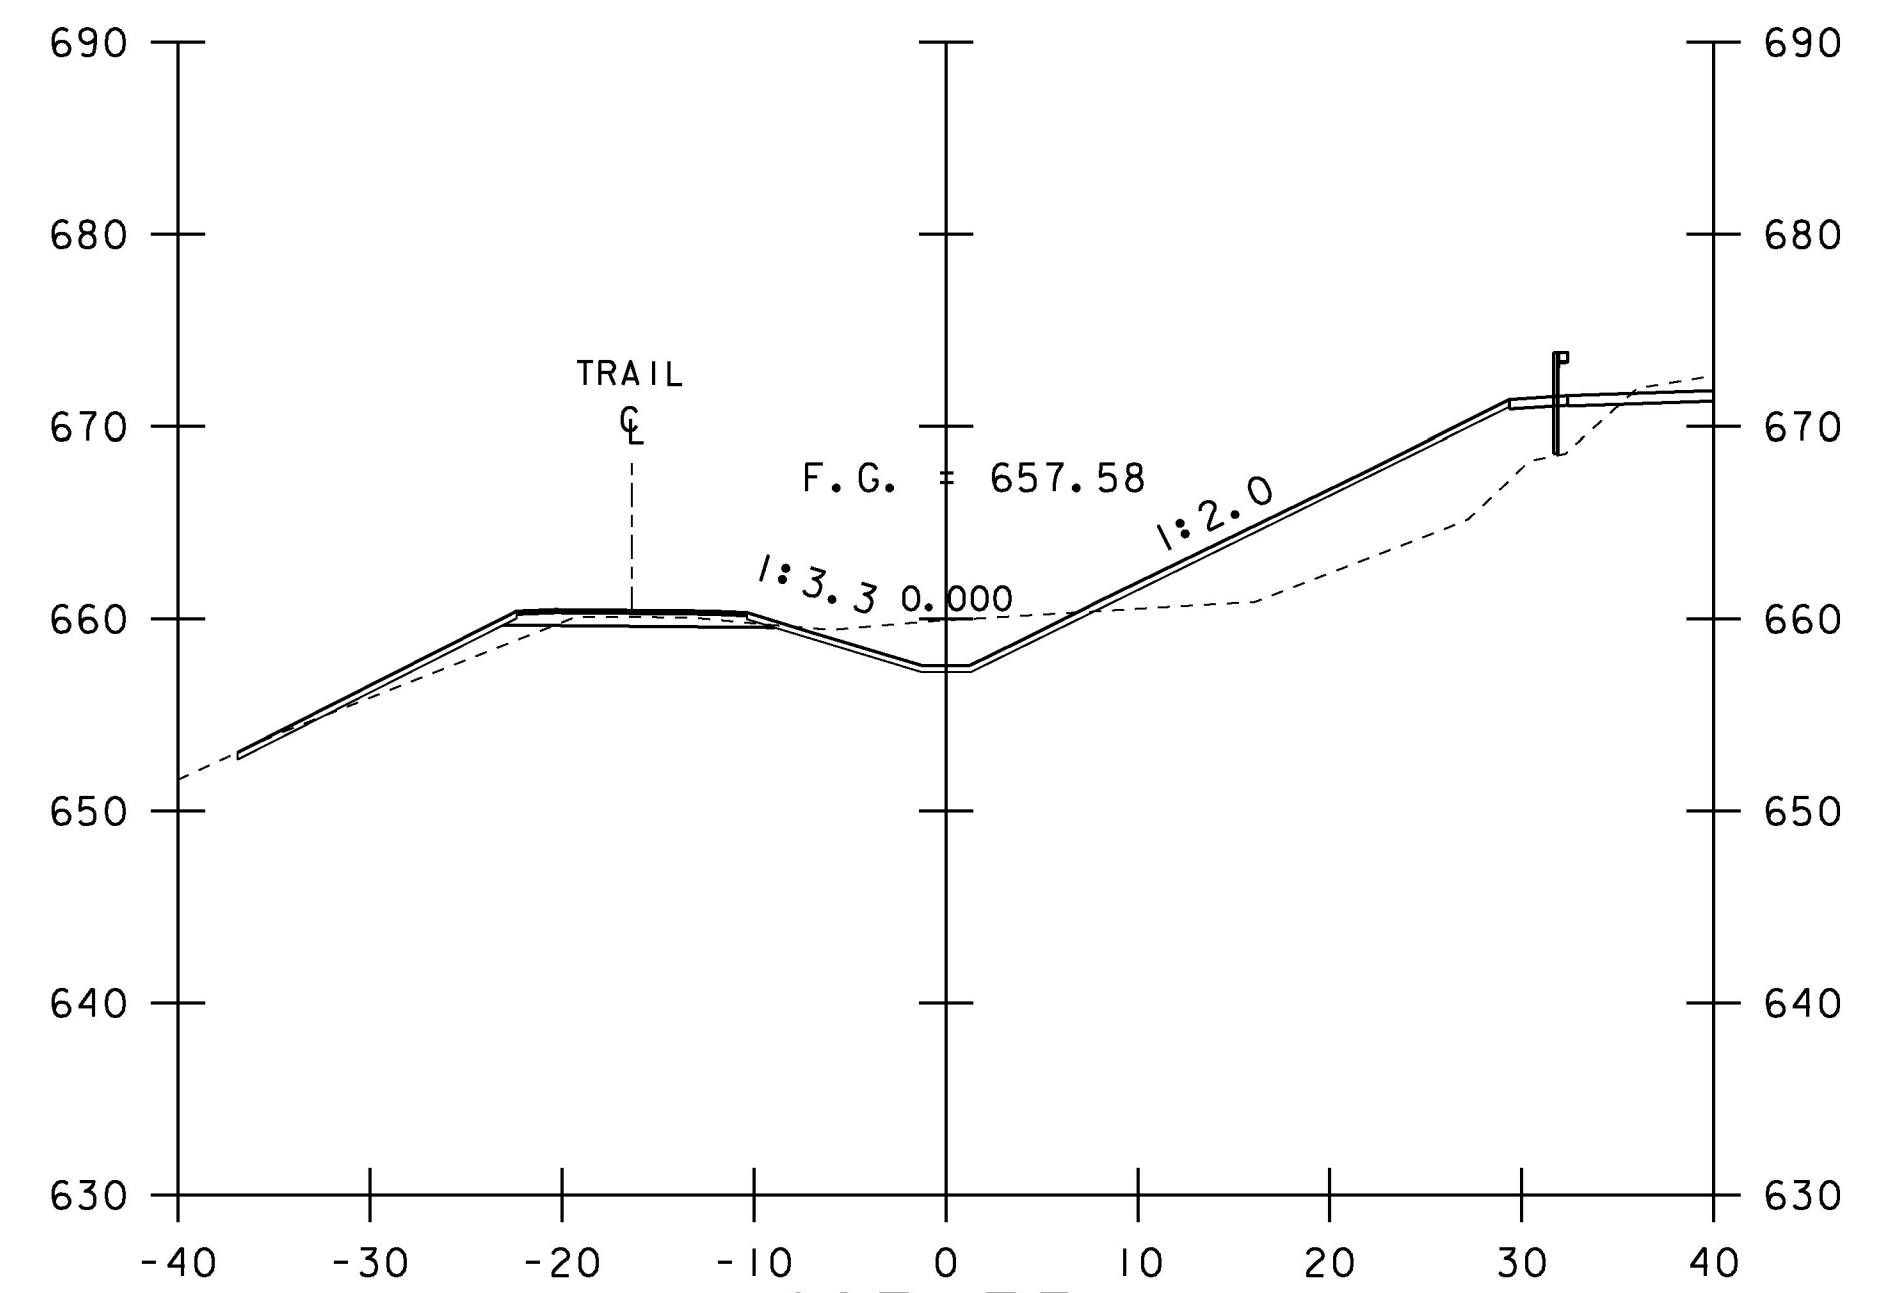


403+35

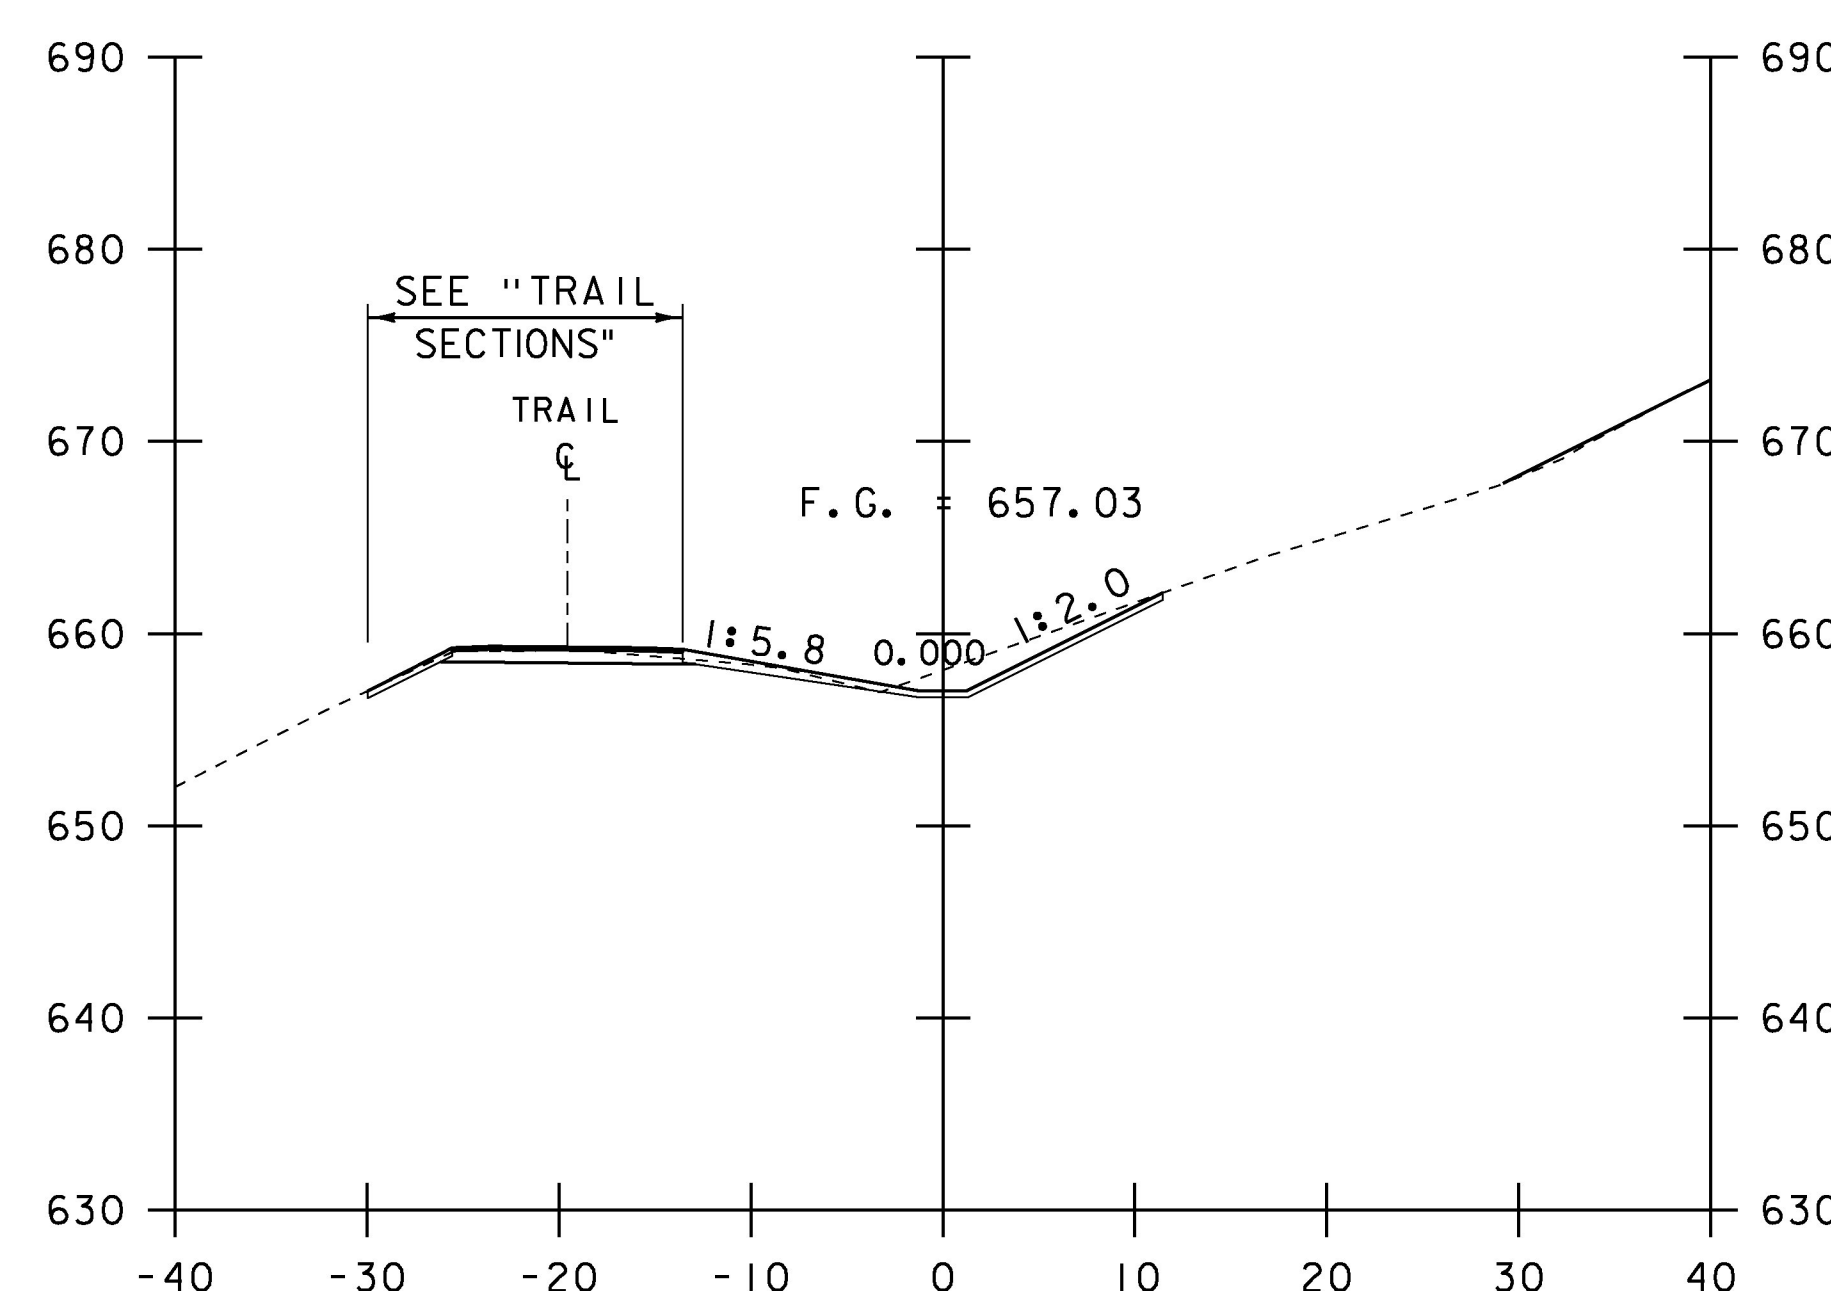

402+25

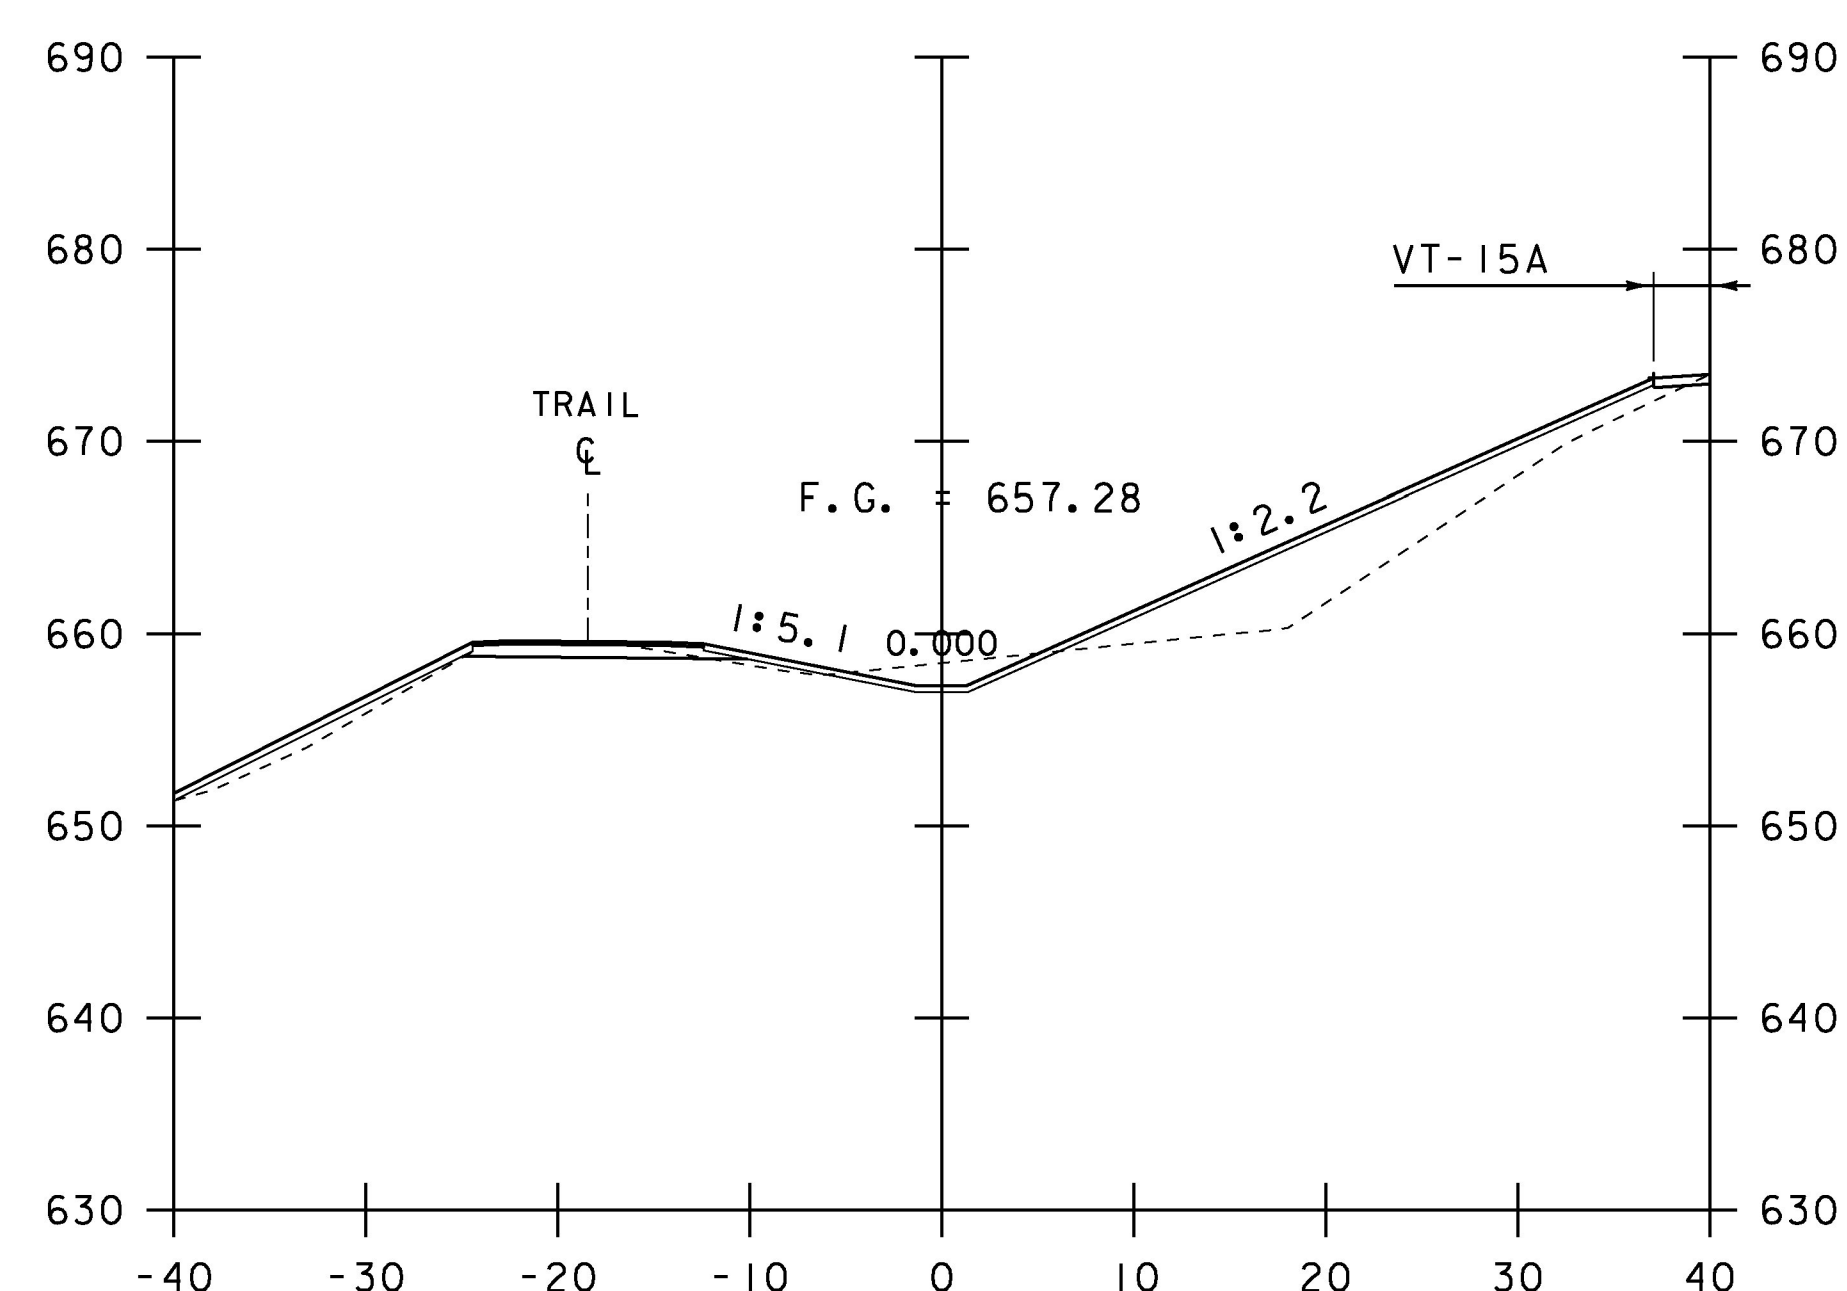

402+75

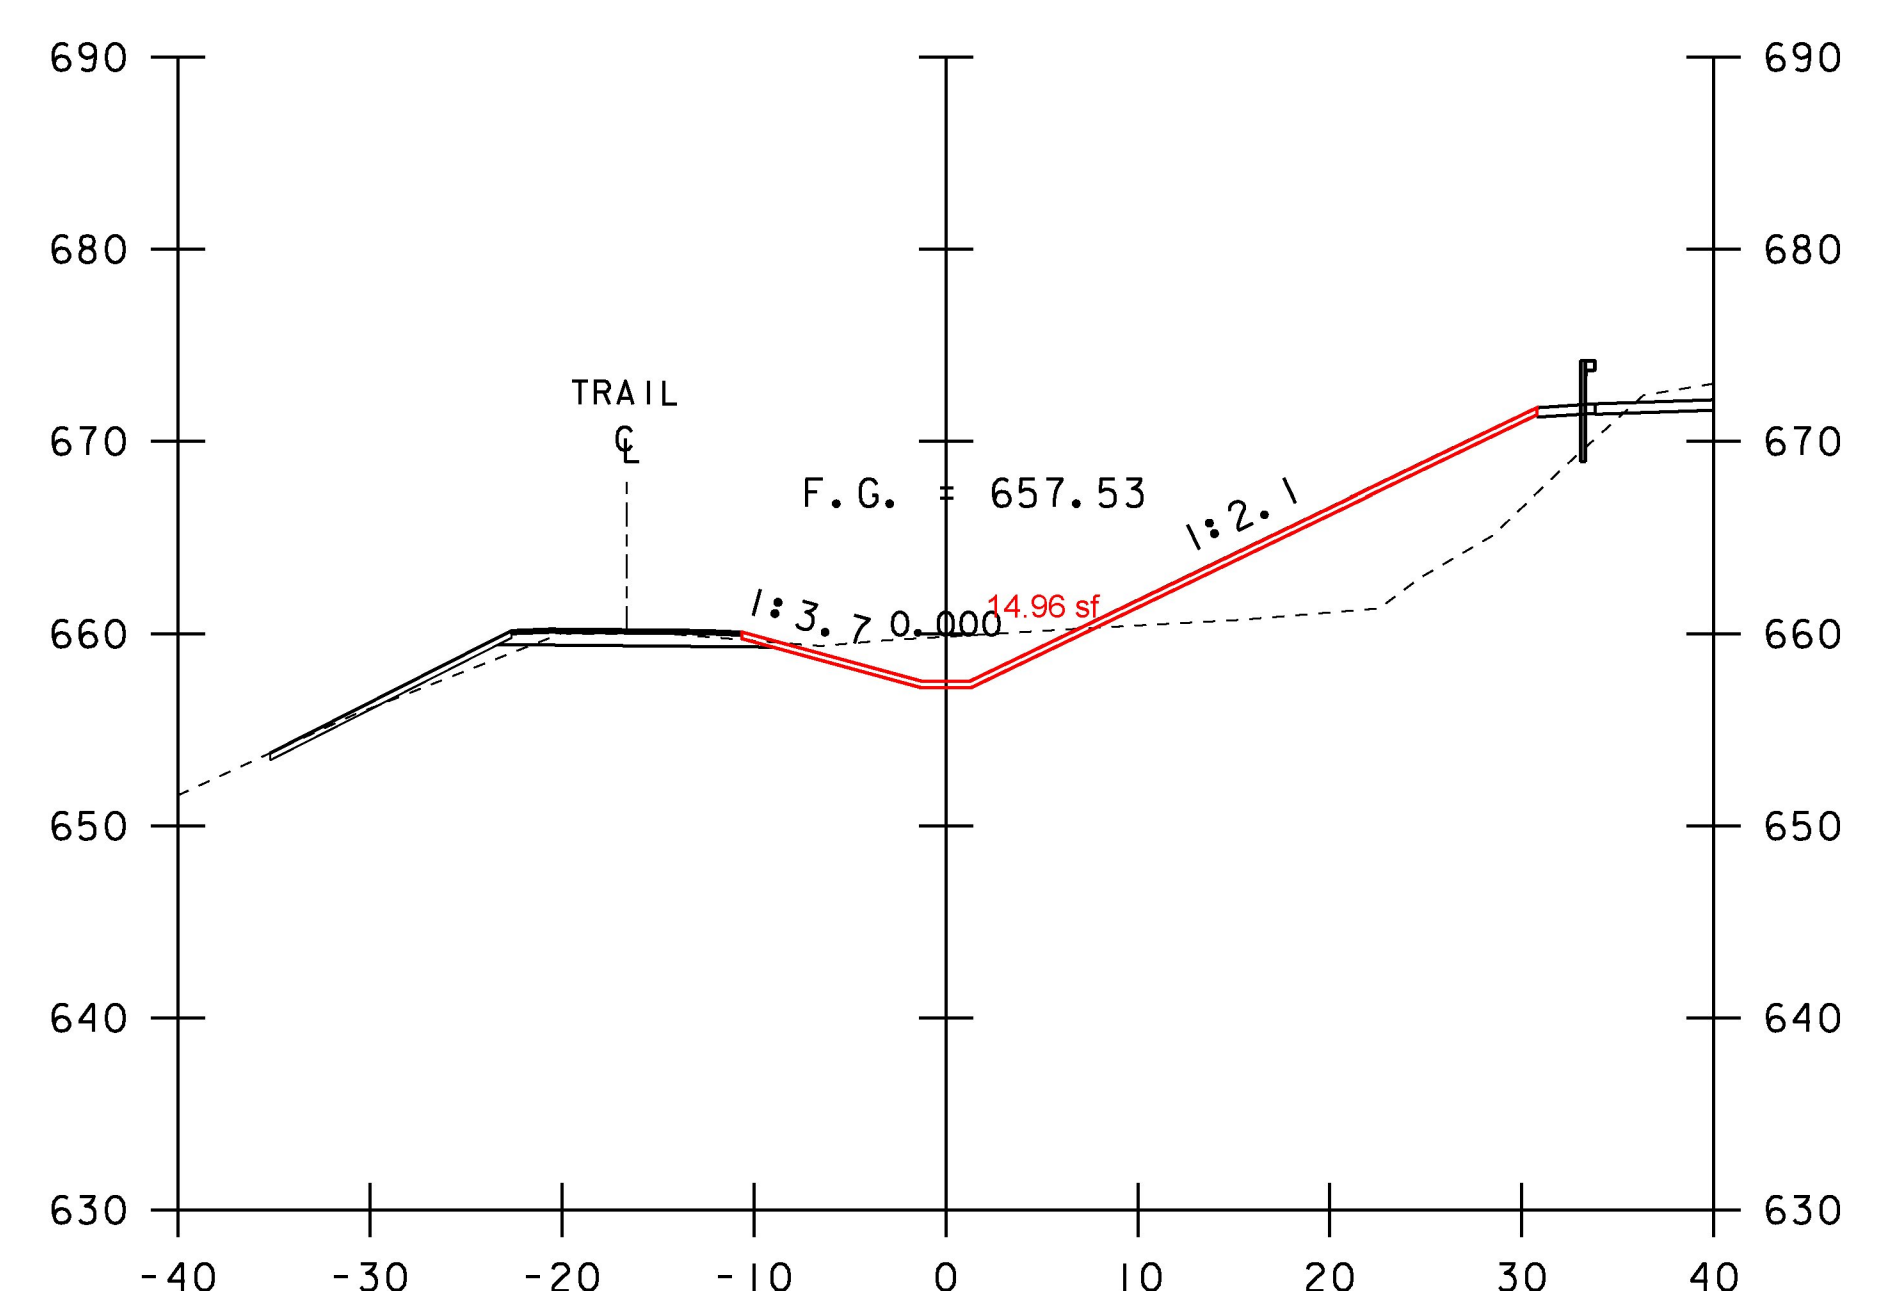

403+25

STA. 402+25 TO STA. 403+35

PROJECT NAME:	MORRISTOWN
PROJECT NUMBER:	BRS 0240(3)S/STP HES 030-2(28)
FILE NAME:	s78f329xs.dgn
PROJECT LEADER:	C. CARLSON
DESIGNED BY:	C. BURRALL
GRASS TREATMENT SWALE SECTIONS SHEET	2 SHEET 138 OF 175
PLOT DATE:	12-APR-2017
DRAWN BY:	G. ROKES
CHECKED BY:	J. LACROIX