


VIEW T-T (TOP FLANGE)
SECTION B-B (BTM FLANGE)

FLANGE DIAGRAM FOR 6G1B THRU 10G5B

LOCATION	RAD	ARC	CHD	AA	EA	A1	A2	A3	A4	AB	CA	EB	B1	B2	B3	B4	WL1	WL2	HD1	PL PA (M270-SOWT2)	PL PB (M270-SOWT2)
6G1B TOP FLG	622.12	109'-2 1/2	109'-0 13/16	49'-11 5/8	3/8	6	5 5/8	4 1/2	2 5/8	6'-2 15/16	49'-11 7/16	1/2	8 7/16	7 15/16	6 5/16	3 11/16	49'-10 13/16	59'-2	2'-4 1/2	PL 7/8 x 20-ta (2/L)	PL 7/8 x 20-tb (2/E)
6G1B BTM FLG	622.12	109'-3 1/16	109'-1 3/8	50'-0 3/16	3/8	6	5 5/8	4 1/2	2 5/8	6'-3	50'-0	1/2	8 7/16	7 15/16	6 5/16	3 11/16	49'-11 5/16	59'-2 1/16	2'-4 9/16	PL 7/8 x 20-ba (2/L)	PL 7/8 x 20-bb (2/E)
7G2B TOP FLG	629.37	110'-5 13/16	110'-4 1/8	51'-2 15/16	7/16	6 1/4	5 7/8	4 11/16	2 3/4	6'-4 7/8	51'-2 3/4	1/2	8 3/8	7 13/16	6 1/4	3 11/16	51'-2 1/16	59'-2 1/16	2'-4 15/16	PL 7/8 x 20-ta (2/J)	PL 7/8 x 20-tb (2/E)
7G2B BTM FLG	629.37	110'-6 5/16	110'-4 5/8	51'-3 7/16	7/16	6 1/4	5 7/8	4 11/16	2 3/4	6'-4 15/16	51'-3 1/4	1/2	8 3/8	7 13/16	6 1/4	3 11/16	51'-2 5/8	59'-2	2'-4 15/16	PL 7/8 x 20-ba (2/J)	PL 7/8 x 20-bb (2/E)
8G3B TOP FLG	636.62	111'-9 3/16	111'-7 7/16	52'-6 5/16	7/16	6 1/2	6 1/16	4 7/8	2 13/8	6'-6 3/4	52'-6 8/16	7/16	8 1/4	7 3/4	6 3/8	3 5/8	52'-5 1/16	59'-2	2'-5 5/16	PL 7/8 x 20-ta (2/G)	PL 7/8 x 20-tb (2/E)
8G3B BTM FLG	636.62	111'-9 1/2	111'-7 13/16	52'-6 5/8	7/16	6 1/2	6 1/8	4 7/8	2 7/8	6'-6 13/16	52'-6 7/16	7/16	8 1/4	7 3/4	6 3/16	3 5/8	52'-5 3/4	59'-2 1/16	2'-5 5/16	PL 7/8 x 20-ba (2/G)	PL 7/8 x 20-bb (2/E)
9G4B TOP FLG	643.87	113'-0 9/16	112'-10 13/16	53'-9 11/16	7/16	6 3/4	6 5/16	5 1/16	2 15/8	6'-8 11/16	53'-9 1/2	7/16	8 3/16	7 11/16	6 1/8	3 9/16	53'-8 13/16	59'-2	2'-5 11/16	PL 1 1/8 x 20-ta (2/C)	PL 1 1/8 x 20-tb (1/G)
9G4B BTM FLG	643.87	113'-0 3/4	112'-11	53'-9 7/16	7/16	6 3/4	6 5/16	5 1/16	2 15/8	6'-8 11/16	53'-9 11/16	7/16	8 3/16	7 11/16	6 1/8	3 9/16	53'-9	59'-2	2'-5 11/16	PL 1 3/4 x 20-ba (1/E)	PL 1 3/4 x 20-bb (1/A)
10G5B TOP FLG	651.12	114'-3 15/16	114'-2 3/16	55'-1 1/16	7/16	7	6 9/16	5 1/4	3 1/16	6'-10 5/8	55'-0 7/8	7/16	8 1/16	7 9/16	6 1/16	3 9/16	55'-0 3/16	59'-2	2'-6 1/16	PL 1 1/8 x 20-ta (1/Y)	PL 1 1/8 x 20-tb (1/G)
10G5B BTM FLG	651.12	114'-3 15/16	114'-2 3/16	55'-1 1/16	7/16	7	6 9/16	5 1/4	3 1/16	6'-10 5/8	55'-0 7/8	7/16	8 1/16	7 9/16	6 1/16	3 9/16	55'-0 3/16	59'-2	2'-6 1/16	PL 1 3/4 x 20-ba (1/C)	PL 1 3/4 x 20-bb (1/A)

Vermont Agency of Transportation
RECEIVED
10-5-17_713_Shop_Drawings_REV2.pdf
CK'D BY CLB OK'D BY CWC
October 5, 2017
RESUBMIT NO Approved
BY C. CARLSON DATE 10/05/17

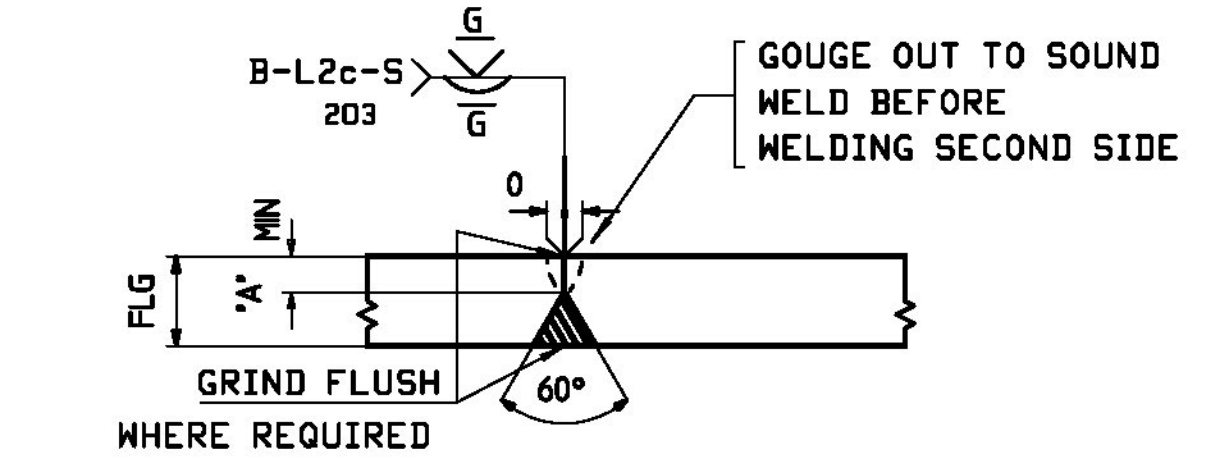

DIRECTION OF GRINDING
FLANGE PLATE SPLICE DETAIL "FA"

FLG	'A'
7/8	1/4
1 1/8	3/8
3/4	1/2

- NOTES:
1. FOR GENERAL NOTES SEE DRAWING GNI.
2. T2 DENOTES MATERIAL SUBJECT TO CHARPY V-NOTCH TEST AT H FREQ. FOR ZONE 2
3. TRIM FLANGES AFTER ASSEMBLY.

REV.	DATE	REMARKS	DWN	CHK	APVL	SHOP
0						
MATERIAL:		SURFACE PREP. & PAINT:		HOLES:		SHOP BOLTS:
M270-SOWT2		SEE DWG GNI				
DESCRIPTION: FLANGE DIAGRAMS						
			CASCO BAY STEEL STRUCTURES, INC. 1 WALLACE AVE. PHONE (207) 780-6722 SOUTH PORTLAND, ME 04106 FAX. (207) 780-6726 			
STRUCTURE: VT RTE 15A OVER LAMOILLE RIVER			DRAWN: JTJ		DATE: 08/01	
ROUTE No. VT 15A, MAJOR COLLECTOR			CHKD: WJL		DATE: 08/30	
BRIDGE No. 1						
COUNTY OF LAMOILLE						
LOCATION: MORRISTOWN, VT			JOB NO. 713		DWG NO. F2	
PROJ NO. BRS-0240(3)S & STP HES 030-2(28)						
CUSTOMER: STATE OF VERMONT R.O.T.					REV.	