



RBM INFO		BILL OF MATERIAL				JOB NO.	DRAWING NO.	REV.	
PAGE	LINE	MARK	QTY	MARK	MATERIAL	LENGTH FT INCHES	REMARKS	WT	PROCUREMENT NOTES
		9G4B	1		GIRDER			44344	
3	A		1	wa	PL 1 1/8 x 7/8	59'-2 7/8	M270-SDW12	10810	
3	E		1	wb	PL 1 1/8 x 7/8	59'-2 7/8	M270-SDW12	9821	
2	C		1	ta	PL 1 1/8 x 20	53'-9 1/16	M270-SDW12	4120	
1	G		1	tb	PL 1 1/8 x 20	59'-2 7/8	M270-SDW12	4536	
1	E		1	ba	PL 1 3/4 x 20	53'-9 1/16	M270-SDW12	6410	
1	A		1	bb	PL 1 3/4 x 20	59'-2 7/8	M270-SDW12	7055	
4	M		16	x2d	PL 1/2 x 3	6'-6	M270-SDW	100	

ONE - GIRDER - 9G4B (DEVELOPED)

FOR FIELD SPLICE DETAILS SEE DRAWING X1.
 FOR GIRDER STANDARDS SEE DRAWING X2.
 FOR CAMBER DIAGRAM SEE DRAWING C2.
 FOR FLANGE DIAGRAMS SEE DRAWING F2.
 FOR GENERAL NOTES SEE DRAWING GNI.
 T2 DENOTES MATERIAL SUBJECT TO CHARPY V-NOTCH TESTING.
 FOR HORIZONTAL CURVING DIAGRAMS SEE DRAWINGS HCI.

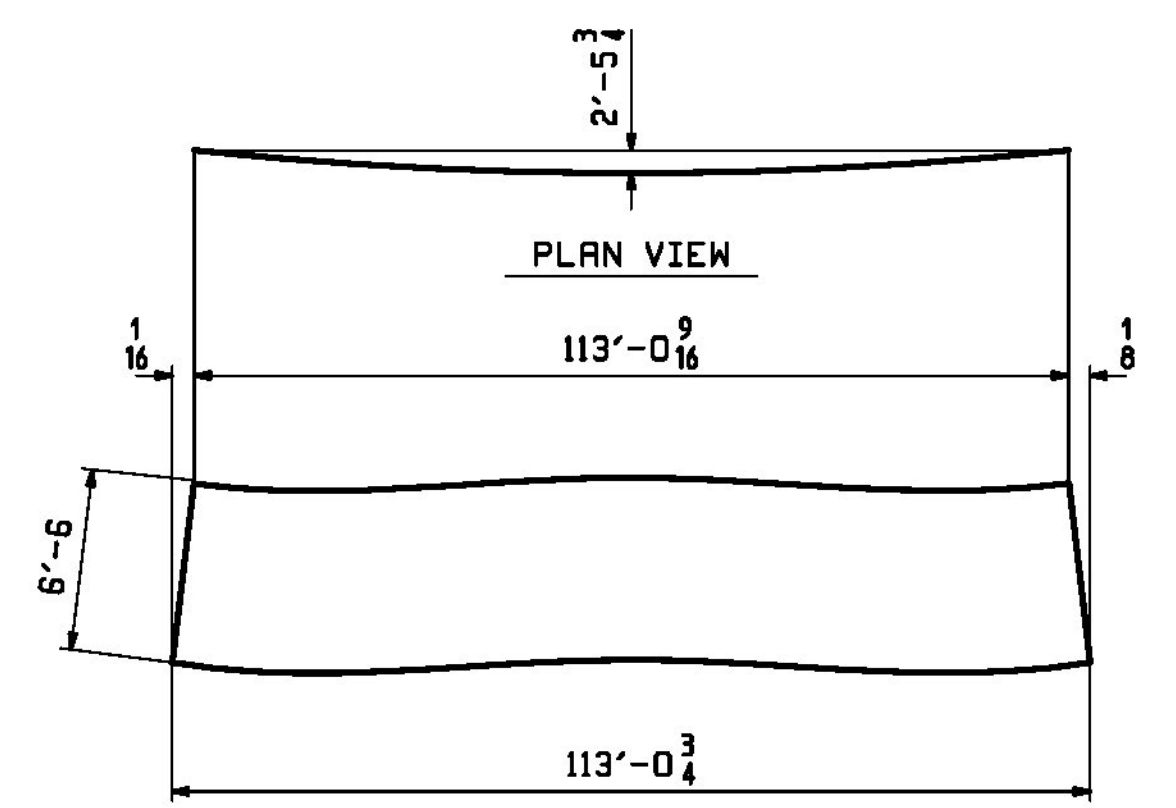

DEV. ORIENTATION DIAGRAM FOR CAMBER SEE DRAWING C2

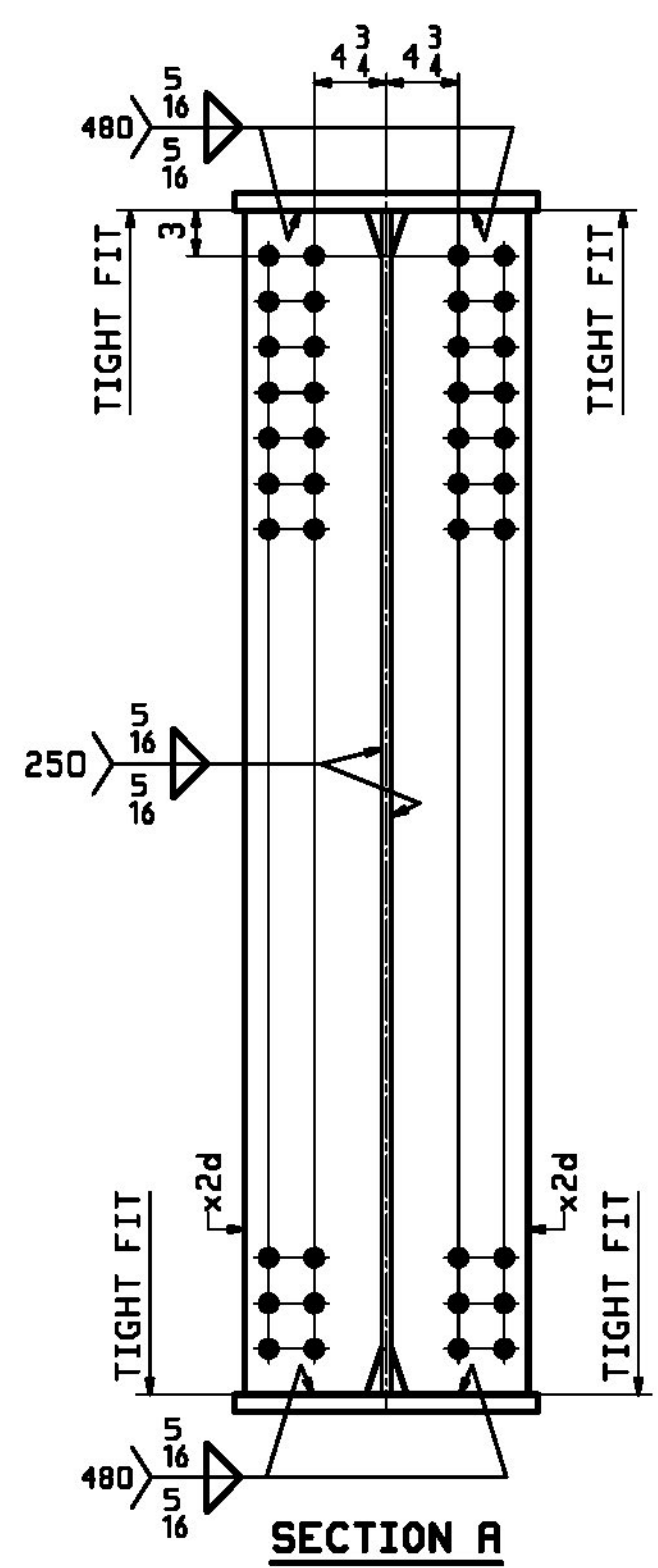

SECTION A

Vermont Agency of Transportation
RECEIVED
 CK'D BY CLB OK'D BY CWC
 October 5, 2017
 RESUBMIT NO Approved
 BY C. CARLSON DATE 10/05/17

REV.	DATE	REMARKS	DWN	CHK	APVL	SHOP
0						
MATERIAL:		SURFACE PREP. & PAINT:	HOLES:		SHOP BOLTS:	
M270-SOW (UN)		SEE DWG GNI	1 5/16" Ø		NONE	
DESCRIPTION:		GIRDER - 9G4B				
STRUCTURE:		DRAWN:		DATE:		
VT RTE 15A OVER LAMOILLE RIVER		JTJ		08/02		
ROUTE No. VT 15A, MAJOR COLLECTOR		CHKD:		DATE:		
BRIDGE No. 1		WJL		08/30		
COUNTY OF LAMOILLE		JOB NO.		DWG NO.		
LOCATION: MORRISTOWN, VT		713		9		
PROJ NO. BRS-0240(3)S & STP HES Q30-2(28)		CUSTOMER: STATE OF VERMONT R.O.T.		REV. <u>Δ</u>		

CASCO BAY STEEL STRUCTURES, INC.
 1 WALLACE AVE. PHONE (207) 780-6722
 SOUTH PORTLAND, ME 04106 FAX. (207) 780-6726