
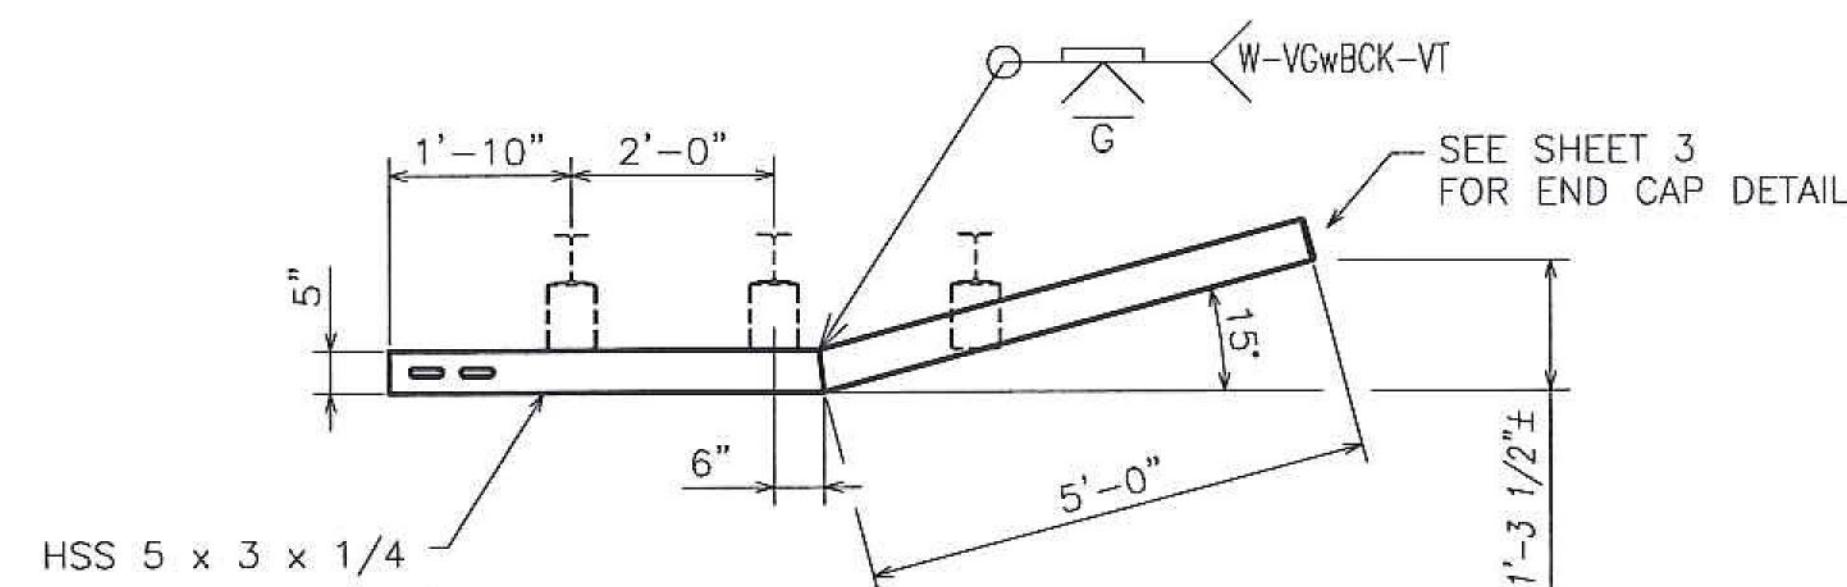
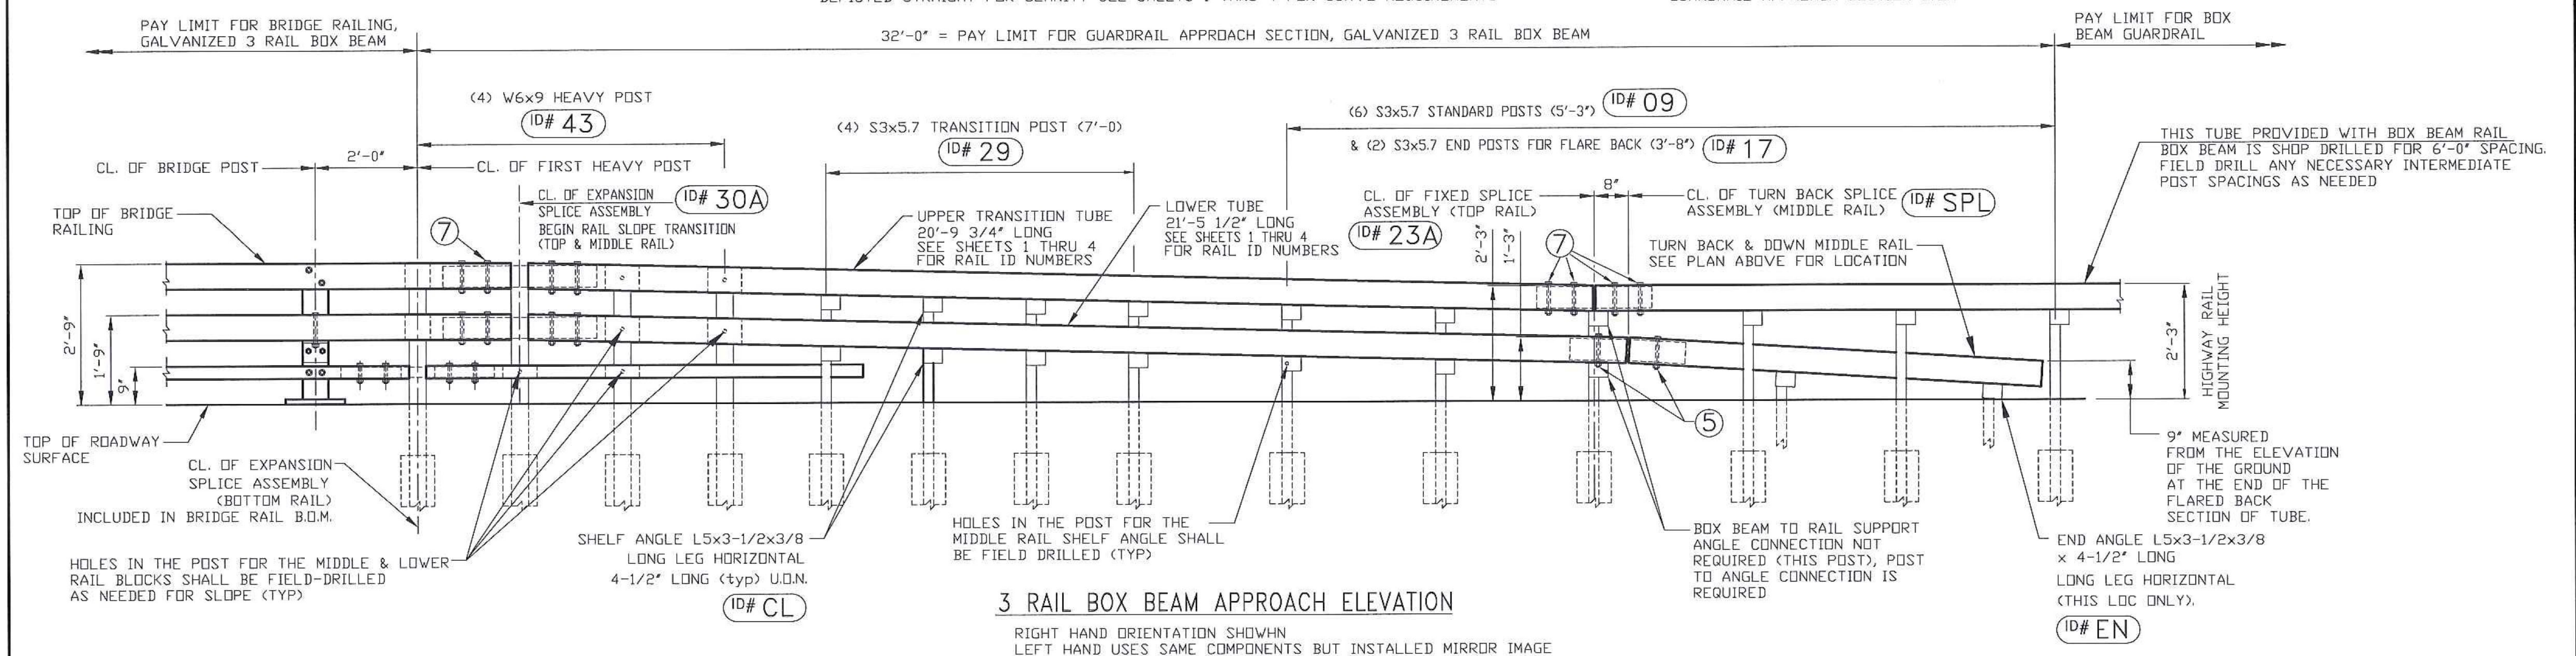


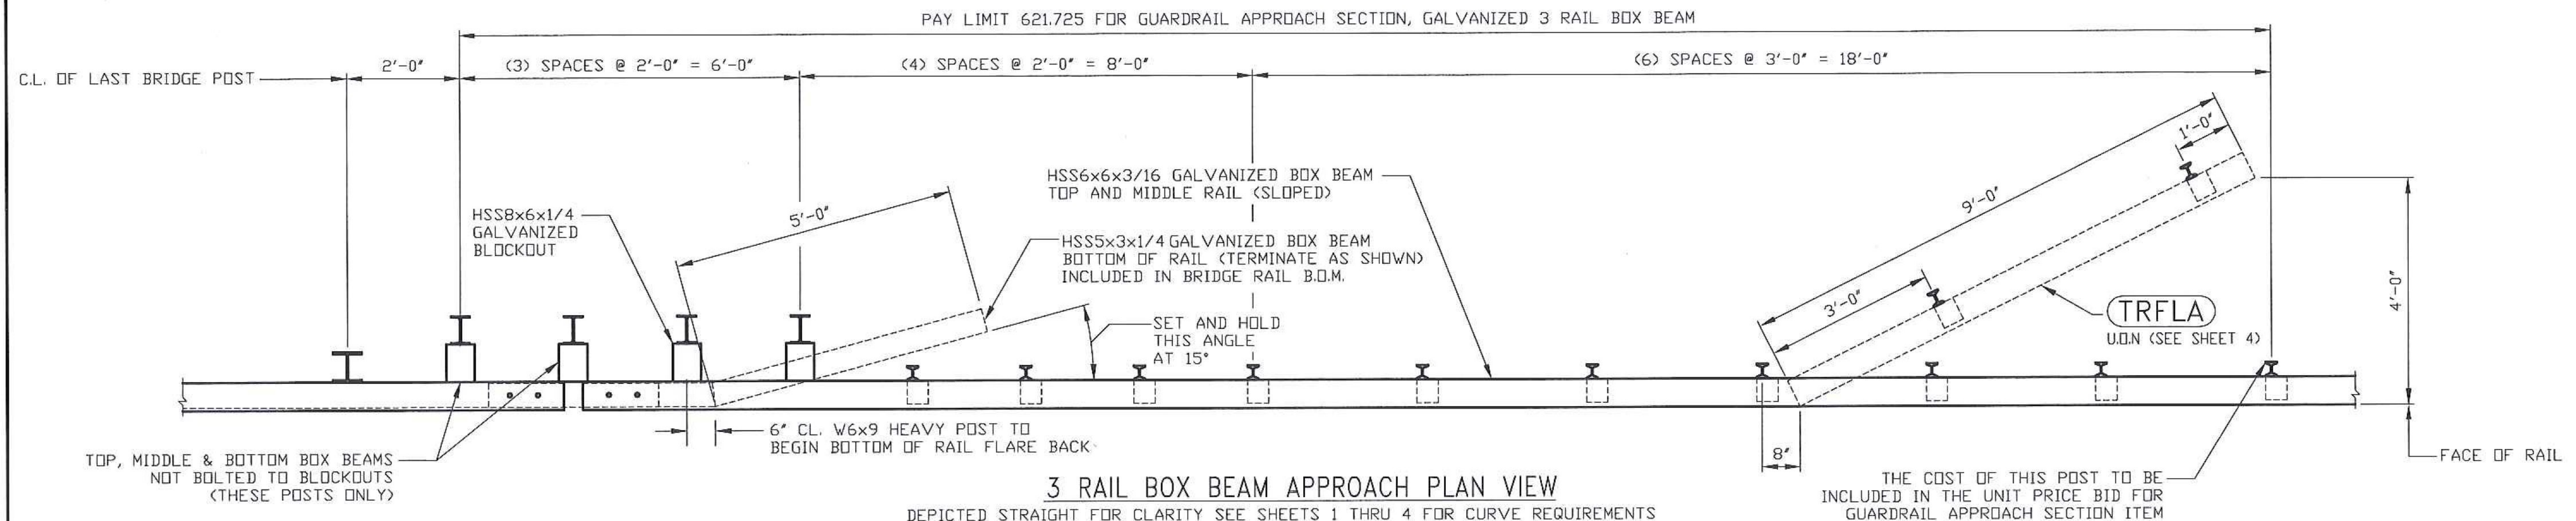

LOWER RAIL FLAREBACK END TUBE DETAIL

4 LOCATIONS (typ) AT APPROACH TERMINATION OF LOWER 5x3 RAIL
RIGHT HAND ORIENTATION SHOWN
LEFT HAND IS SAME PIECE INSTALLED MIRROR IMAGE

TUBE AS SHOWN WILL ACCOMMODATE 600' - 700' RADIUS WITHOUT SHOP BENDING

Vermont Agency of Transportation
RECEIVED
CK'D BY CLB OK'D BY CWC

April 13, 2018

RESUBMIT NO Approved AsNoted
BY C. CARLSON DATE 04/27/18

HIGHWAY SAFETY CORP	
GLASTONBURY, CT 860-633-9445	
ITEM 525.335 BRIDGE RAIL, GALVANIZED, 3 RAIL BOX BEAM ITEM 621.725 GUARDRAIL APPROACH, GALVANIZED, 3 RAIL BOX BEAM VT RT 15A BRIDGE No. 1 TOWN OF MORRISTOWN - LAMOILLE COUNTY, VT BRS 0240(3) S	
CERTIFIED FABRICATOR	HSC JOB NO. 2236
SHEET NO. 7 of 8	
GENERAL CONTRACTOR LAFAYETTE	SUB CONTRACTOR LAFAYETTE
DRAWN PAR	CHECKED DATE 04-09-18 SCALE NONE SIZE D