




CL OF 1"Ø HOLES (FIELD DRILL) FOR 7/8" GALV
ROUND HEAD BOLTS w/ HEX NUT, SQ WASHER &
SPRING LOCK WASHER (TYP)

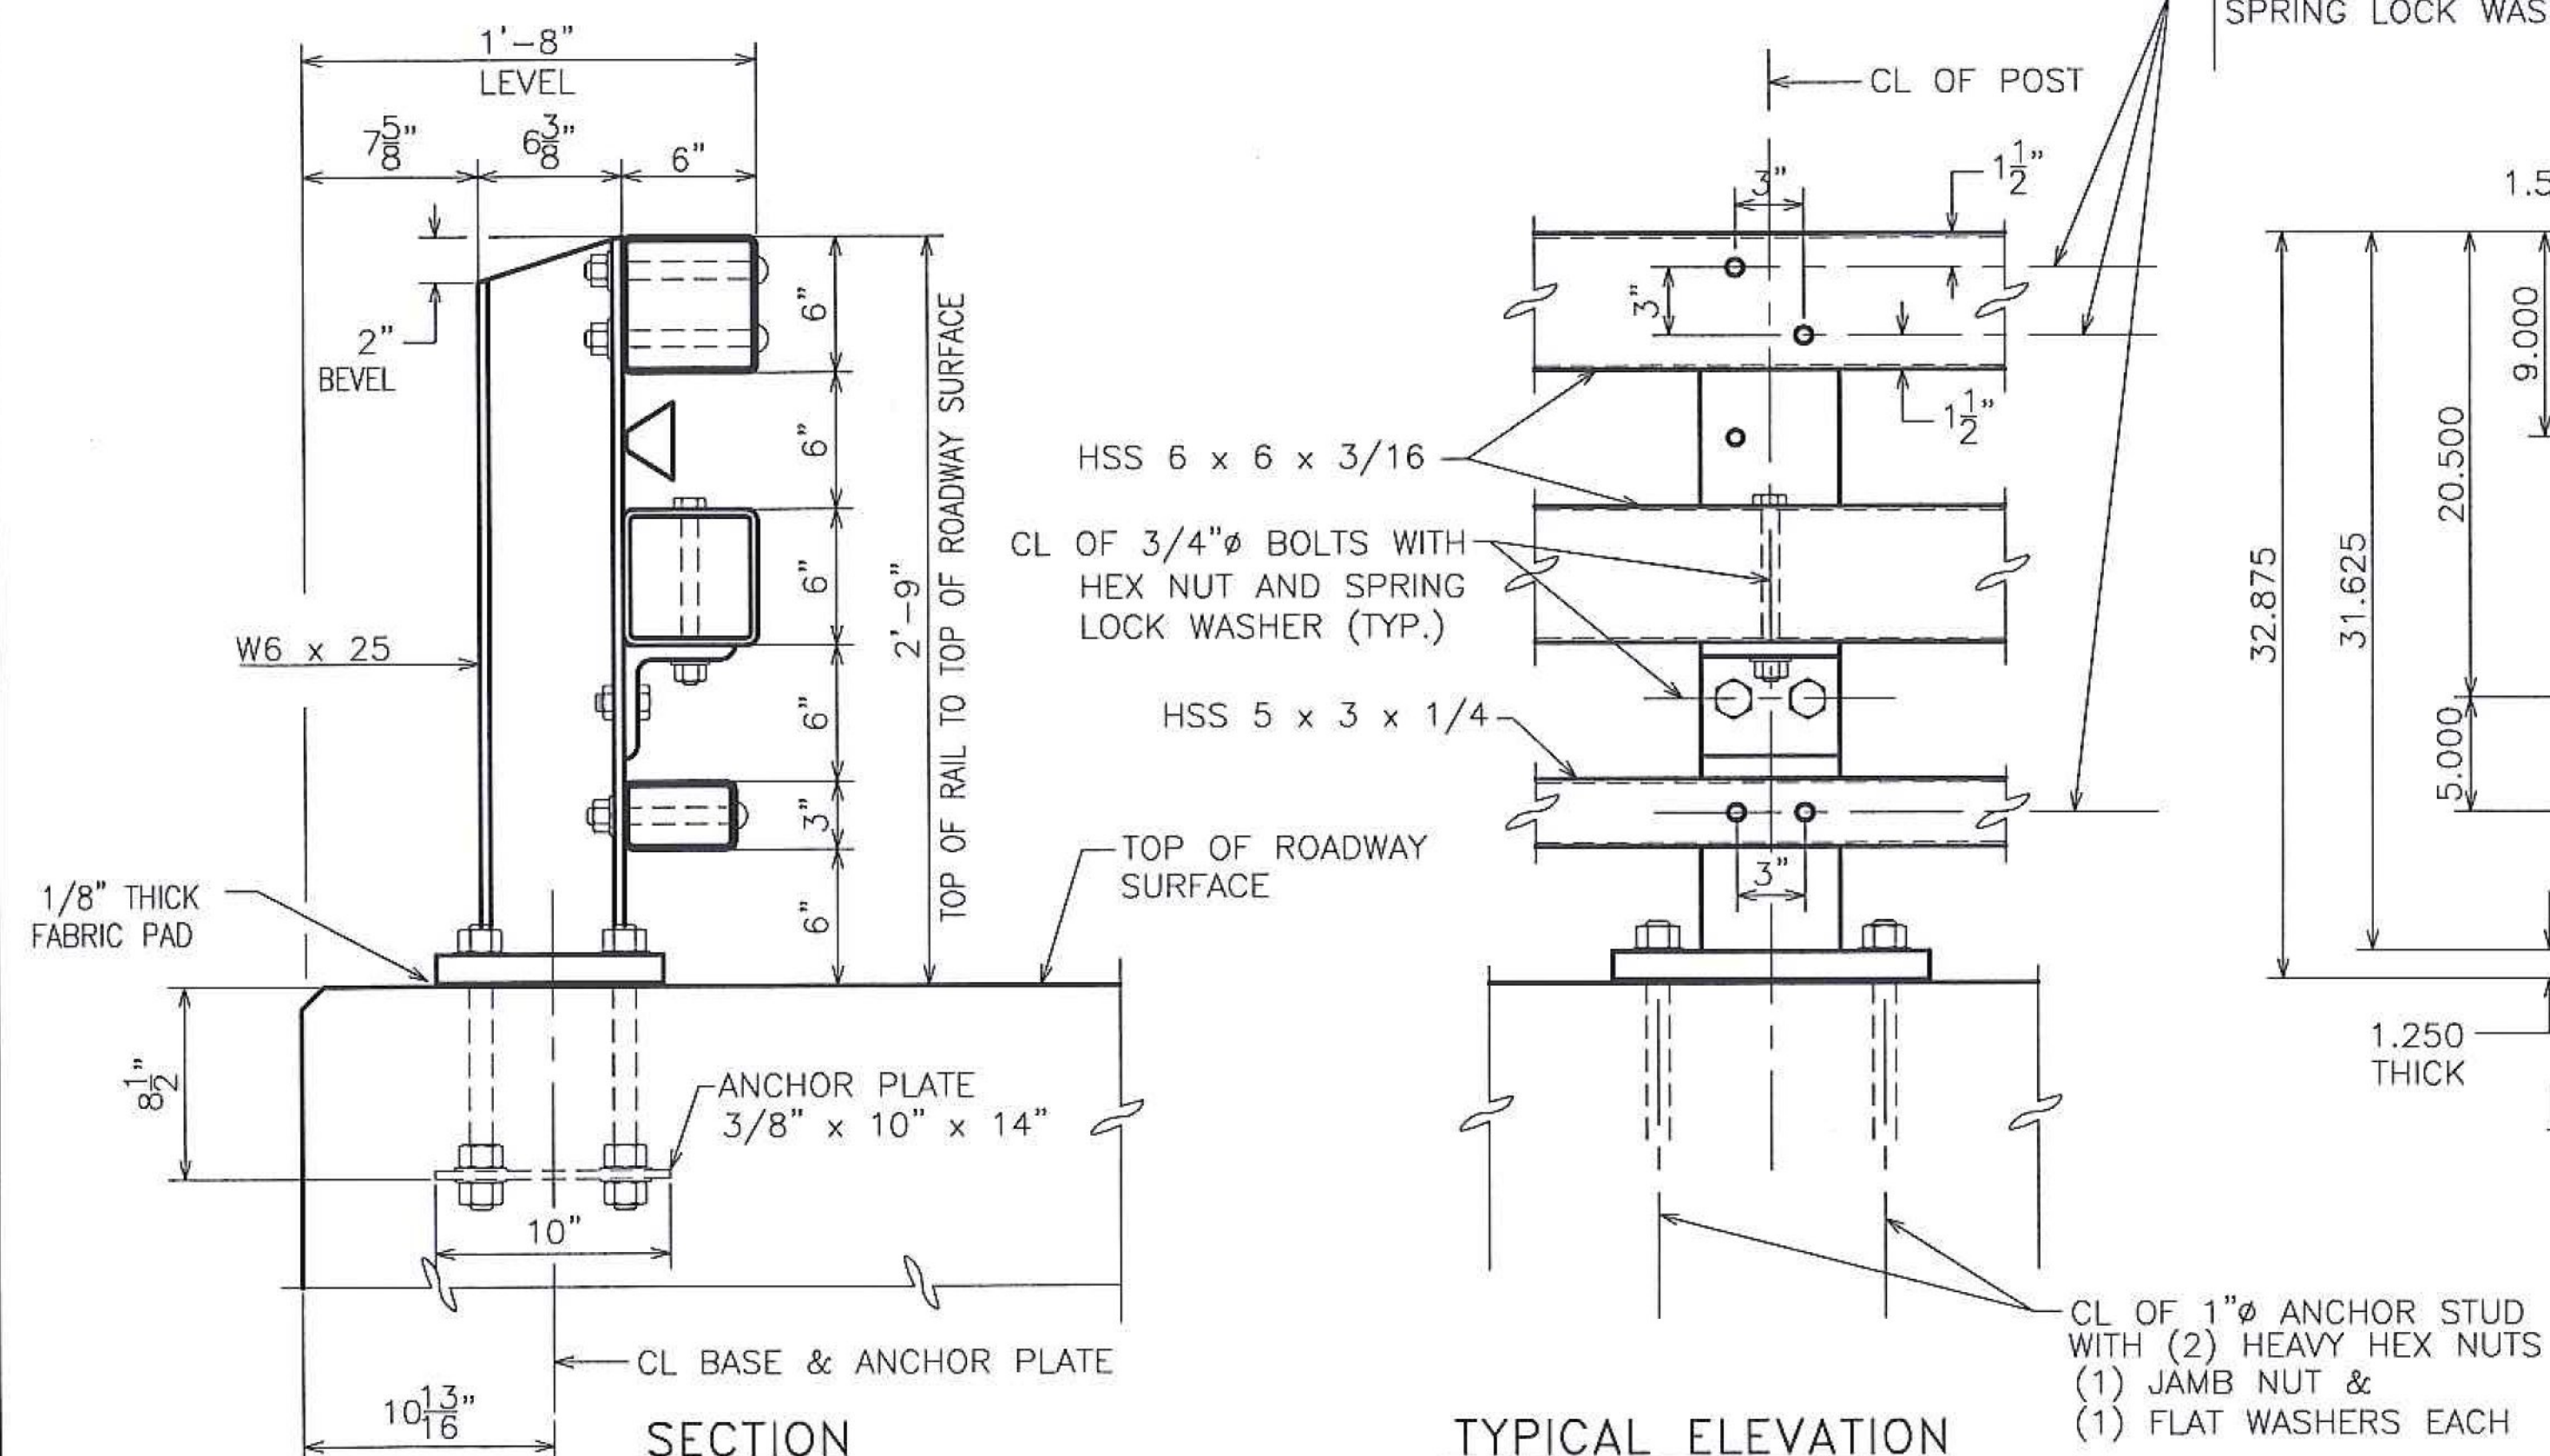

STEEL BRIDGE RAILING
(THREE-RAIL CURBLESS)

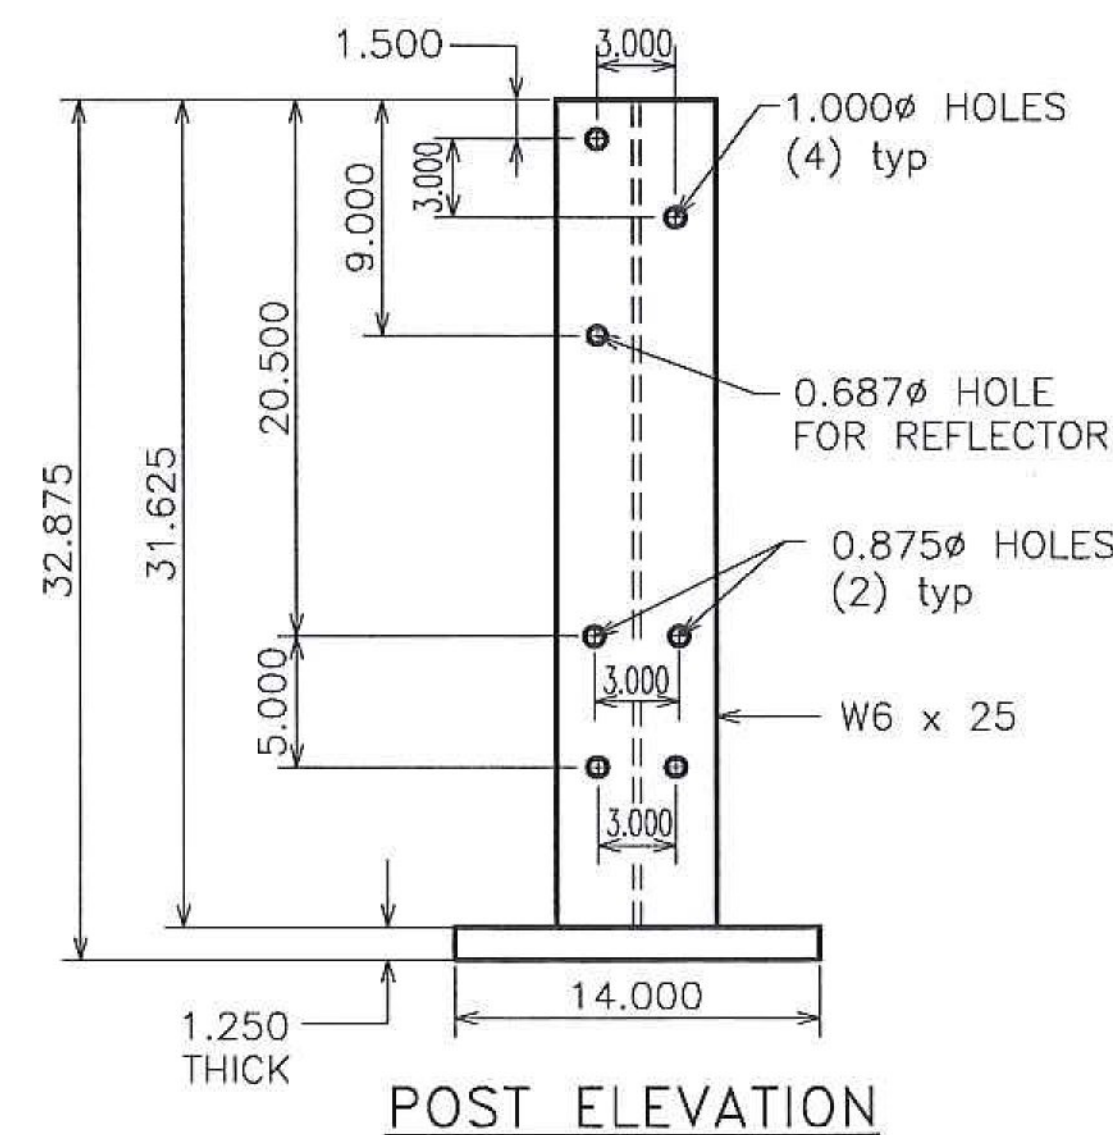

POST ELEVATION

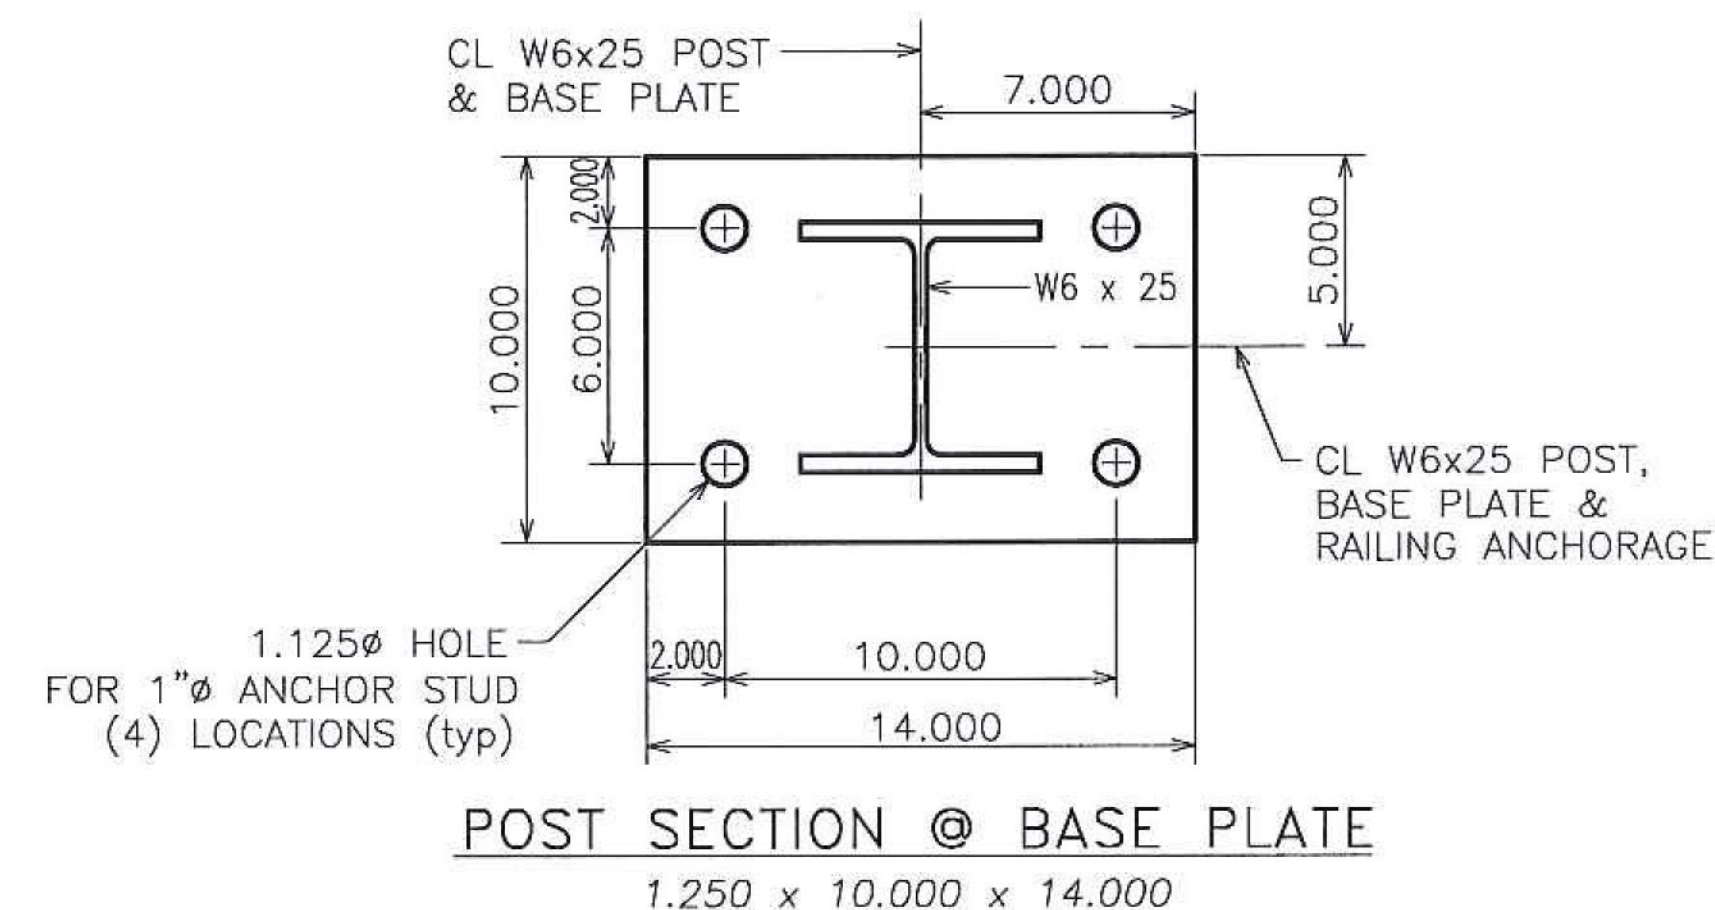

1/8" BEARING PAD TO HAVE SAME DIMENSIONS AS BASE PLATE


Vermont Agency of Transportation

RECEIVED


CK'D BY CLB OK'D BY CWC

April 13, 2018


RESUBMIT NO Approved AsNoted
BY C. CARLSON DATE 04/27/18

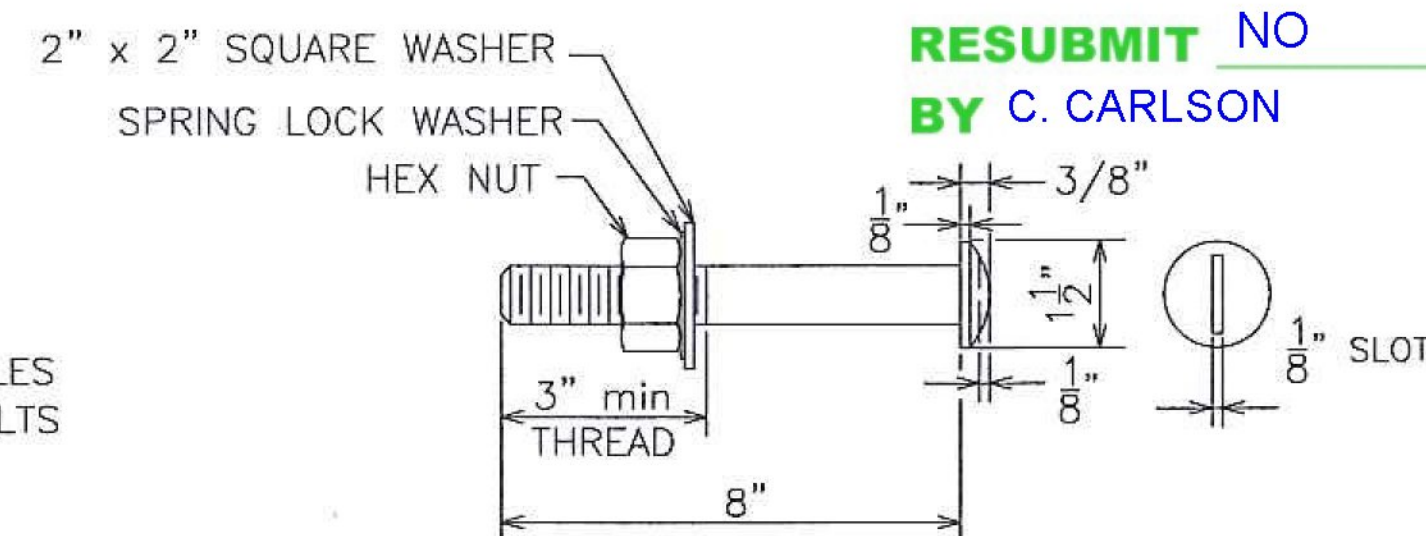

7/8Ø ROUND HEAD BOLT

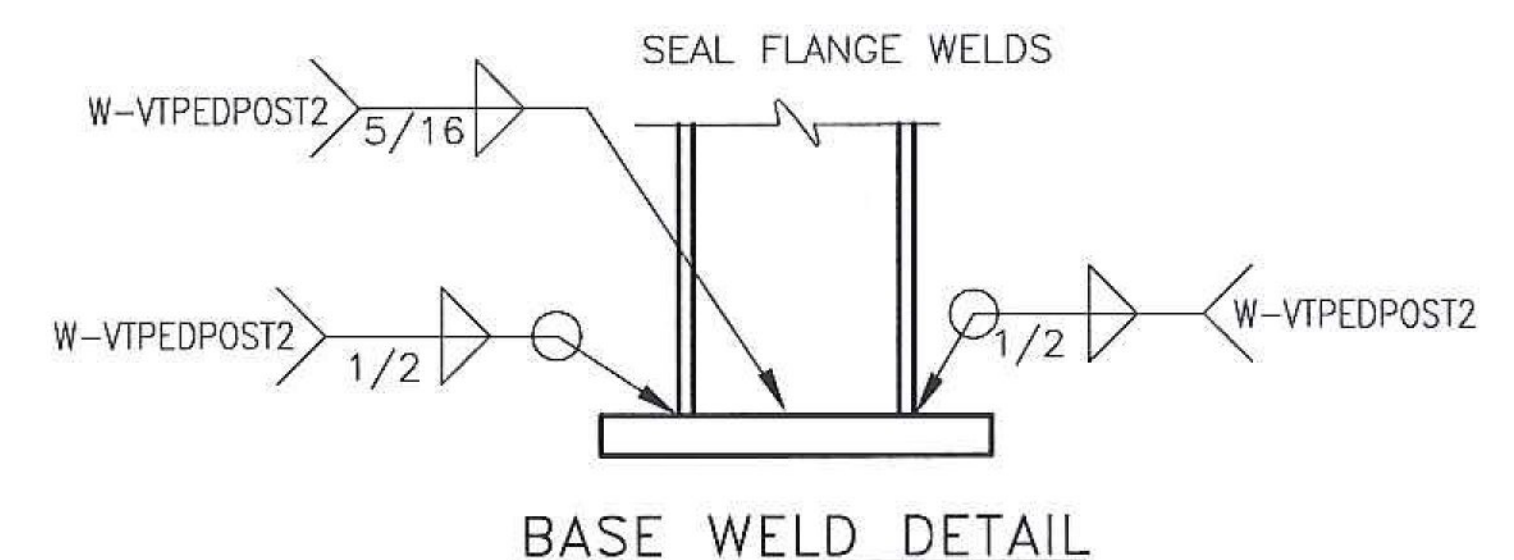


BASE WELD DETAIL

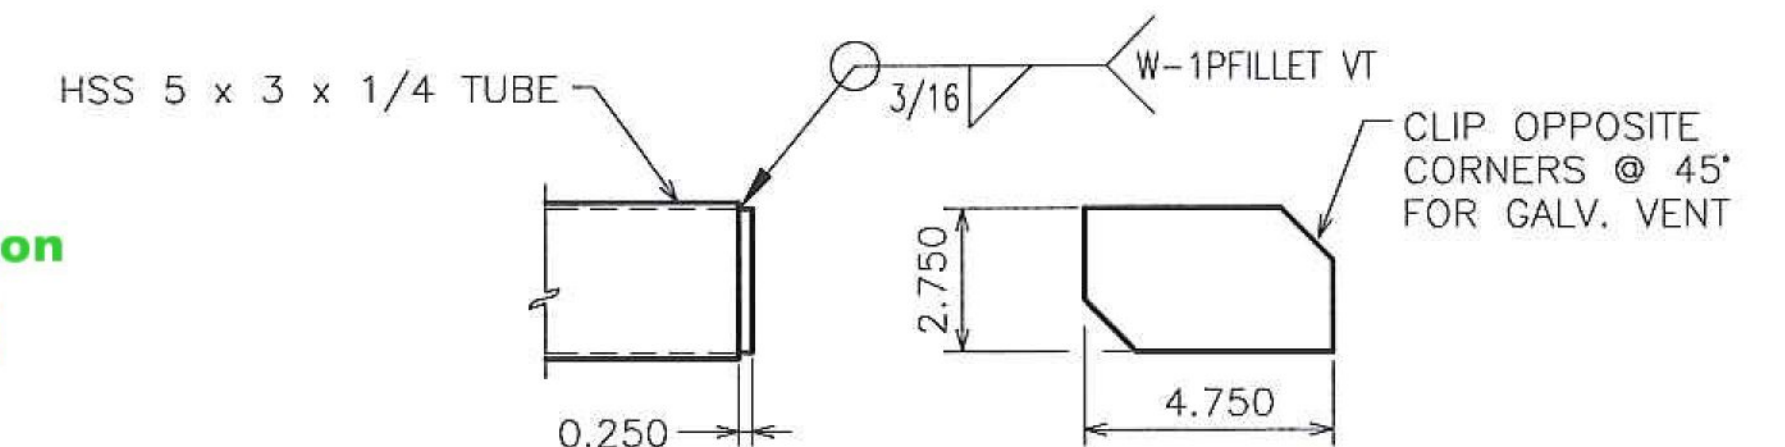


WELDED END CAP DETAIL

USED AT FLAREBACK END OF BOTTOM 5 x 3 APPROACH RAIL

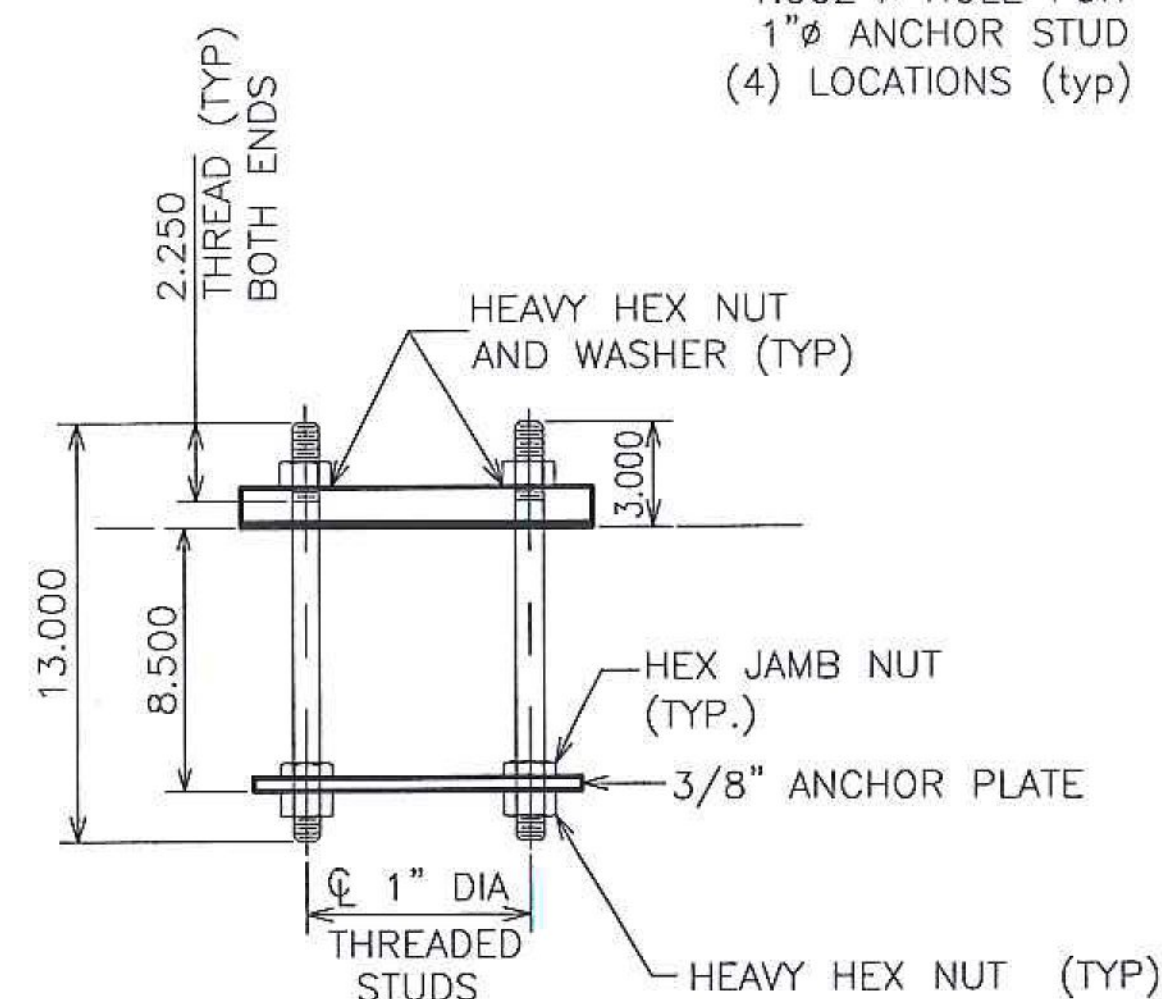

RAIL POST ANCHORAGE

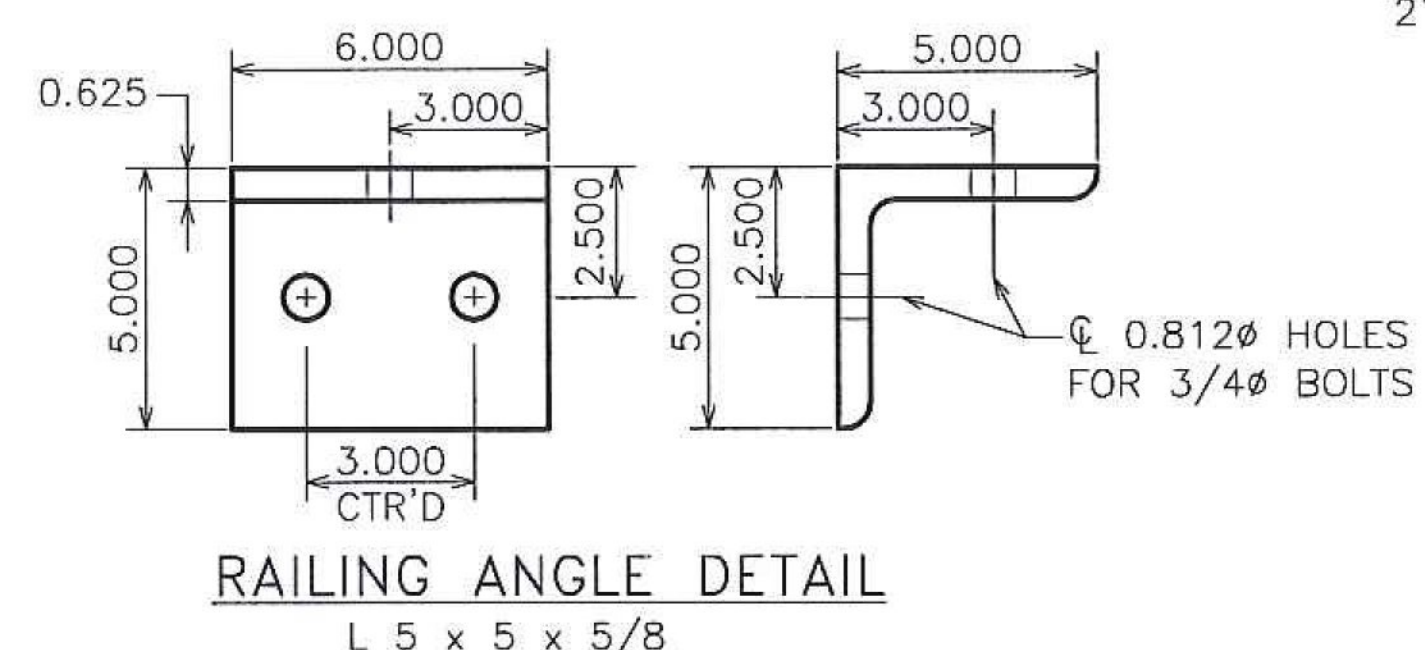

RAILING ANGLE DETAIL
L 5 x 5 x 5/8

HIGHWAY SAFETY CORP	
GLASTONBURY, CT 860-633-9445	
ITEM 525.335 BRIDGE RAIL, GALVANIZED, 3 RAIL BOX BEAM	CERTIFIED FABRICATOR
ITEM 621.725 GUARDRAIL APPROACH, GALVANIZED, 3 RAIL BOX BEAM	
VT RT 15A BRIDGE No. 1	
TOWN OF MORRISTOWN - LAMOILLE COUNTY, VT	
BRS 0240(3) S	
GENERAL CONTRACTOR	HSC JOB NO. 2236
SUB CONTRACTOR	SHEET NO. 5 of 8
DRAWN PAR	CHECKED
DATE 04-09-18	SCALE NONE
SIZE	D