


RECEIVED


CK'D BY CLB OK'D BY CWC

February 16, 2018

RESUBMIT NO Approved
 BY C. CARLSON DATE 02/16/18

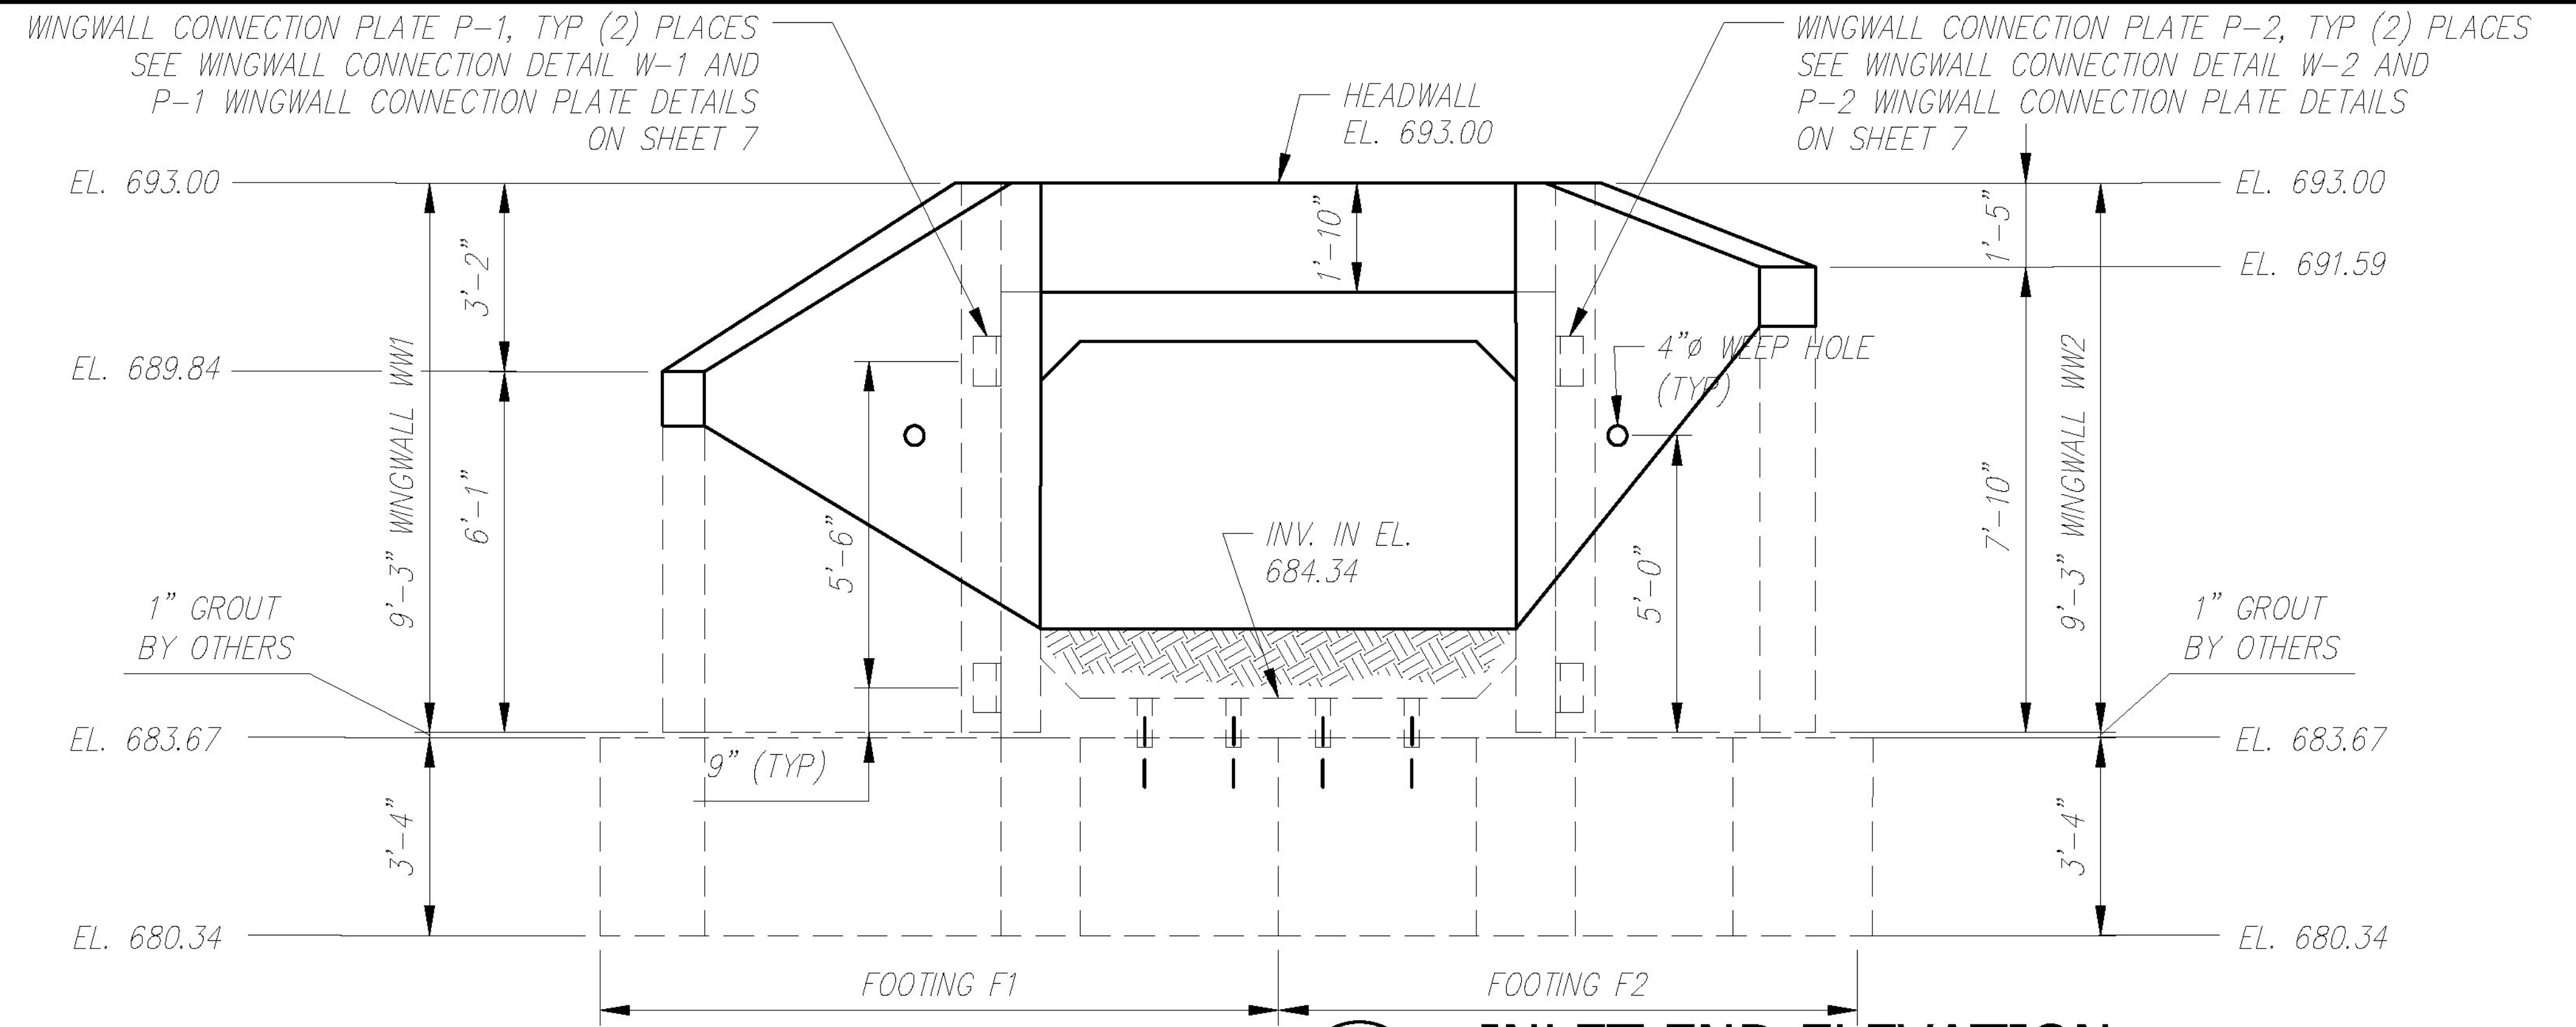

A INLET END ELEVATION
 Scale: 1/4" = 1'-0"

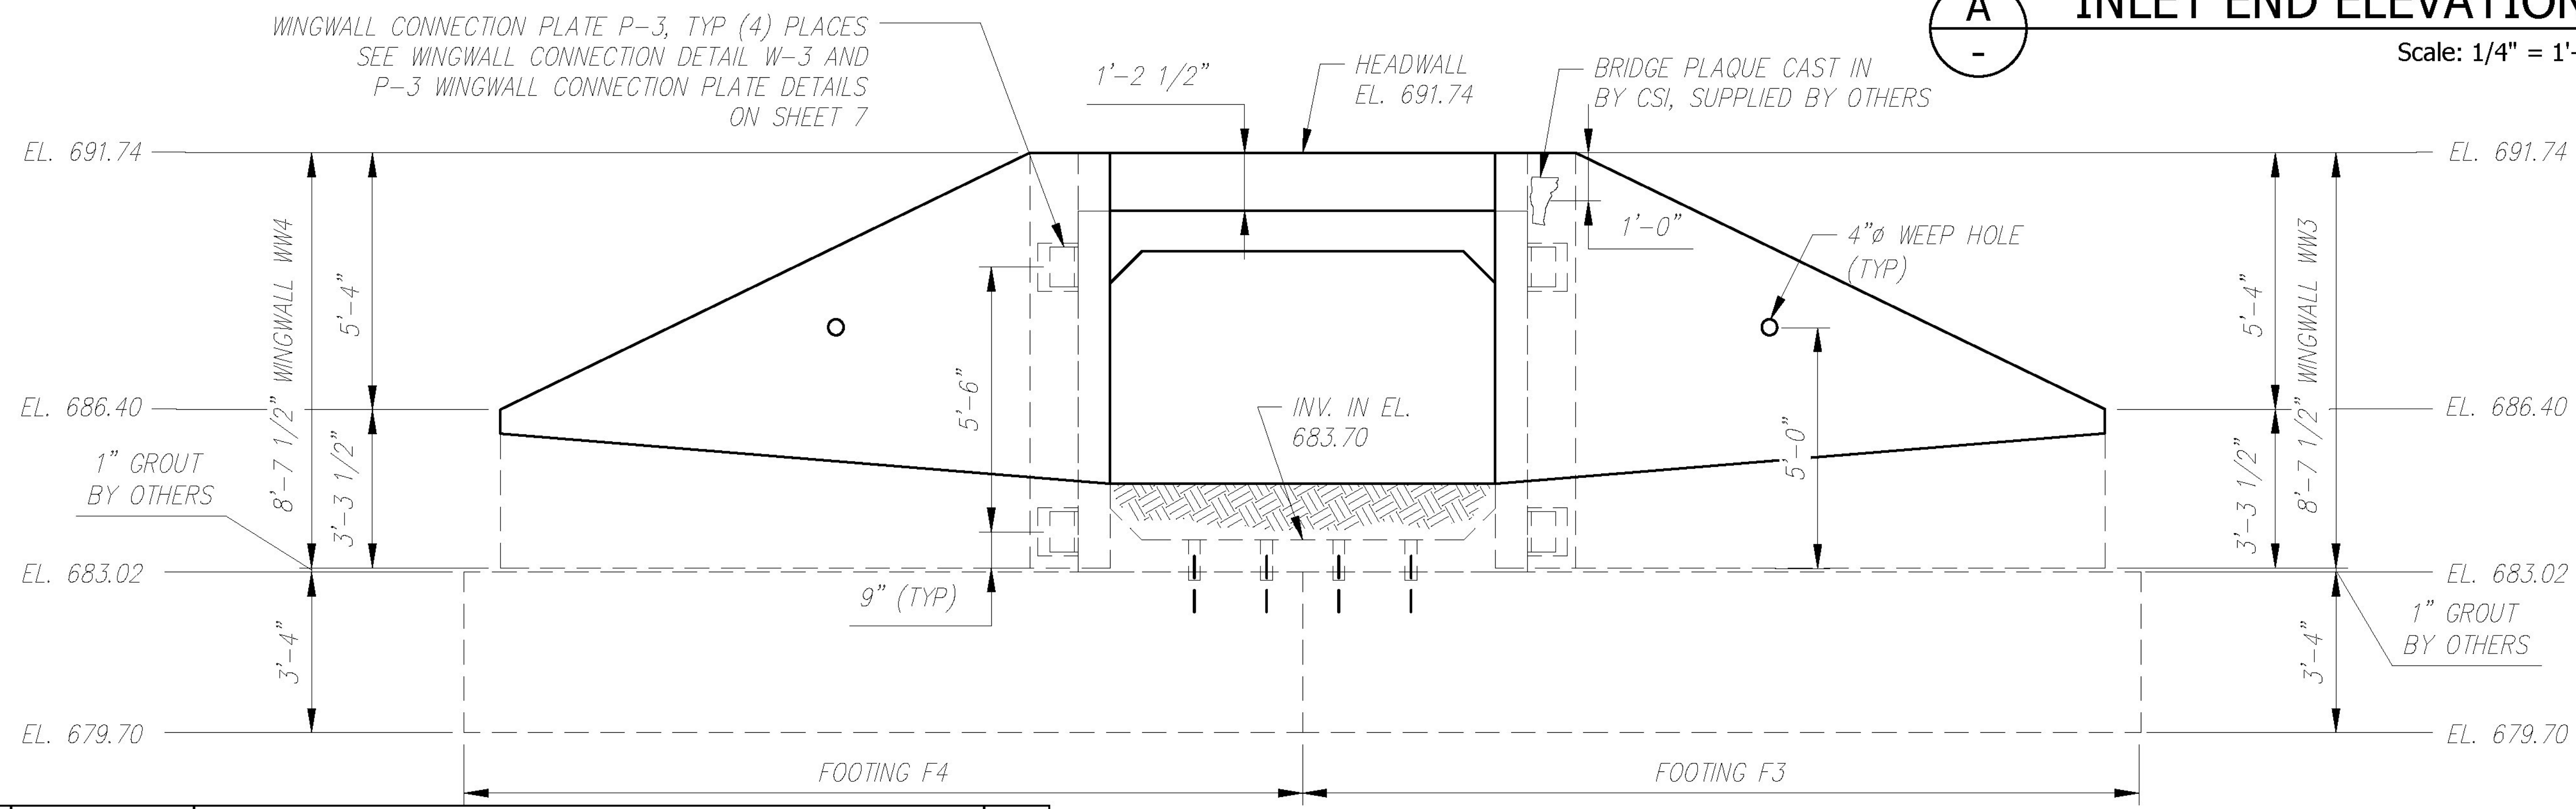

B DEVELOPED OUTLET END ELEVATION
 Scale: 1/4" = 1'-0"

Rev.	Date	DESCRIPTION	By
5			
4	12/13/17	NO CHANGES TO THIS SHEET	BSS
3	12/01/17	NO CHANGES TO THIS SHEET	BSS
2	11/02/17	NO CHANGES TO THIS SHEET	BSS
1	08/17/17	REV PER CUSTOMER REVIEW	BSS
REVISIONS			

CONCRETE SYSTEMS INC.
 9 Commercial Street
 Hudson, New Hampshire 03051
 (800) 342-3374 (603) 889-4163
 FAX (603) 889-0039 www.csigroup.com

Drawn By
 B. SKELTON
 Date
 07/10/2017
 Reviewed By
 B.K./M.S.
 Date
 07/17/2017
 Approved By
 B. SKELTON
 Date
 01/03/2018

B BOX CULVERT END ELEVATIONS
 Drawing No. C23199-L01C
 Proj. No: STP HES 030-2(28) SHEET 5
 REV 4