



Fax to:	Customer
Fax#:	Project
Form	Job#
Date	PA Insert Quote/Order#
	Ship Date
	Page ____ of ____

Approved/Notes



PA Insert Corp
 PO Box 199
 Spring City PA 19475
 tel: 610-948-9688
 fax: 610-948-9750
 email: sales@pennsylvaniainsert.com
 web: www.pennsylvaniainsert.com

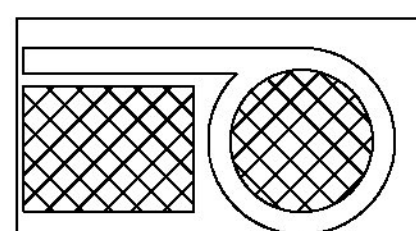

BOLT POCKET FORMER (for up to 1" bolt)

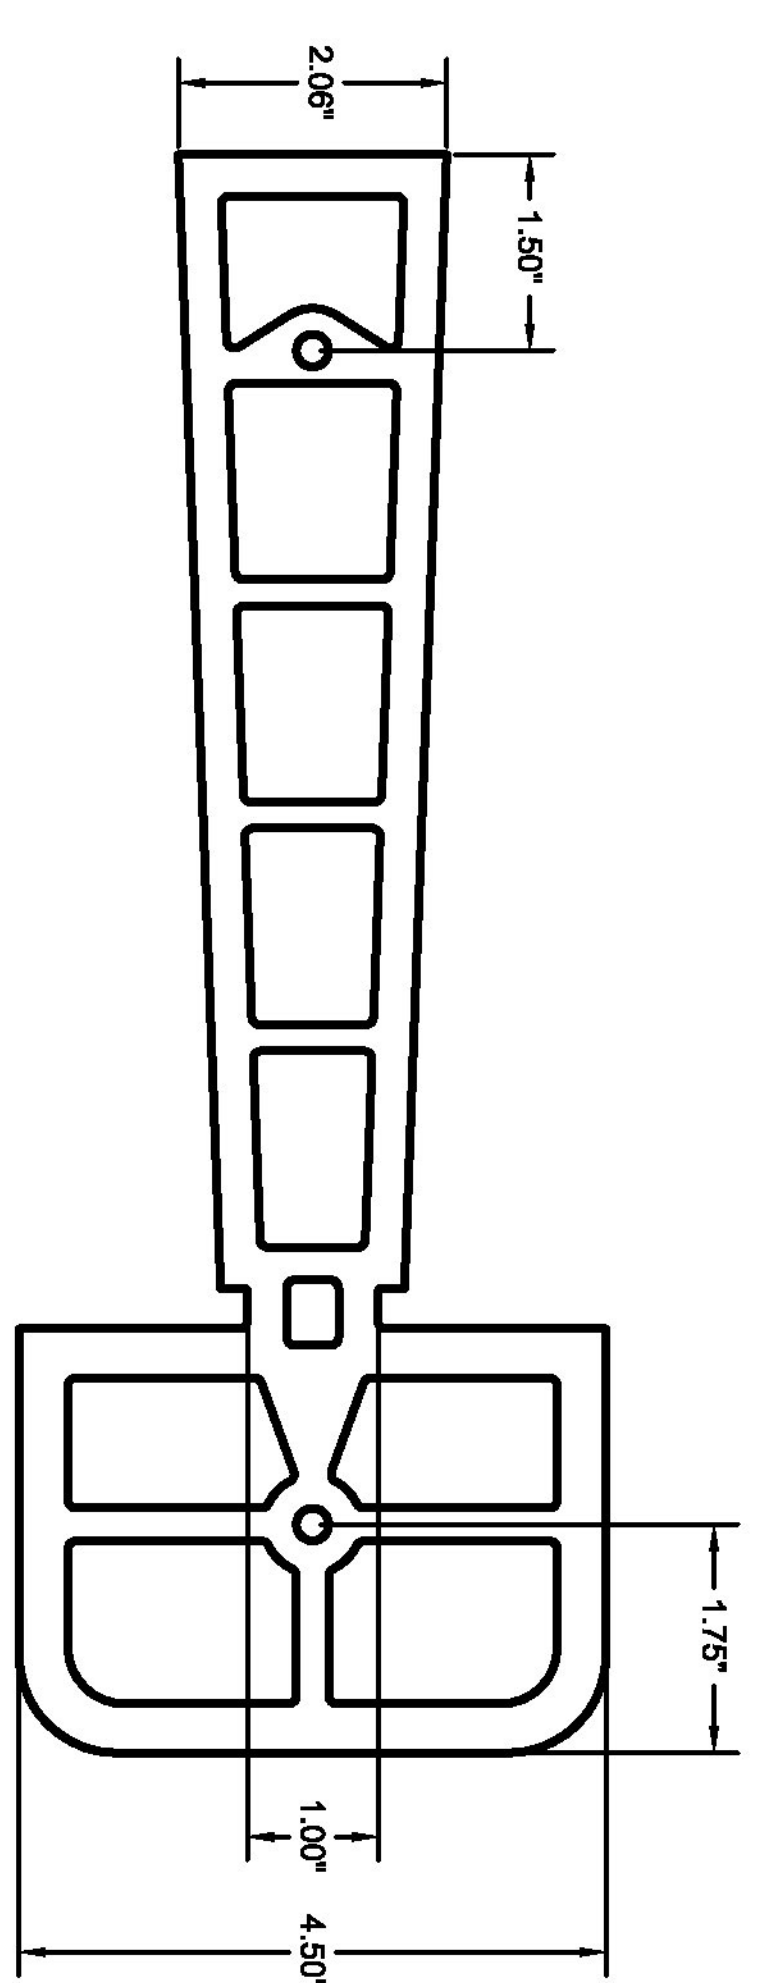

- Made from durable Urethane for reusability
- Ribbed construction increases strength
- *Replacable 1/4" Threaded Inserts
- **1/4" Galvanized Steel Plate Standard
- Available with magnets to attach to form

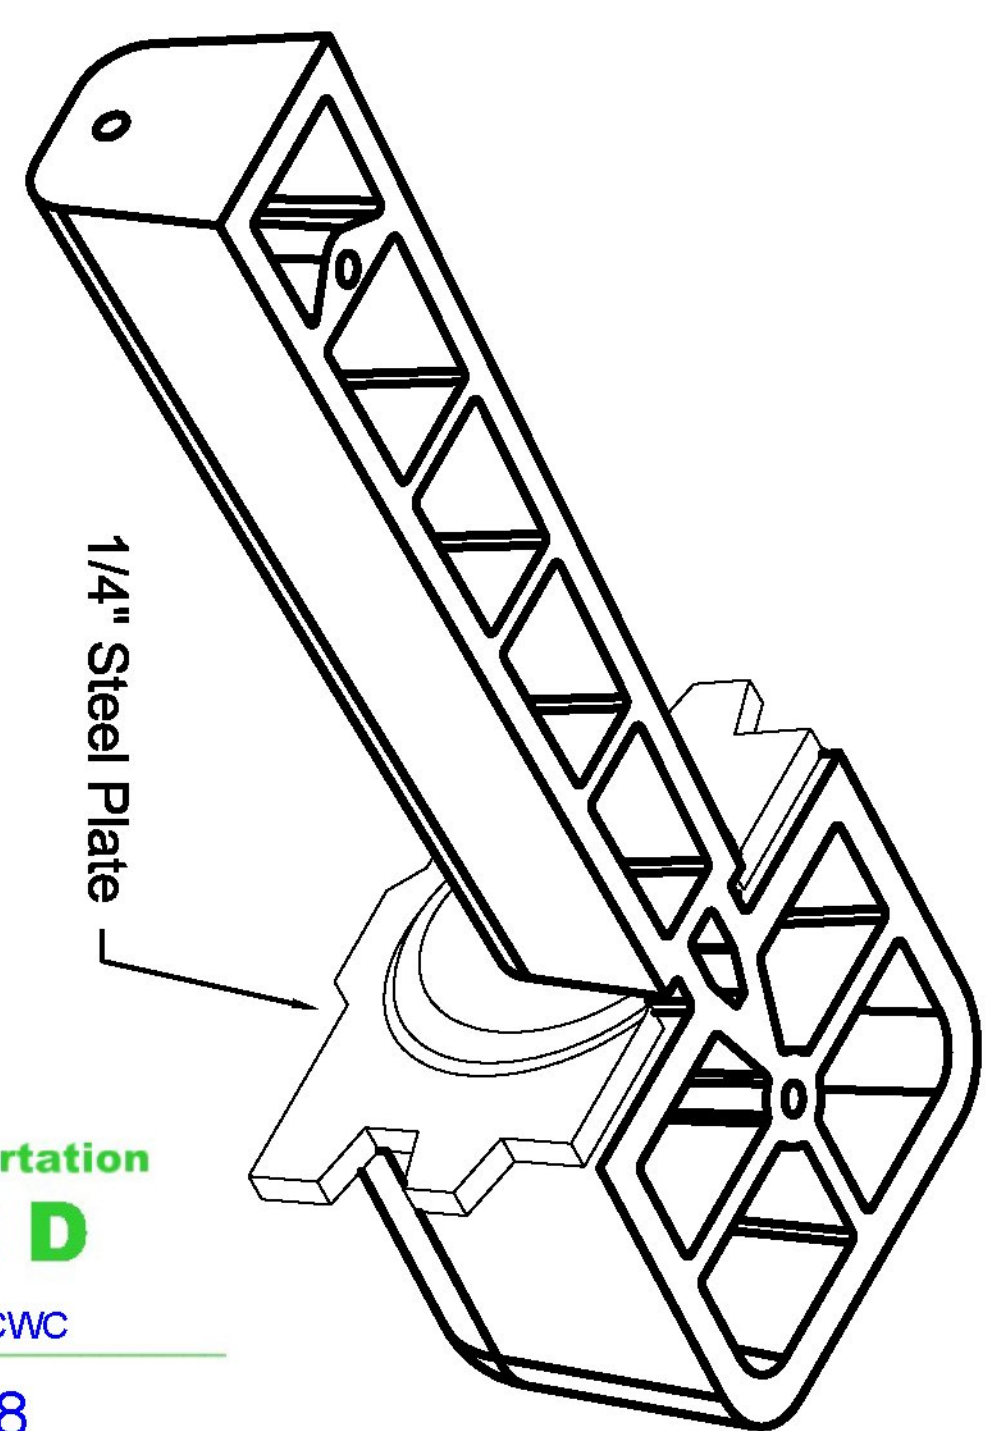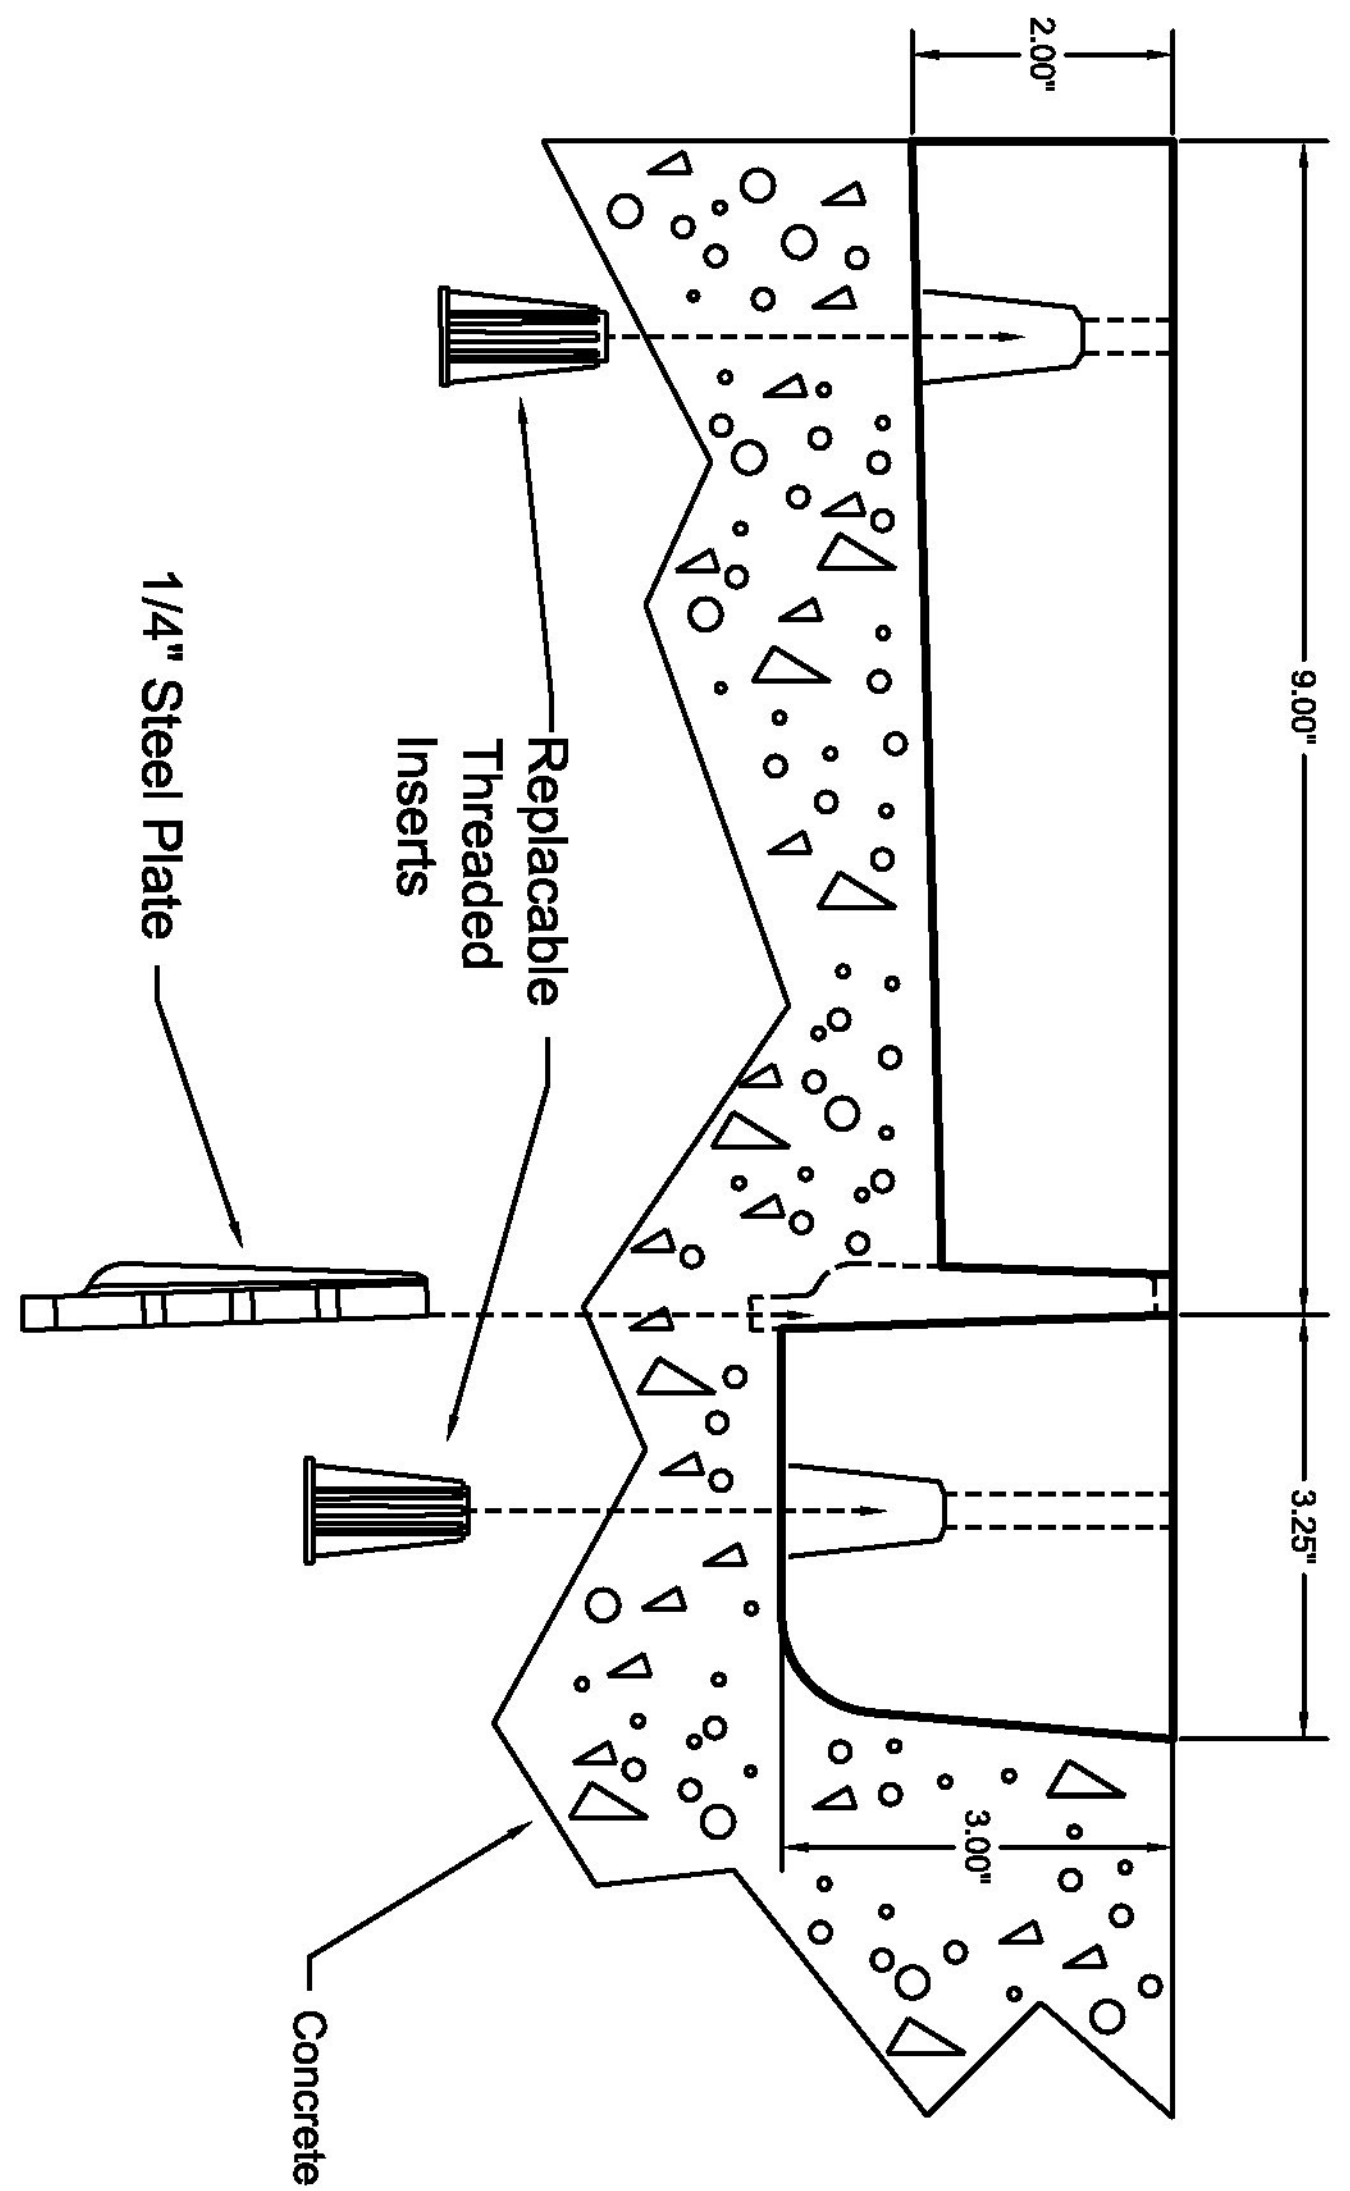

*Threaded Inserts sold separately (Part Number 1200)
 **Steel Plate stays in concrete, sold separately (Part Number 4024)

Vermont Agency of Transportation
RECEIVED
 CK'D BY CLB OK'D BY CWC
 February 16, 2018
 RESUBMIT No Approved
 BY C. CARLSON DATE 02/16/18