

STATE OF VERMONT AGENCY OF TRANSPORTATION



PROPOSED IMPROVEMENT SIGN REPLACEMENT PROJECT


TOWNS OF ALBURGH, SWANTON AND HIGHGATE COUNTIES OF GRAND ISLE AND FRANKLIN VT ROUTE 78 AND US ROUTE 7 (PRINCIPAL ARTERIAL) (MAJOR COLLECTOR)

BEGINNING AT A POINT, IN THE TOWN OF ALBURGH, AT THE INTERSECTION OF US ROUTE 2 AND VT ROUTE 78 (MM 0.00) AND EXTENDING EASTERLY, ALONG VT ROUTE 78, APPROXIMATELY 11.136 MILES INTO THE TOWN OF SWANTON AT MM 7.898. THIS DISTANCE EXCLUDES THE PORTION OF US ROUTE 7 IN THE VILLAGE OF SWANTON, BETWEEN CANADA ST AND FIRST ST.
ALSO BEGINNING AT A POINT, IN THE TOWN OF HIGHGATE, ON US ROUTE 7, AT THE SWANTON/HIGHGATE TOWN LINE, AND EXTENDING NORTHERLY APPROXIMATELY 6.209 MILES.


VT 78 ALBURGH = 3.329 MILES
VT 78 SWANTON = 7.807 MILES
US 7 HIGHGATE = 6.209 MILES

LENGTH OF PROJECT = 17.345 MILES

WORK TO BE PERFORMED UNDER THIS PROJECT INCLUDES THE REMOVAL OF EXISTING SIGNS AND POSTS AND THE INSTALLATION OF NEW SIGNS, SIGN POSTS AND OTHER RELATED HIGHWAY ITEMS.

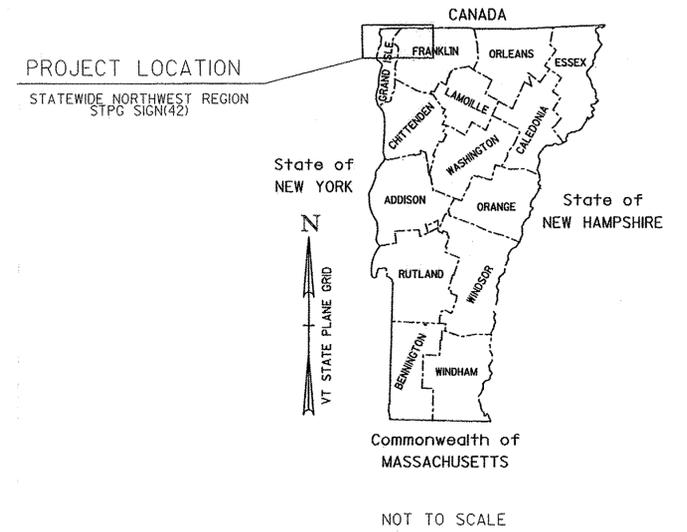

RECORD PLANS	
CONTRACTOR:	F. R. LAFAYETTE, INC. - ESSEX JUNCTION, VT
RESIDENT ENGINEER:	JEFF COTA
CONSTRUCTION BEGAN:	APRIL 15, 2013
CONSTRUCTION COMPLETE:	MAY 1, 2013
RECORD PLANS BY:	JEFF COTA & JENNA HYDE
I HEREBY CERTIFY THAT ALL THE CONSTRUCTION REQUIRED BY THIS SET OF DRAWINGS HAS BEEN ACCOMPLISHED AS INDICATED HEREIN.	
BY	RESIDENT ENGINEER
DATE	3/7/14
NOTE: Any further information concerning final quantities, amounts or other details relative to this project may be found at Central Files in the electronic archives.	

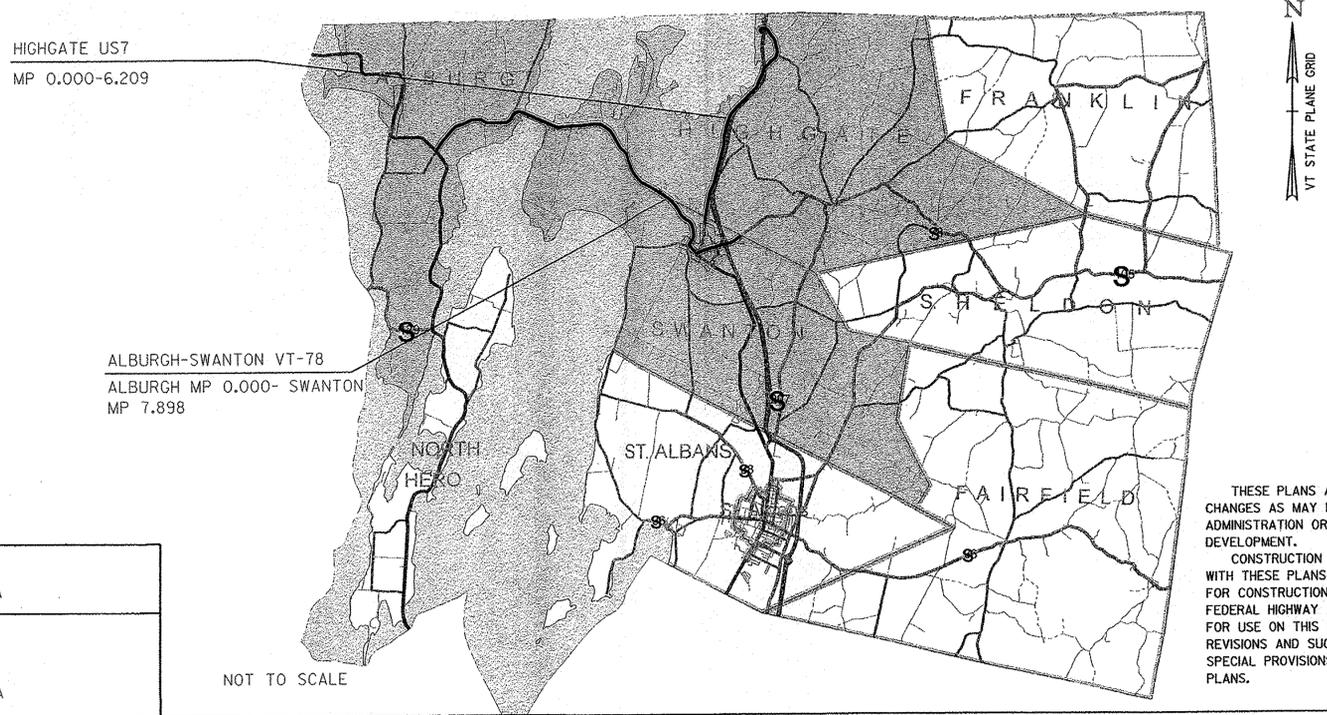

QUALITY ASSURANCE PROGRAM: LEVEL 3

CONVENTIONAL SYMBOLS	
COUNTY LINE	
TOWN LINE	
LIMITS OF ACCESS	
POINT OF ACCESS	
FENCE LINE	
STONE WALL	
TRAVELED WAY	
GUARD RAIL	
RAILROAD	
SURVEY LINE	
CULVERT	
POWER POLE	
TELEPHONE POLE	
TREES	
CONTROL OF ACCESS	
PROPERTY LINE	
R.O.W. TAKING LINE	
SLOPE RIGHTS	
TOP OF CUT	
TOE OF SLOPE	

SURVEYED BY : N/A
 SURVEYED DATE : N/A
 DATUM
 VERTICAL N/A
 HORIZONTAL N/A

THESE PLANS ARE SUBJECT TO SUCH ENGINEERING CHANGES AS MAY BE REQUIRED BY THE FEDERAL HIGHWAY ADMINISTRATION OR THE DIRECTOR OF PROGRAM DEVELOPMENT.
 CONSTRUCTION IS TO BE CARRIED ON IN ACCORDANCE WITH THESE PLANS AND THE STANDARD SPECIFICATIONS FOR CONSTRUCTION DATED 2011, AS APPROVED BY THE FEDERAL HIGHWAY ADMINISTRATION ON JULY 20, 2011. FOR USE ON THIS PROJECT, INCLUDING ALL SUBSEQUENT REVISIONS AND SUCH REVISED SPECIFICATIONS AND SPECIAL PROVISIONS AS ARE INCORPORATED IN THESE PLANS.

DIRECTOR OF PROGRAM DEVELOPMENT	
APPROVED	DATE 8-23-12
PROJECT MANAGER :	AMY GAMBLE
PROJECT NAME :	STATEWIDE-NW REGION
PROJECT NUMBER :	STPG SIGN (42)
SHEET 1 OF	69 SHEETS