
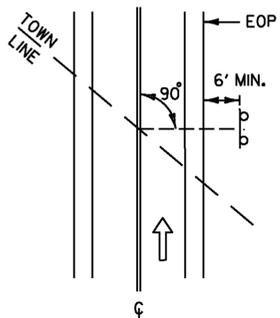


1.5" RADIUS, NO BORDER, GREEN;  
[HIGHGATE] WHITE C; [SWANTON] WHITE C;

**VD-024**

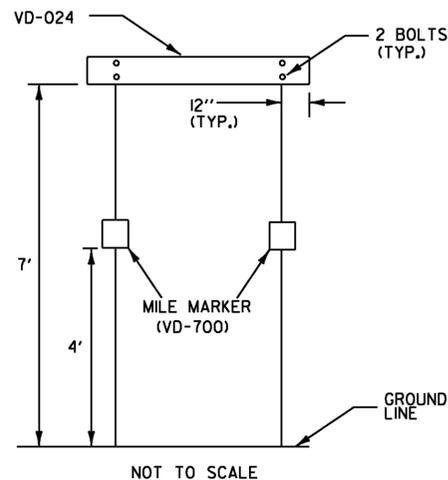

THE SIGN SHALL BE MOUNTED PARALLEL WITH THE ROADWAY, NORMALLY ON RIGHT SIDE TRAVELING WEST TO EAST OR SOUTH TO NORTH.

**TOWN /COUNTY LINE (VD-024 /VD-025) INSTALLATION**

1. THE SIGN SHALL BE MOUNTED PARALLEL WITH THE ROADWAY, NORMALLY ON THE RIGHT SIDE TRAVELING WEST TO EAST OR SOUTH TO NORTH.
2. FOR POST-MOUNTED SIGNS, THE MINIMUM LATERAL OFFSET SHOULD BE TWELVE FEET FROM THE EDGE OF THE TRAVELED WAY. IF A SHOULDER WIDER THAN 6' EXISTS, THE MINIMUM LATERAL OFFSET FOR POST-MOUNTED SIGNS SHOULD BE 6' FROM THE EDGE OF THE SHOULDER.



1.500" RADIUS, 0.375" BORDER, WHITE ON GREEN;  
STANDARD ARROW CUSTOM 9.000" X 6.125" 45°;

**VD1-1**



1.500" RADIUS, 0.375" BORDER, WHITE ON GREEN;  
STANDARD ARROW CUSTOM 9.000" X 6.125" 45°;

**VD1-1A**



1.500" RADIUS, 0.375" BORDER, WHITE ON GREEN;  
STANDARD ARROW CUSTOM 9.000" X 6.125" 45°;

**VD1-1A**



1.500" RADIUS, 0.375" BORDER, WHITE ON GREEN;  
STANDARD ARROW CUSTOM 9.000" X 6.125" 45°;

**VD1-1A**



1.500" RADIUS, 0.375" BORDER, WHITE ON GREEN;  
STANDARD ARROW CUSTOM 9.000" X 6.125" 45°;

**VD2-1**

**STANDARD DESTINATION SIGN NOTES  
VD1-1, VD1-1A, VD2-1**

- 1.) THE DESTINATION SIGNS SHOWN ON THIS SHEET SHALL HAVE WHITE RETROREFLECTIVE ASTM D 4956 TYPE III OR IV TEXT, ARROWS AND BORDERS ON A GREEN RETROREFLECTIVE ASTM D 4956 TYPE III OR IV BACKGROUND.
- 2.) USE THE LARGEST LETTER / THICKEST FONT AVAILABLE THAT WILL SATISFY THE MINIMUM SPACING REQUIREMENTS, AS SHOWN IN THE DETAILS ABOVE; I.e. IF A 6" SERIES C LETTER DOES NOT WORK, DUE TO THE LENGTH OF THE WORD, USE A 6" SERIES B LETTER, IF A 6" SERIES B LETTER DOES NOT WORK, USE A 5" SERIES C. USE NO LESS THAN 80% KERNING.



1.500" RADIUS, 0.375" BORDER, WHITE ON GREEN;  
STANDARD ARROW CUSTOM 9.000" X 6.125" 45°;


**VD1-1A**



1.500" RADIUS, 0.375" BORDER, WHITE ON GREEN;  
STANDARD ARROW CUSTOM 9.000" X 6.125" 135°


**VD1-1A**

SEE NOTE 2 BELOW:

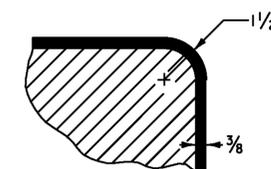


**BORDER DETAIL**

TRIM CORNERS

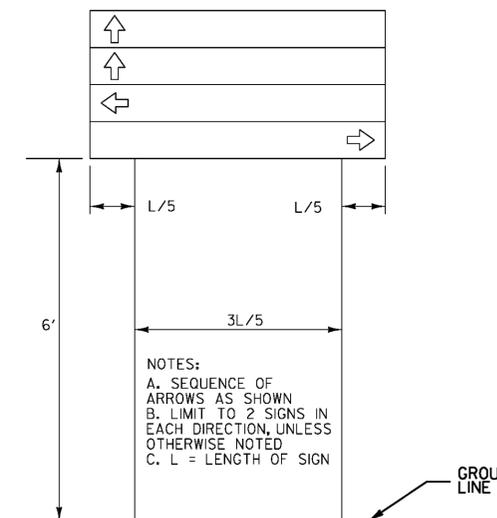

**DESTINATION ASSEMBLY**

- NOTES:
- A. SEQUENCE OF ARROWS AS SHOWN
  - B. LIMIT TO 2 SIGNS IN EACH DIRECTION, UNLESS OTHERWISE NOTED
  - C. L = LENGTH OF SIGN

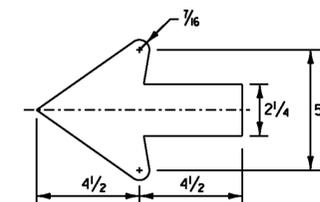

**STANDARD SHS 2.25" ARROW**

NOT TO SCALE  
ALL DIMENSIONS SHOWN IN INCHES, EXCEPT WHERE NOTED.

PROJECT NAME: STATEWIDE - NORTHWEST REGION

PROJECT NUMBER: STPG SIGN (42)

FILE NAME: I2BI20.DGN  
PROJECT LEADER: A. GAMBLE  
DESIGNED BY: T. GUAZZONI  
SIGN DETAIL SHEET 1

PLOT DATE: 17-AUG-2012  
DRAWN BY: T. GUAZZONI  
CHECKED BY: A. GAMBLE  
SHEET 4 OF 69