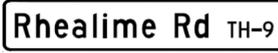


DIRECTION	MILEPOINT	LOCATION CODE (SHEET 2)	SIGN CODE	WIDTH (IN)	HEIGHT (IN)	SHEETING REMARKS	SIGN LEGEND	NEW SIGNS		EXISTING SIGNS				EXIST POST		NUMBER OF NEW POSTS	SQUARE STEEL (IN)			TUBULAR STEEL Ø (IN)				SIGN FRAME REQUIRED	REMARKS	SIGN DETAIL LOCATION					
								"A"	"B"	RETAIN	SALVAGE FROM	SALVAGE TO	REMOVE	RETAIN	REMOVE		1.75	2.00	2.50	FOUNDATION	3.00	3.50	4.00			5.00	SHSM	PROJECT SHEET #	STANDARD SHEET #		
																	(LB / FT)				(LB / FT)										
HIGHGATE US7 NB							FY-FLUORESCENT YELLOW FYG-FLUORESCENT YELLOW GREEN															"SHSM"-STANDARD HIGHWAY SIGNS AND MARKINGS									
		C	VR-017	24	30			5.00						1		X							RHEALIME RD (TH-9)		7						
		C	R2-1	24	30			5.00																X							
NB	5.510	A	D3-1	XX	XX		STREET NAME SIGN																								
		D	R1-1	24	24									1																	
		D	R1-1	30	30			6.25						1		X							RHEALIME RD (TH-9) ALIGN POST SO IT FACES TOWN HIGHWAY TRAFFIC BETTER	X							
NB	5.51	A	D3-1	60	12			5.00						2		X							SIGN LOCATION TO BE DETERMINED IN FIELD		5						
NB	5.68	A	D4-1	30	24									1	X																
		A	D4-1	30	24			5.00																X							
NB	5.710	A	VD-062B	72	16		BUSINESS SIGN			1																					
NB	5.760	B	VD-062B	72	16		BUSINESS SIGN			1																					
NB	5.775	A	M2-1	21	15		JCT			1																					
		A	M1-1	24	24		INTERSTATE 89			1																					
NB	5.800	A	D1-1M	72	10		DESTINATION SIGN			1																					
		A	UNK	UNK	UNK		CHAMPLAIN BIKEWAY			1																					
		A	UNK	UNK	UNK		UP ARROW			1																					
SIGN SUMMARY SHEET							SHEET TOTALS	26.25	0.00	7	0	0	2 3	0	0	4	60.0	0	0.0	0.0	0.0	0.0	0.0	0.0	PROJECT NAME: Statewide-NW Region						
								SF	SF	EA	EA	EA	EA	EA	EA	EA	EA	EA	EA	EA	EA	EA	EA	EA	EA	EA	EA	PROJECT NUMBER: STPG SIGN(42)			
																													FILE NAME: Highgate us7NB.xls	PLOT DATE: 8/30/2012	
VERMONT AGENCY OF TRANSPORTATION							TOWN DIRECTIONAL TOTALS	108.3	0.0	57	5	5	19	0	0	24	360.0	0		0.0				PROJECT MANAGER: A. Gamble	DRAWN BY: T. Guazzoni						
																								DESIGNED BY: T. Guazzoni	CHECKED: A. Gamble						
																									HIGHGATE US7 NB SHEET 4	SHEET 60 OF 69					