

STATE OF VERMONT AGENCY OF TRANSPORTATION



PROPOSED IMPROVEMENT BRIDGE PROJECT


TOWN OF WAITSFIELD
COUNTY OF WASHINGTON

ROUTE NO : VT 100 (MINOR ARTERIAL) BRIDGE NO : 177

BEGINNING AT A POINT APPROXIMATELY 0.8 MILES SOUTH OF JUNCTION OF VT ROUTE 100 WITH
VT ROUTE 17 AND EXTENDING NORTHERLY 576 FEET ALONG VT ROUTE 100

WORK TO BE PERFORMED UNDER THIS PROJECT INCLUDES REPLACEMENT OF THE EXISTING BRIDGE
WITH A NEW BRIDGE ON THE EXISTING ALIGNMENT WITH NECESSARY ROADWAY AND CHANNEL WORK.

LENGTH OF STRUCTURE: 179.43 FEET
LENGTH OF ROADWAY: 396.57 FEET
LENGTH OF PROJECT: 576.00 FEET

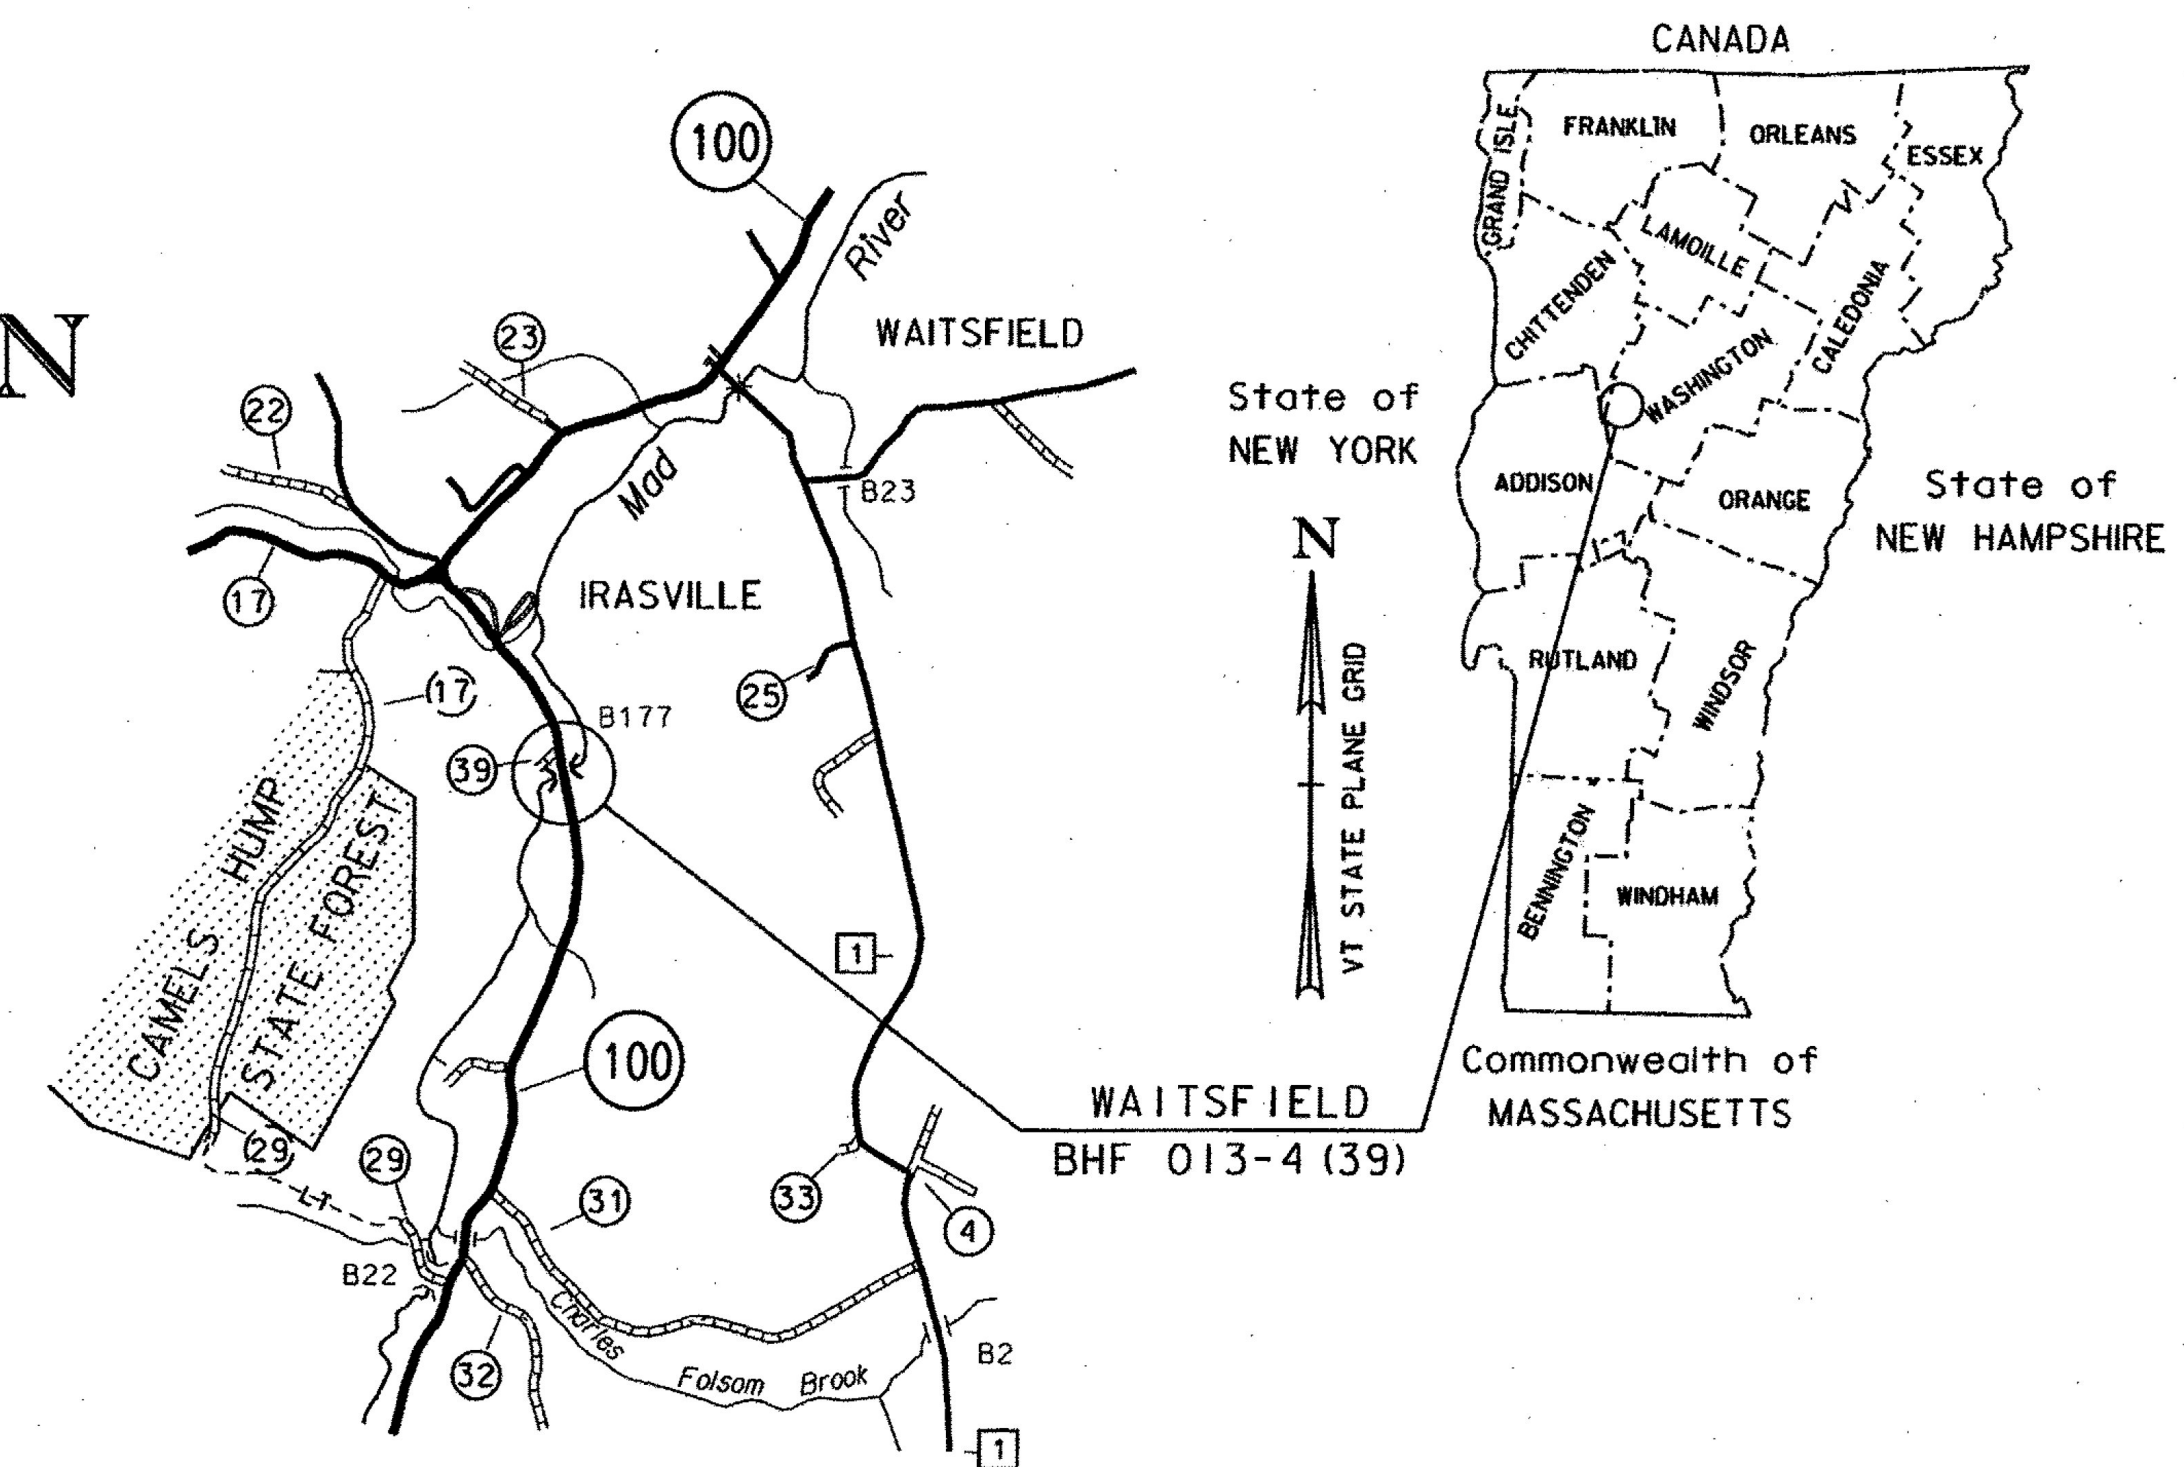


Record Plans
Contractor: A.L. ST. ONGE CONTRACTOR, INC. - MONTGOMERY, VT
Resident Engineer: ROBERT SUCKERT
Construction Began: APRIL 25, 2016
Construction Complete: SEPTEMBER 19, 2017
Record Plans By: ROBERT SUCKERT & JESSE IVES

I hereby certify that all construction required by this set of drawings has been accomplished as indicated herein.

BY: E-SIGNED by Thomas Mancini on 2019-01-18 18:50:13 UTC Resident Engineer

Date: January 18, 2019

NOTE: Any further information concerning final quantities, amounts or other details relative to this project may be found at Central Files in the electronic archives.

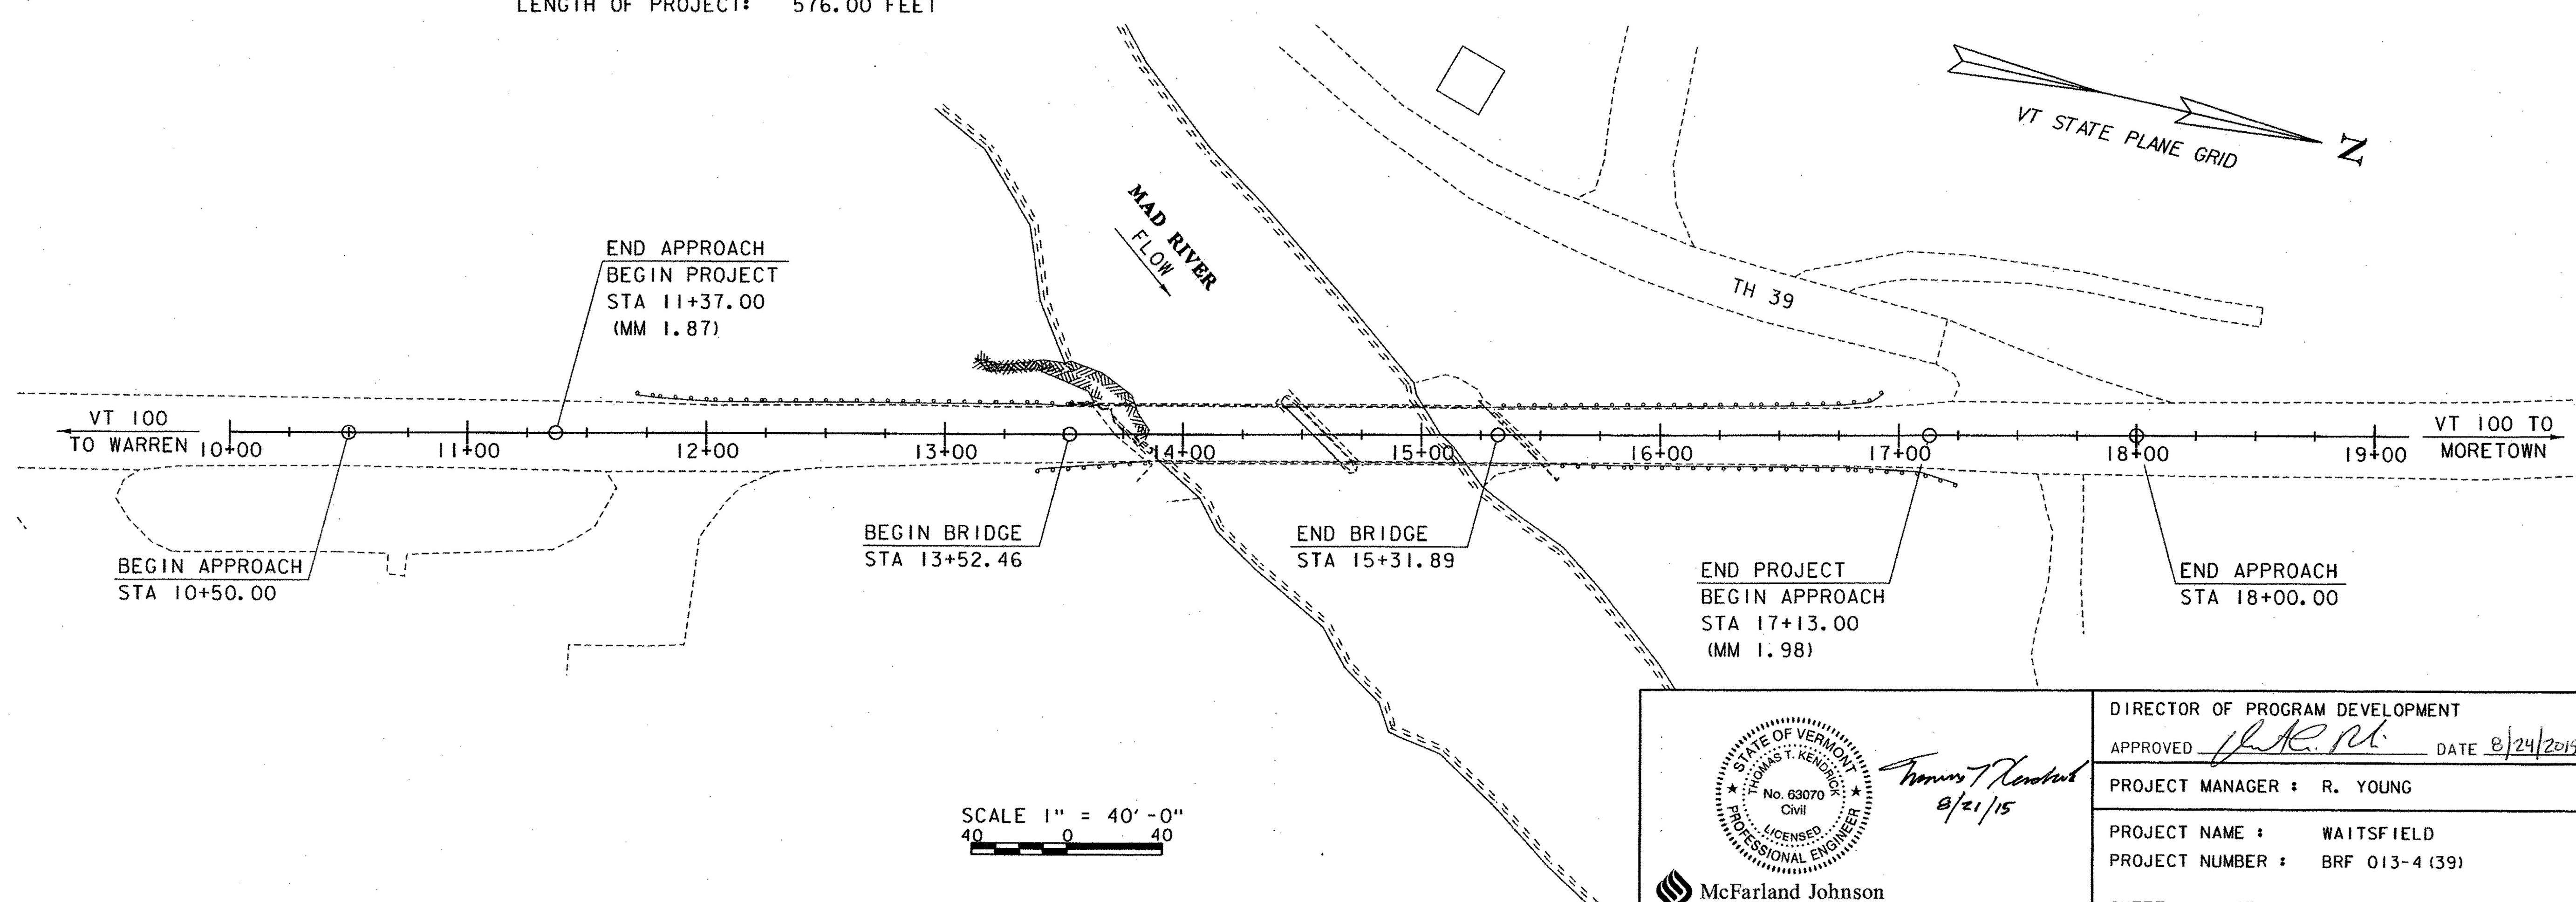

THESE PLANS ARE SUBJECT TO SUCH ENGINEERING CHANGES AS MAY BE REQUIRED BY THE FEDERAL HIGHWAY ADMINISTRATION OR THE DIRECTOR OF PROGRAM DEVELOPMENT.
CONSTRUCTION IS TO BE CARRIED ON IN ACCORDANCE WITH THESE PLANS AND THE STANDARD SPECIFICATIONS FOR CONSTRUCTION DATED 2014, AS APPROVED BY THE FEDERAL HIGHWAY ADMINISTRATION ON JULY 20, 2011 FOR USE ON THIS PROJECT, INCLUDING ALL SUBSEQUENT REVISIONS AND SUCH REVISED SPECIFICATIONS AND SPECIAL PROVISIONS AS ARE INCORPORATED IN THESE PLANS.

QUALITY ASSURANCE PROGRAM : LEVEL 2	
SURVEYED BY :	G. HITCHCOCK
SURVEYED DATE :	5-23-2012
DATUM	
VERTICAL	NAVD88
HORIZONTAL	NAD83 (2007)

SCALE 1" = 40' - 0"
40 0 40

Thomas T. Hendrick
8/21/15

McFarland Johnson

DIRECTOR OF PROGRAM DEVELOPMENT	
APPROVED <u>[Signature]</u>	DATE 8/24/2015
PROJECT MANAGER : R. YOUNG	
PROJECT NAME : WAITSFIELD	
PROJECT NUMBER : BRF 013-4 (39)	
SHEET 1 OF 69 SHEETS	