

COLD PLANING, BITUMINOUS PAVEMENT

STA 17+50 - STA 18+00 LT
 STA 17+50 - STA 18+00 RT

CONSTRUCT DRIVE (HAND PLACED)

STA 17+16 - STA 18+00 LT

REMOVING SIGNS

STA 16+88 RT

ERECTING SALVAGED SIGNS

STA 16+88 RT

SETTING SALVAGED SIGN POSTS

STA 16+88 RT

4" WHITE LINE (4" WL)

STA 16+25 - STA 17+25, LT
 STA 16+25 - STA 18+00, RT

4" YELLOW LINE (4" DYCL)

STA 16+25 - 18+00
 (CL DOUBLE)

REMOVAL AND DISPOSAL OF GUARDRAIL


STA 16+25 - STA 17+25 RT

STEEL BEAM GUARDRAIL GALVANIZED

STA 16+25 - STA 16+63 RT

MANUFACTURED TERMINAL SECTION, TANGENT

STA 16+24 - STA 16+74 LT
 STA 16+63 - STA 17+13 RT

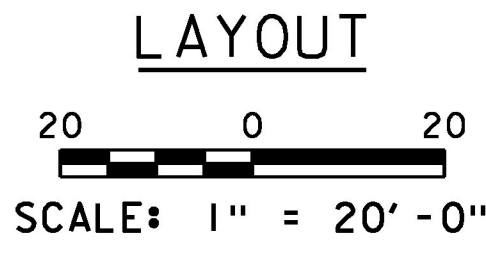

PROJECT NAME: WAITSFIELD	
PROJECT NUMBER: BRF 013-4(39)	
FILE NAME: z12b136bdr.dgn	PLOT DATE: 8/24/2015
PROJECT LEADER: R. YOUNG	DRAWN BY: S.MERKWAN
DESIGNED BY: D. KULL	CHECKED BY: T. KENDRICK
LAYOUT SHEET 2	SHEET 14 OF 69