



PLAN

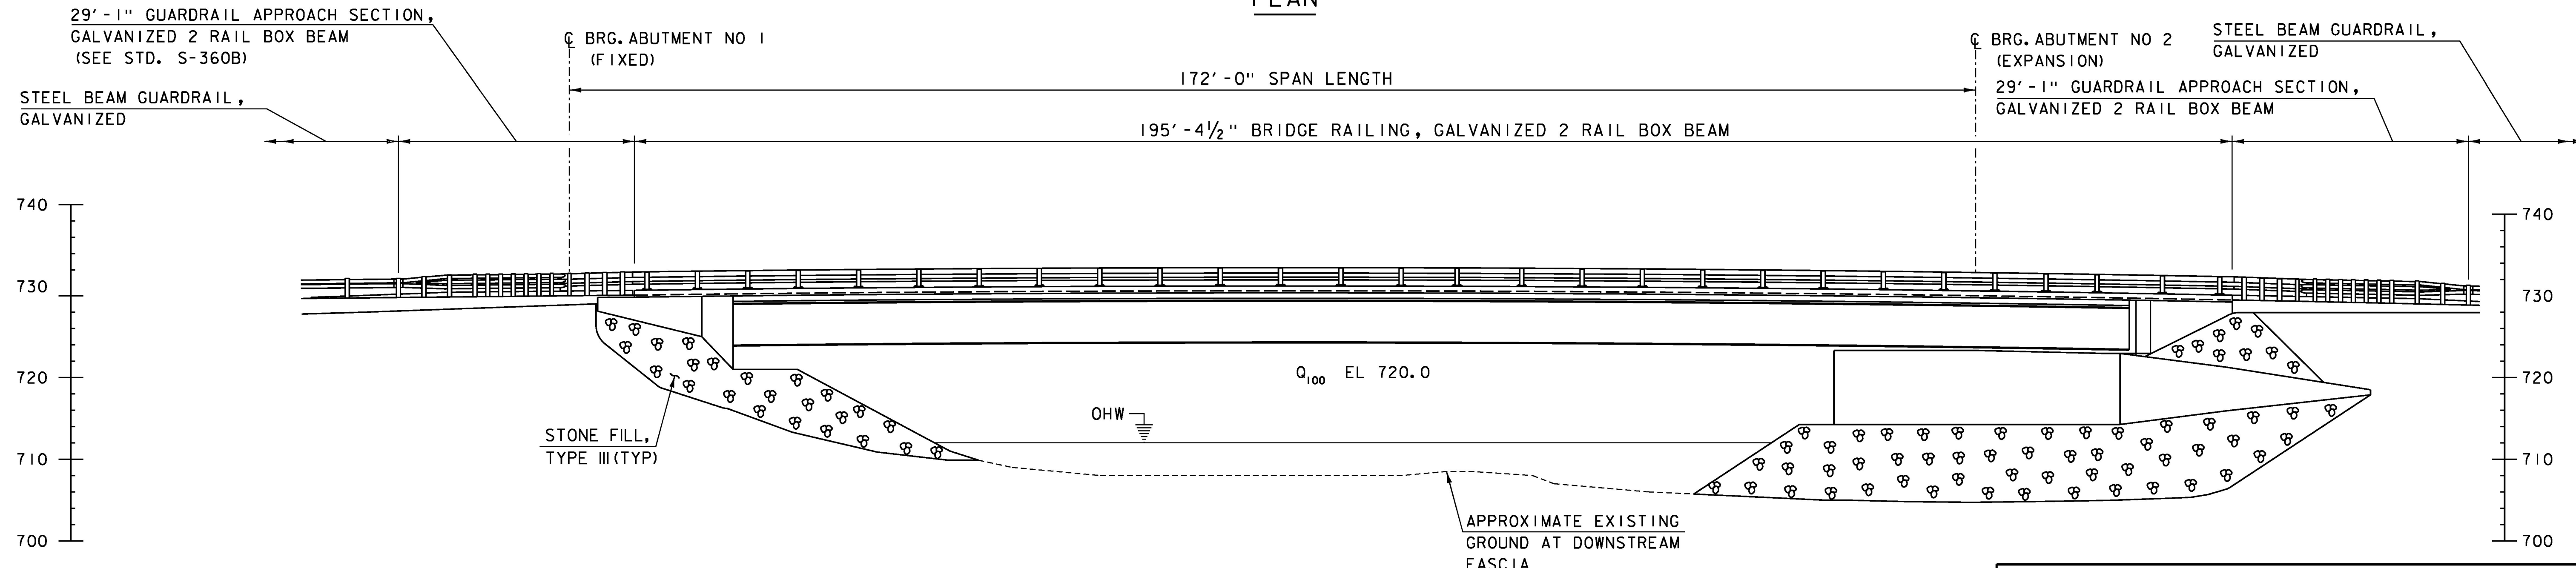

ELEVATION

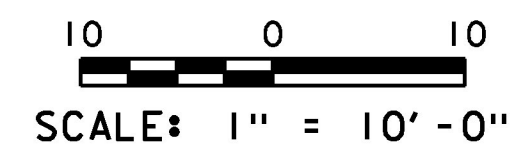

PROJECT NAME: WAITSFIELD	
PROJECT NUMBER: BRF 013-4(39)	
FILE NAME: z12b136pe.dgn	PLOT DATE: 8/24/2015
PROJECT LEADER: R. YOUNG	DRAWN BY: S.MERKWAN
DESIGNED BY: D. KULL	CHECKED BY: T. KENDRICK
PLAN AND ELEVATION	SHEET 22 OF 69