
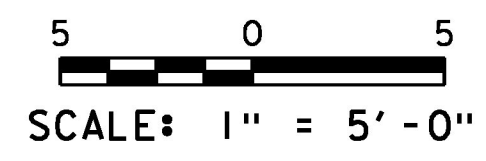


LEGEND:
 APPROXIMATE LOCATION OF EXISTING ABUTMENT AND PILES TO BE COMPLETELY REMOVED ABOVE EL. 711.0.

NOTE:
 PROPOSED BRIDGE SUPERSTRUCTURE AND APPROACH SLABS NOT SHOWN FOR CLARITY.

ABUTMENT NO 2 GRADING PLAN



PROJECT NAME:	WAITSFIELD	PLOT DATE:	8/24/2015
PROJECT NUMBER:	BRF 013-4(39)	DRAWN BY:	S. MERKWAN
FILE NAME:	z12b136abut_grd.dgn	CHECKED BY:	T. KENDRICK
PROJECT LEADER:	R. YOUNG	DESIGNED BY:	D. KULL
DESIGNED BY:	D. KULL	ABUTMENT NO 2 GRADING PLAN	SHEET 24 OF 69