


TYPICAL EXTERIOR END PANEL REINFORCEMENT PLAN
 ACUTE FASCIA PANEL SHOWN, OBTUSE INTERIOR PANEL SIMILAR
 SCALE: 3/4" = 1'-0"

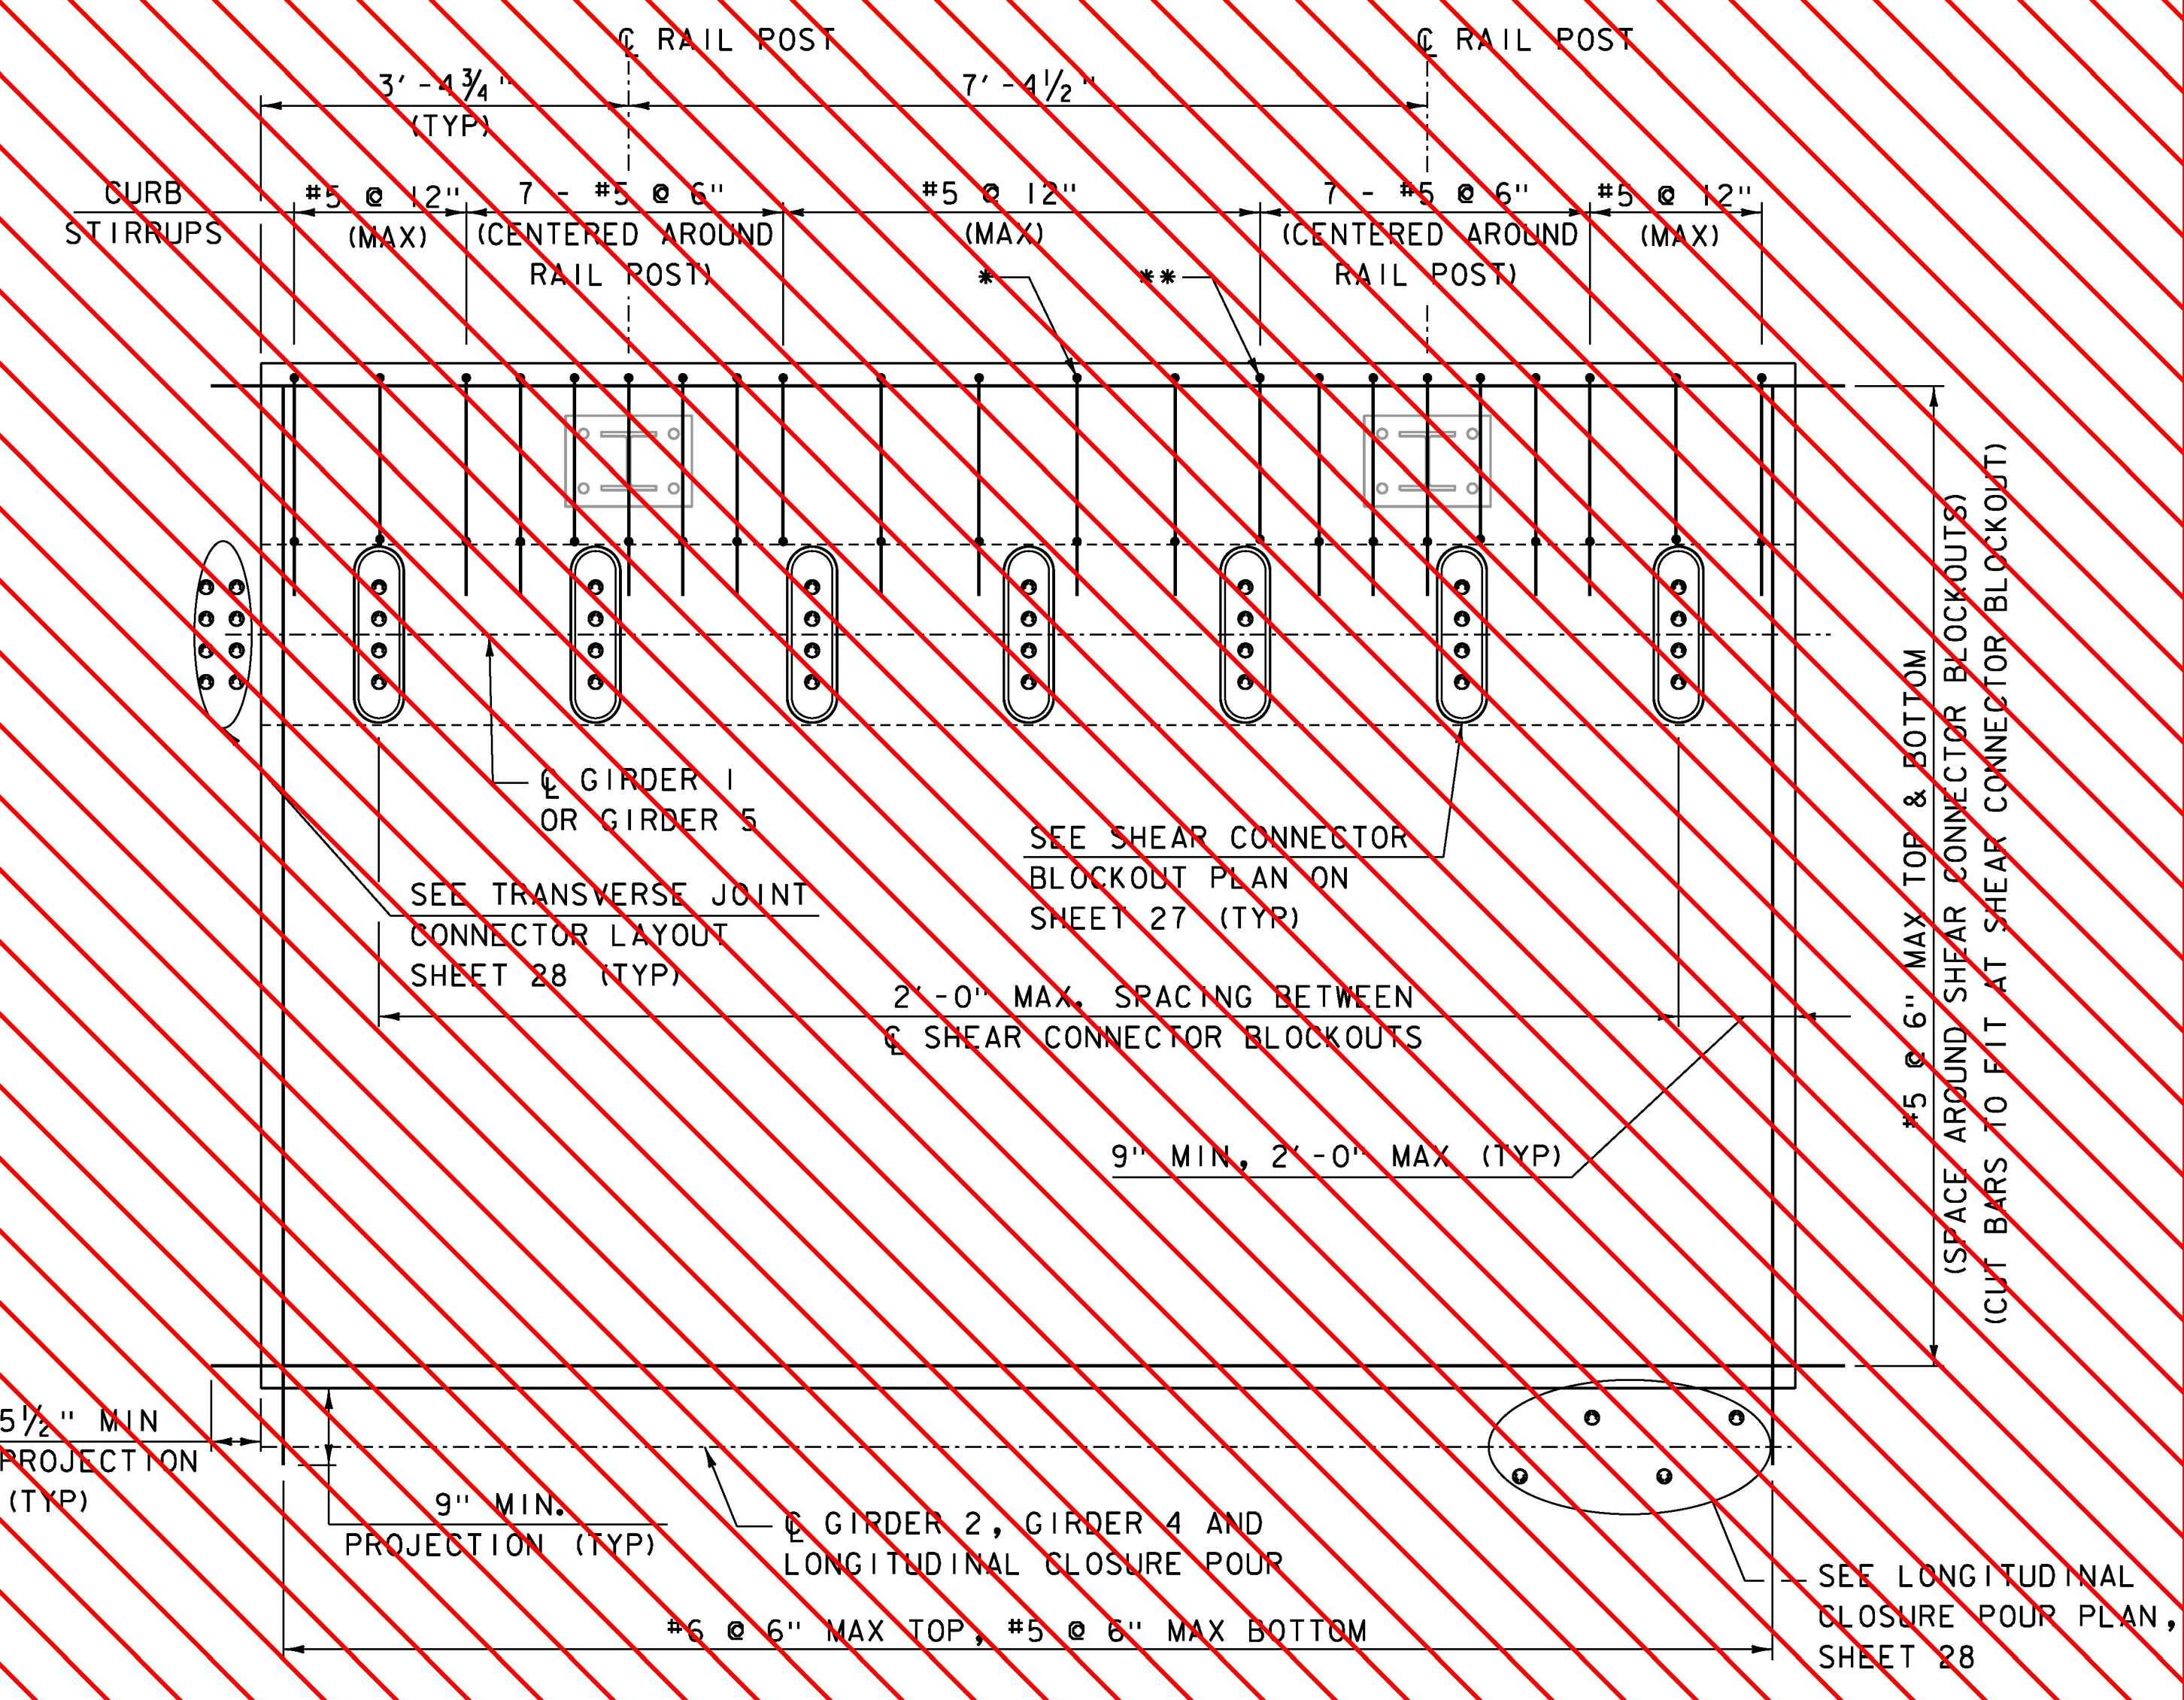

TYPICAL EXTERIOR PANEL REINFORCEMENT PLAN
 (FASCIA PANEL SHOWN, INTERIOR PANEL SIMILAR)
 SCALE: 3/4" = 1'-0"

- * PROJECT STIRRUP LEGS AS SHOWN OUTSIDE OF SHEAR CONNECTOR BLOCKOUT (TYP)
- ** PROJECT STIRRUP LEGS INTO CURB AT SHEAR CONNECTOR BLOCKOUT (TYP)

NOTE:
 NF = NEAR FACE
 FF = FAR FACE
 EF = EACH FACE
 ▲ = CUT TO FIT IN FIELD
 3" CLEAR, UNLESS OTHERWISE SPECIFIED ON THE PLANS.
 2'-2" BAR LAP UNLESS OTHERWISE SPECIFIED ON THE PLANS.

SEE REVISED SHEET 26 BY T.Y. LIN INTERNATIONAL



PROJECT NAME:	WAITSFIELD	PLOT DATE:	8/24/2015
PROJECT NUMBER:	BRF 013-4(39)	DRAWN BY:	S.MERKWAN
FILE NAME:	z12b136sup_panel.dgn	CHECKED BY:	T.KENDRICK
PROJECT LEADER:	R.YOUNG	SHEET	26 OF 69
DESIGNED BY:	D.KULL		
PRECAST DECK DETAILS			