


**BRIDGE RAIL LAYOUT**  
SCALE: 1" = 10'-0"

**NOTE**

- RAIL DIMENSIONS HAVE BEEN PROVIDED FOR INFORMATION ONLY. ACTUAL RAIL DIMENSIONS MAY BE REVISED BY CONTRACTOR BASED ON FINAL DIMENSIONS OF DECK PANELS. REFER TO S-360A FOR DETAILS.

REV	DATE	DESCRIPTION
△VE	02/03/16	MODIFICATIONS FOR CHANGED DECK TYPE

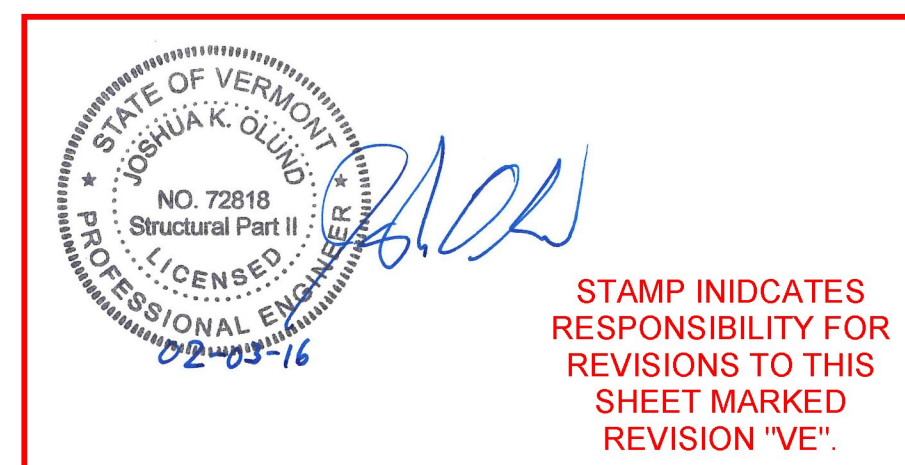

STAMP INDICATES RESPONSIBILITY FOR REVISIONS TO THIS SHEET MARKED REVISION "VE".

10 0 10  
SCALE: 1" = 10'-0"



PROJECT NAME: WAITSFIELD	PLOT DATE: 8/24/2015
PROJECT NUMBER: BRF 013-4(39)	DRAWN BY: S.MERKWAN
FILE NAME: z12b136bdr_raillay.dgn	CHECKED BY: T. KENDRICK
PROJECT LEADER: R. YOUNG	SHEET 29 OF 69
DESIGNED BY: D. KULL	
BRIDGE RAIL LAYOUT SHEET	