



CAMBER TABLE - GIRDERS 1 & 5 (INCHES)																					
POINT ON GIRDER	CL BRG ABUT 1	0.05 L	0.10 L	0.15 L	0.20 L	0.25 L	0.30 L	0.35 L	0.40 L	0.45 L	0.50 L	0.55 L	0.60 L	0.65 L	0.70 L	0.75 L	0.80 L	0.85 L	0.90 L	0.95 L	CL BRG ABUT 2
STEEL DL	0.00	0.67	1.14	1.62	2.09	2.48	2.82	3.08	3.27	3.39	3.43	3.38	3.27	3.08	2.82	2.49	2.09	1.62	1.11	0.57	0.00
CONCRETE SLAB	0.00	1.07	2.11	3.08	3.96	4.72	5.34	5.84	6.21	6.43	6.51	6.48	6.21	5.84	5.34	4.72	3.96	3.08	2.11	1.07	0.00
SUPERIMPOSED DL	0.00	0.31	0.61	0.89	1.15	1.37	1.55	1.70	1.81	1.87	1.90	1.87	1.81	1.70	1.55	1.37	1.15	0.89	0.61	0.31	0.00
TOTAL DEFLECTION	0.00	1.95	3.83	5.60	7.19	8.57	9.71	10.62	11.29	11.65	11.83	11.69	11.29	10.62	9.71	8.57	7.19	5.60	3.83	1.95	0.00
VERTICAL ORDINATE	0.00	1.41	2.67	3.79	4.75	5.57	6.24	6.76	7.13	7.35	7.43	7.35	7.13	6.76	6.24	5.57	4.75	3.79	2.67	1.41	0.00
TOTAL CAMBER	0.00	3.36	6.51	9.39	11.95	14.14	15.95	17.38	18.42	19.05	19.26	19.05	18.42	17.38	15.95	14.14	11.95	9.39	6.51	3.36	0.00

CAMBER TABLE - GIRDERS 2, 3 & 4 (INCHES)																					
POINT ON GIRDER	CL BRG ABUT 1	0.05 L	0.10 L	0.15 L	0.20 L	0.25 L	0.30 L	0.35 L	0.40 L	0.45 L	0.50 L	0.55 L	0.60 L	0.65 L	0.70 L	0.75 L	0.80 L	0.85 L	0.90 L	0.95 L	CL BRG ABUT 2
STEEL DL	0.00	0.60	1.18	1.72	2.20	2.63	2.97	3.25	3.46	3.58	3.62	3.58	3.46	3.25	2.97	2.63	2.20	1.72	1.18	0.60	0.00
CONCRETE SLAB	0.00	1.23	2.42	3.53	4.54	5.40	6.12	6.70	7.12	7.37	7.46	7.37	7.12	6.70	6.12	5.40	4.54	3.53	2.42	1.23	0.00
SUPERIMPOSED DL	0.00	0.30	0.59	0.85	1.10	1.31	1.49	1.63	1.73	1.79	1.81	1.79	1.73	1.63	1.49	1.31	1.10	0.85	0.59	0.30	0.00
TOTAL DEFLECTION	0.00	2.12	4.18	6.10	7.84	9.34	10.58	11.58	12.30	12.74	12.89	12.74	12.30	11.58	10.58	9.34	7.84	6.10	4.18	2.12	0.00
VERTICAL ORDINATE	0.00	1.41	2.67	3.79	4.75	5.57	6.24	6.76	7.18	7.35	7.43	7.35	7.18	6.76	6.24	5.57	4.75	3.79	2.67	1.41	0.00
TOTAL CAMBER	0.00	3.53	6.85	9.89	12.59	14.91	16.82	18.34	19.43	20.10	20.32	20.10	19.43	18.34	16.82	14.91	12.59	9.89	6.85	3.53	0.00

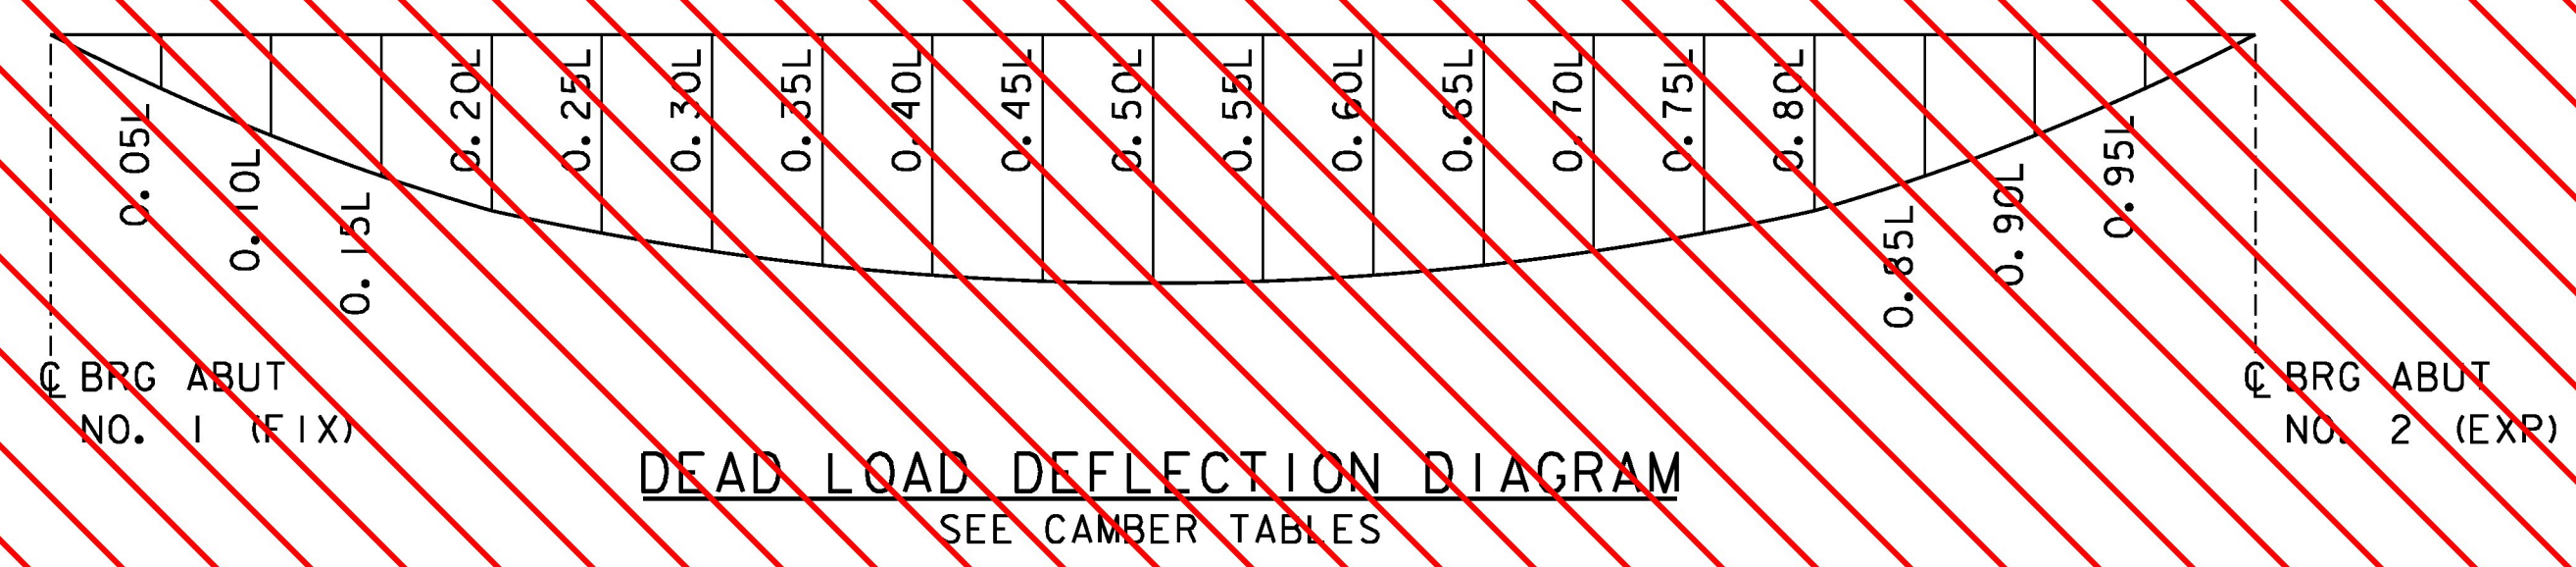

SEE REVISED SHEET 32 BY T.Y. LIN INTERNATIONAL

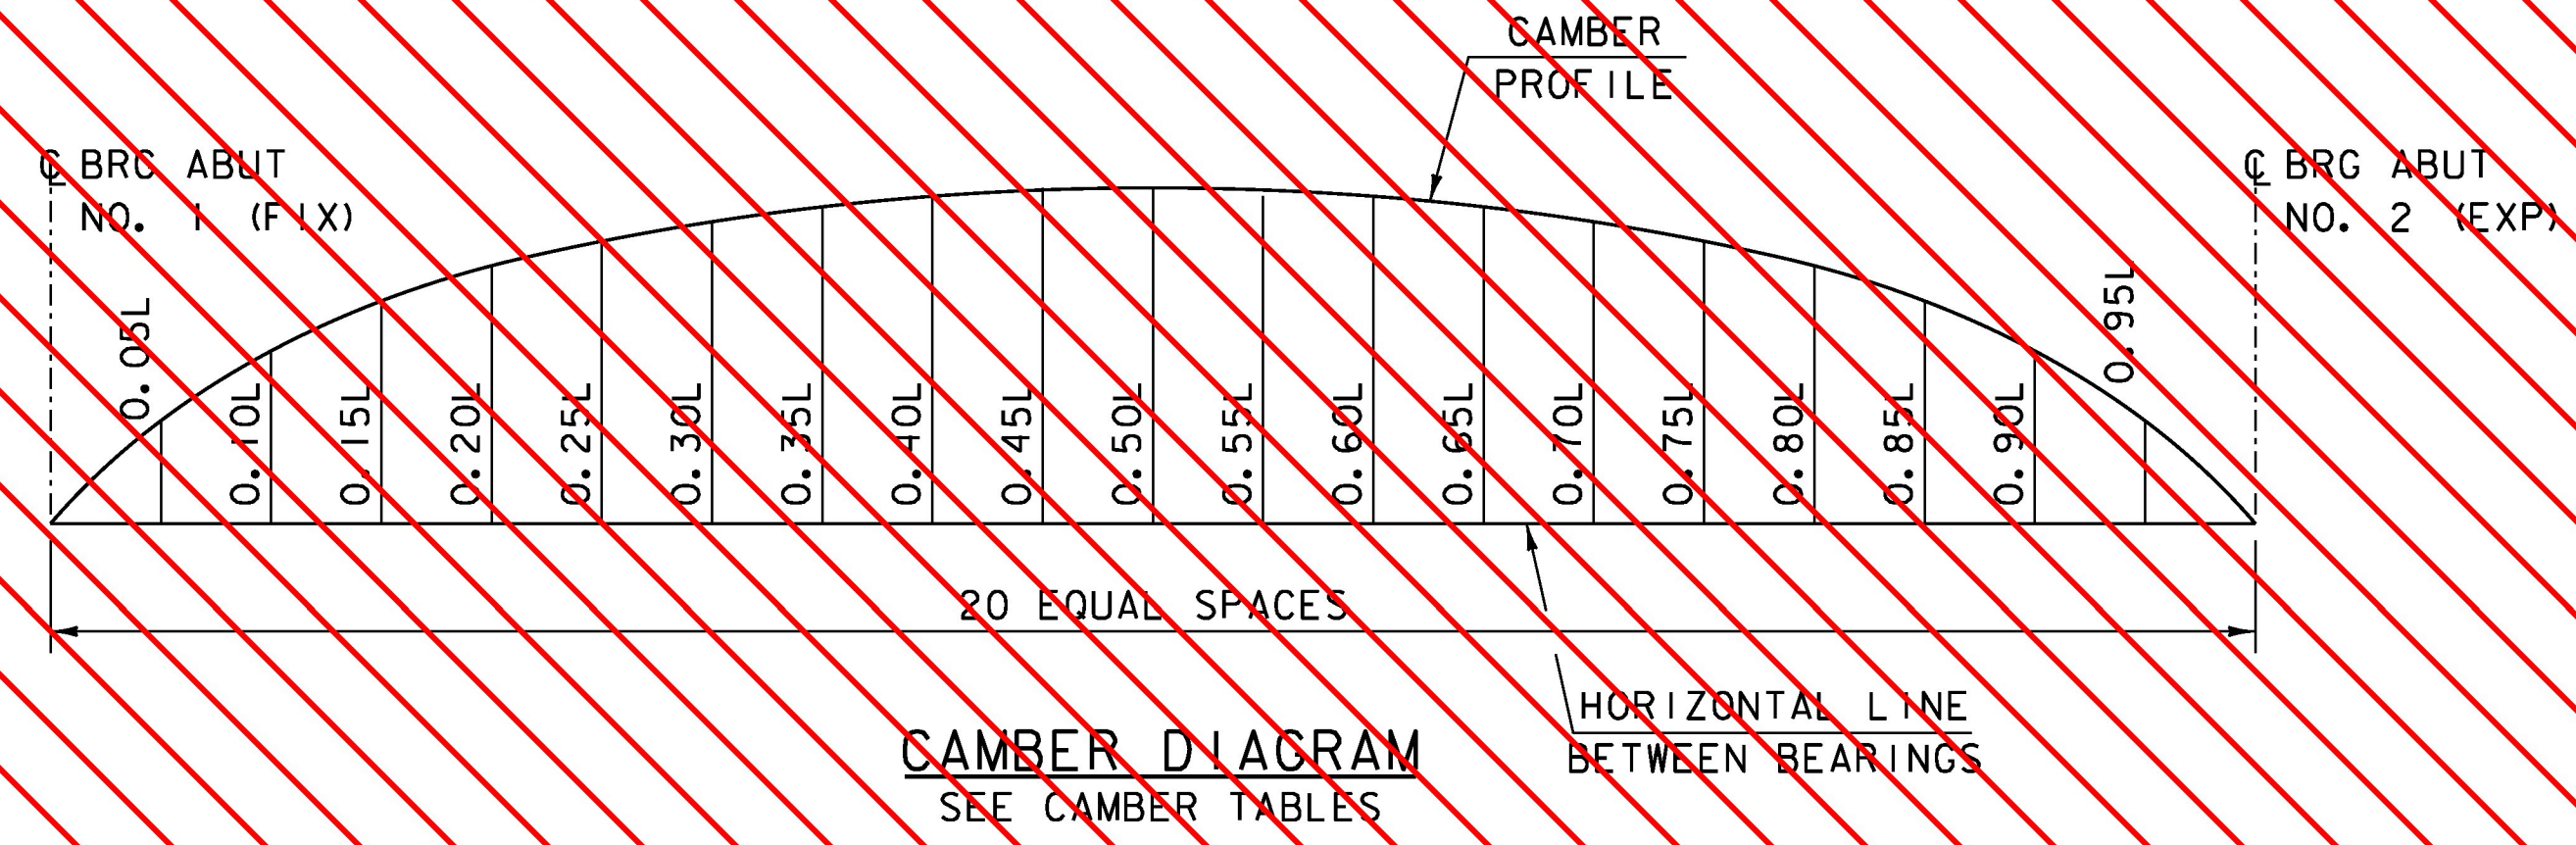

PROJECT NAME:	WAITSFIELD	PLOT DATE:	8/24/2015
PROJECT NUMBER:	BRF 013-4(39)	DRAWN BY:	S.MERKWAN
FILE NAME:	I20136sup_frm.dgn	CHECKED BY:	T.KENDRICK
PROJECT LEADER:	R. YOUNG	DESIGNED BY:	D. KULL
CAMBER DETAILS		SHEET	32 OF 69