


ABUTMENT NO. 1 FOOTING REINFORCING PLAN

SCALE:  $\frac{3}{8}'' = 1' - 0''$   
 NOTE: LEVELING BOLTS AND GROUT PORTS NOT SHOWN FOR CLARITY

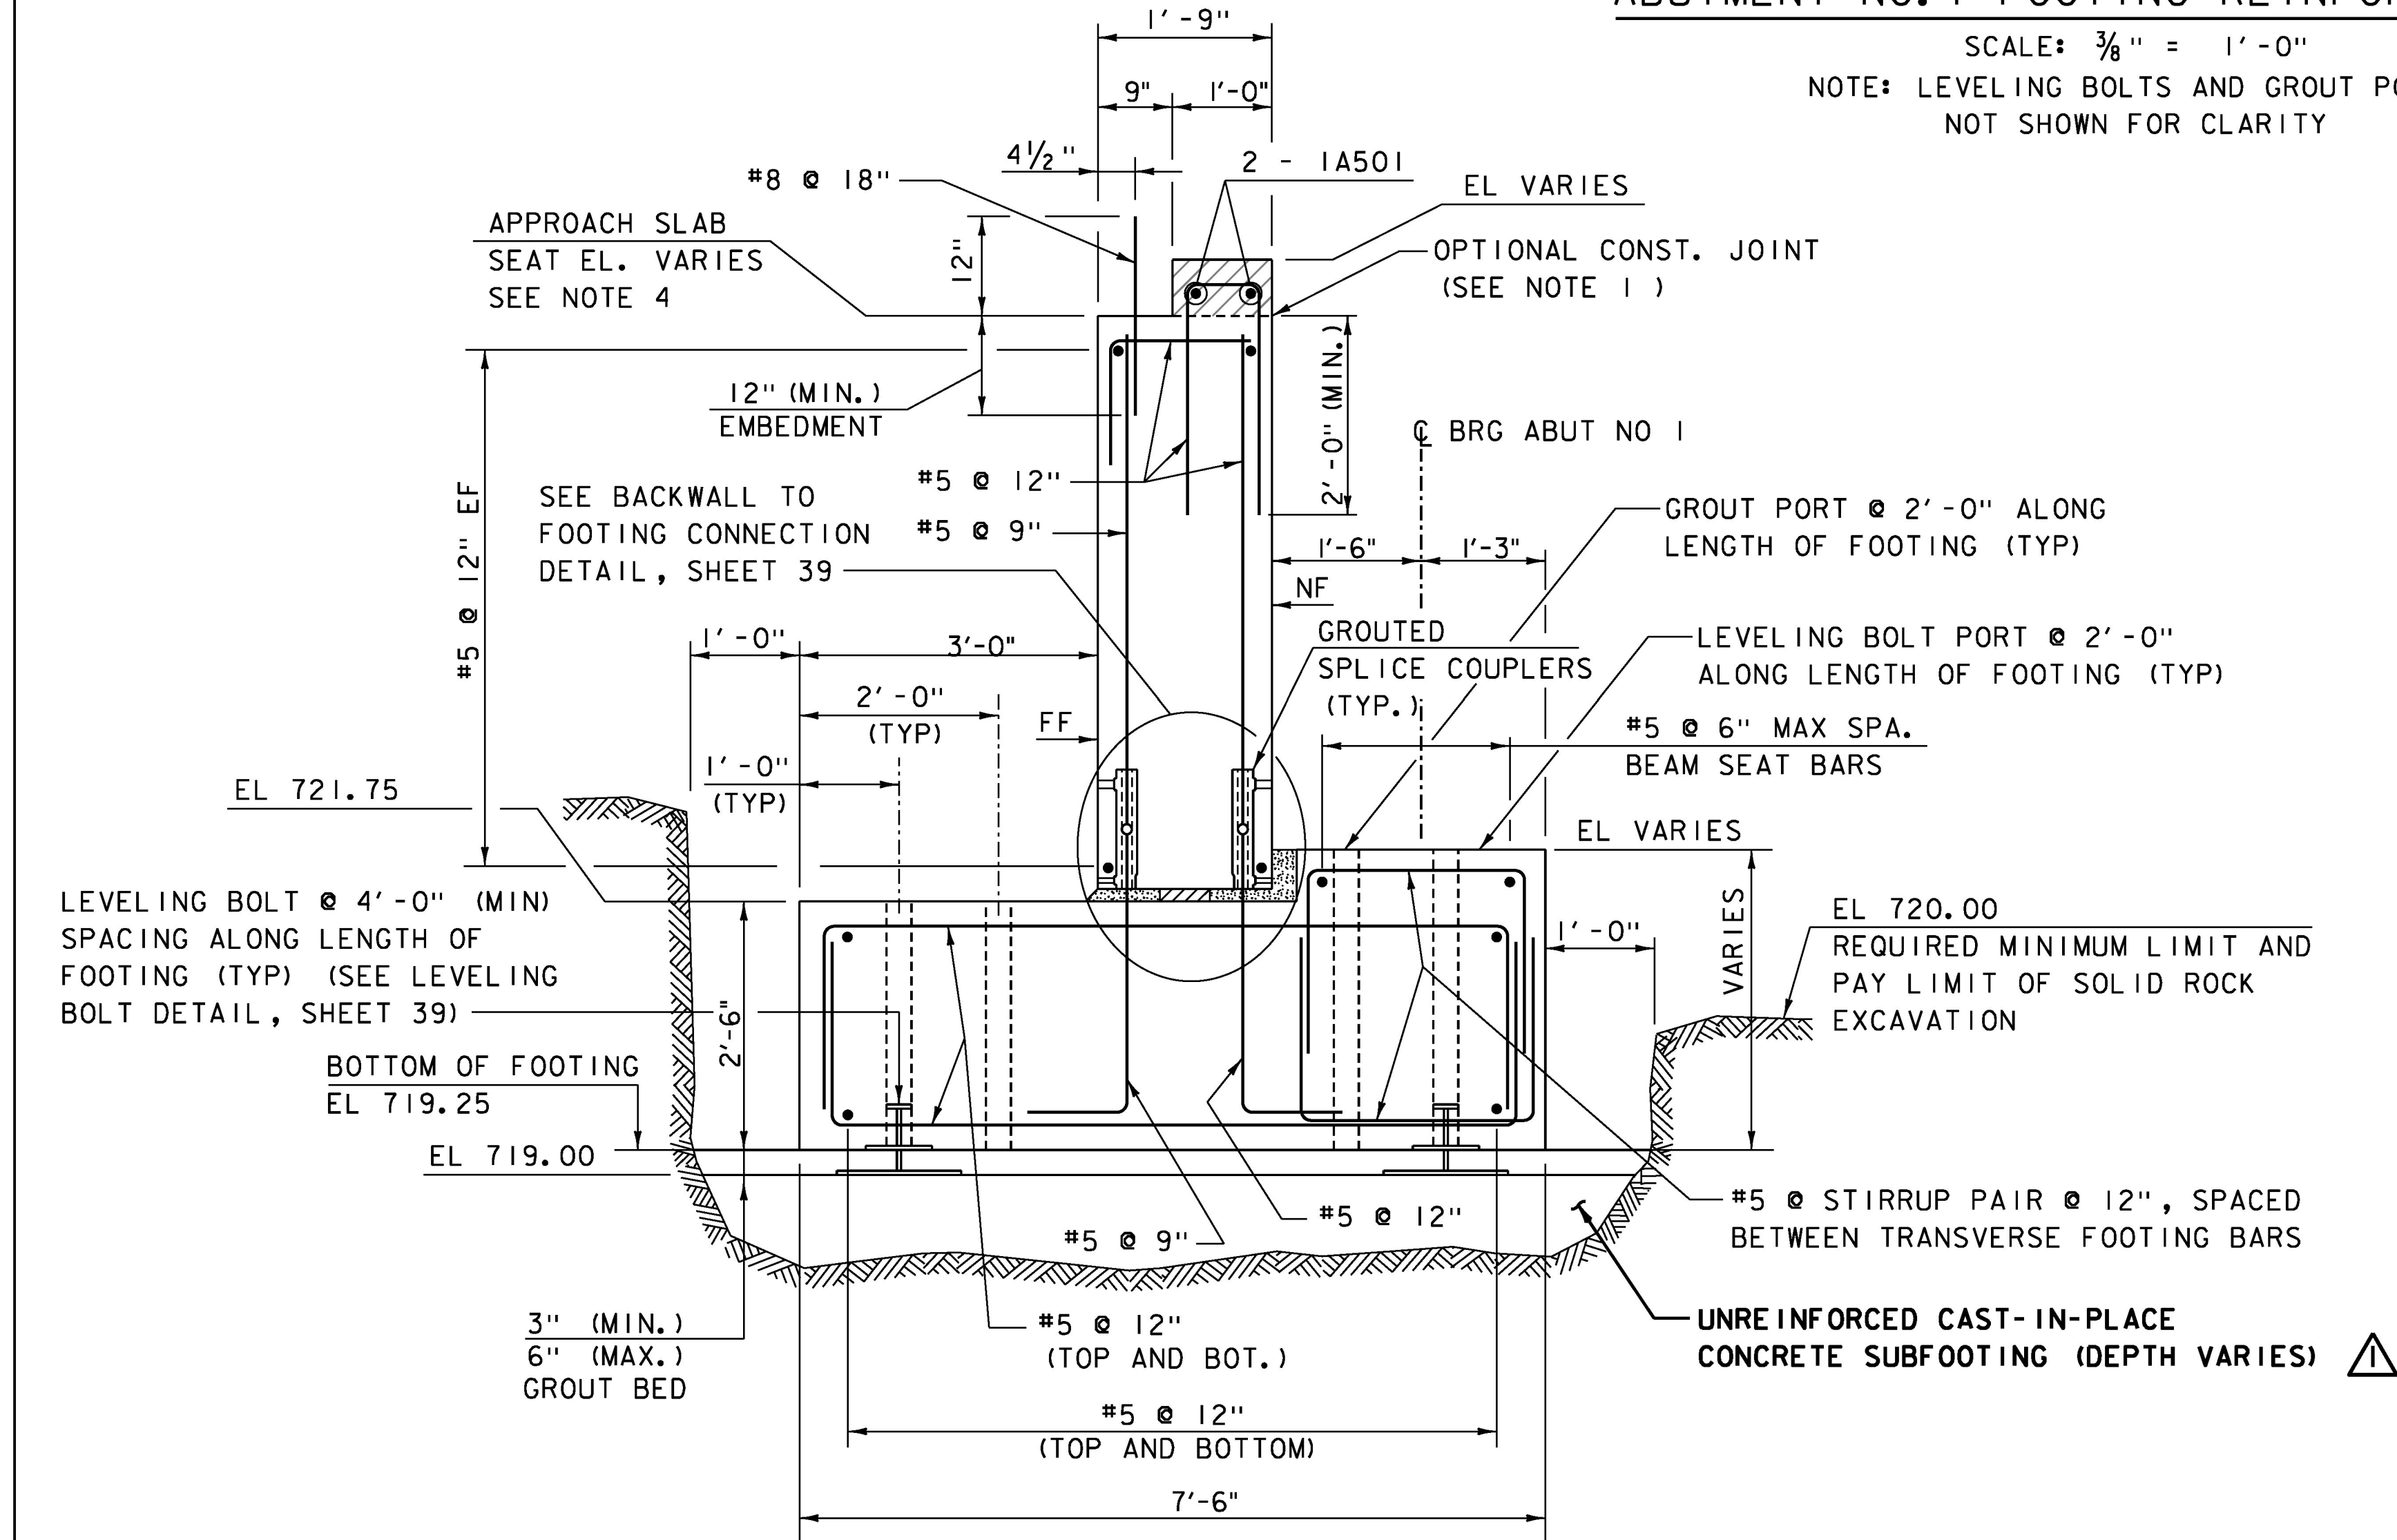

TYPICAL ABUTMENT NO. 1 SECTION

SCALE:  $\frac{3}{4}'' = 1' - 0''$

LEGEND

SPECIAL PROVISION (HIGH PERFORMANCE CONCRETE, RAPID SET) (FPQ)

NOTES

1. THE CONSTRUCTION JOINTS ABOVE THE APPROACH SLAB SEAT AND BEAM SEATS ARE OPTIONAL AND MAY BE INCLUDED WITH THE PRECAST BACKWALL. THE BACKWALL MAY ALSO BE PRECAST WITH THE FOOTING.
2. FOR APPROACH SLAB SEAT ELEVATIONS, SEE SHEET 35.

REV	DATE	DESCRIPTION
△	10/13/2015	SUBFOOTING REVISION
△	10/13/2015	CLOSURE POUR ADDITION

PROJECT NAME: WAITSFIELD  
 PROJECT NUMBER: BRF 013-4(39)

FILE NAME: z12b136abu+d+1s.dgn  
 PROJECT LEADER: R.YOUNG  
 DESIGNED BY: D.KULL  
 ABUTMENT NO 1 DETAILS (1 OF 3)

PLOT DATE: 10/13/2015  
 DRAWN BY: S.MERKWAN  
 CHECKED BY: T.KENDRICK  
 SHEET 37 OF 69

