



**BACKWALL TO FOOTING CONNECTION DETAIL**

SCALE: 1" = 1'-0"

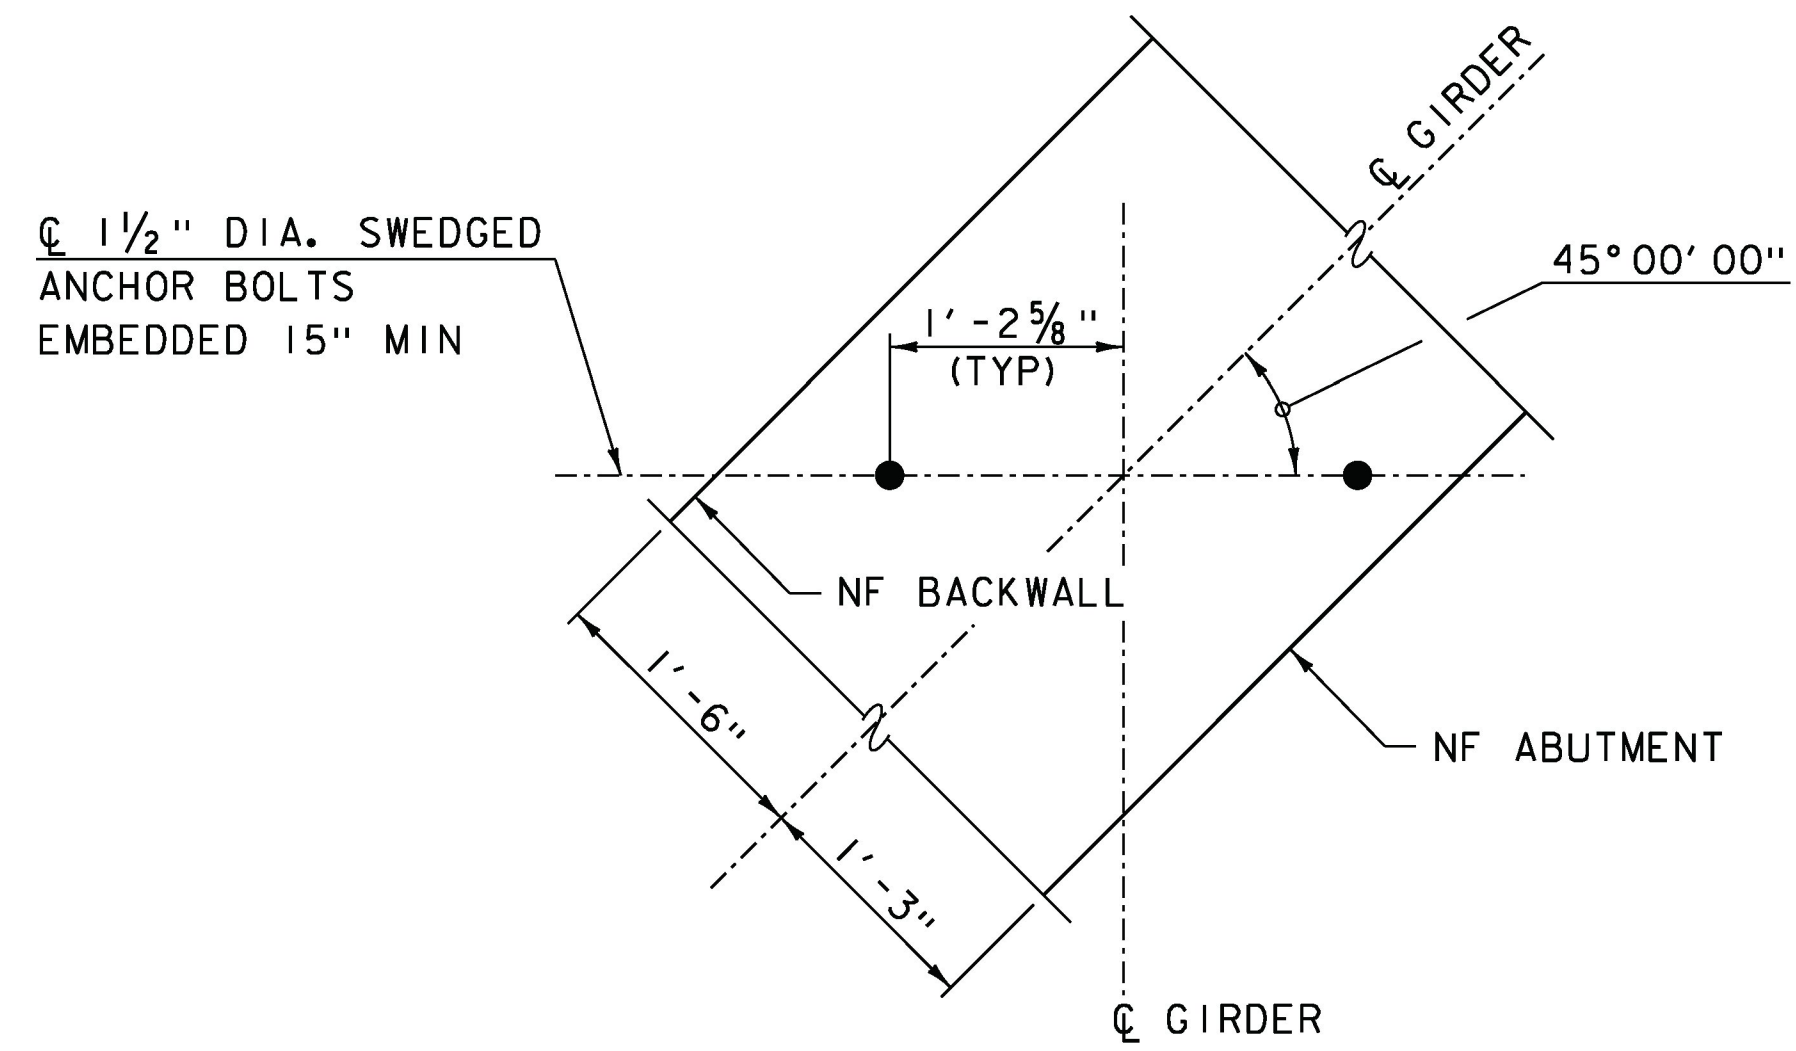


**ANCHOR BOLT LAYOUT**

SCALE: 1" = 1'-0"

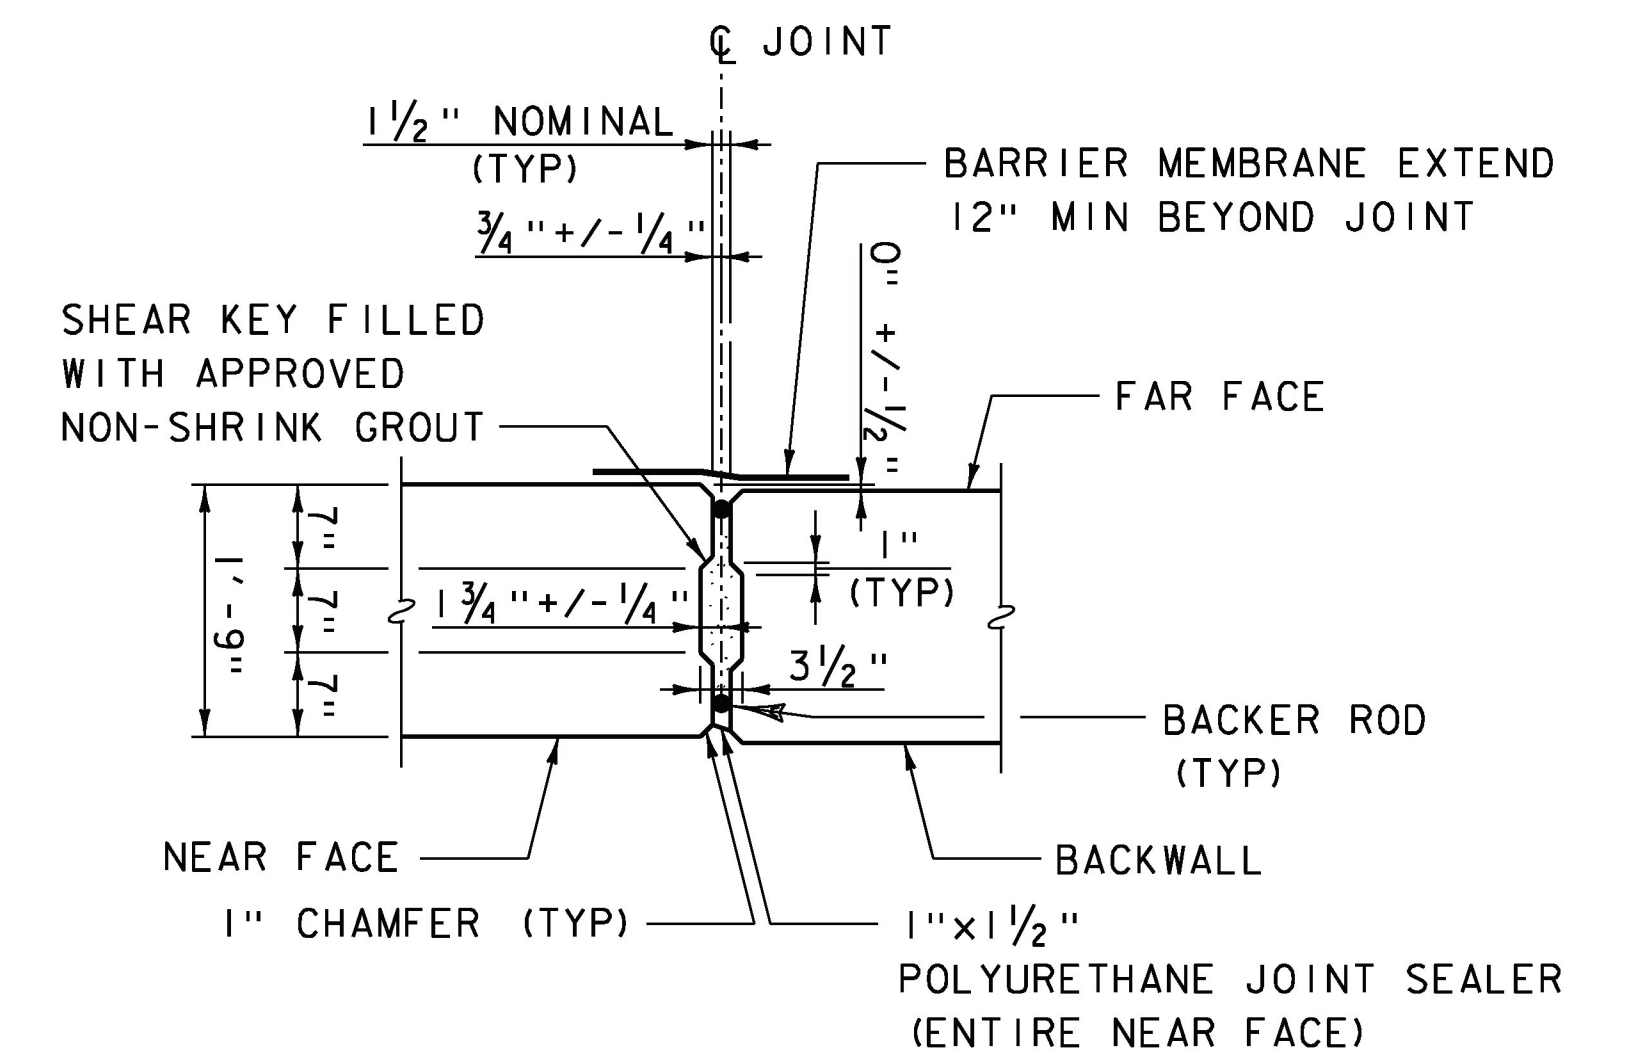

**BACKWALL VERTICAL JOINT**


(BELOW APPROACH SLAB SEAT)  
SCALE: 3/4" = 1'-0"

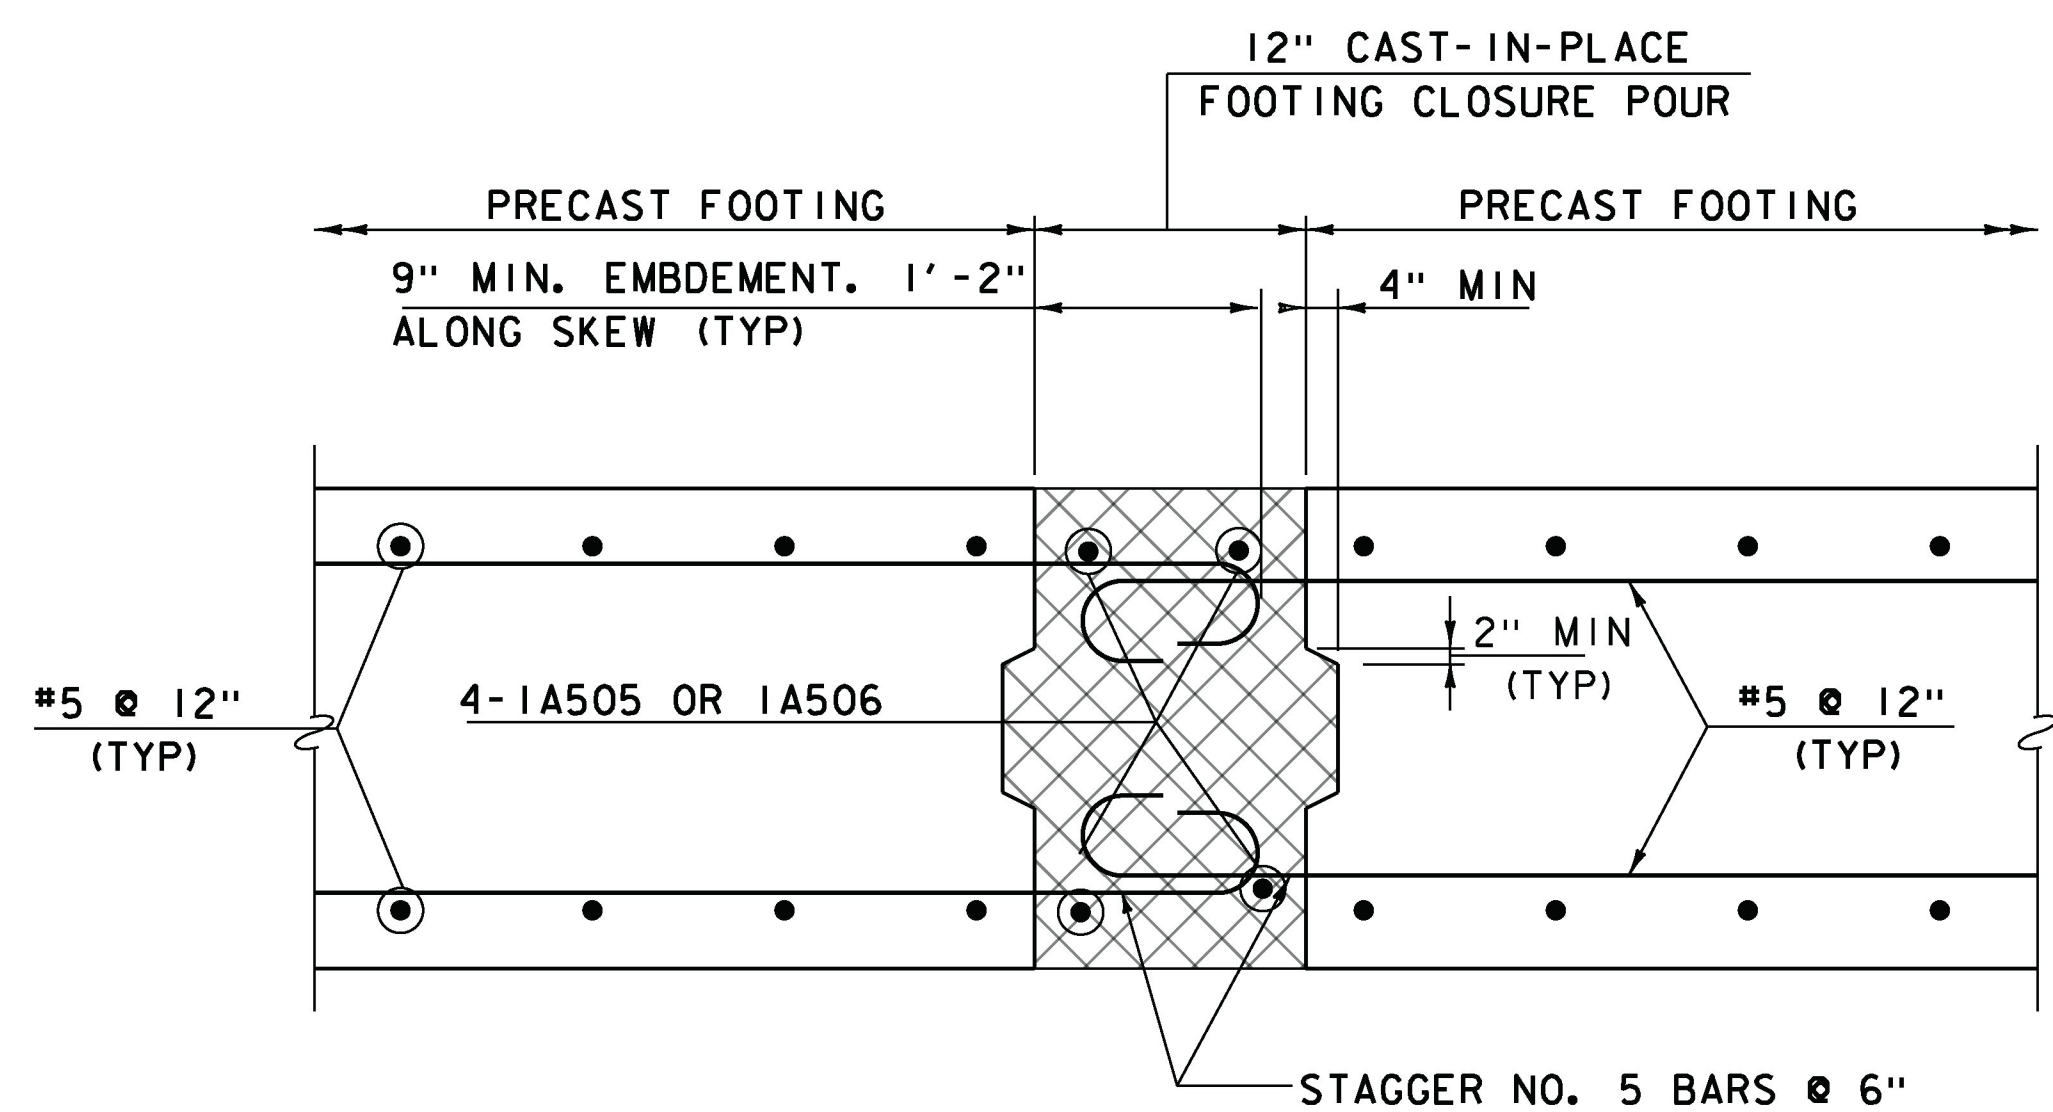

**PRECAST FOOTING CLOSURE POUR DETAIL**

(SECTION A-A)

SCALE: 1" = 1'-0"

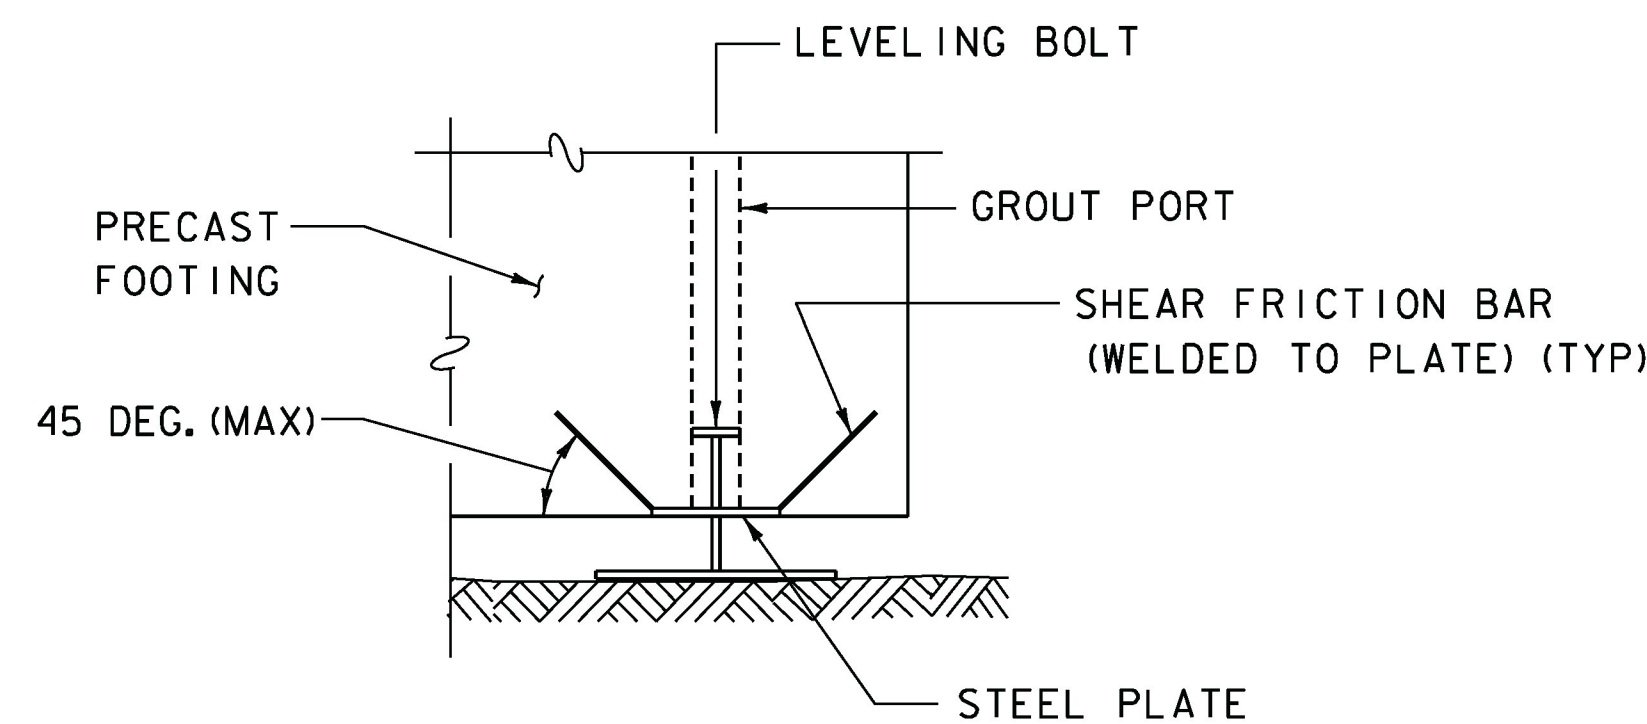

**LEVELING BOLT DETAIL**

SCALE: 1" = 1'-0"

NOTE: LEVELING BOLT DETAIL SHOWN IS CONCEPTUAL. THE CONTRACTOR IS RESPONSIBLE FOR THE DESIGN AND DETAILING OF THE LEVELING DEVICE BASED ON THE WEIGHT OF THE PRECAST UNIT AND THE NUMBER OF DEVICES.

**KEY:**

- NF = NEAR FACE
- FF = FAR FACE
- EF = EACH FACE
- ▲ = CUT TO FIT IN FIELD
- 3" CLEAR, UNLESS OTHERWISE SPECIFIED ON THE PLANS.
- 2'-2" BAR LAP UNLESS OTHERWISE SPECIFIED ON THE PLANS.

**NOTES**

1. THE BACKWALL MAY BE PRECAST WITH THE FOOTING.
2. THE LEVELING BOLT DETAIL SHOWN IS CONCEPTUAL. THE CONTRACTOR IS RESPONSIBLE FOR THE DESIGN AND DETAILING OF THE LEVELING DEVICE BASED ON THE WEIGHT OF THE PRECAST UNIT AND NUMBER OF DEVICES.

REV	DATE	DESCRIPTION
△	10/13/2015	FOOTING MATCH CAST JOINT REMOVAL & CLOSURE POUR ADDITION

PROJECT NAME:	WAITSFIELD
PROJECT NUMBER:	BRF 013-4(39)
FILE NAME:	z12b136abu+d+1s.dgn
PROJECT LEADER:	R.YOUNG
DESIGNED BY:	D.KULL
CHECKED BY:	T.KENDRICK
ABUTMENT NO 1 DETAILS (3 OF 3)	
PLOT DATE:	10/13/2015
DRAWN BY:	S.MERKWAN
CHECKED BY:	T.KENDRICK
SHEET	39 OF 69