



WINGWALL I PLAN
SCALE: 3/4" = 1'-0"

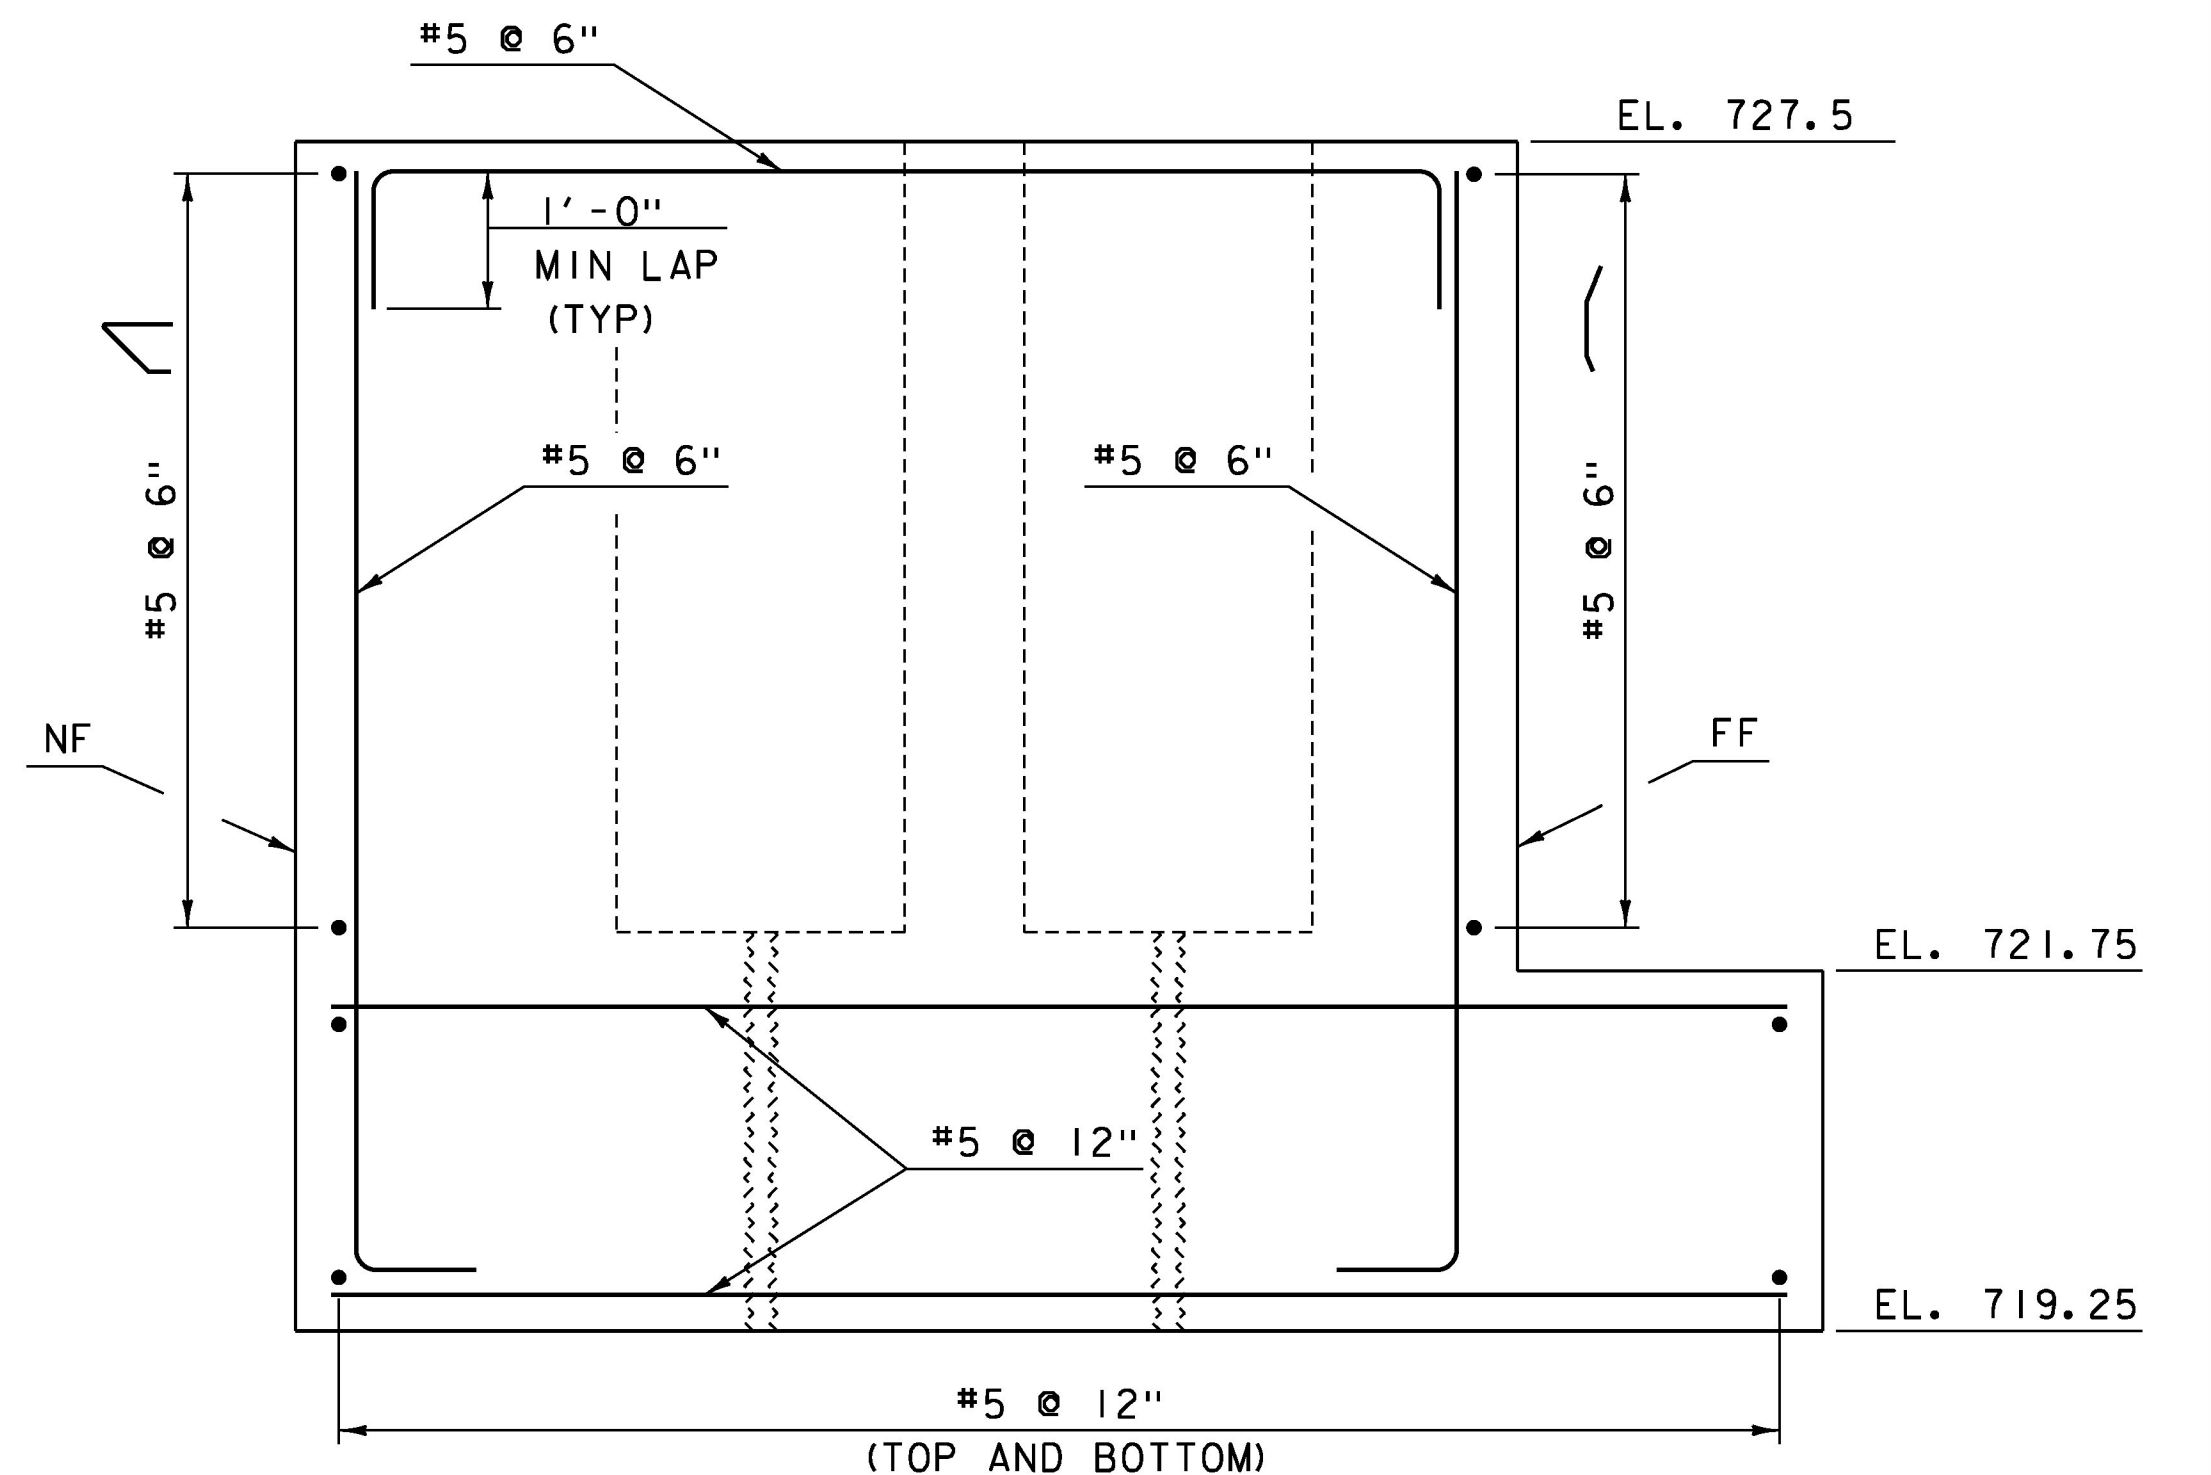


SECTION A-A
SCALE: 3/4" = 1'-0"

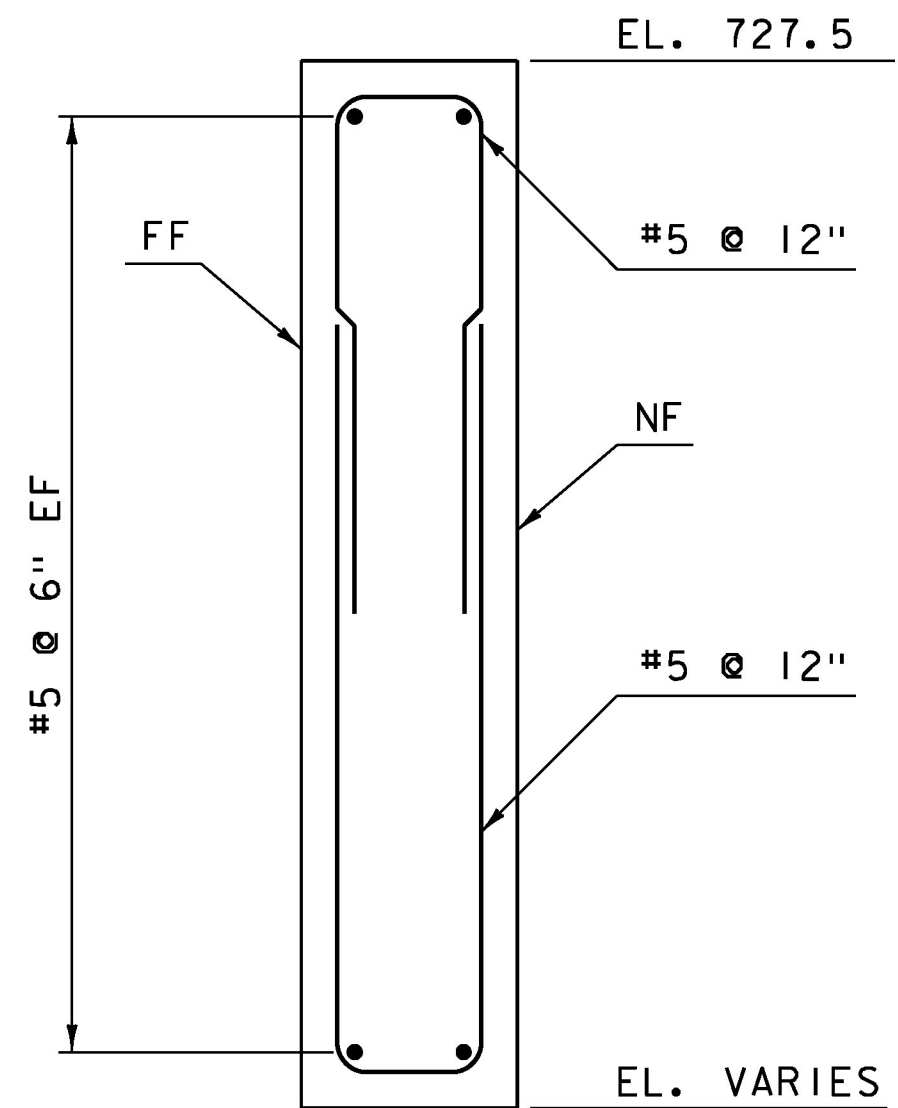

SECTION B-B
(CORNER BARS NOT SHOWN)
SCALE: 3/4" = 1'-0"

NOTE

1. VOIDS ARE OPTIONAL AND ARE INTENDED TO REDUCE PRECAST WEIGHT. LOCATION AND NUMBER OF VOIDS CAN BE VARIED BY THE CONTRACTOR PROVIDED THE REINFORCING LAYOUT AND REQUIRED CLEARANCES ARE MAINTAINED. VOIDS TO BE FILLED WITH SPECIAL PROVISION (HIGH PERFORMANCE CONCRETE, RAPID SET) (FPQ).

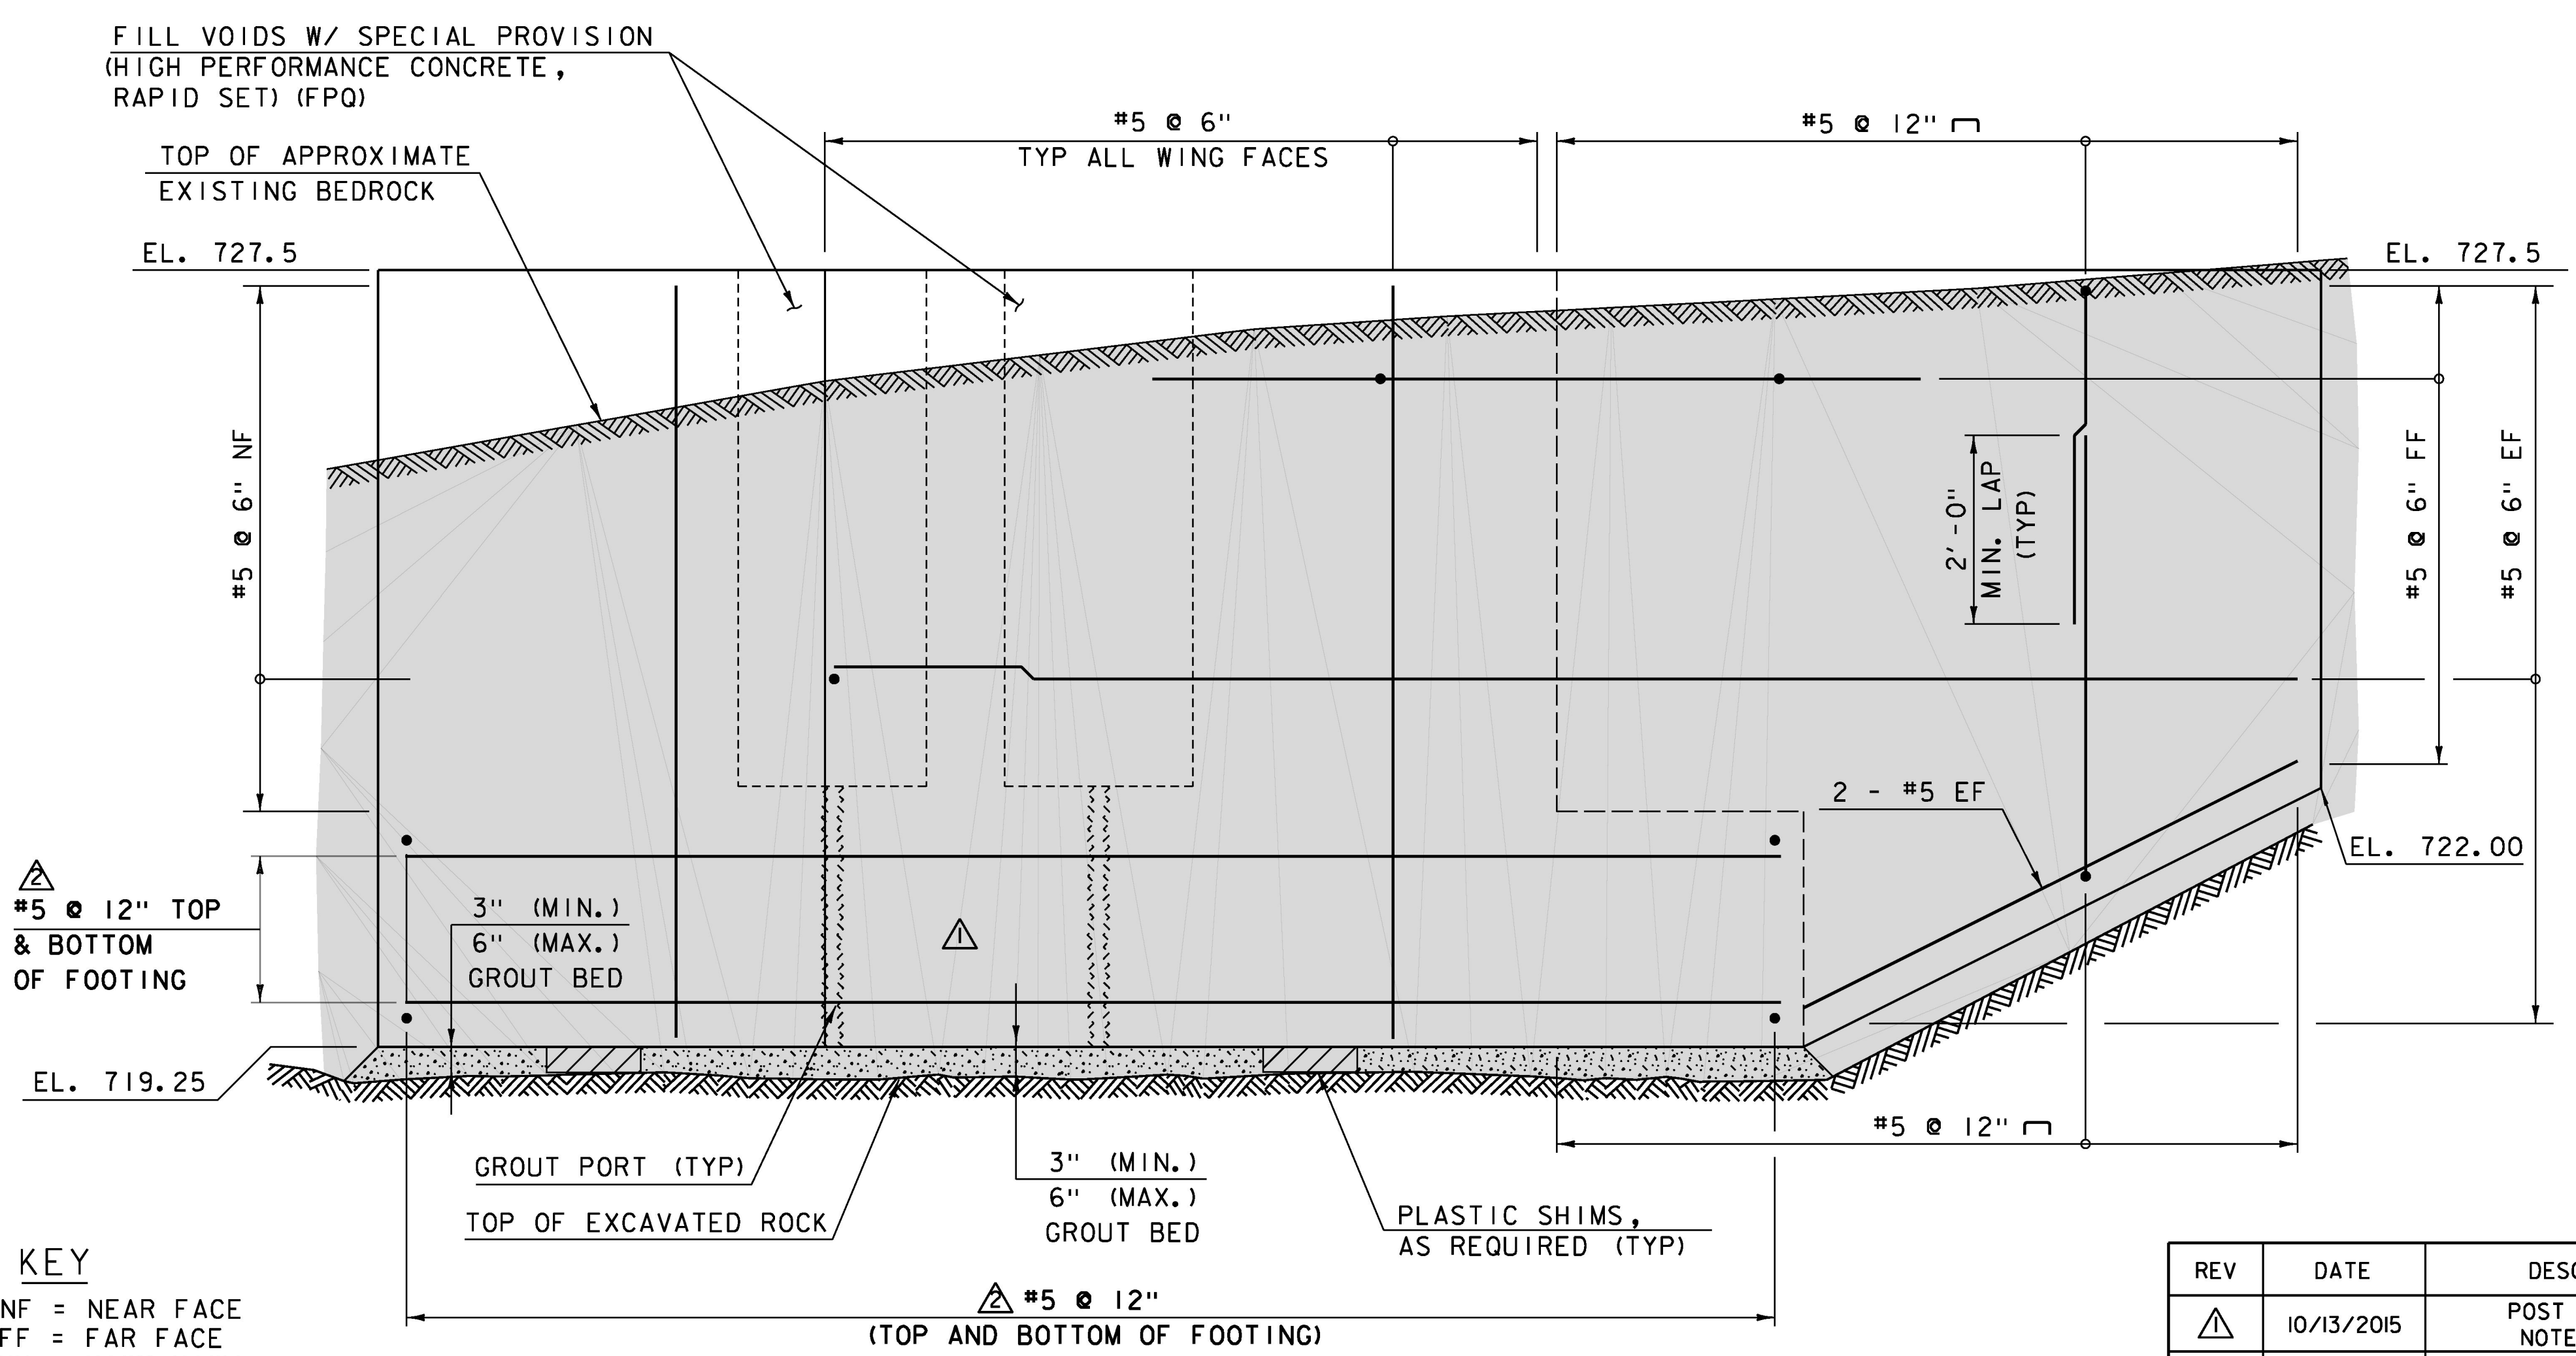

WINGWALL I ELEVATION
SCALE: 3/4" = 1'-0"

KEY
NF = NEAR FACE
FF = FAR FACE
EF = EACH FACE
▲ = CUT TO FIT IN FIELD
3" CLEAR, UNLESS OTHERWISE SPECIFIED ON THE PLANS.
2'-2" BAR LAP UNLESS OTHERWISE SPECIFIED ON THE PLANS.

| REV | DATE | DESCRIPTION |
|-----|------------|------------------------------|
| △ | 10/13/2015 | POST TENSIONING NOTE REMOVAL |
| △ | 10/13/2015 | FOOTING REBAR CALLOUT |

LEGEND

APPROXIMATE BEDROCK REMOVAL LIMITS



PROJECT NAME: WAITSFIELD
PROJECT NUMBER: BRF 013-4(39)
FILE NAME: z12b136wingd+1s.dgn
PROJECT LEADER: R. YOUNG
DESIGNED BY: D. KULL
PLOT DATE: 10/13/2015
DRAWN BY: S.MERKWAN
CHECKED BY: T. KENDRICK
ABUTMENT NO 1 WINGWALL DETAILS (1 OF 3) SHEET 40 OF 69