



WINGWALL 2 PLAN
SCALE: 3/4" = 1'-0"

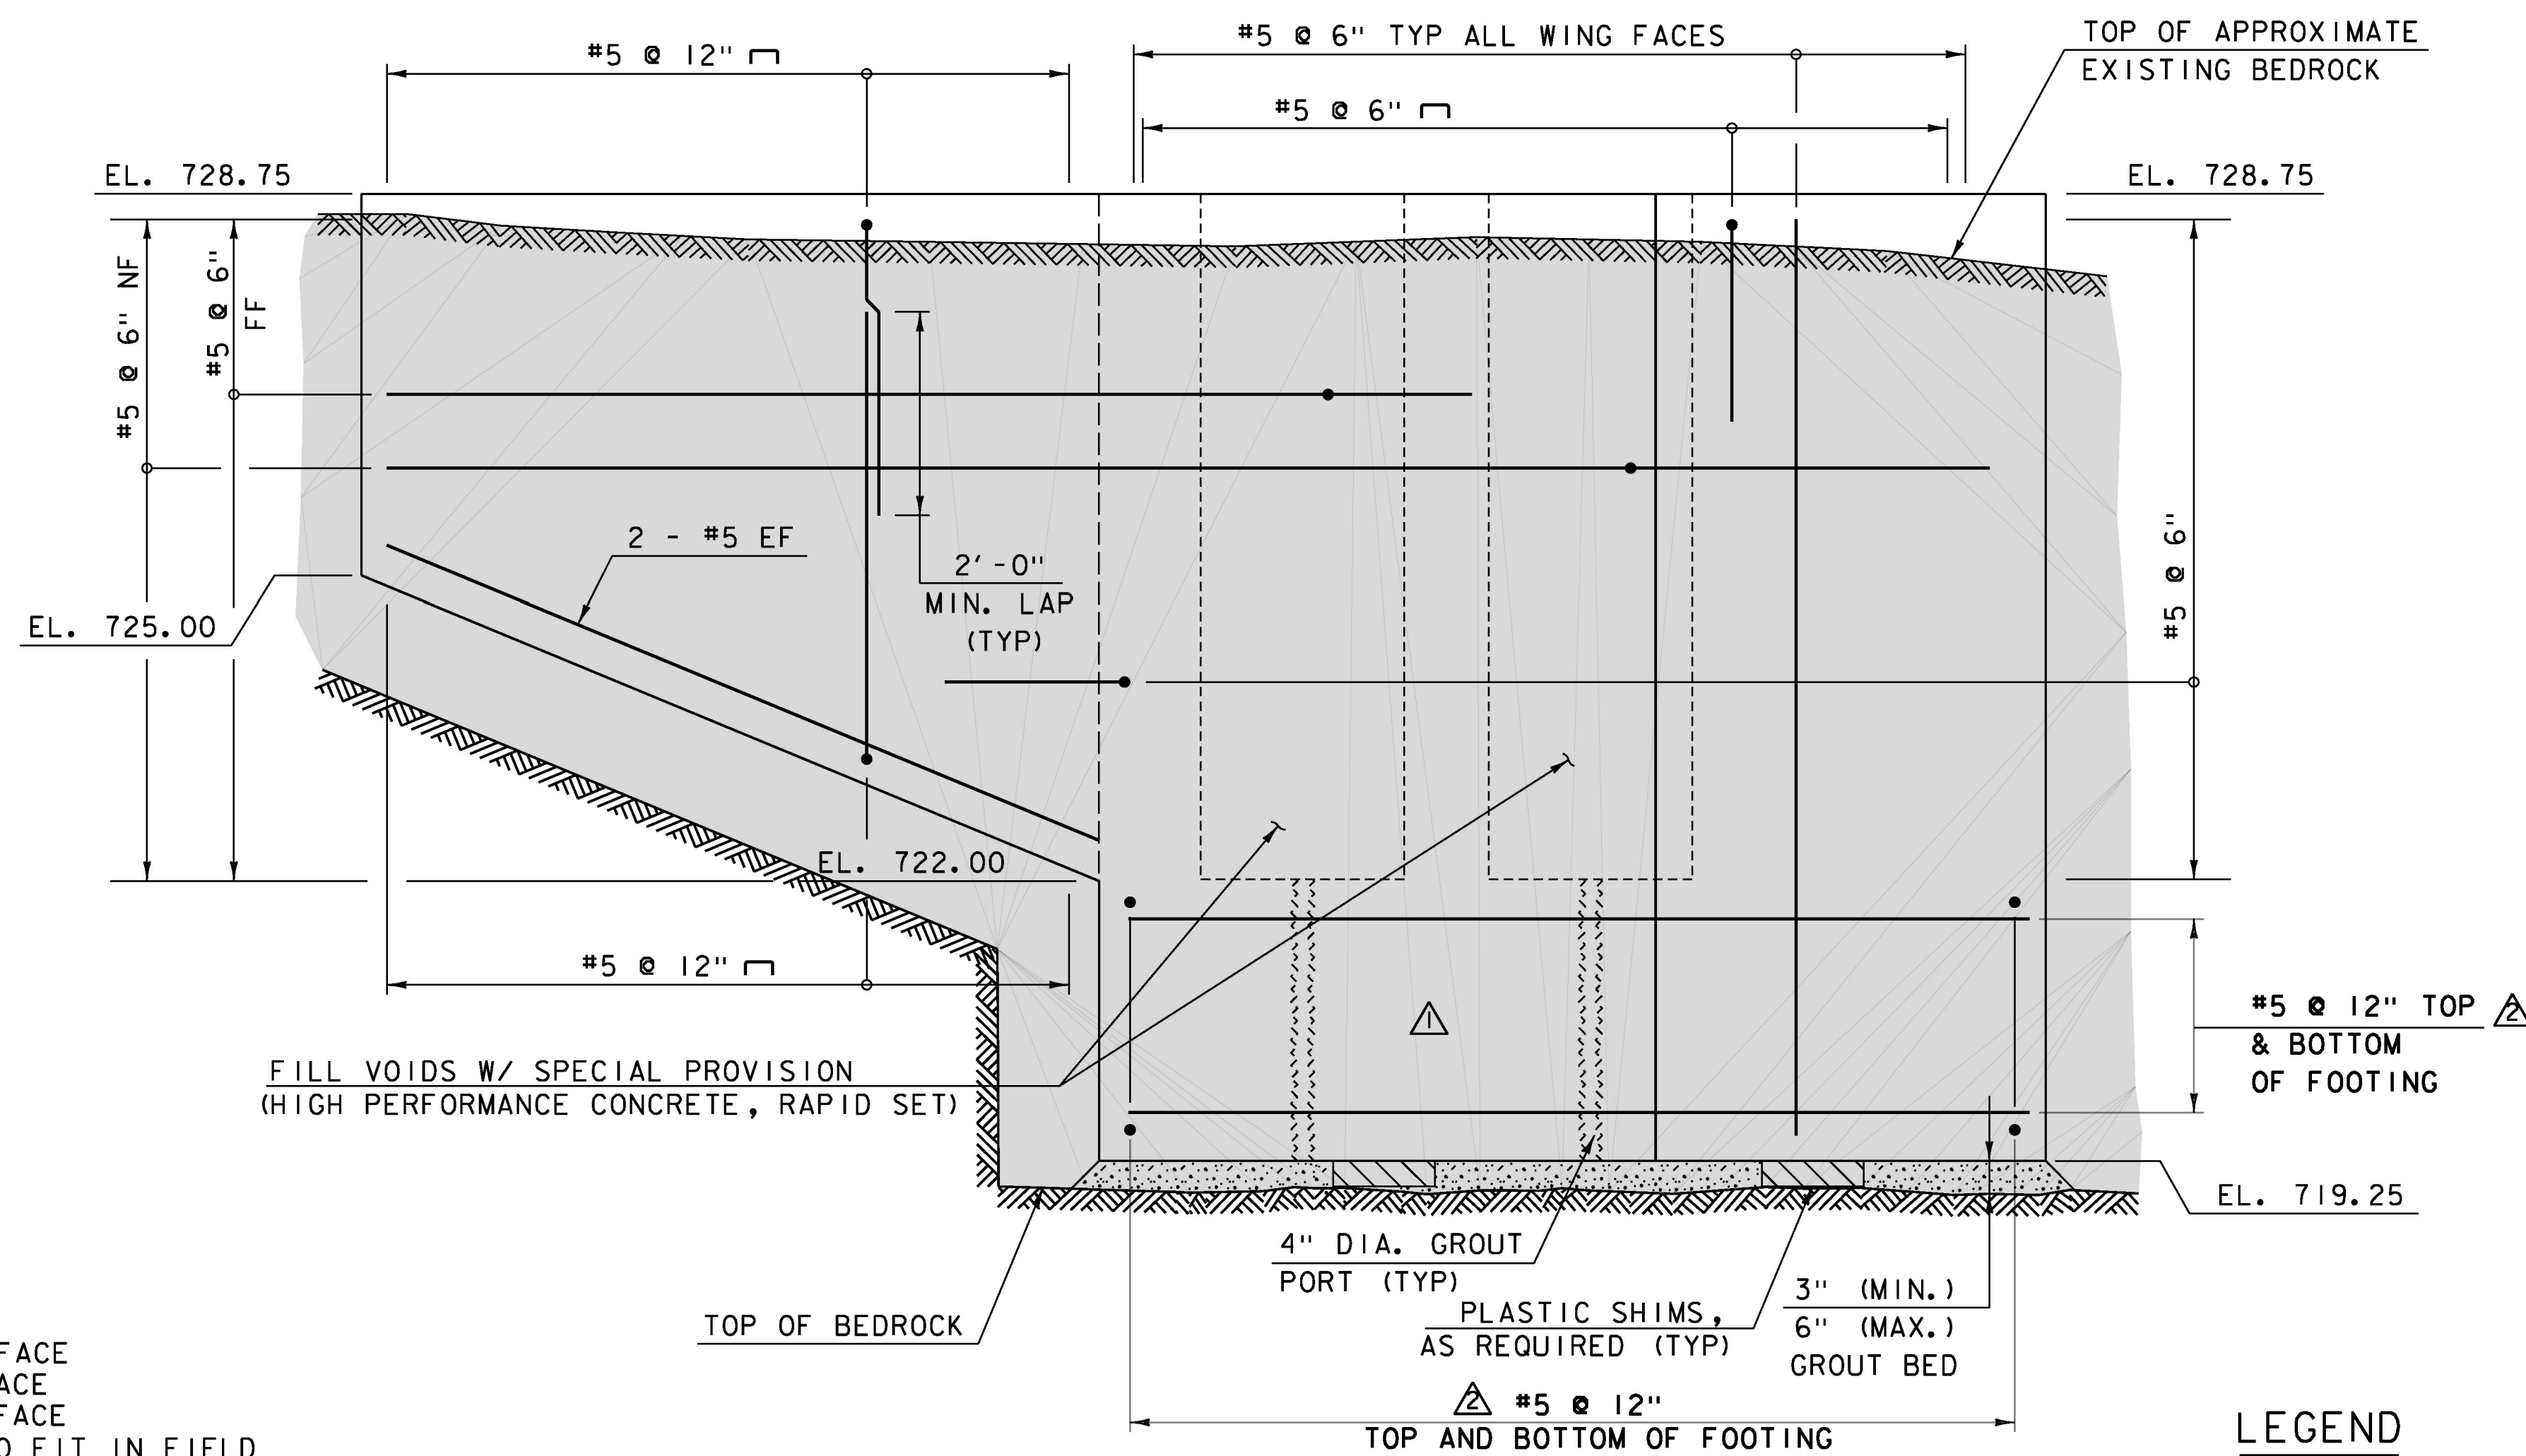

WINGWALL 2 ELEVATION
SCALE: 3/4" = 1'-0"

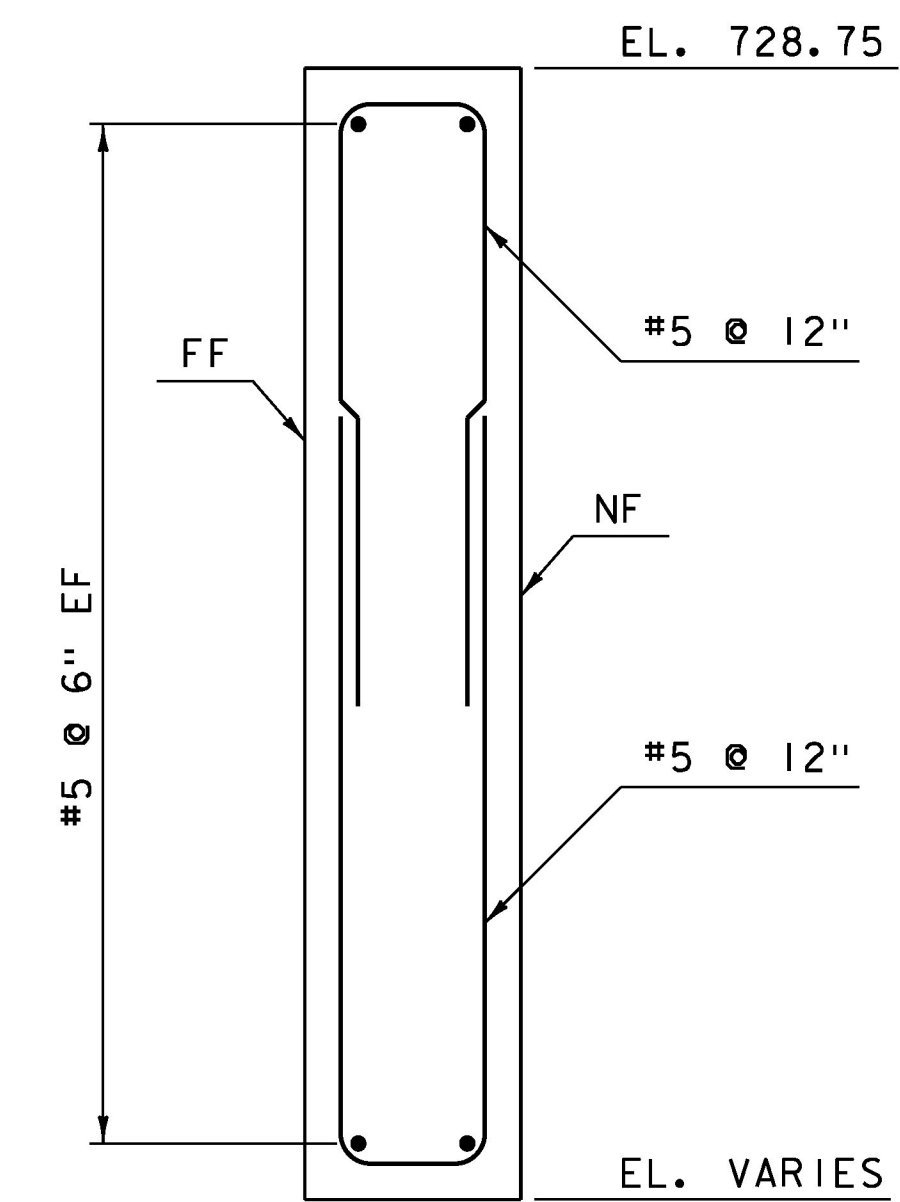

SECTION A-A
(CORNER BARS NOT SHOWN)
SCALE: 3/4" = 1'-0"

NOTE

- VOIDS ARE OPTIONAL AND ARE INTENDED TO REDUCE PRECAST WEIGHT. LOCATION AND NUMBER OF VOIDES CAN BE VARIED BY THE CONTRACTOR PROVIDED THE REINFORCING LAYOUT AND REQUIRED CLEARANCES ARE MAINTAINED. VOIDES TO BE FILLED WITH SPECIAL PROVISION (HIGH PERFORMANCE CONCRETE, RAPID SET) (FPQ).

KEY

- NF = NEAR FACE
- FF = FAR FACE
- EF = EACH FACE
- ▲ = CUT TO FIT IN FIELD
- 3" CLEAR, UNLESS OTHERWISE SPECIFIED ON THE PLANS.
- 2'-2" BAR LAP UNLESS OTHERWISE SPECIFIED ON THE PLANS.

LEGEND

APPROXIMATE BEDROCK REMOVAL LIMITS

REV	DATE	DESCRIPTION
△	10/13/2015	POST TENSIONING NOTE REMOVAL
▲	10/13/2015	FOOTING REBAR CALLOUT

PROJECT NAME: WAITSFIELD
PROJECT NUMBER: BRF 013-4(39)

FILE NAME: z12b136wingd+1s.dgn PLOT DATE: 10/13/2015
PROJECT LEADER: R. YOUNG DRAWN BY: S.MERKWAN
DESIGNED BY: D. KULL CHECKED BY: T. KENDRICK
ABUTMENT NO 1 WINGWALL DETAILS (2 OF 3) SHEET 41 OF 69

