
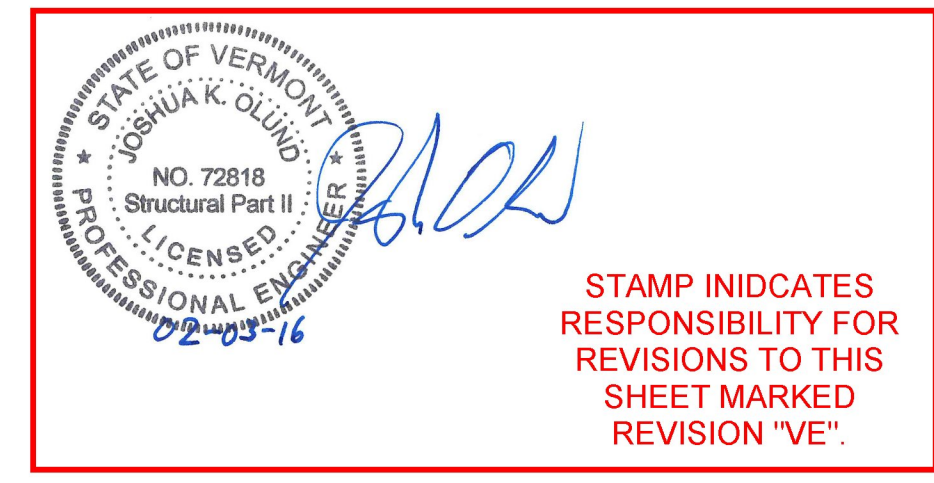


REV	DATE	DESCRIPTION
VE	02/03/16	REVISED ELEVATIONS FOR DECK CHANGE

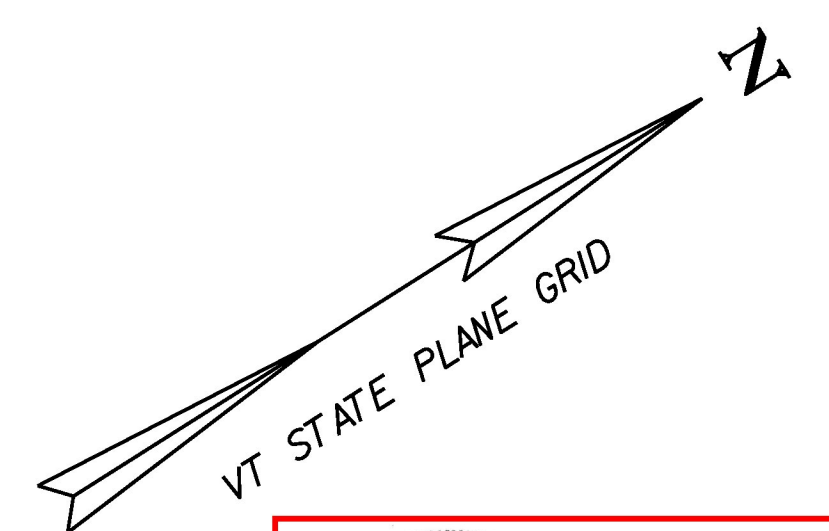

STAMP INDICATES RESPONSIBILITY FOR REVISIONS TO THIS SHEET MARKED REVISION 'VE'.

NOTES


- USE GALVANIZED CORRUGATED STEEL PIPE THAT CONFORMS TO SUBSECTION 711.01 FOR PILE POCKETS, STEM VOIDS AND GROUT PORTS.
- FORM TOP 6" WITH REMOVABLE FORM TO ELIMINATE EXPOSED CORRUGATED STEEL ON THE TOP OF THE BRIDGE SEAT.
- SET PILES PARALLEL TO THE CENTERLINE OF GIRDERS AS SHOWN.
- FOR MSE REINFORCING STRIP DETAILS, SEE SHEET 44.
- ELEVATION IS THEORETICAL AND SHALL MATCH TOP OF C.I.P. BRIDGE CURB.

LEGEND

- CONCRETE, HIGH PERFORMANCE, CLASS A
- SPECIAL PROVISION (HIGH PERFORMANCE CONCRETE, RAPID SET) (FPQ)

KEY:

- NF = NEAR FACE
- FF = FAR FACE
- EF = EACH FACE
- ▲ = CUT TO FIT IN FIELD
- 3" CLEAR, UNLESS OTHERWISE SPECIFIED ON THE PLANS.
- 2'-2" BAR LAP UNLESS OTHERWISE SPECIFIED ON THE PLANS.

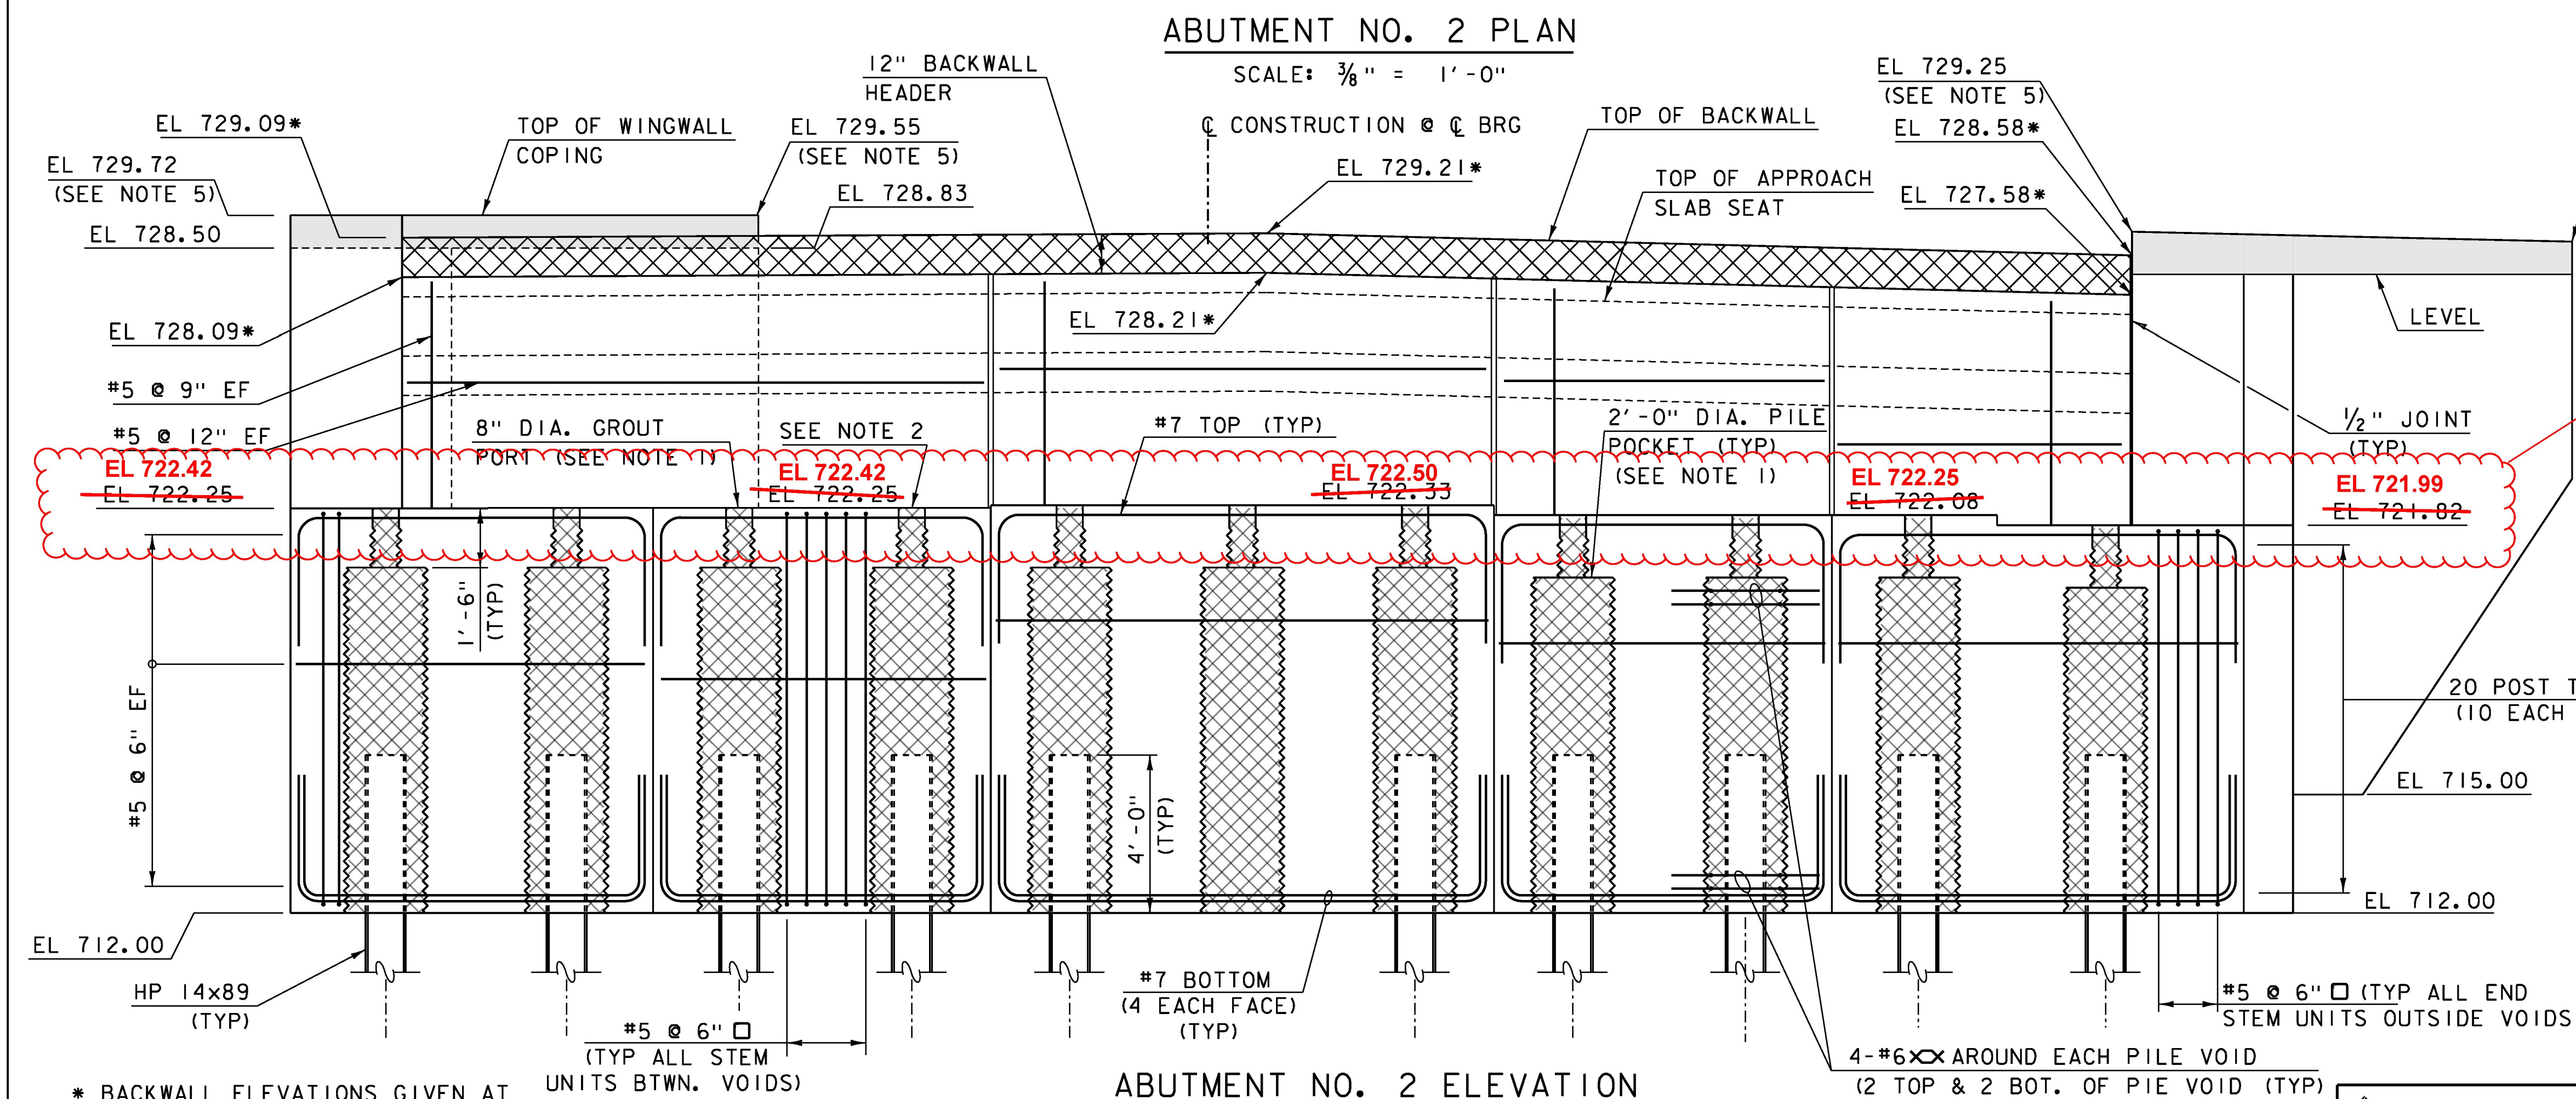

PROJECT NAME: WAITSFIELD	PLOT DATE: 8/24/2015
PROJECT NUMBER: BRF 013-4(39)	DRAWN BY: S.MERKWAN
FILE NAME: z12b136abut.dgn	CHECKED BY: T.KENDRICK
DESIGNED BY: D.KULL	SHEET 42 OF 69
ABUTMENT NO. 2 PLAN AND ELEVATION	



* BACKWALL ELEVATIONS GIVEN AT CENTERLINE OF BACKWALL.

ABUTMENT NO. 2 ELEVATION
SCALE: 3/8" = 1'-0"