


TYPICAL ABUTMENT NO. 2 SECTION

SCALE: 3/8" = 1'-0"

NOTE: SOIL REINFORCING STRIPS AND THREADED INSERTS FOR DOWNSPOUT NOT SHOWN FOR CLARITY

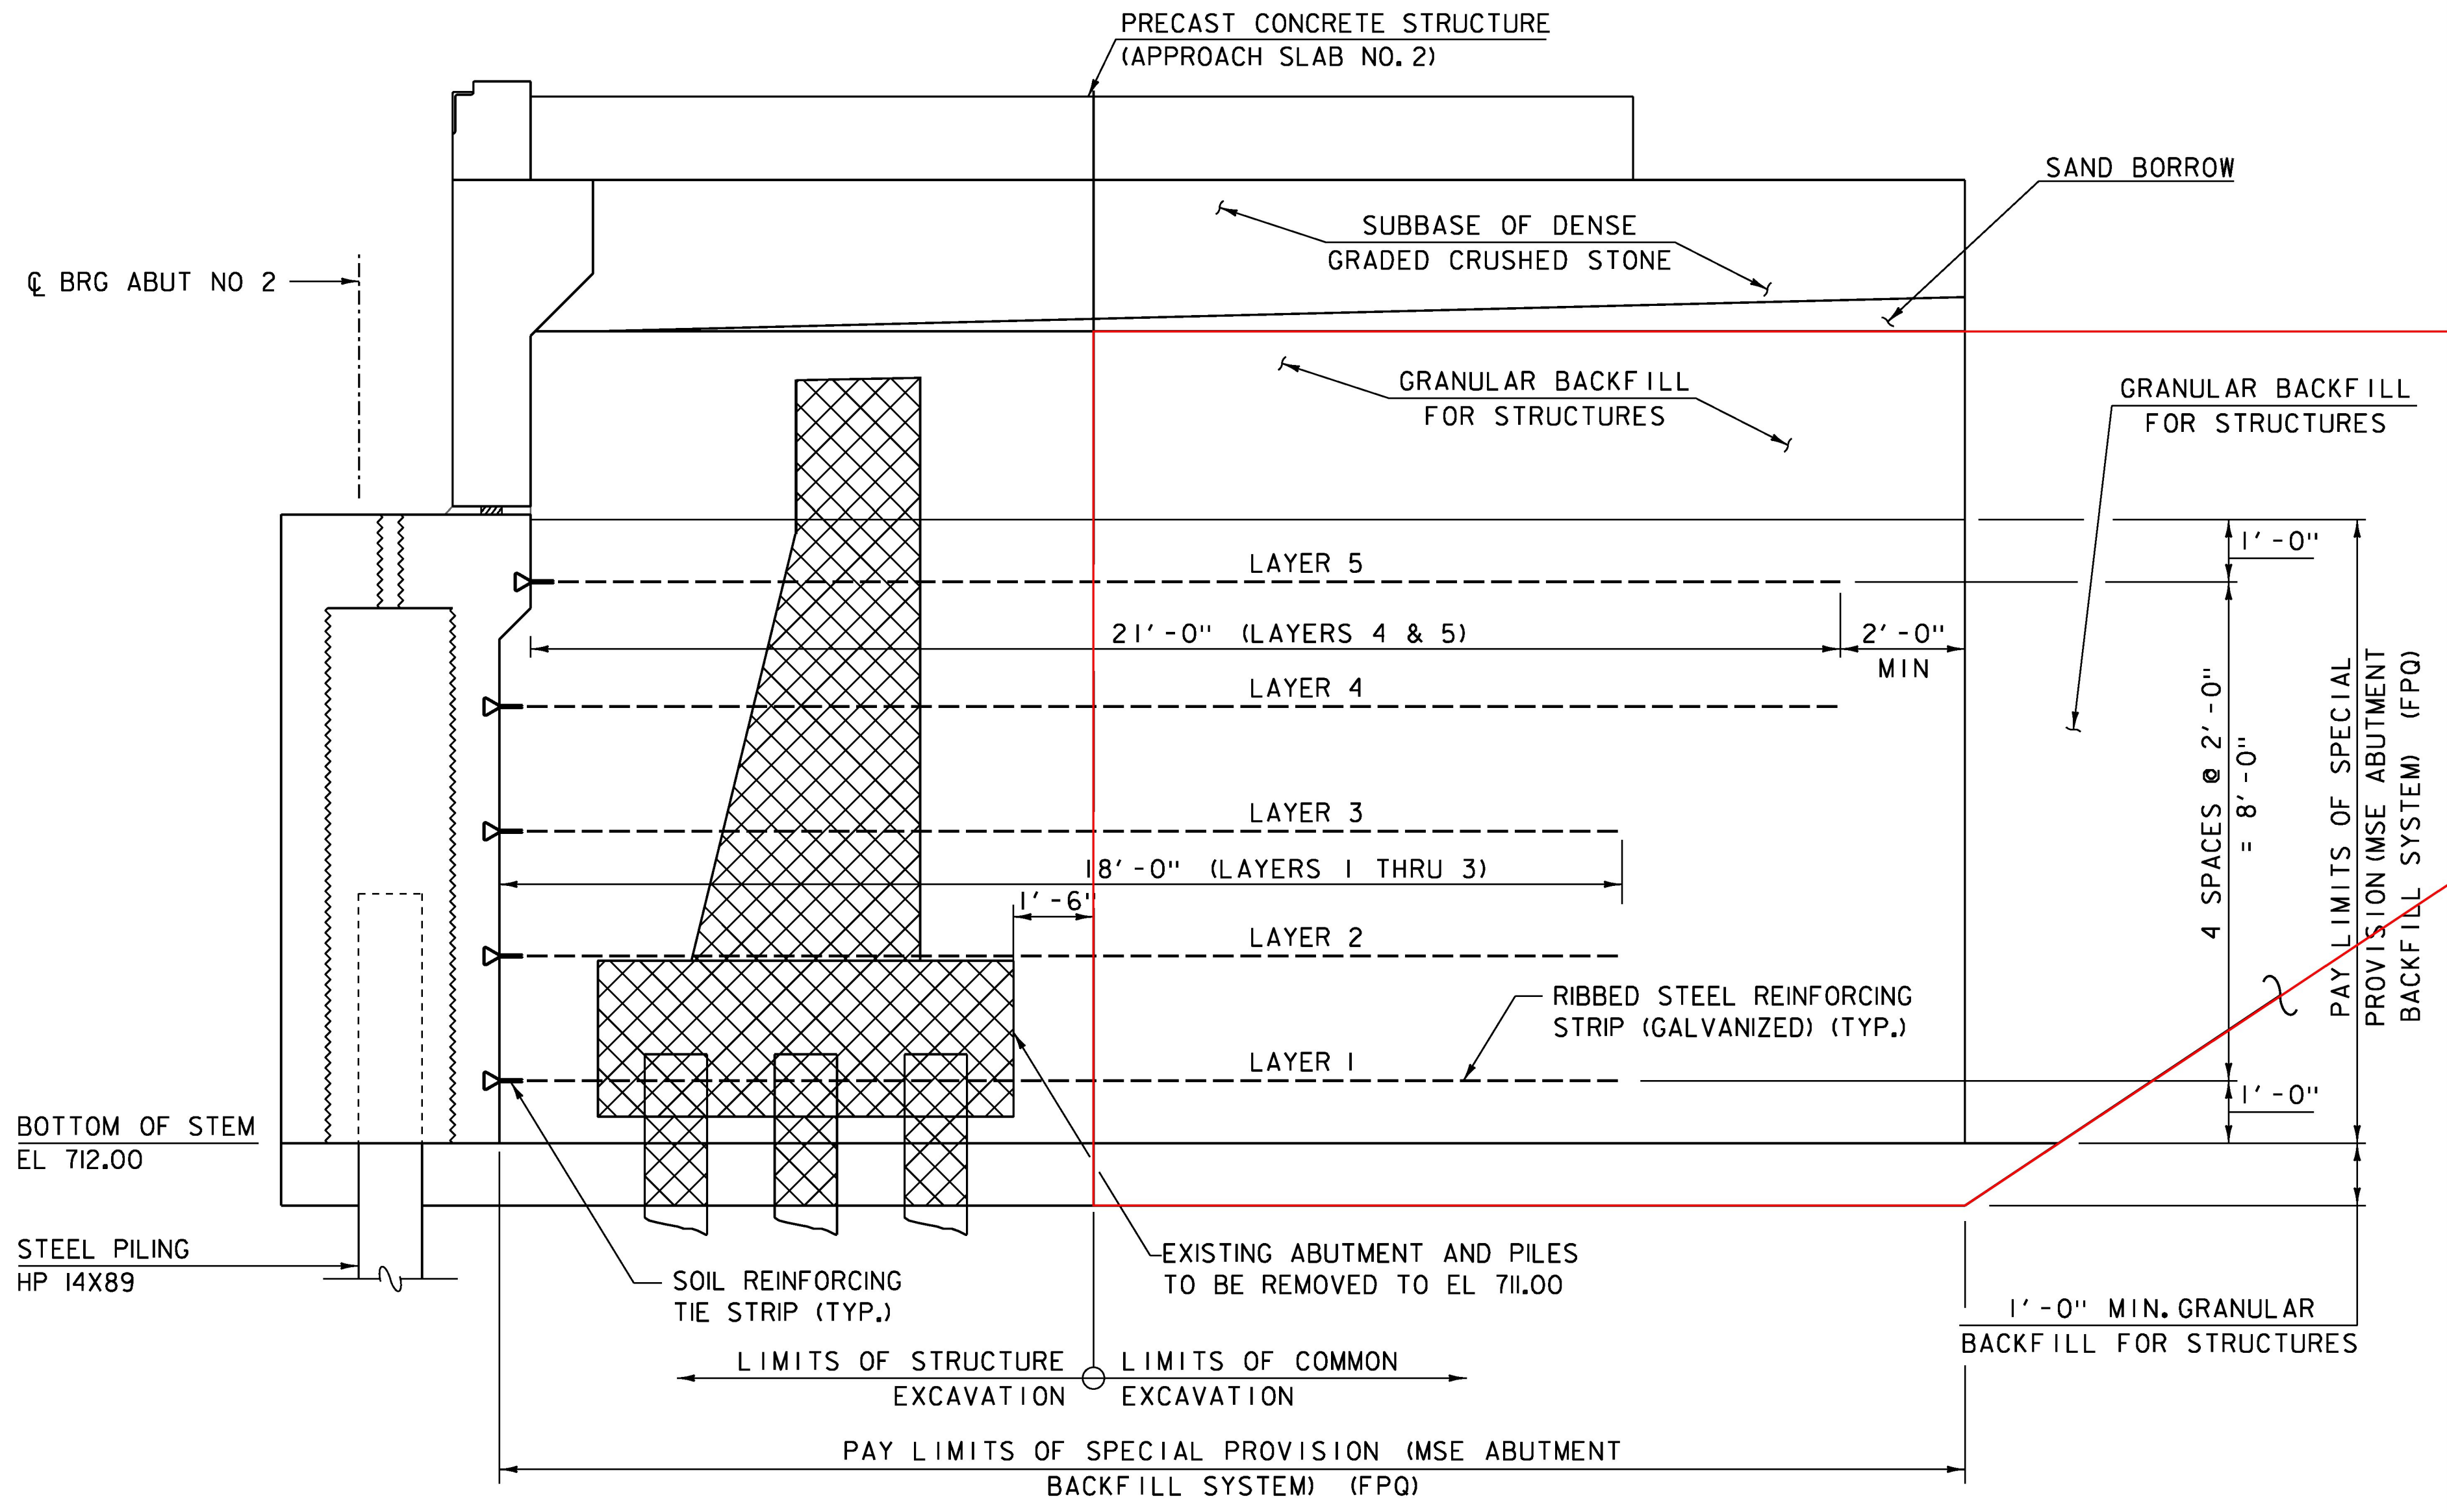

SOIL REINFORCING SECTION

SCALE: 1/2" = 1'-0"



PROJECT NAME: WAITSFIELD	PLOT DATE: 8/24/2015
PROJECT NUMBER: BRF 013-4(39)	DRAWN BY: S.MERKWAN
FILE NAME: z12b136abu+d+1s.dgn	CHECKED BY: T.KENDRICK
PROJECT LEADER: R.YOUNG	SHEET 43 OF 69
DESIGNED BY: D.KULL	ABUTMENT NO 2 DETAILS (1 OF 3)