




BEGIN BRIDGE STA 13+52.46

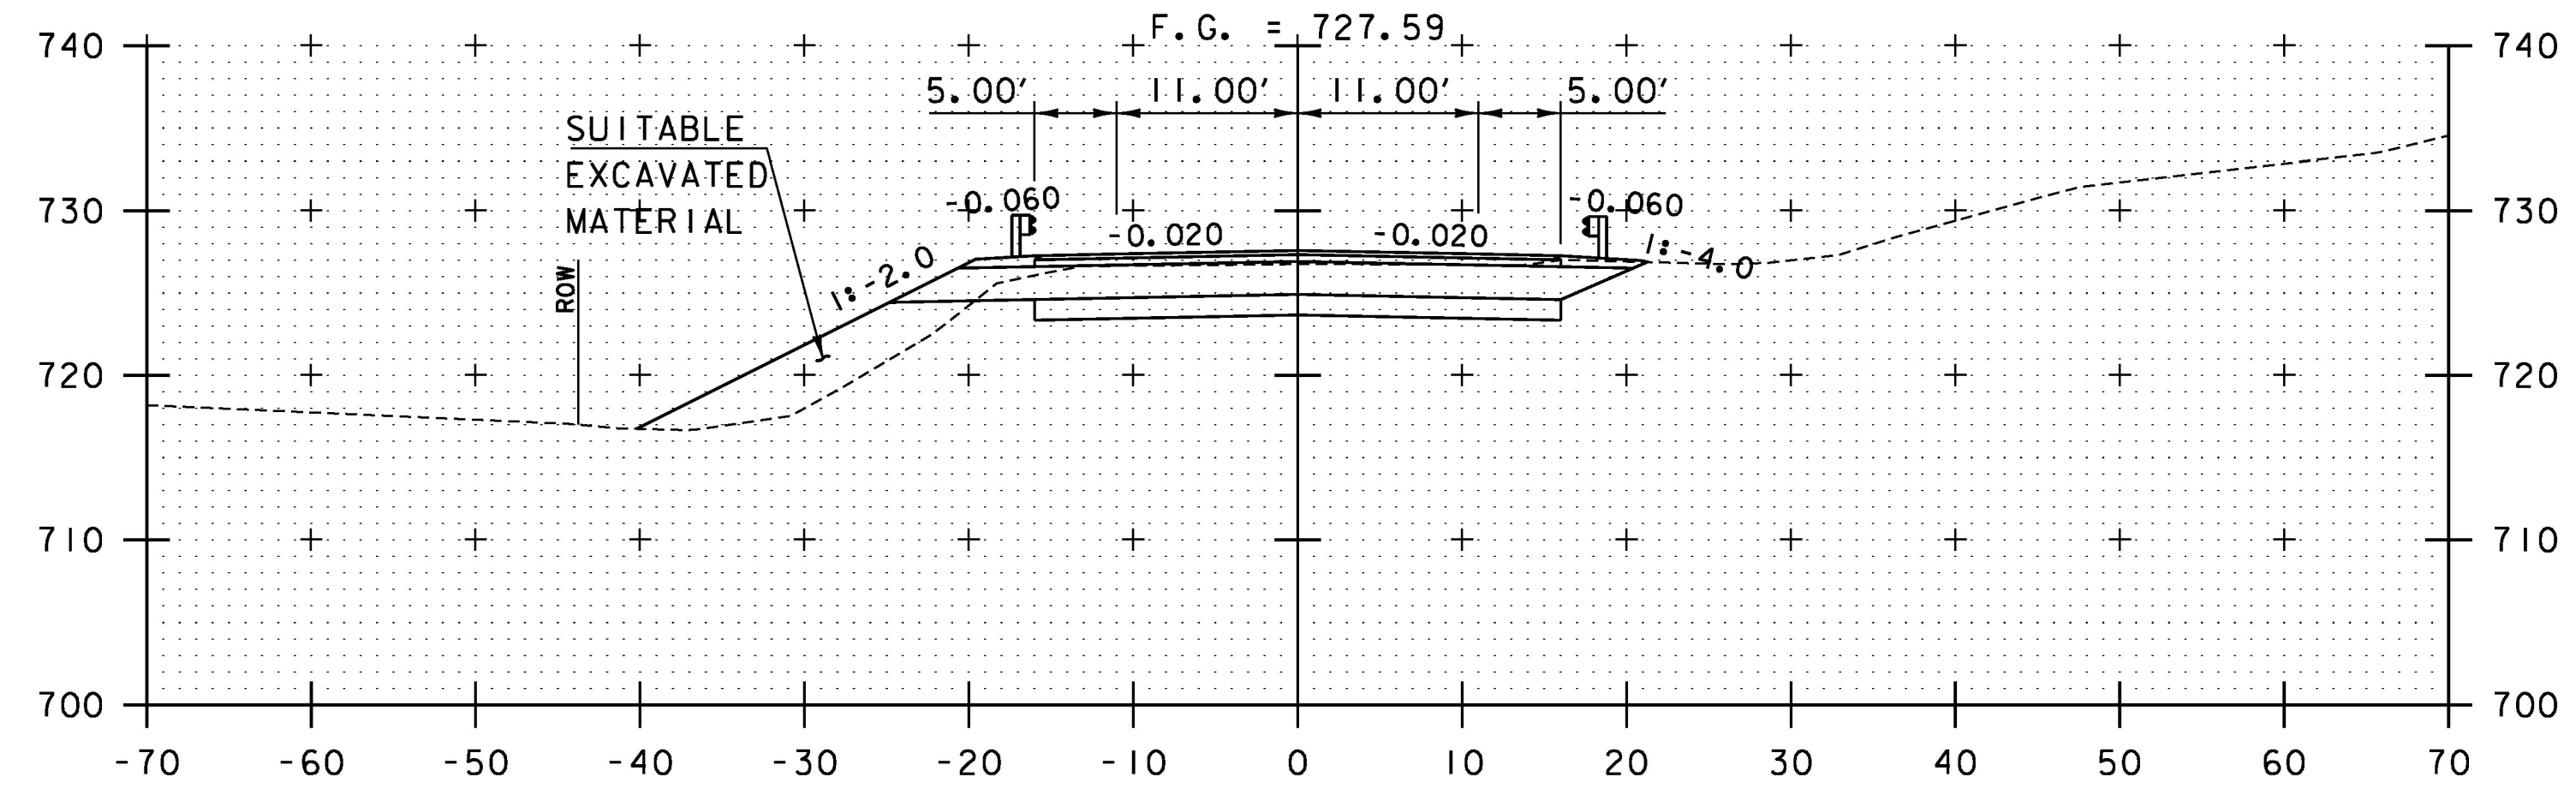


12+75

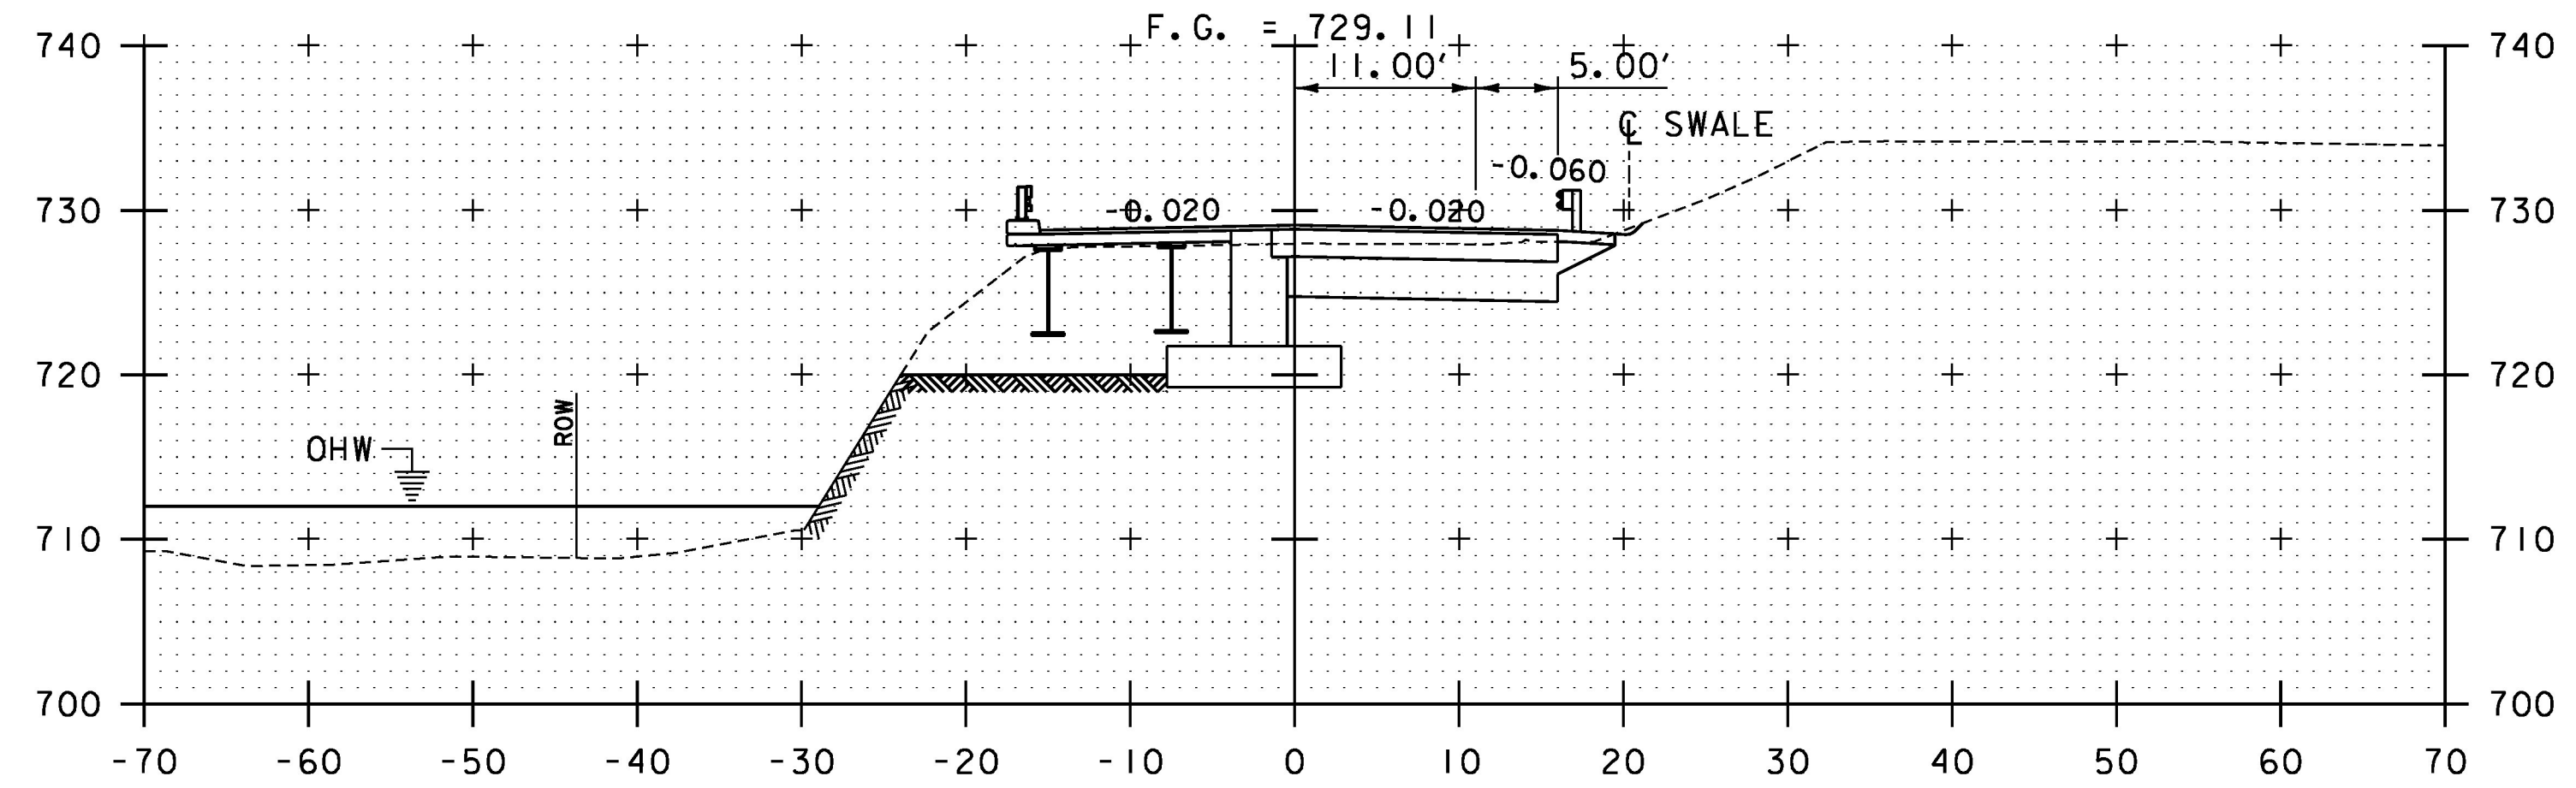


13+50

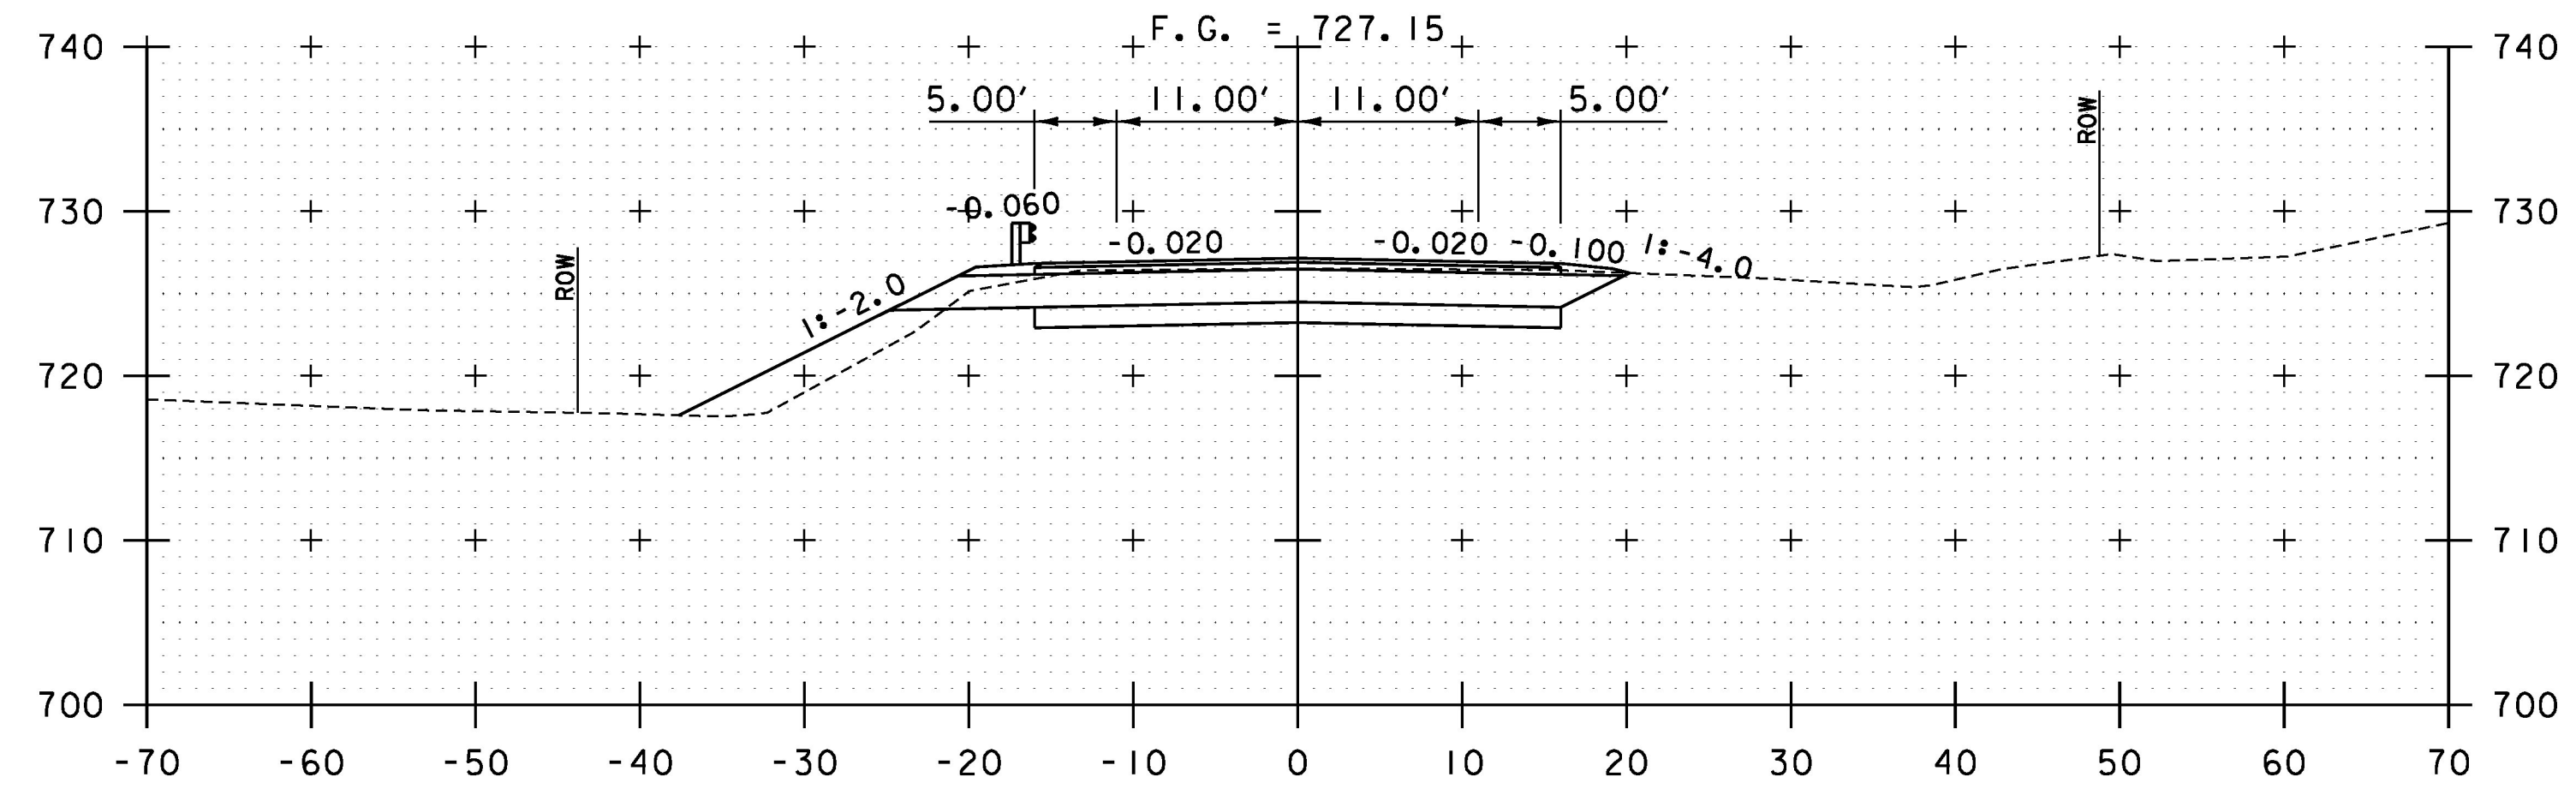


12+50

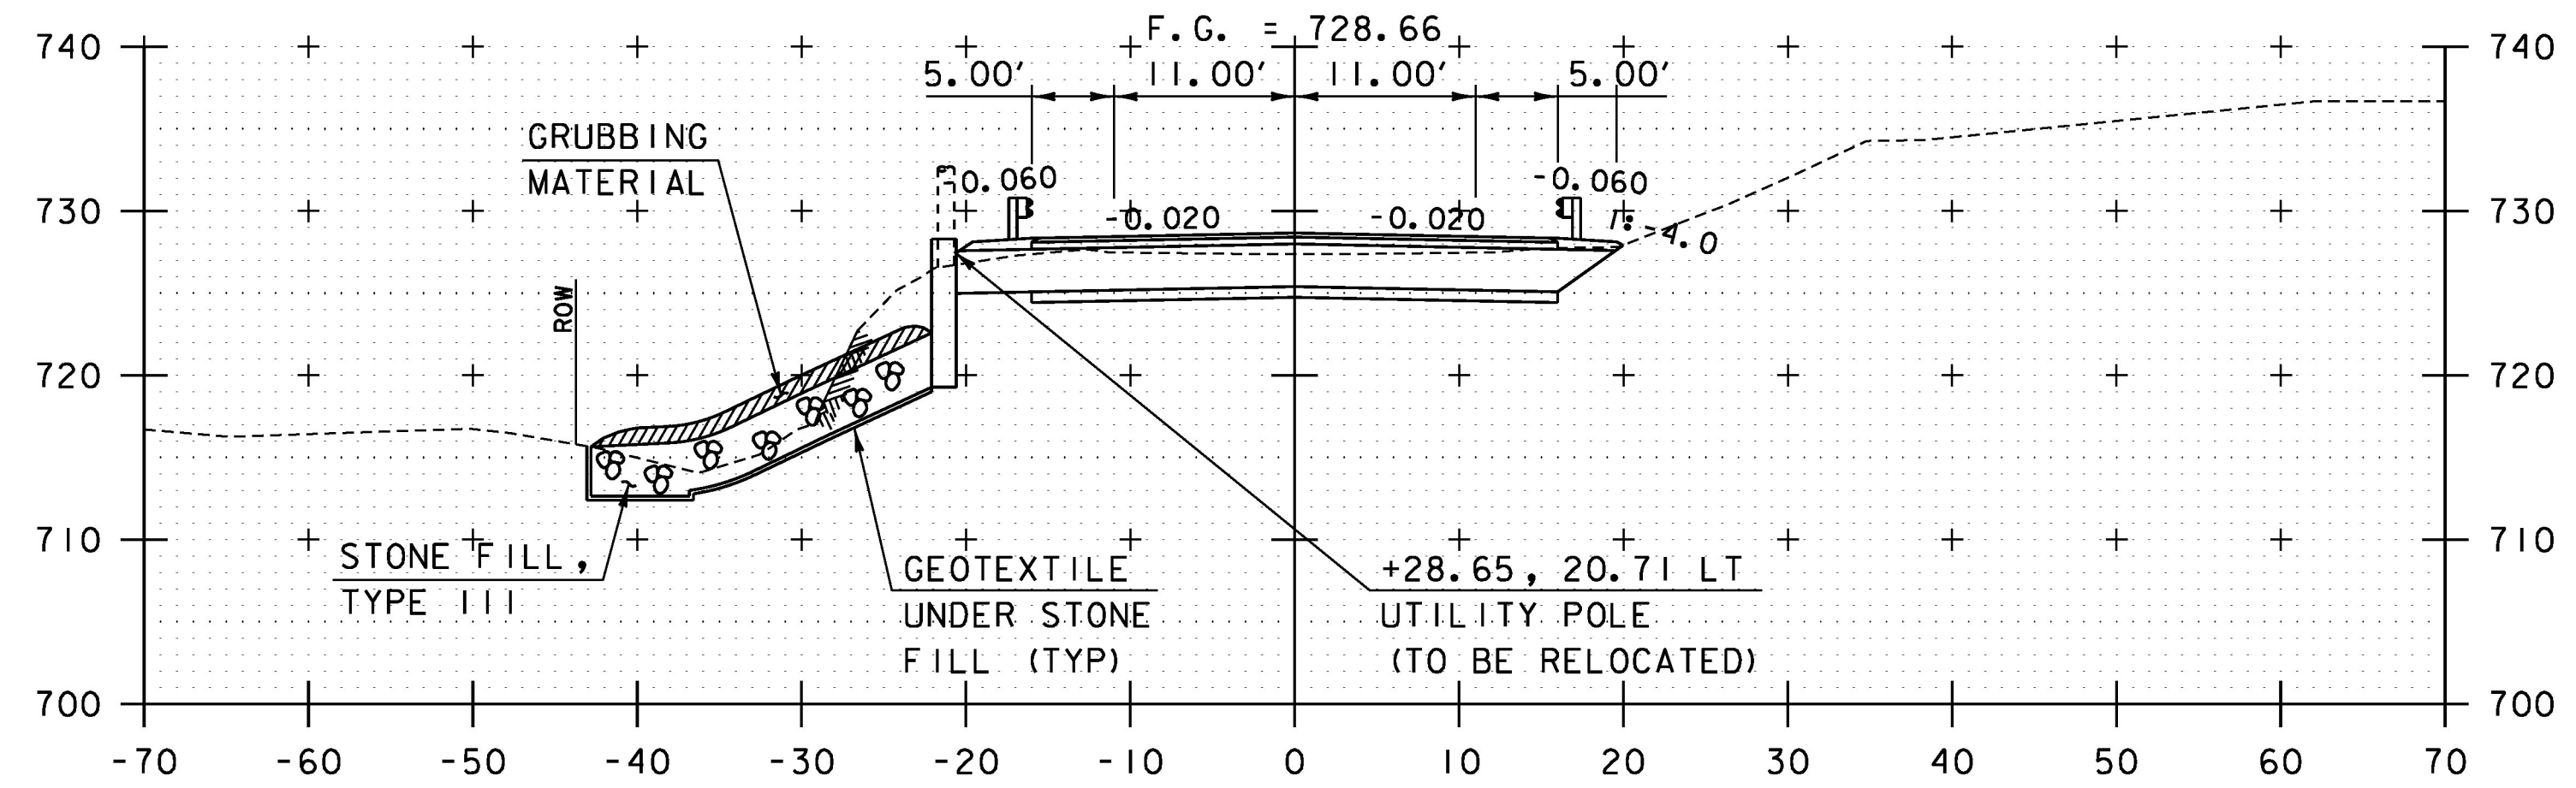

13+25

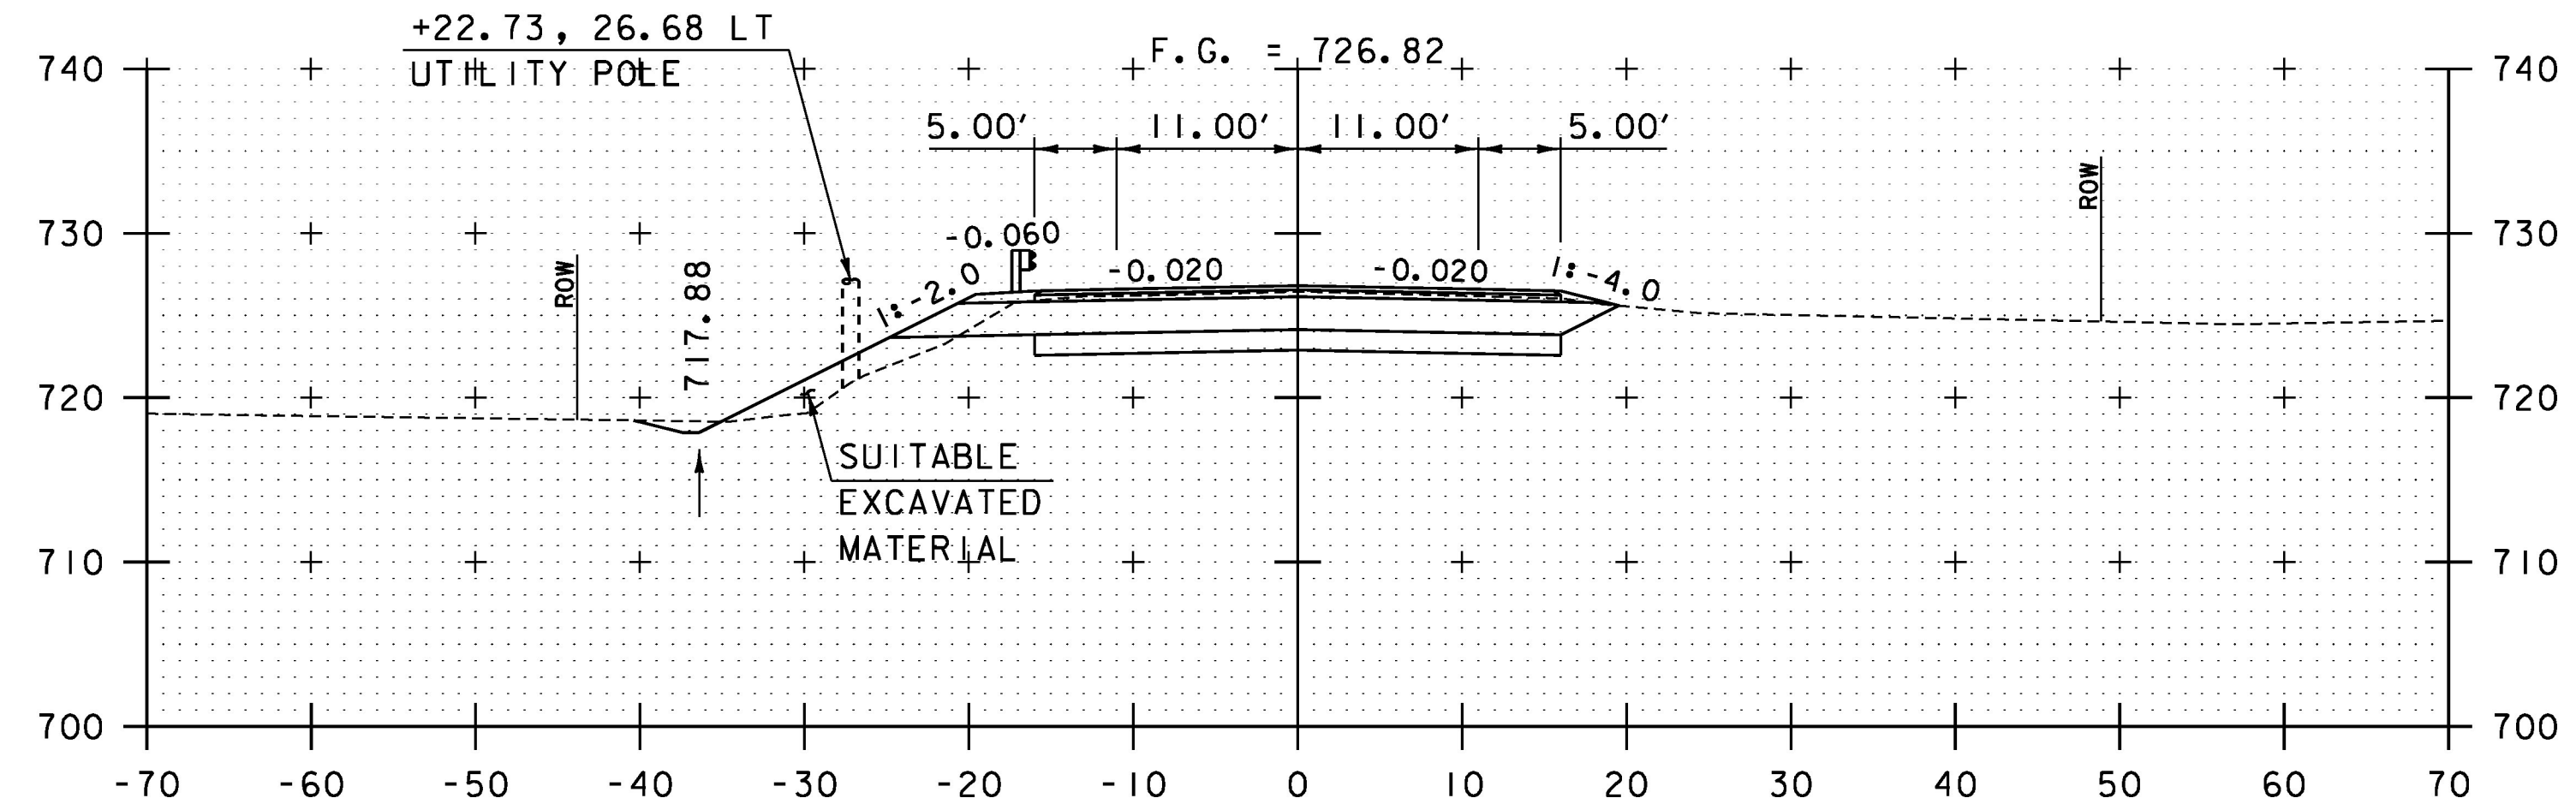

12+25

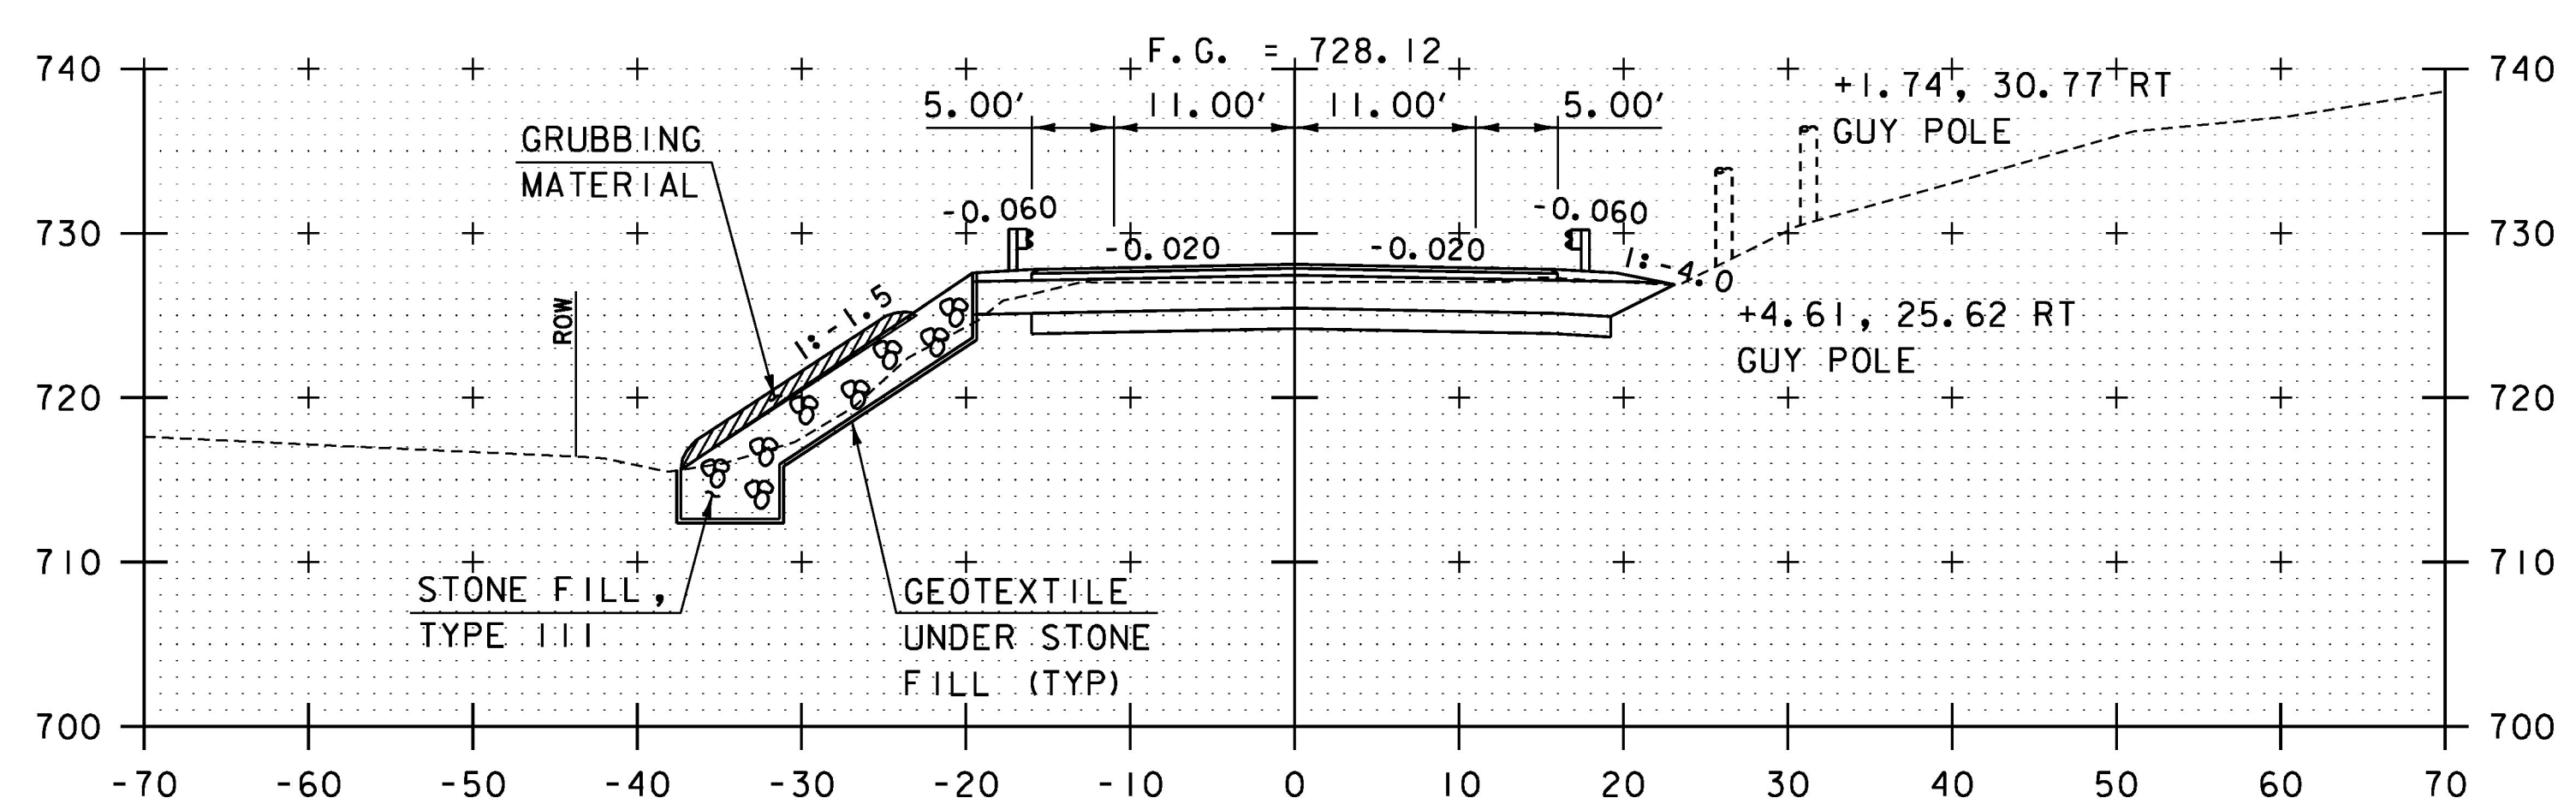

13+00

SCALE 1" = 10'-0"



STA. 12+25 TO STA. 13+50

PROJECT NAME: WAITSFIELD	PLOT DATE: 8/24/2015
PROJECT NUMBER: BRF 013-4(39)	DRAWN BY: S. MERKWAN
FILE NAME: z12b136xsl.dgn	CHECKED BY: T. KENDRICK
PROJECT LEADER: R. YOUNG	SHEET 52 OF 69
DESIGNED BY: D. KULL	
VT 100 CROSS SECTION SHEET 2	