


SOIL CLASSIFICATION:  
 MACHIAS FINE SANDY LOAM  
 3%-8% SLOPES  
 NOT HIGHLY ERODIBLE  
 K=0.17

SOIL CLASSIFICATION:  
 WEIDER VERY FINE SANDY LOAM  
 0%-3% SLOPES  
 NOT HIGHLY ERODIBLE  
 K=0.32

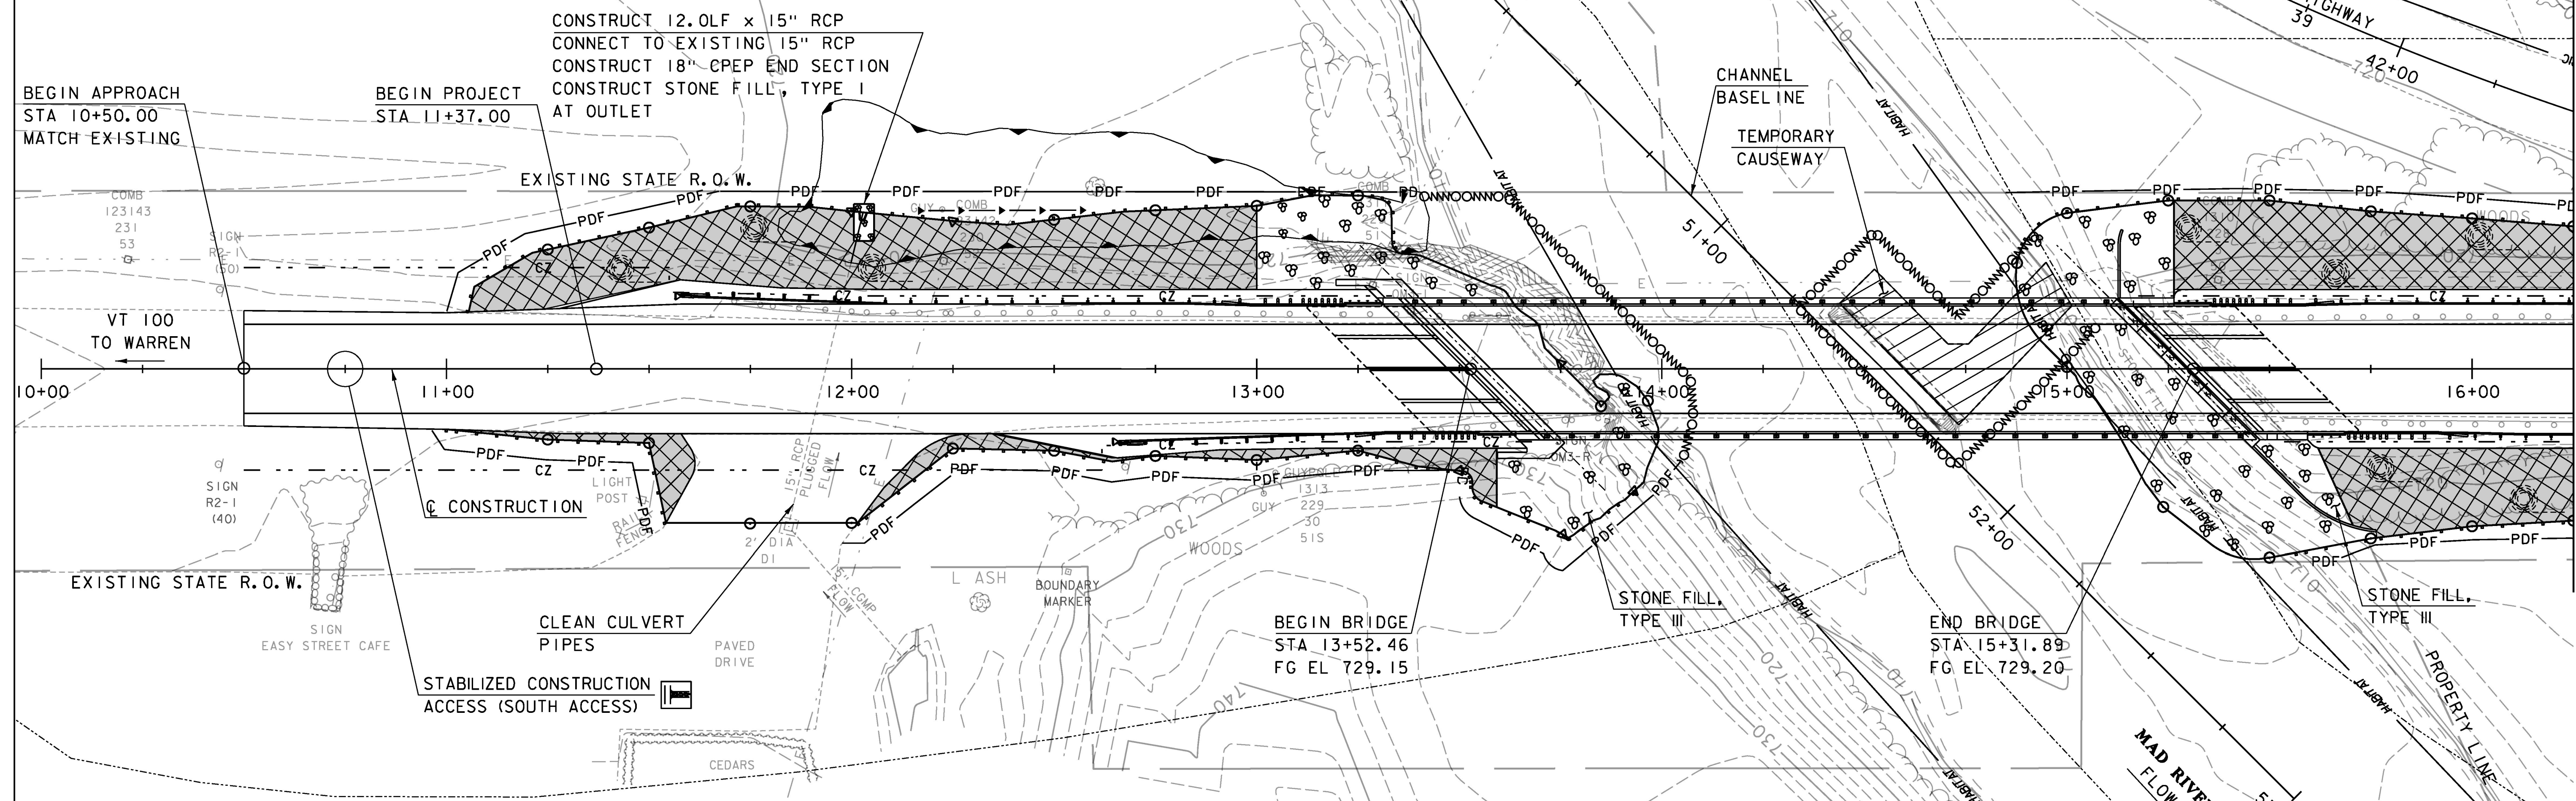

BEGIN APPROACH  
 STA 10+50.00  
 MATCH EXISTING

BEGIN PROJECT  
 STA 11+37.00

CONSTRUCT 12.0LF x 15" RCP  
 CONNECT TO EXISTING 15" RCP  
 CONSTRUCT 18" CPEP END SECTION  
 CONSTRUCT STONE FILL, TYPE I  
 AT OUTLET

CHANNEL  
 BASELINE  
 TEMPORARY  
 CAUSEWAY

VT 100  
 TO WARREN

EXISTING STATE R.O.W.

CLEAN CULVERT  
 PIPES

STABILIZED CONSTRUCTION  
 ACCESS (SOUTH ACCESS)

BEGIN BRIDGE  
 STA 13+52.46  
 FG EL 729.15


STONE FILL,  
 TYPE III

END BRIDGE  
 STA 15+31.89  
 FG EL 729.20

STONE FILL,  
 TYPE III

NOTE:  
 FOR EPSC PLAN SYMBOLOGY LEGEND SEE SHEET 11.

SOIL CLASSIFICATION:  
 COLTON GRAVELLY LOAMY SAND  
 25%-60% SLOPES  
 HIGHLY ERODIBLE  
 K=0.17

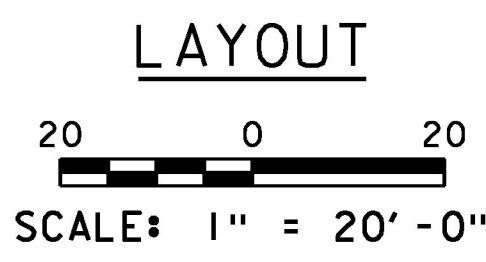

PROJECT NAME:	WAITSFIELD
PROJECT NUMBER:	BRF 013-4(39)
FILE NAME:	z12b136bdr_ero.dgn
PROJECT LEADER:	R. YOUNG
DESIGNED BY:	J. SANTACRUCE
EPSC CONSTRUCTION LAYOUT SHEET 1	
PLOT DATE:	8/24/2015
DRAWN BY:	S. MERKWAN
CHECKED BY:	T. KENDRICK
SHEET	62 OF 69

MATCH LINE STA 16+25 (CONSTRUCTION LAYOUT 2)