

BEGIN APPROACH  
STA 10+50.00  
MATCH EXISTING

BEGIN PROJECT  
STA 11+37.00

COMB  
123143  
231  
53  
9

VT 100  
TO WARREN

EXISTING STATE R.O.W.

10+00 11+00 12+00 13+00 14+00 15+00 16+00

SIGN  
R2-1  
(40)

CONSTRUCTION

LIGHT  
POST

RAIL FENCE

2' DIA  
DI

1.5" RCP  
PLUGGED  
FLOW

ST. COMB  
FLOW

EXISTING STATE R.O.W.

SIGN  
EASY STREET CAFE

PAVED  
DRIVE

CEDARS

L ASH

BOUNDARY  
MARKER

WOODS

BEGIN BRIDGE  
STA 13+52.46  
FG EL 729.15


STONE FILL,  
TYPE III

END BRIDGE  
STA 15+31.89  
FG EL 729.20

STONE FILL,  
TYPE III

MAD RIVER  
FLOW

NOTE:  
FOR EPSC PLAN SYMBOLY LEGEND SEE SHEET 11.

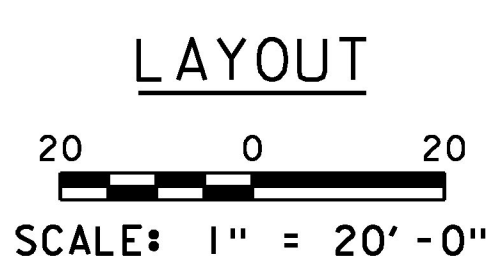

PROJECT NAME: WAITSFIELD	
PROJECT NUMBER: BRF 013-4(39)	
FILE NAME: z12b136bdr_ero.dgn	PLOT DATE: 8/24/2015
PROJECT LEADER: R. YOUNG	DRAWN BY: P. DUSTIN
DESIGNED BY: D. KULL	CHECKED BY: T. KENDRICK
EPSC FINAL LAYOUT SHEET 1	SHEET 64 OF 69

MATCH LINE STA 16+25 (FINAL LAYOUT 2)