


NOTE:
FOR EPSC PLAN SYMBOLOGY LEGEND SEE SHEET 11.



PROJECT NAME: WAITSFIELD	
PROJECT NUMBER: BF 013-4(39)	
FILE NAME: z12b136bdr_ero.dgn	PLOT DATE: 8/24/2015
PROJECT LEADER: R. YOUNG	DRAWN BY: S. MERKWAN
DESIGNED BY: D. KULL	CHECKED BY: T. KENDRICK
EPSC FINAL LAYOUT SHEET 2	SHEET 65 OF 69

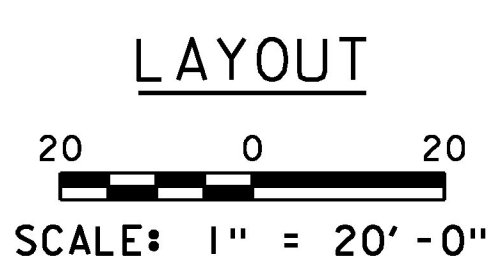