



15-0789 2/2/2016 COPYRIGHT © 2011 - 2015 BY CIVIL DESIGN PROFESSIONALS. THIS DRAWING IS BEING FURNISHED FOR THIS SPECIFIC PROJECT ONLY. COPY AND/OR REUSE WITHOUT THE CONSENT OF CIVIL DESIGN PROFESSIONALS IS PROHIBITED.

NOTES:

1. THE SITE PLAN SHOWN IS FOR ILLUSTRATIVE PURPOSES ONLY. SITE PLAN PROVIDED IS REPRODUCED FROM MCFARLAND JOHNSON ABUTMENT NO. 2 GRADING PLAN (SHEET 24 OF 69) LAST DATED AUGUST 24, 2015.
2. THE APPROXIMATE LOCATION OF UTILITIES KNOWN TO EXIST AS SHOWN ON THE PLANS ARE BASED ON THE BEST INFORMATION AVAILABLE AT THE TIME OF PLAN PREPARATION.
3. IT SHALL BE THE RESPONSIBILITY OF THE CONTRACTOR TO VERIFY THE LOCATIONS AND NECESSARY INVERTS OF ALL UTILITIES WITHIN THE LIMITS OF CONSTRUCTION. THE CONTRACTOR SHALL BE RESPONSIBLE FOR THE NOTIFICATIONS AND LIAISON WITH UTILITY COMPANIES IN THE PROCESS OF LOCATING, RELOCATING, AND TIE-IN TO THE PUBLIC UTILITIES.



Know what's below.
Call before you dig.

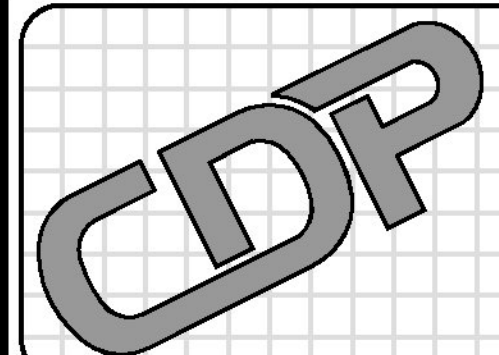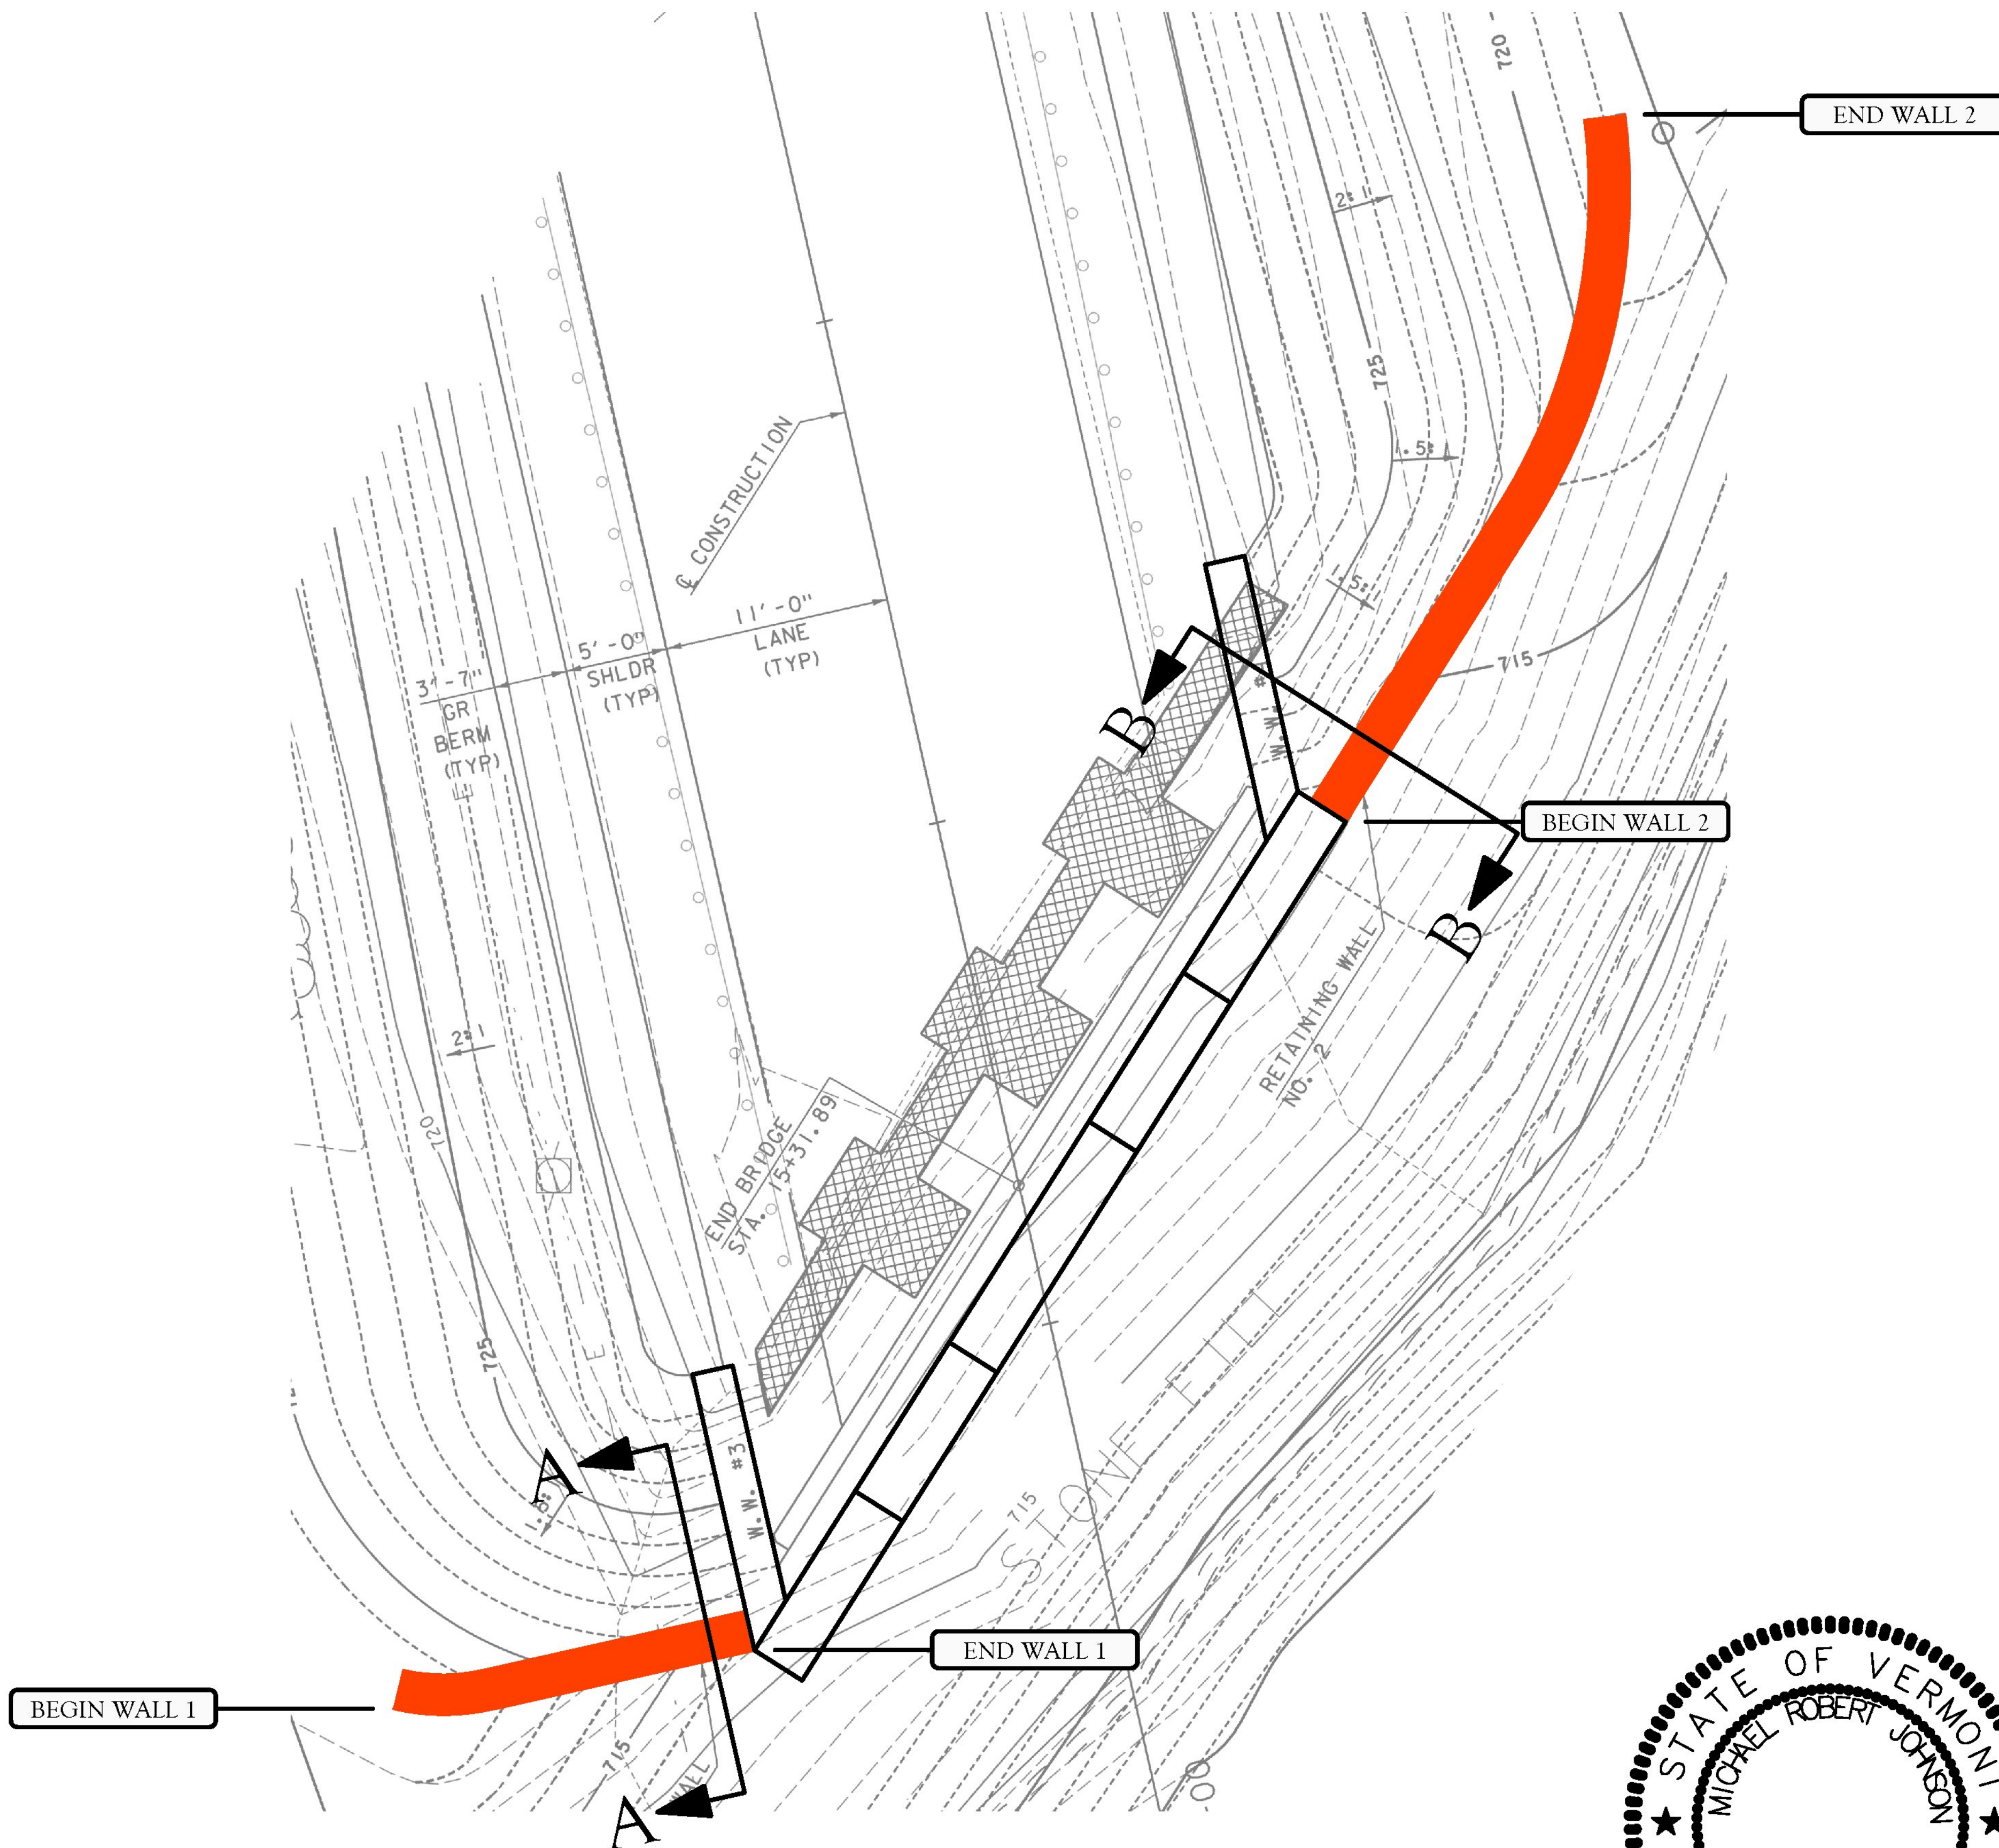

CIVIL DESIGN PROFESSIONALS


8609 LINDALE AVENUE SOUTH, SUITE 200 BLOOMINGTON, MN 55420
PHONE: (952) 303-5312 | FAX: (763) 392-1889 | WEBSITE: WWW.CDP.US.COM
SITE SOLUTION PROFESSIONALS, INC. D.B.A. CIVIL DESIGN PROFESSIONALS

No	Date	Revision	By
1	2.02.2016	REVISE BLOCK AND QUANTITIES	TPH
2			
3			
4			
5			
6			

Designed By
TPH
Scale
1" = 10'
Date
JAN 28, 2016

Project
WAITSFIELD BR# 013-4(39)
WAITSFIELD, VERMONT
Title
SITE PLAN

Registration No
8619
Project No
15-0789
Sheet No
2.00

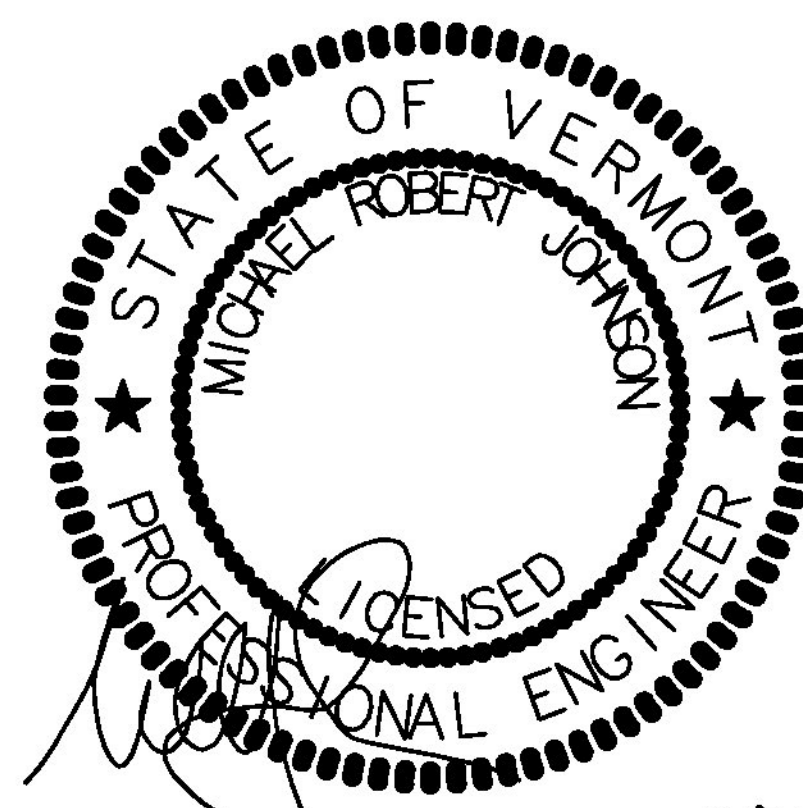

MICHAEL R. JOHNSON, P.E. Date 2/2/16