



1 ABUTMENT #2 - ABUTMENT, BACKWALL, & WINGWALL ELEVATION  
F4.1  
1/4" = 1'-0"

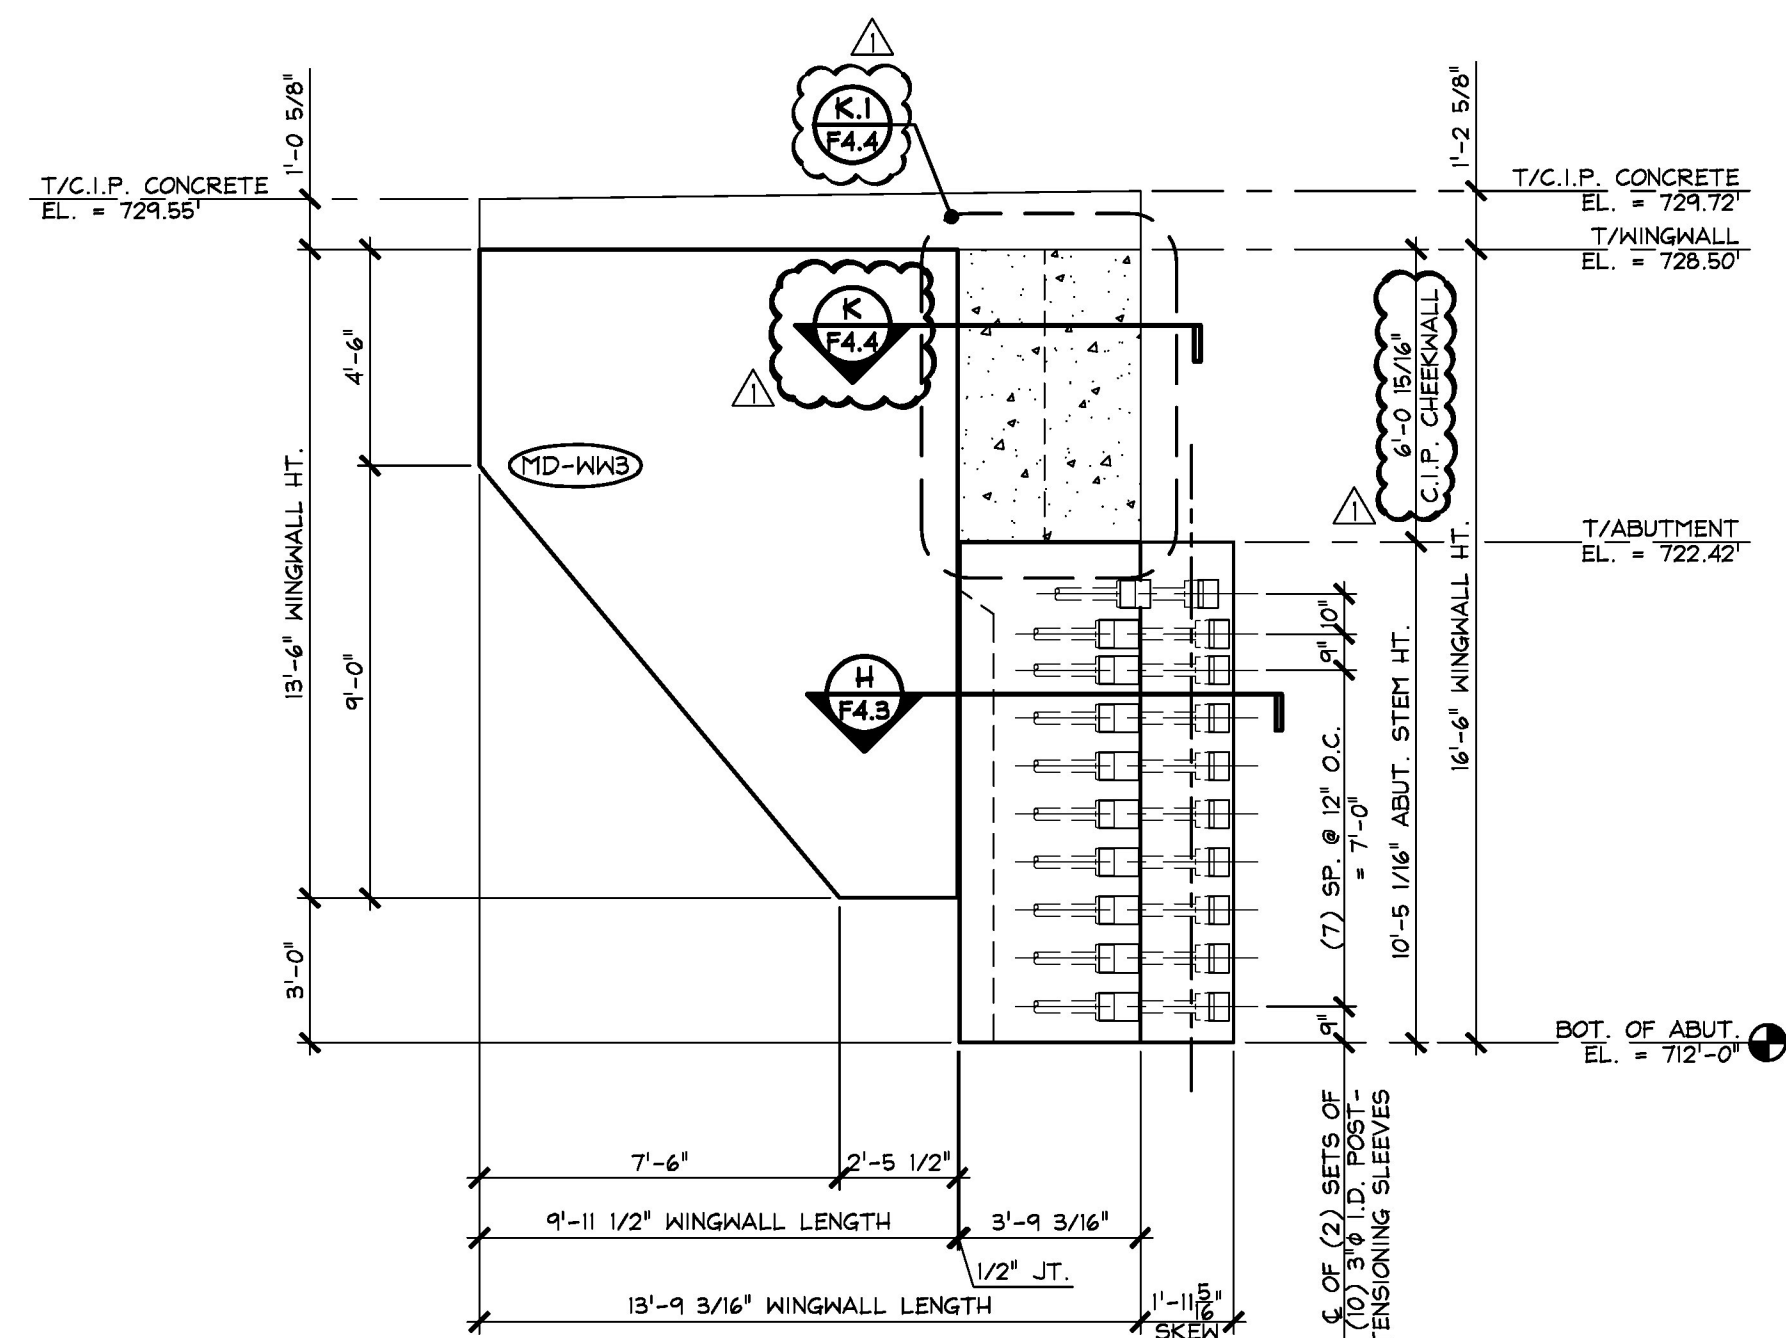

2 WINGWALL #3 ELEVATION  
F4.1  
1/4" = 1'-0"

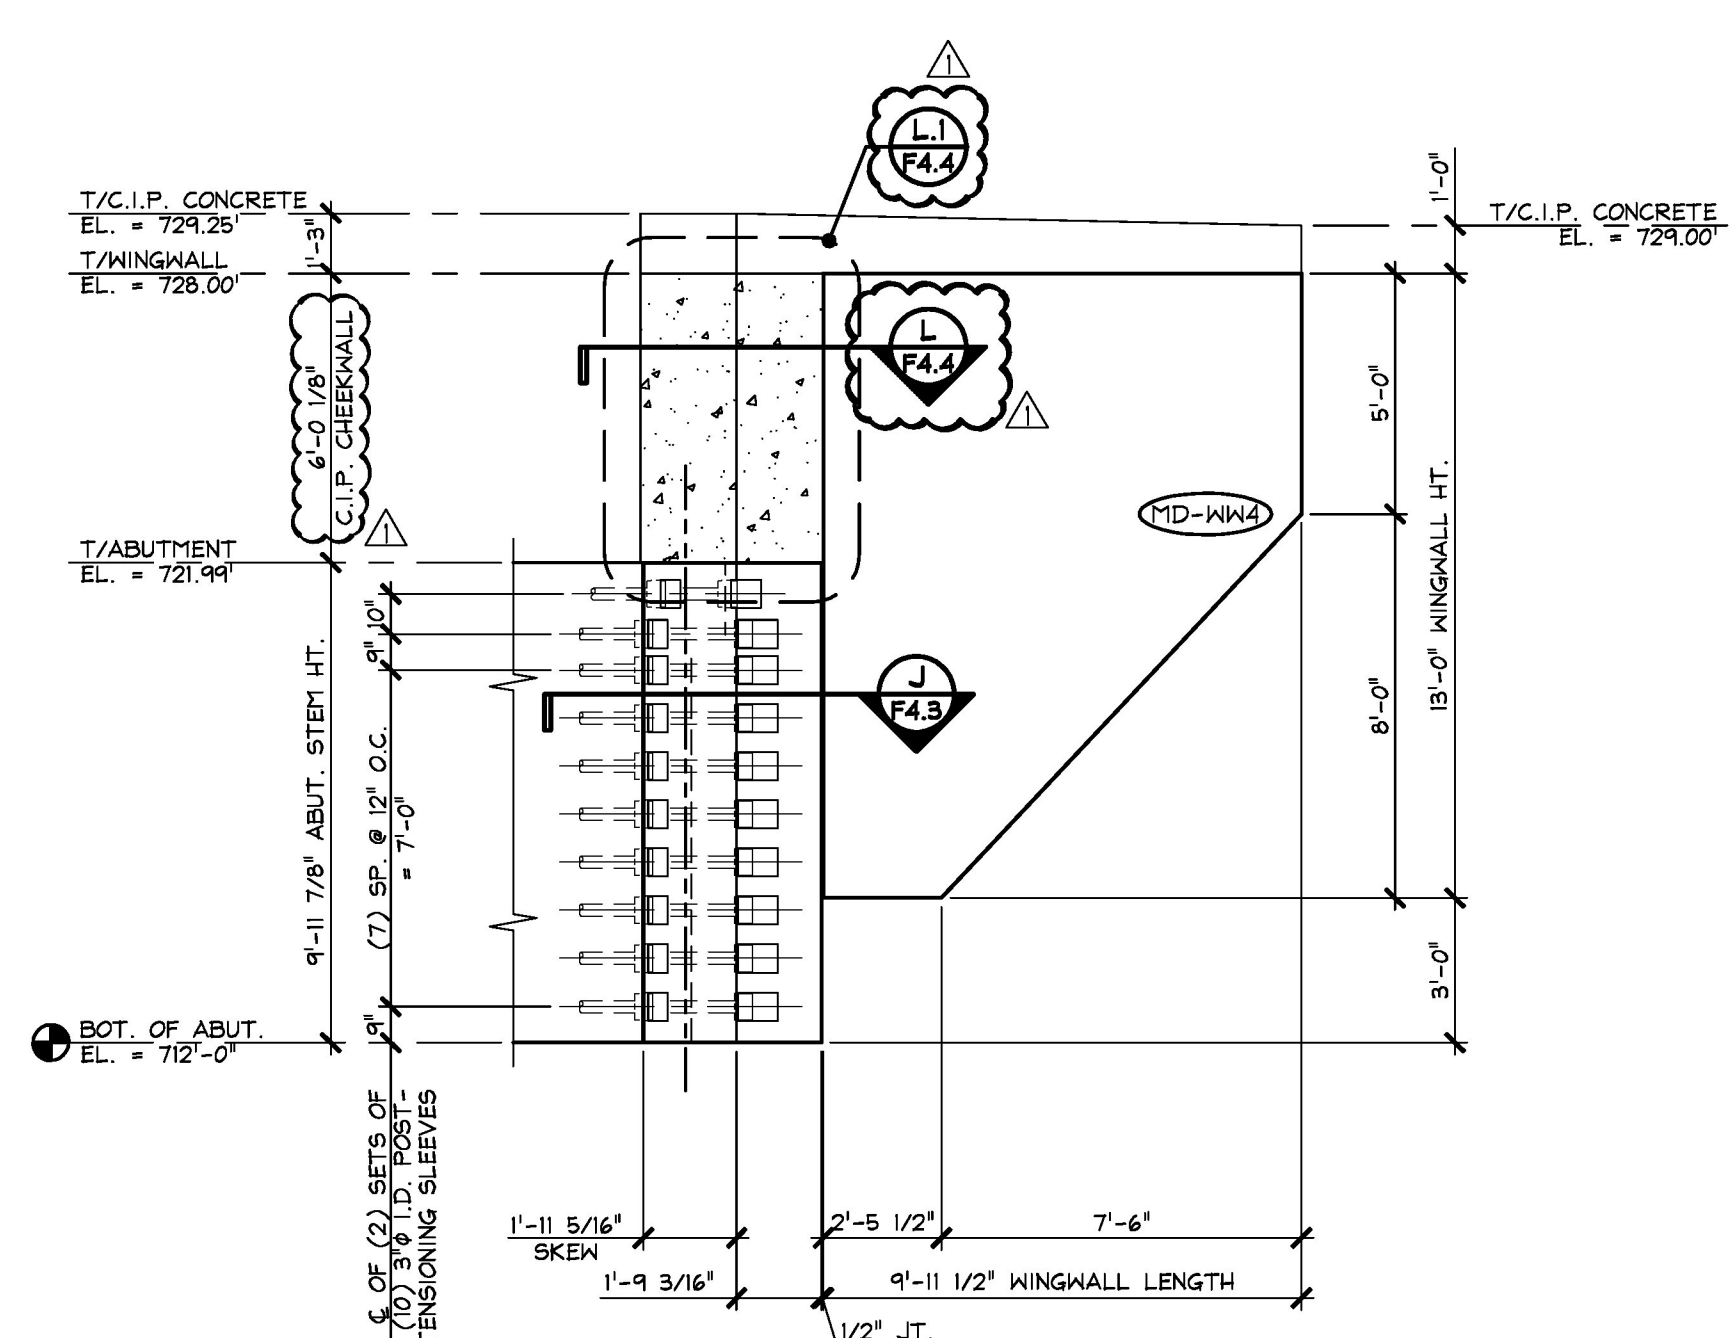

3 WINGWALL #4 ELEVATION  
F4.1  
1/4" = 1'-0"

Vermont Agency of Transportation  
**RECEIVED**  
ON: May 10, 2016  
and Checked for  
**CONFORMANCE**  
BY: Rob Young DATE: 05/18/2016

Approved  
 Rejected

Approved As Noted

This review is only for general conformance with the design concept and the information given in the Construction Documents. Corrections or comments made on the shop drawings during the review do not relieve the Contractor from compliance with the requirements of the Plans and Specifications. Review of a specific item shall not include review of an assembly of which an item is a component. The Contractor is responsible for dimensions to be confirmed and corrected at the job site; information that pertains solely to the fabrication process or to the means, methods, techniques, sequences and procedures of construction; coordination of the Work with that of other trades and performing all Work in a safe and satisfactory manner.

Date: 5/13/2016

By: D. Kull

5-10-16 REVISED AS NOTED

|                 |   |  |  |  |
|-----------------|---|--|--|--|
| APPROVAL STAMP: | <b>J.P. CARRARA &amp; SONS INC.</b><br>Precast & Prestress Manufacturer<br>2464 CASE ST., MIDDLEBURY, VERMONT 05753 Phone: (802)388-6361 Fax: (802)388-9010 |  | <b>A.L. ST. ONGE CONTRACTOR, INC.</b><br>CONTRACTOR<br>MONTGOMERY, VERMONT |  |
|                 | STATE OF VERMONT AGENCY OF TRANSPORTATION<br>COUNTY OF WINDSOR  |  | DATE: JAN. 12, 2016<br>SCALE: NOTED  |  |
|                 | TOWN OF WAITSFIELD<br>VT ROUTE 100 (MINOR ARTERIAL)<br>BRIDGE NO.: 177 PROJECT NO.: BRP 013-4(39)   |  | CHKD: - DFTM: B.L.<br>JOB NO: 23480-016                                    |  |
|                 | ABUTMENT #2 ELEVATIONS  |  | DWG. NO: F4.1  |  |