


THIS DETAIL HAS BEEN REPLACED WITH CAST-IN-PLACE CHEEKWALL DETAILS (SEE DETAIL "K/F4.4")


F WING WALL CONNECTION DETAIL
F4.3 3/4" = 1'-0"

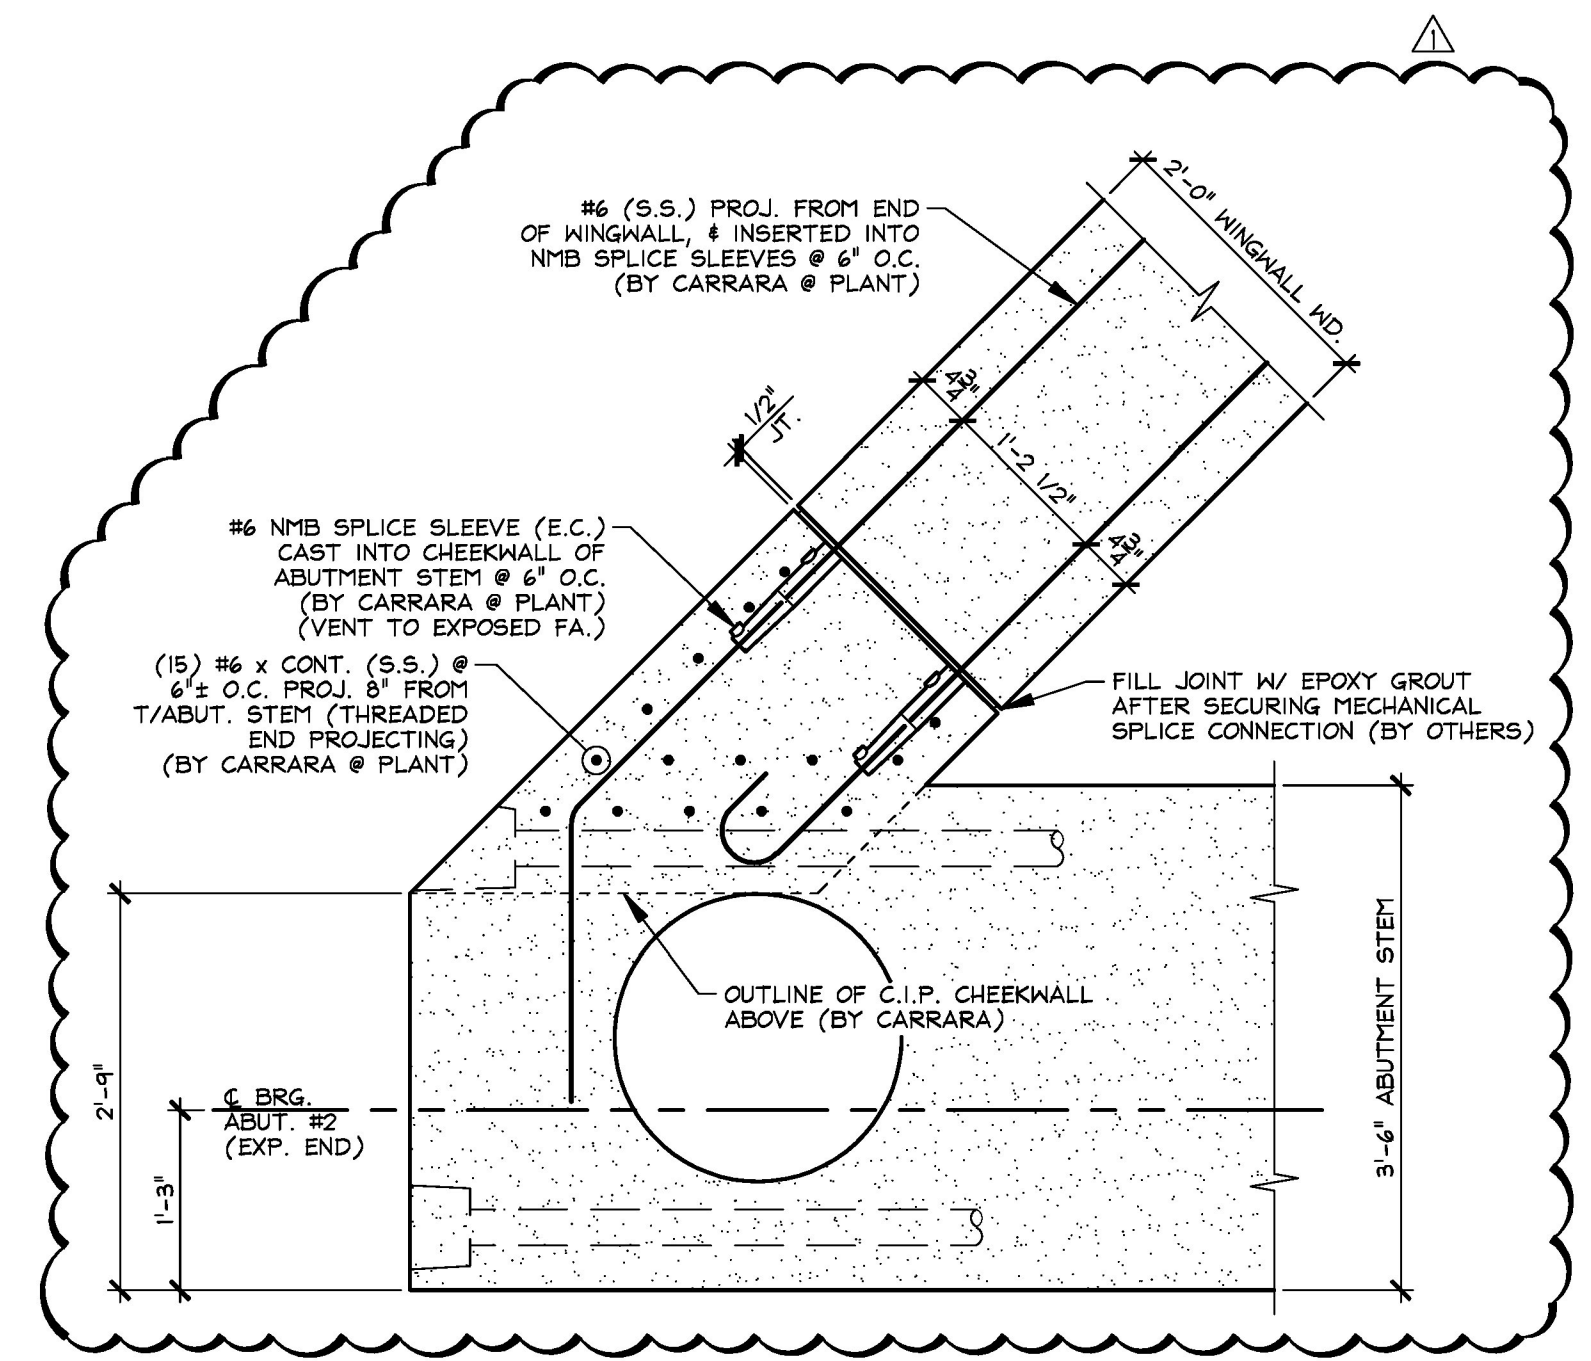

H WING WALL CONNECTION DETAIL
F4.3 3/4" = 1'-0"

THIS DETAIL HAS BEEN REPLACED WITH CAST-IN-PLACE CHEEKWALL DETAILS (SEE DETAIL "L/F4.4")

G WING WALL CONNECTION DETAIL
F4.3 3/4" = 1'-0"

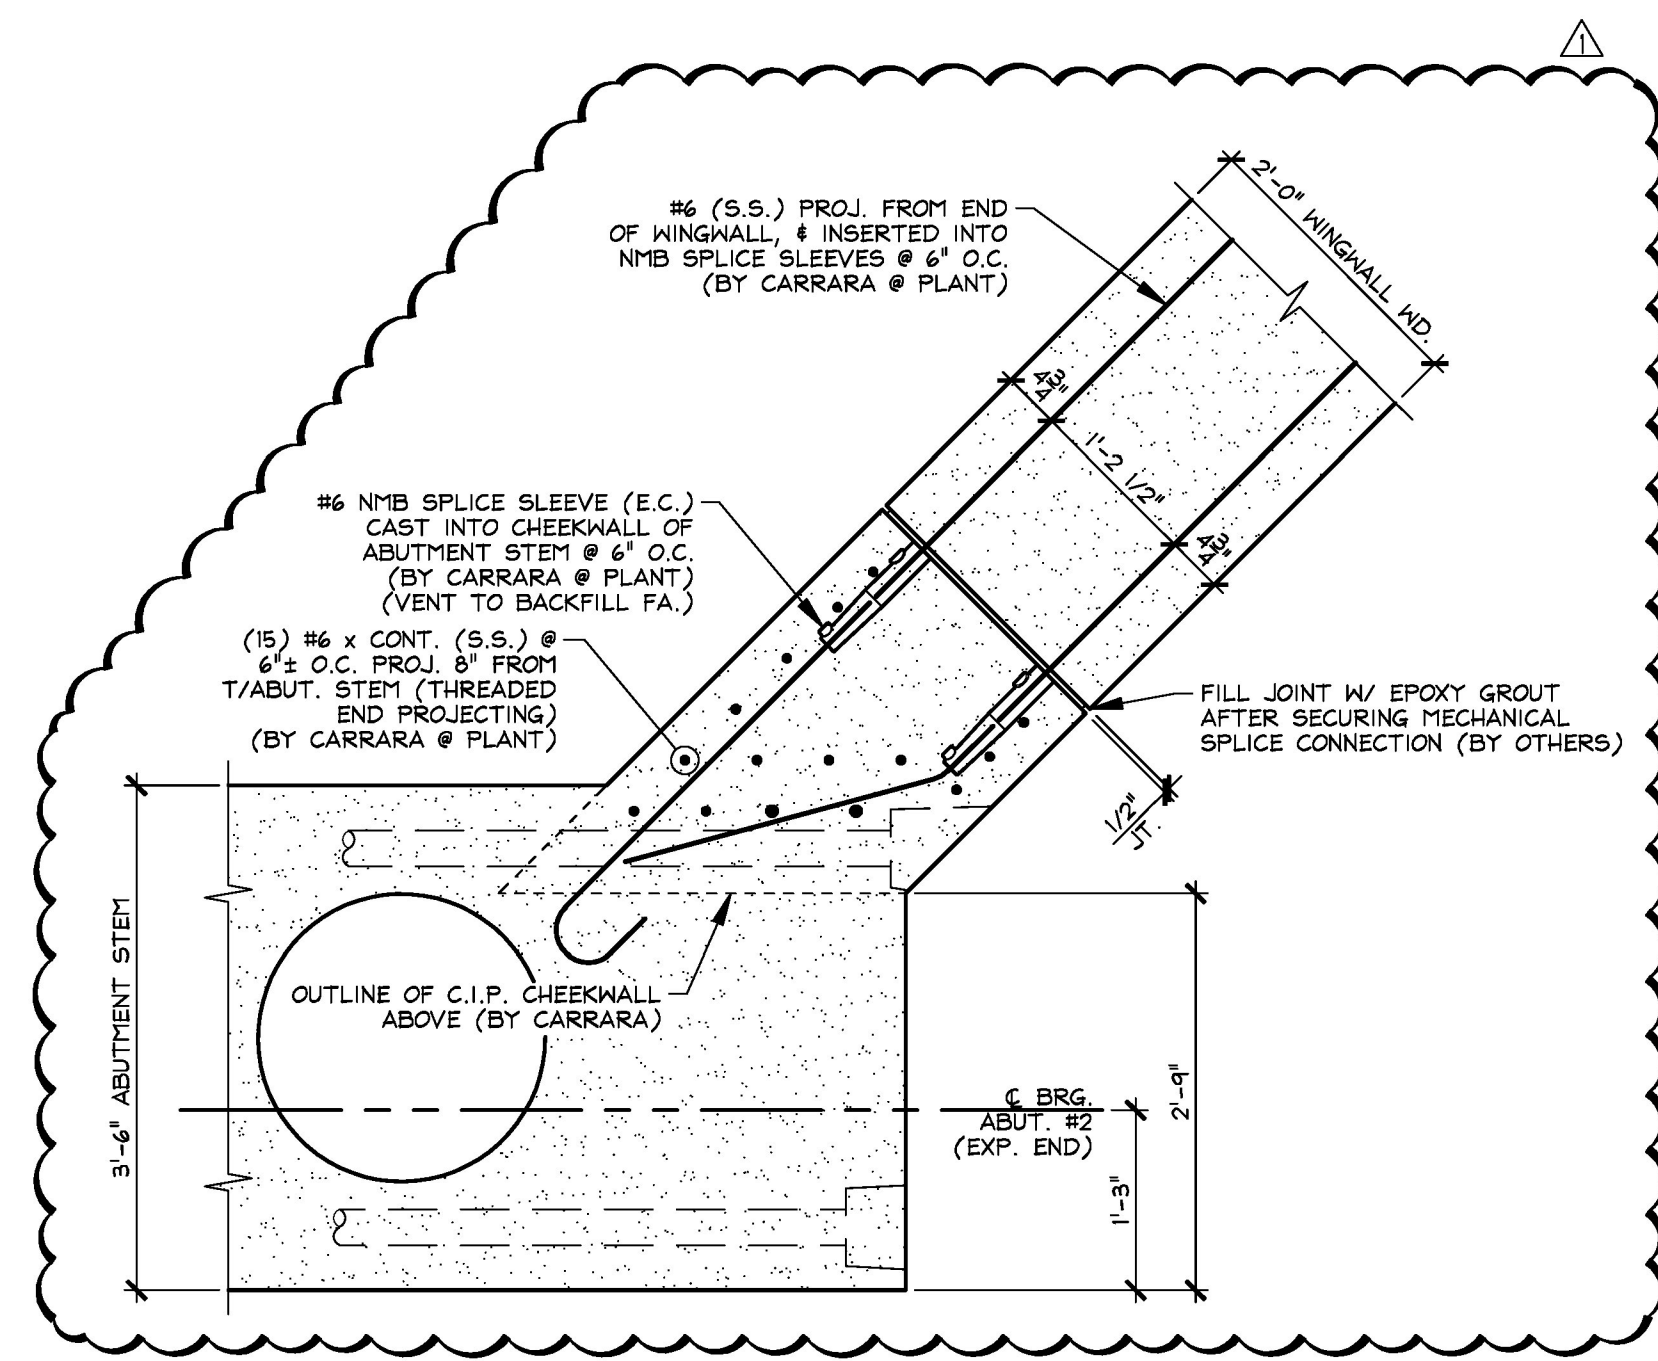

J WING WALL CONNECTION DETAIL
F4.3 3/4" = 1'-0"

GENERAL NOTE:
ALL SPLICE SLEEVES TO BE GROUTED W/ NMB SS MORTAR PER MANUFACTURERS INSTRUCTION, (BY OTHERS)

F:\VT-Bridges\23480-15 Waitsfield\23480-F4-3.dwg, 5/10/2016 2:22:50 PM

Vermont Agency of Transportation
RECEIVED
ON: **May 10, 2016**
and Checked for
CONFORMANCE
BY: Rob Young DATE: 05/16/2016

Approved Approved As Noted
Rejected

This review is only for general conformance with the design concept and the information given in the Construction Documents. Corrections or comments made on the shop drawings during the review do not relieve the Contractor from compliance with the requirements of the Plans and Specifications. Review of a specific item shall not include review of an assembly of which an item is a component. The Contractor is responsible for dimensions to be confirmed and corrected at the job site; information that pertains solely to the fabrication process or to the means, methods, techniques, sequences and procedures of construction; coordination of the Work with that of other trades and performing all Work in a safe and satisfactory manner.

Date: 5/13/2016
By: D. Kull

McFarland Johnson

5-10-16 REVISED TO INCORPORATE C.I.P. CHEEKWALL

APPROVAL STAMP:	J.P. CARRARA & SONS INC. Precast & Prestress Manufacturer 2464 OASE STR., MIDDLEBURY, VERMONT 05753 Phone:(802)388-6361 Fax:(802)388-9010		A.L. ST. ONGE CONTRACTOR, INC. CONTRACTOR MONTGOMERY, VERMONT	
	STATE OF VERMONT AGENCY OF TRANSPORTATION COUNTY OF WINDSOR		DATE: JAN. 12, 2016	SCALE: NOTED
	TOWN OF WAITSFIELD VT ROUTE 100 (MINOR ARTERIAL) BRIDGE NO.: 177 PROJECT NO.: BRP 013-4(39)		CHKD: -	DFTM: B.L.
	ABUTMENT #2 DETAILS		JOB NO: 23480-016	DWG. NO: F4.3