




K.2 T/CHEEKWALL REINFORCING PLAN
F4.4 3/4" = 1'-0"

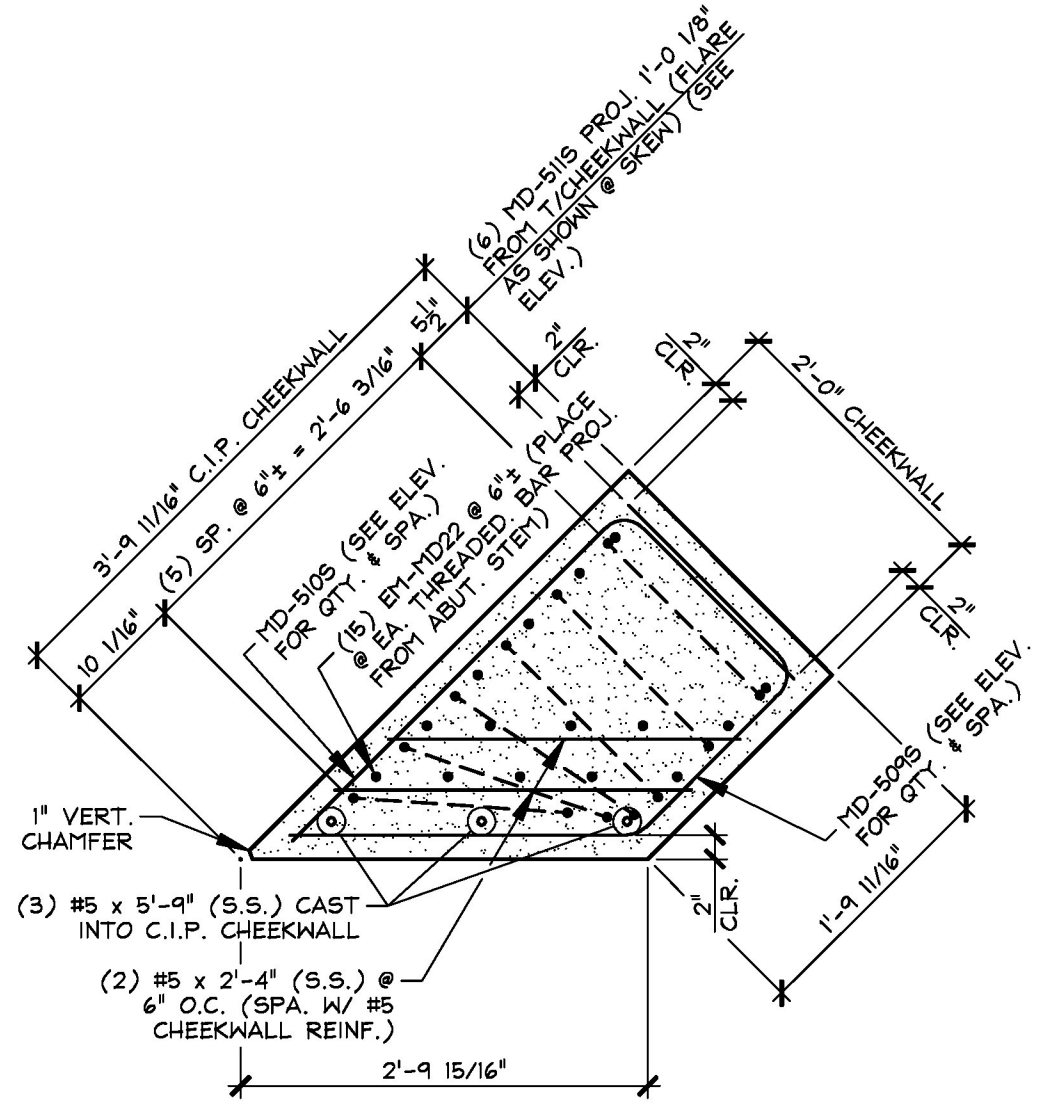


L.2 T/CHEEKWALL REINFORCING PLAN
F4.4 SEE ELEVATION 1/14.11 FOR LOCATION OF EM-MD18 (7/8\"/>

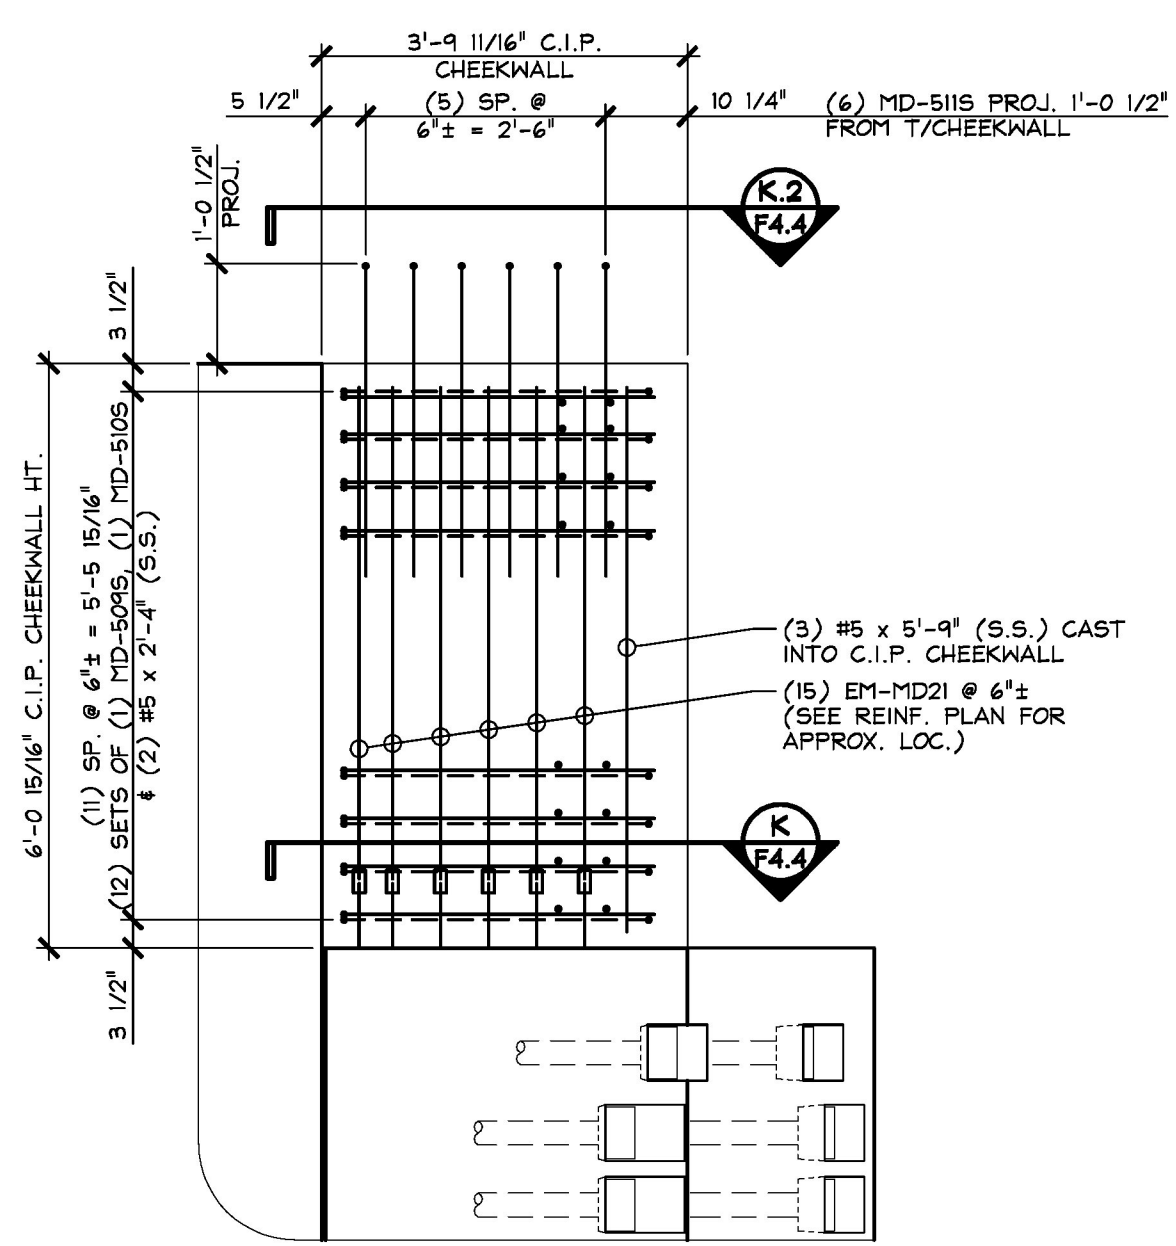


K.1 C.I.P. CHEEKWALL REINFORCING ELEVATION
F4.4 PROJECTING WING WALL REINFORCING NOT SHOWN FOR CLARITY 3/4" = 1'-0"

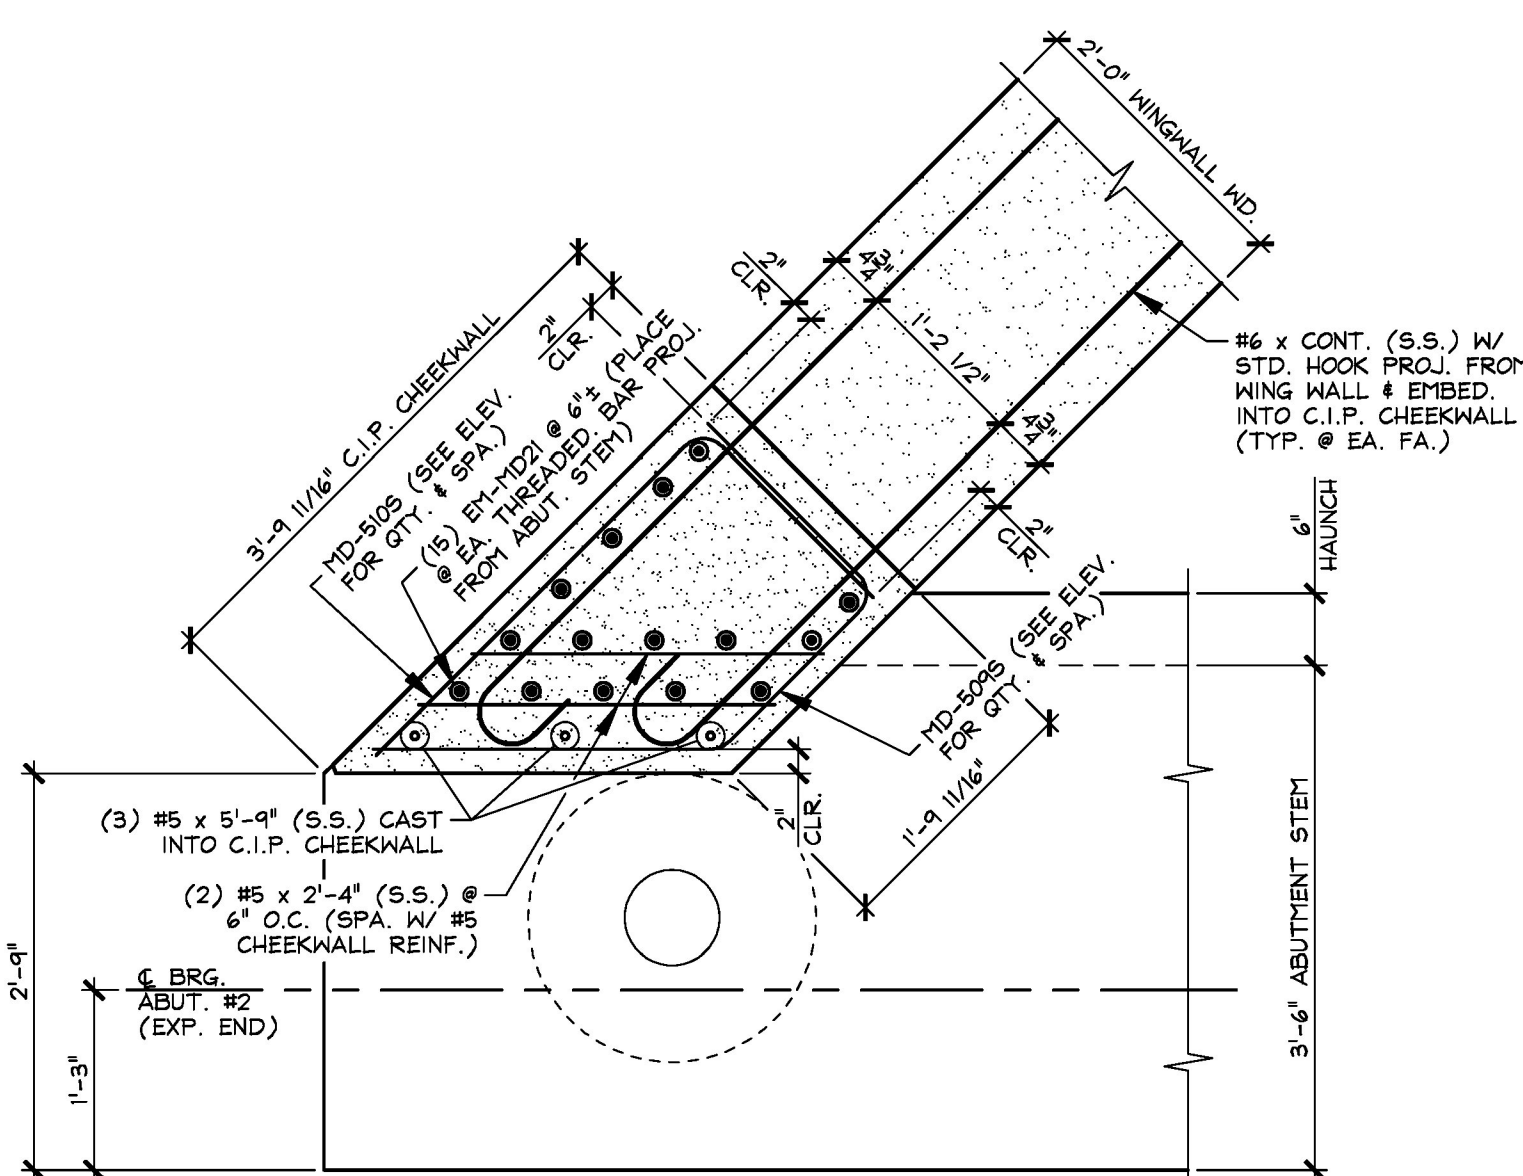

K C.I.P. CHEEKWALL REINFORCING PLAN
F4.4 3/4" = 1'-0"

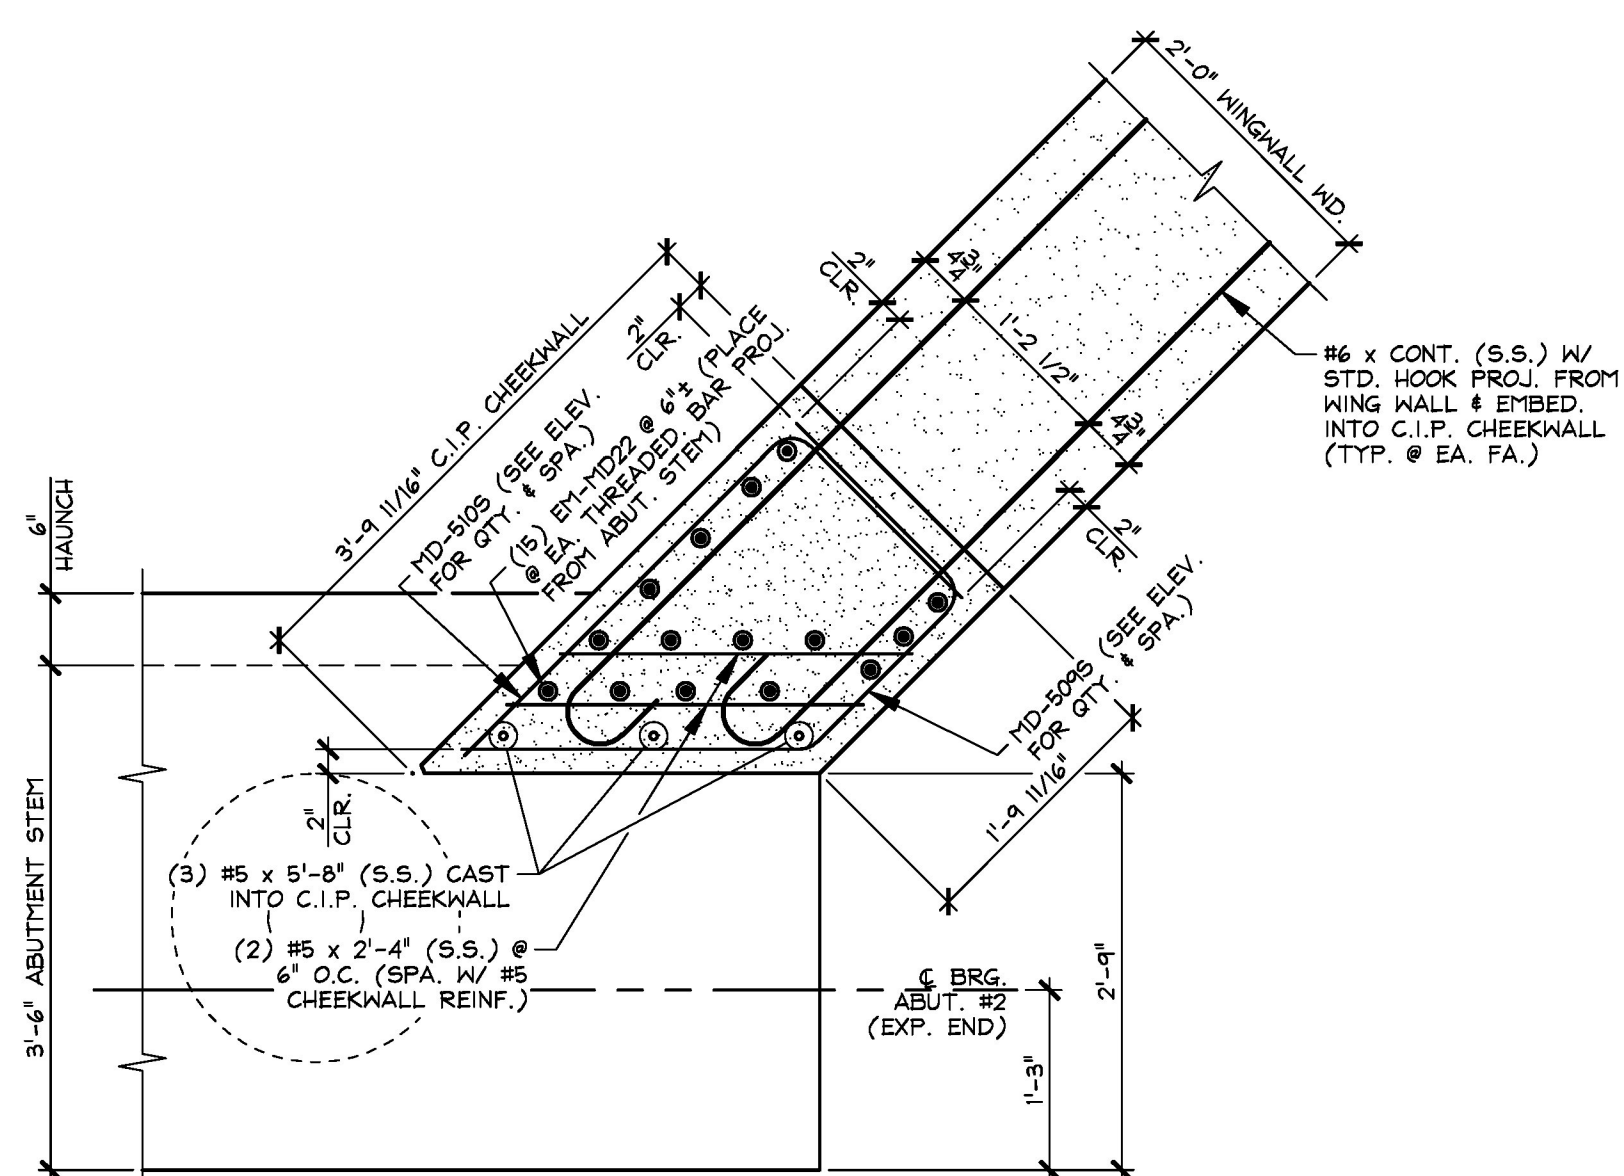

L C.I.P. CHEEKWALL REINFORCING PLAN
F4.4 3/4" = 1'-0"

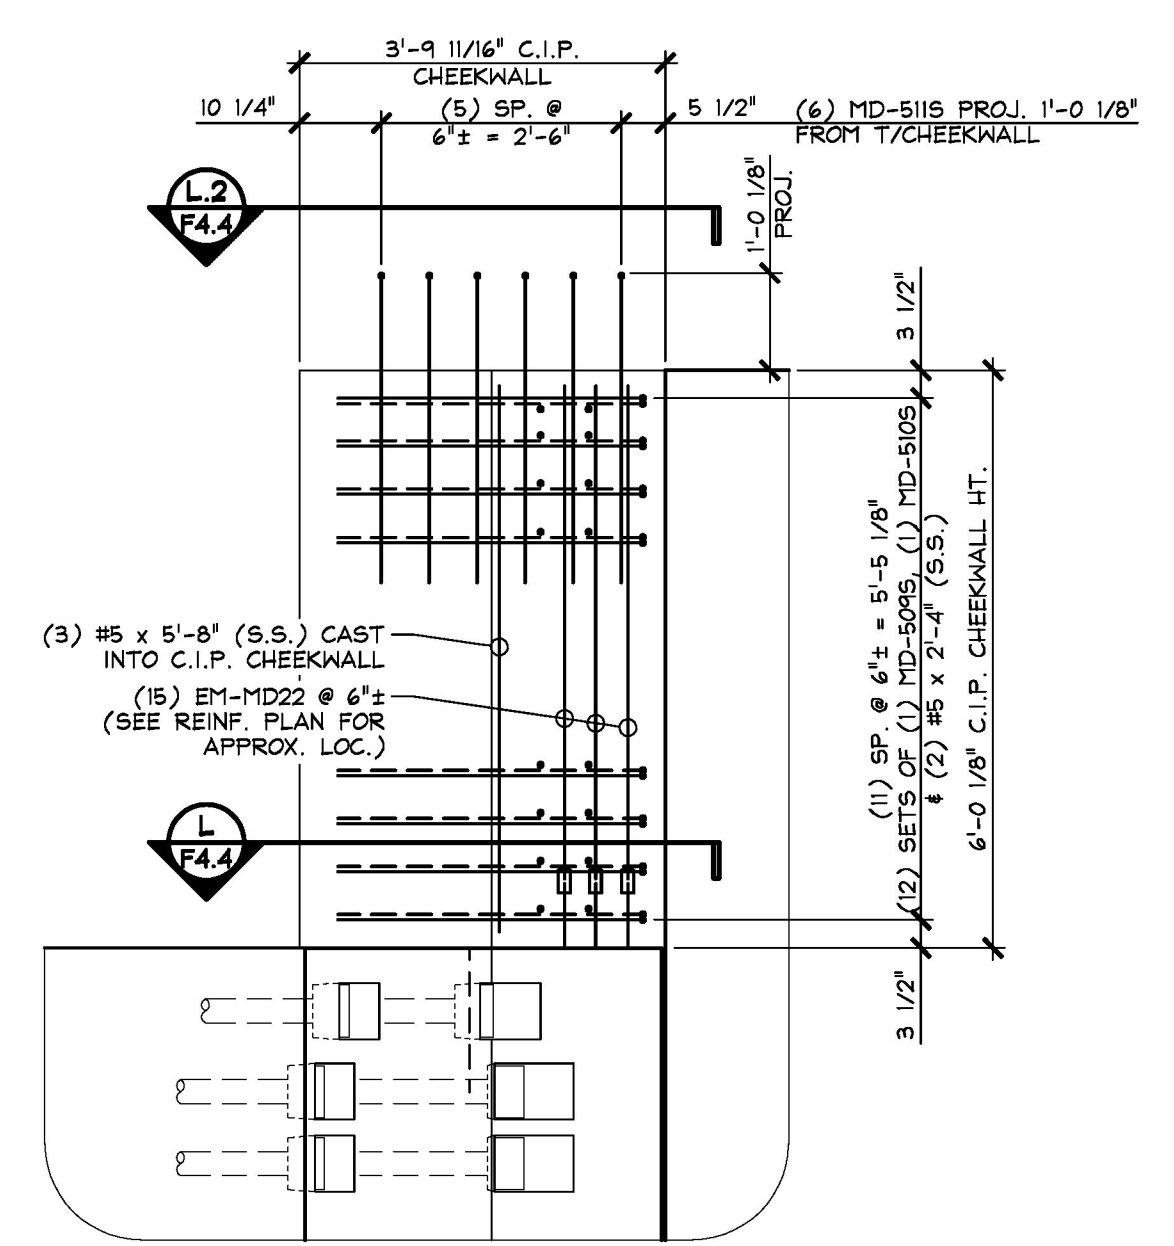

L.1 C.I.P. CHEEKWALL REINFORCING ELEVATION
F4.4 PROJECTING WING WALL REINFORCING NOT SHOWN FOR CLARITY 3/4" = 1'-0"

F:\VT-Bridges\23480-15 Waitsfield\23480-F4-4.dwg, 5/10/2016 2:24:54 PM

Vermont Agency of Transportation
RECEIVED
 ON: **May 10, 2016**
 and Checked for
CONFORMANCE
 BY: Rob Young DATE: 05/16/2016

Approved	X Approved As Noted
Rejected	

This review is only for general conformance with the design concept and the information given in the Construction Documents. Corrections or comments made on the shop drawings during the review do not relieve the Contractor from compliance with the requirements of the Plans and Specifications. Review of a specific item shall not include review of an assembly of which an item is a component. The Contractor is responsible for dimensions to be confirmed and corrected at the job site; information that pertains solely to the fabrication process or to the means, methods, techniques, sequences and procedures of construction; coordination of the Work with that of other trades and performing all Work in a safe and satisfactory manner.

McFarland Johnson
 Date: 5/13/2016
 By: D. Kull

5-10-16 REVISED TO INCORPORATE C.I.P. CHEEKWALL

APPROVAL STAMP:	J.P. CARRARA & SONS INC. Precast & Prestress Manufacturer 2464 OSE STR., MIDDLEBURY, VERMONT 05753 Phone: (802)388-6361 Fax: (802)388-9010	A.L. ST. ONGE CONTRACTOR, INC. CONTRACTOR MONTGOMERY, VERMONT
STATE OF VERMONT AGENCY OF TRANSPORTATION COUNTY OF WINDSOR		DATE: JAN. 12, 2016
TOWN OF WAITSFIELD VT ROUTE 100 (MINOR ARTERIAL) BRIDGE NO.: 177 PROJECT NO.: BRP 013-4(39)		SCALE: NOTED
ABUTMENT #2 CAST-IN-PLACE CHEEKWALL DETAILS		CHKD: - DFTM: B.L. JOB NO: 23480-016
		DWG. NO: F4.4