




1 DIMENSIONAL PLAN VIEW IN FORM
FGI 1/2" = 1'-0"

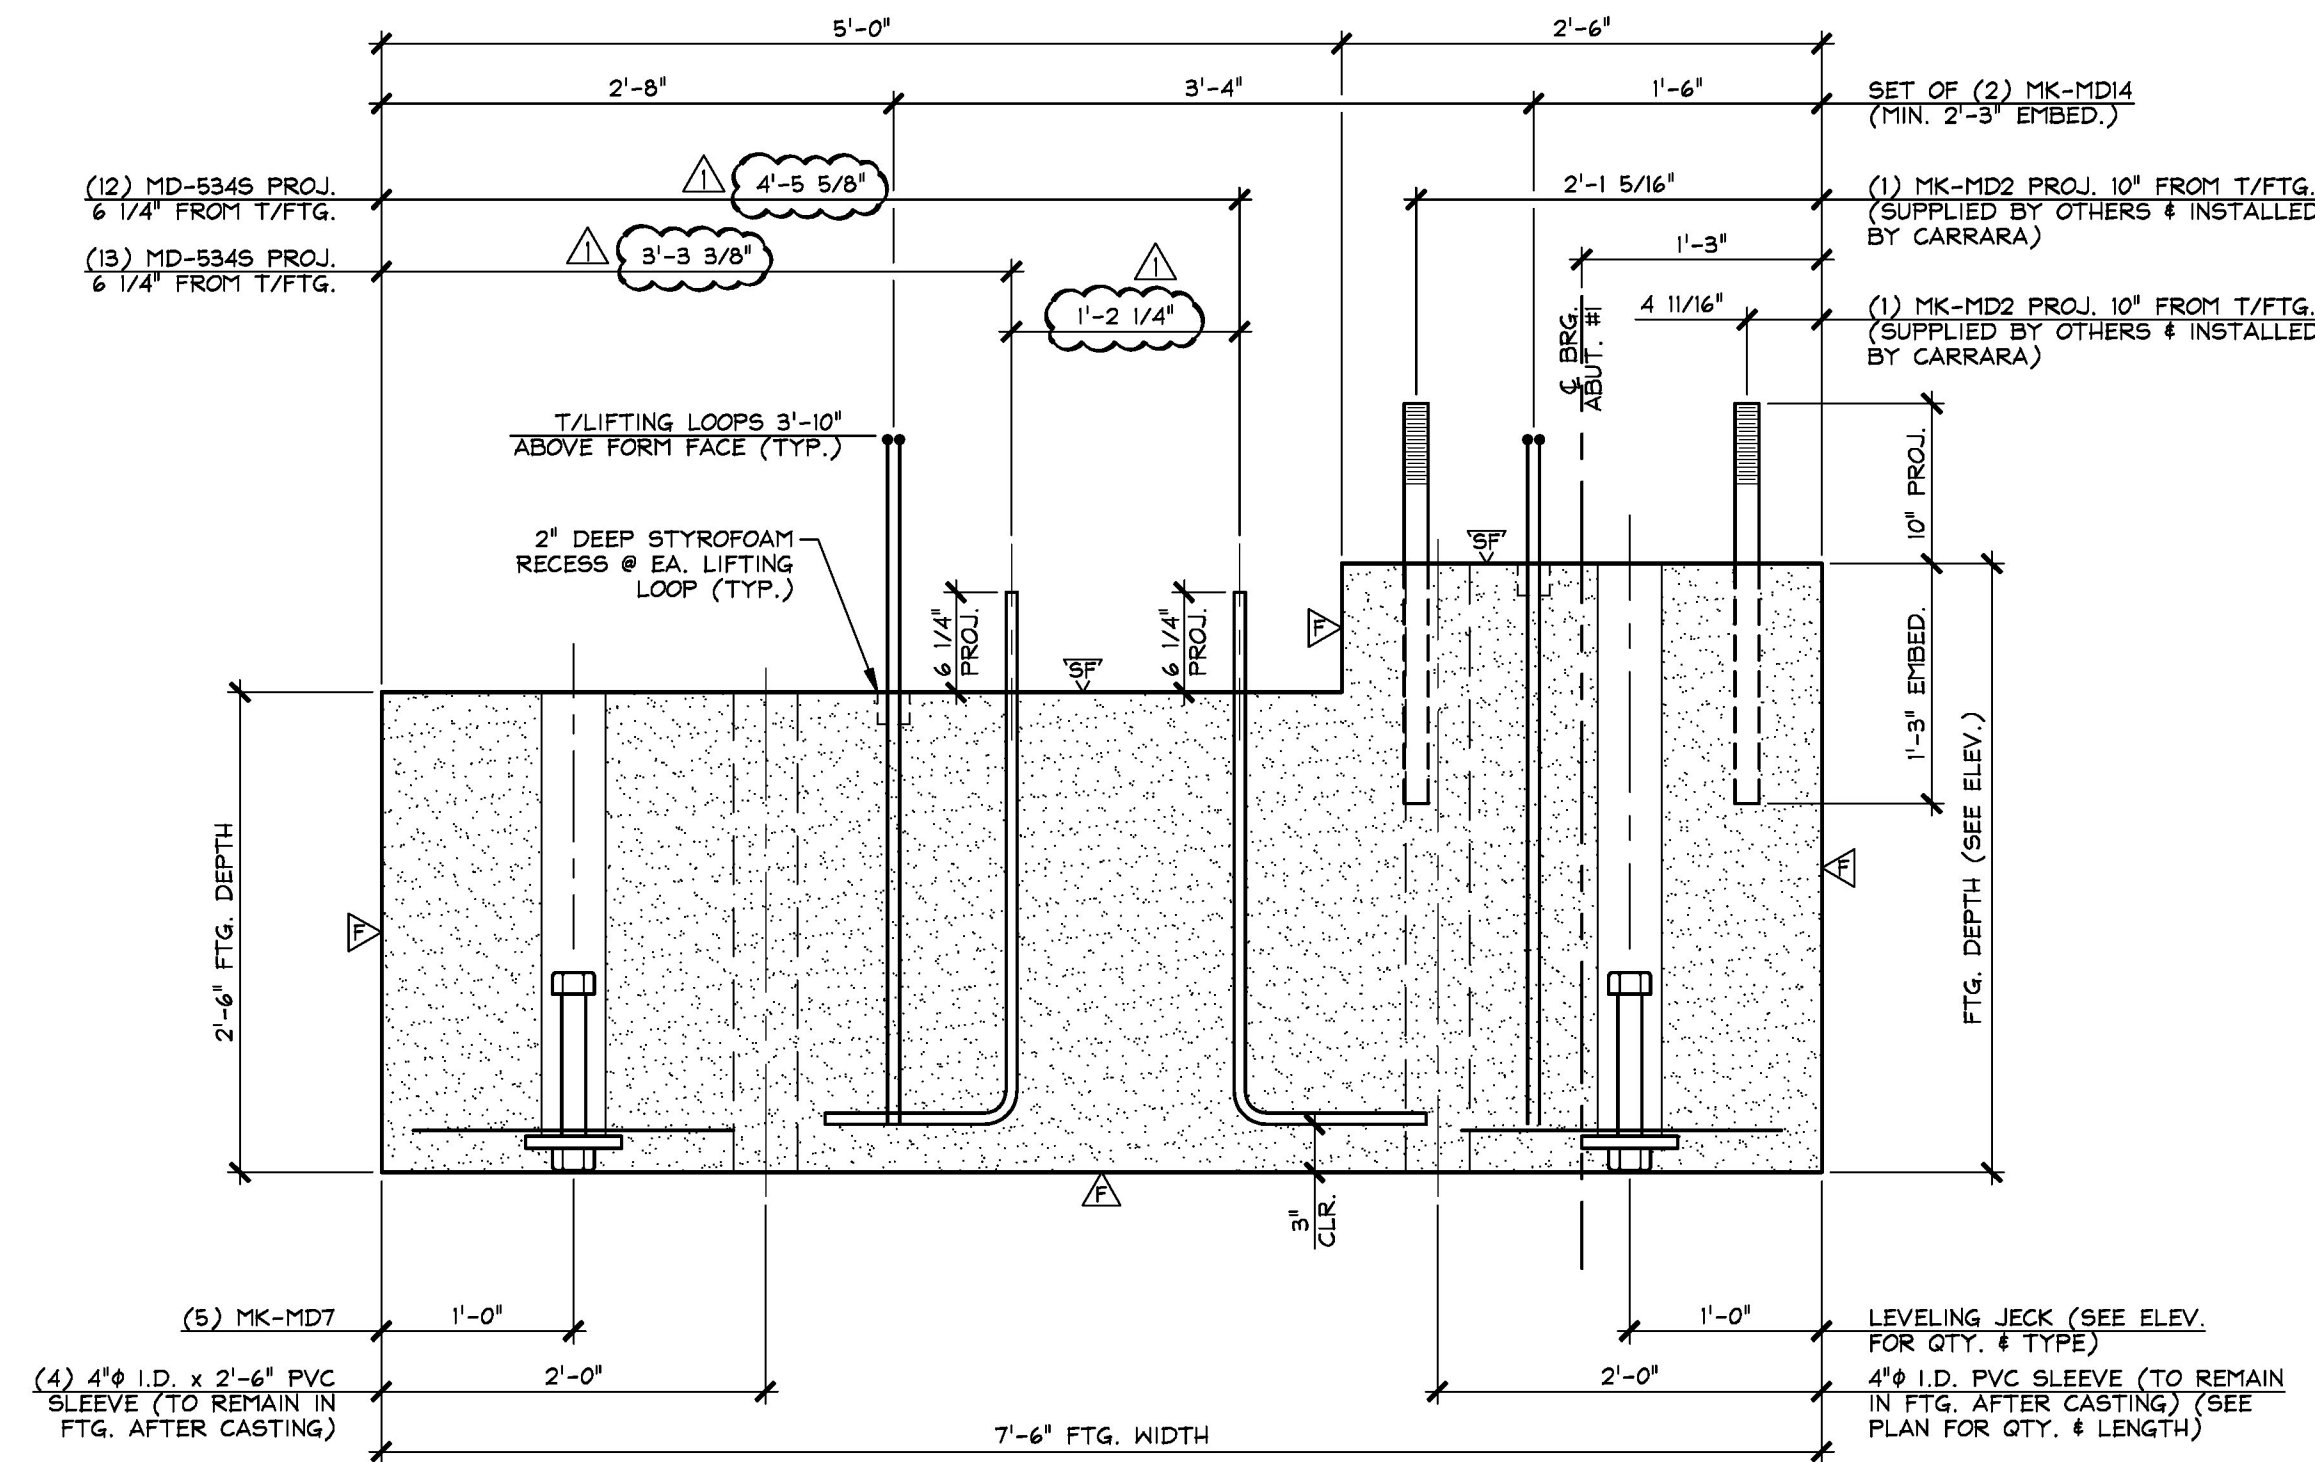

3 DIMENSIONAL SECTION
FGI 1" = 1'-0"

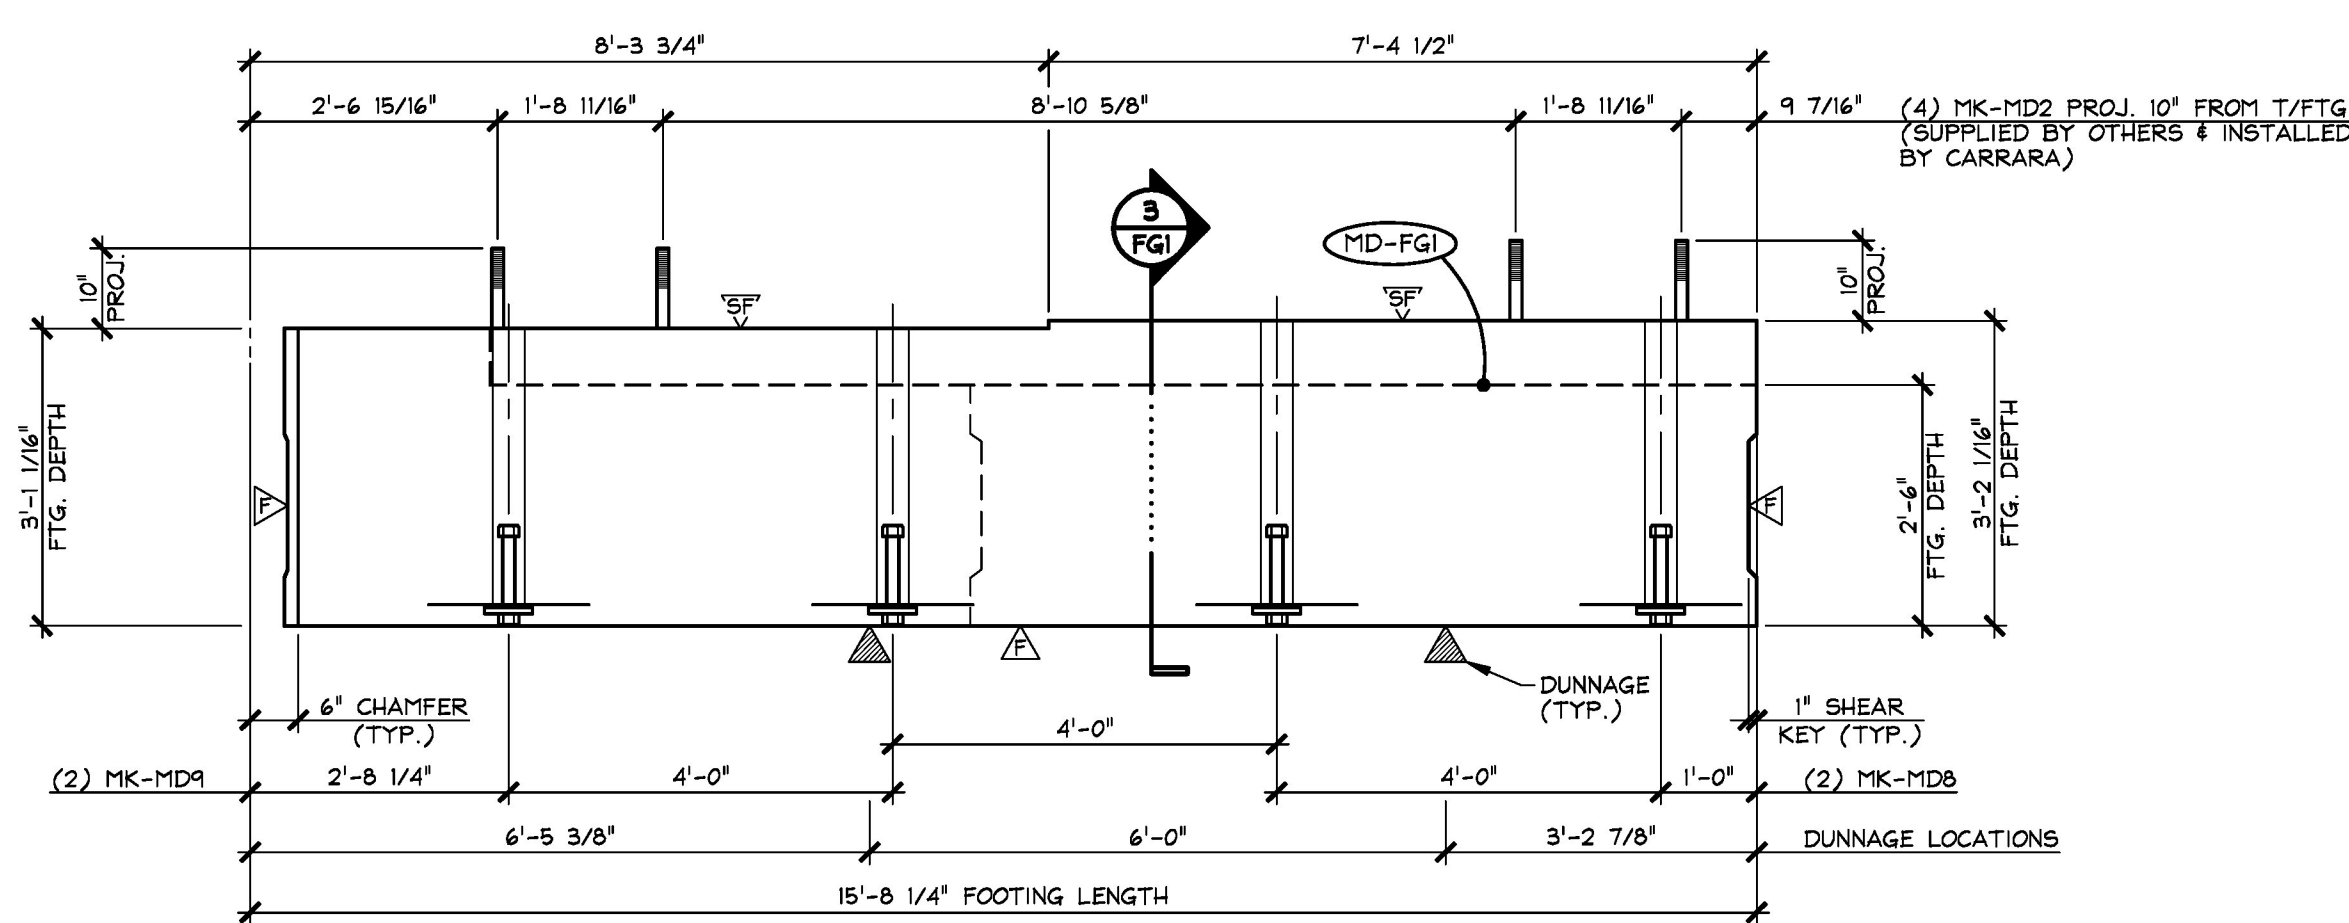

2 DIMENSIONAL ELEVATION
FGI 1/2" = 1'-0"

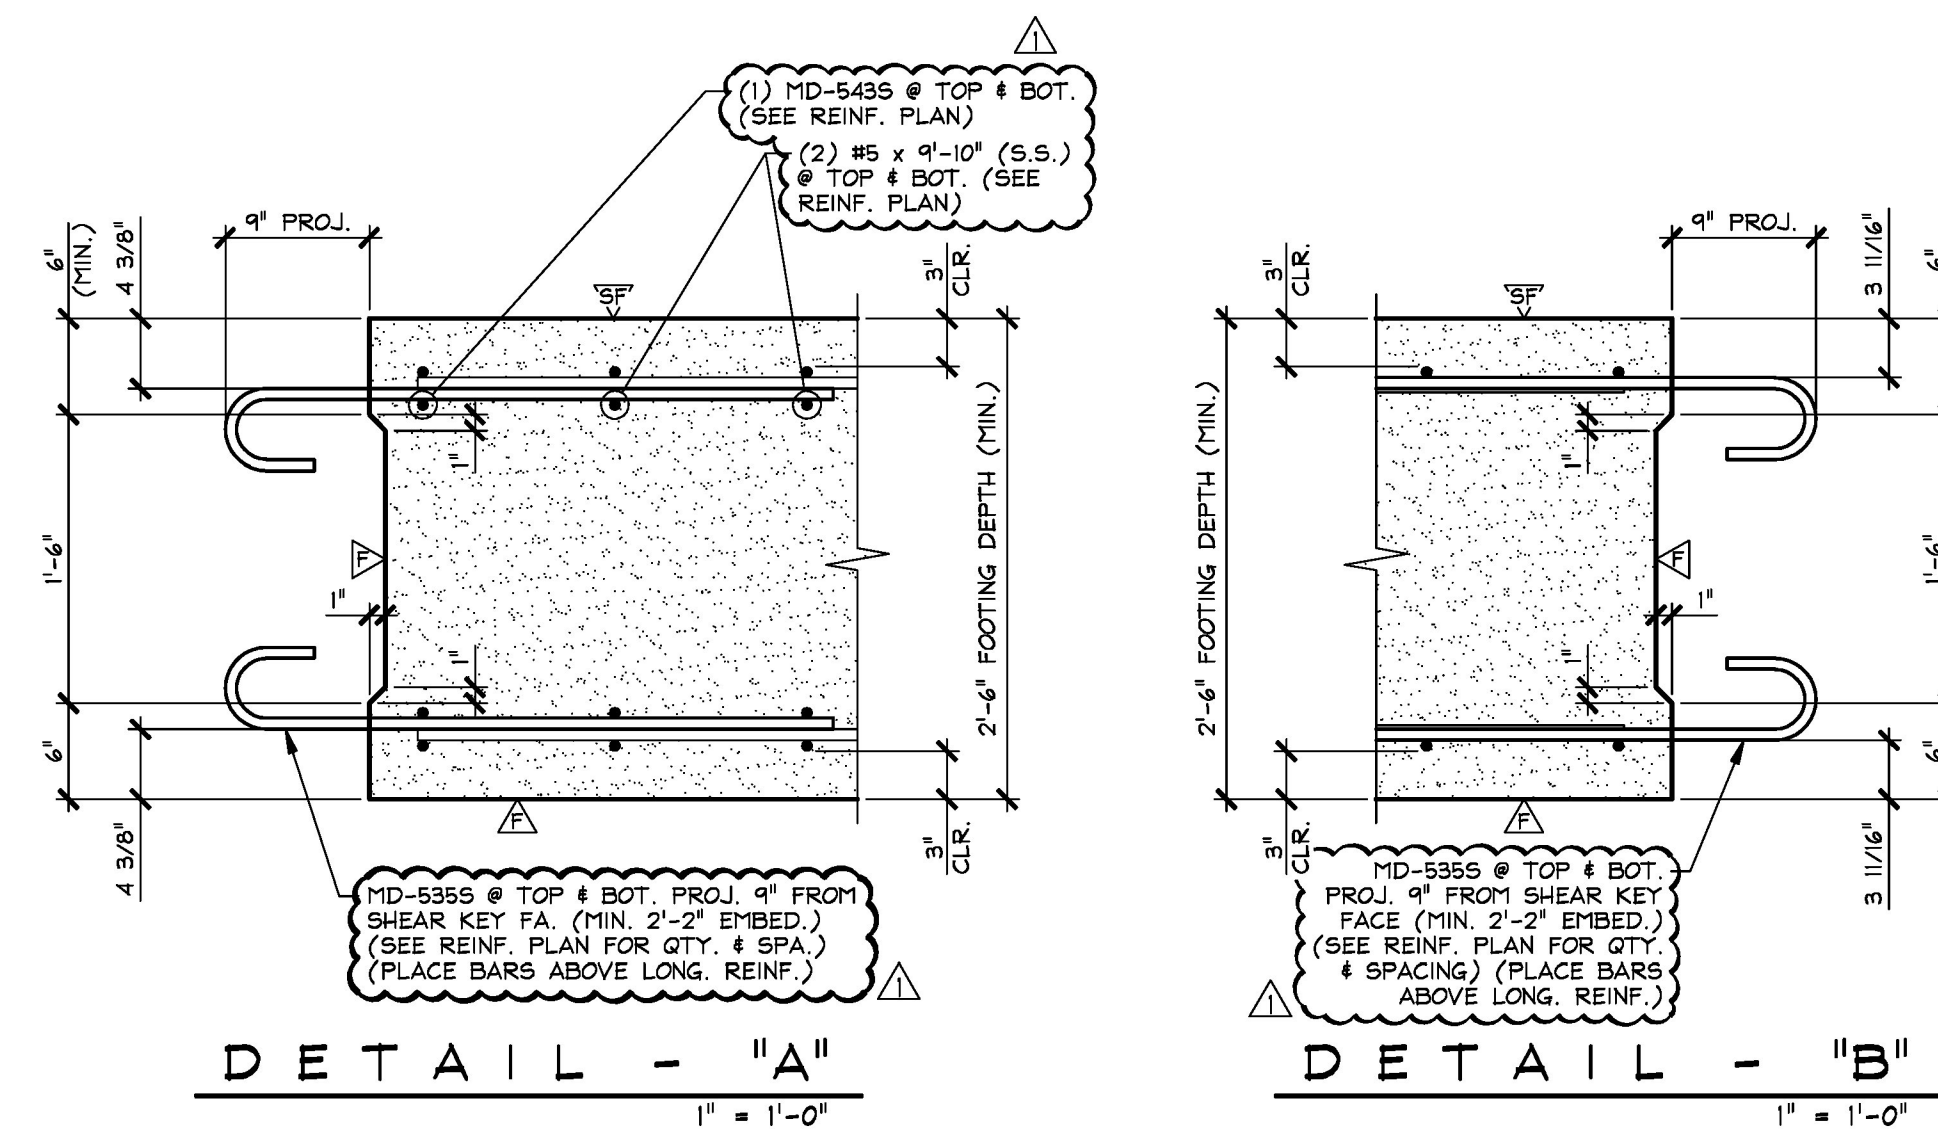

DETAIL - "A"
1" = 1'-0"

DETAIL - "B"
1" = 1'-0"

SHOP NOTE:
SEE DRAWING NO. "FGI.1"
FOOTING REINFORCING

SHOP NOTE:
28-DAY STRENGTH = 7,000 PSI
HANDLING STRENGTH = 5,500 PSI
MIX #426M

△ DENOTES FORM FINISH
⊕ DENOTES SMOOTH FLOAT FINISH

MARK: MD-FGI QTY.: 1 WT.: 17.92 T VOL.: 8.85 cy			
MATERIAL LIST / FOOTING			
ITEM	MARK	DESCRIPTION	QTY.
1	MD-5345	#5 BENT BAR (STAINLESS STEEL)	25
2			
3			
4	MK-MD2	1 1/2" x 2'-1" SHEDGE HANCHOR BOLT W/ 5' THREADS (GALV.)	4
5	MK-MD7	LEVELING JACK ASSEMBLY	3
6	MK-MD8	LEVELING JACK ASSEMBLY	2
7	MK-MD9	LEVELING JACK ASSEMBLY	2
8	MK-MD14	SET OF (2) 1/2" STRAND LIFTING LOOPS	4
9		4" I.C. x 2'-6" PVC SLEEVE	4
10		4" I.C. x 3'-1" PVC SLEEVE	2
11		4" I.C. x 3'-2" PVC SLEEVE	2
12			
13			
14			
15			

△ 5-10-16 REVISED AS NOTED

Approved _____ X Approved As Noted _____
Rejected _____

Vermont Agency of Transportation
RECEIVED
ON: **May 10, 2016**
and Checked for
CONFORMANCE
BY: Rob Young DATE: 05/16/2016

Date: 5/13/2016
By: D. Kull

APPROVAL STAMP:

J.P. CARRARA & SONS INC.
Precast & Prestress Manufacturer
2864 OSE STR., MIDDLEBURY, VERMONT 05753 Phone: (802)388-6361 Fax: (802)388-9010

A.L. ST. ONGE CONTRACTOR, INC.
CONTRACTOR
MONTGOMERY, VERMONT

STATE OF VERMONT AGENCY OF TRANSPORTATION
COUNTY OF WINDSOR

DATE: JAN. 12, 2016
SCALE: NOTED
CHKD: - DFTM: B.L.
JOB NO: 23480-016

TOWN OF WAITSFIELD
VT ROUTE 100 (MINOR ARTERIAL)
BRIDGE NO.: 177 PROJECT NO.: BRP 013-4(39)

PRECAST FOOTING
DIMENSIONAL DETAILS

DWG. NO: **FGI**