




4 DIMENSIONAL ELEVATION
 PCI.1 MARK FACE 1/2" = 1'-0"

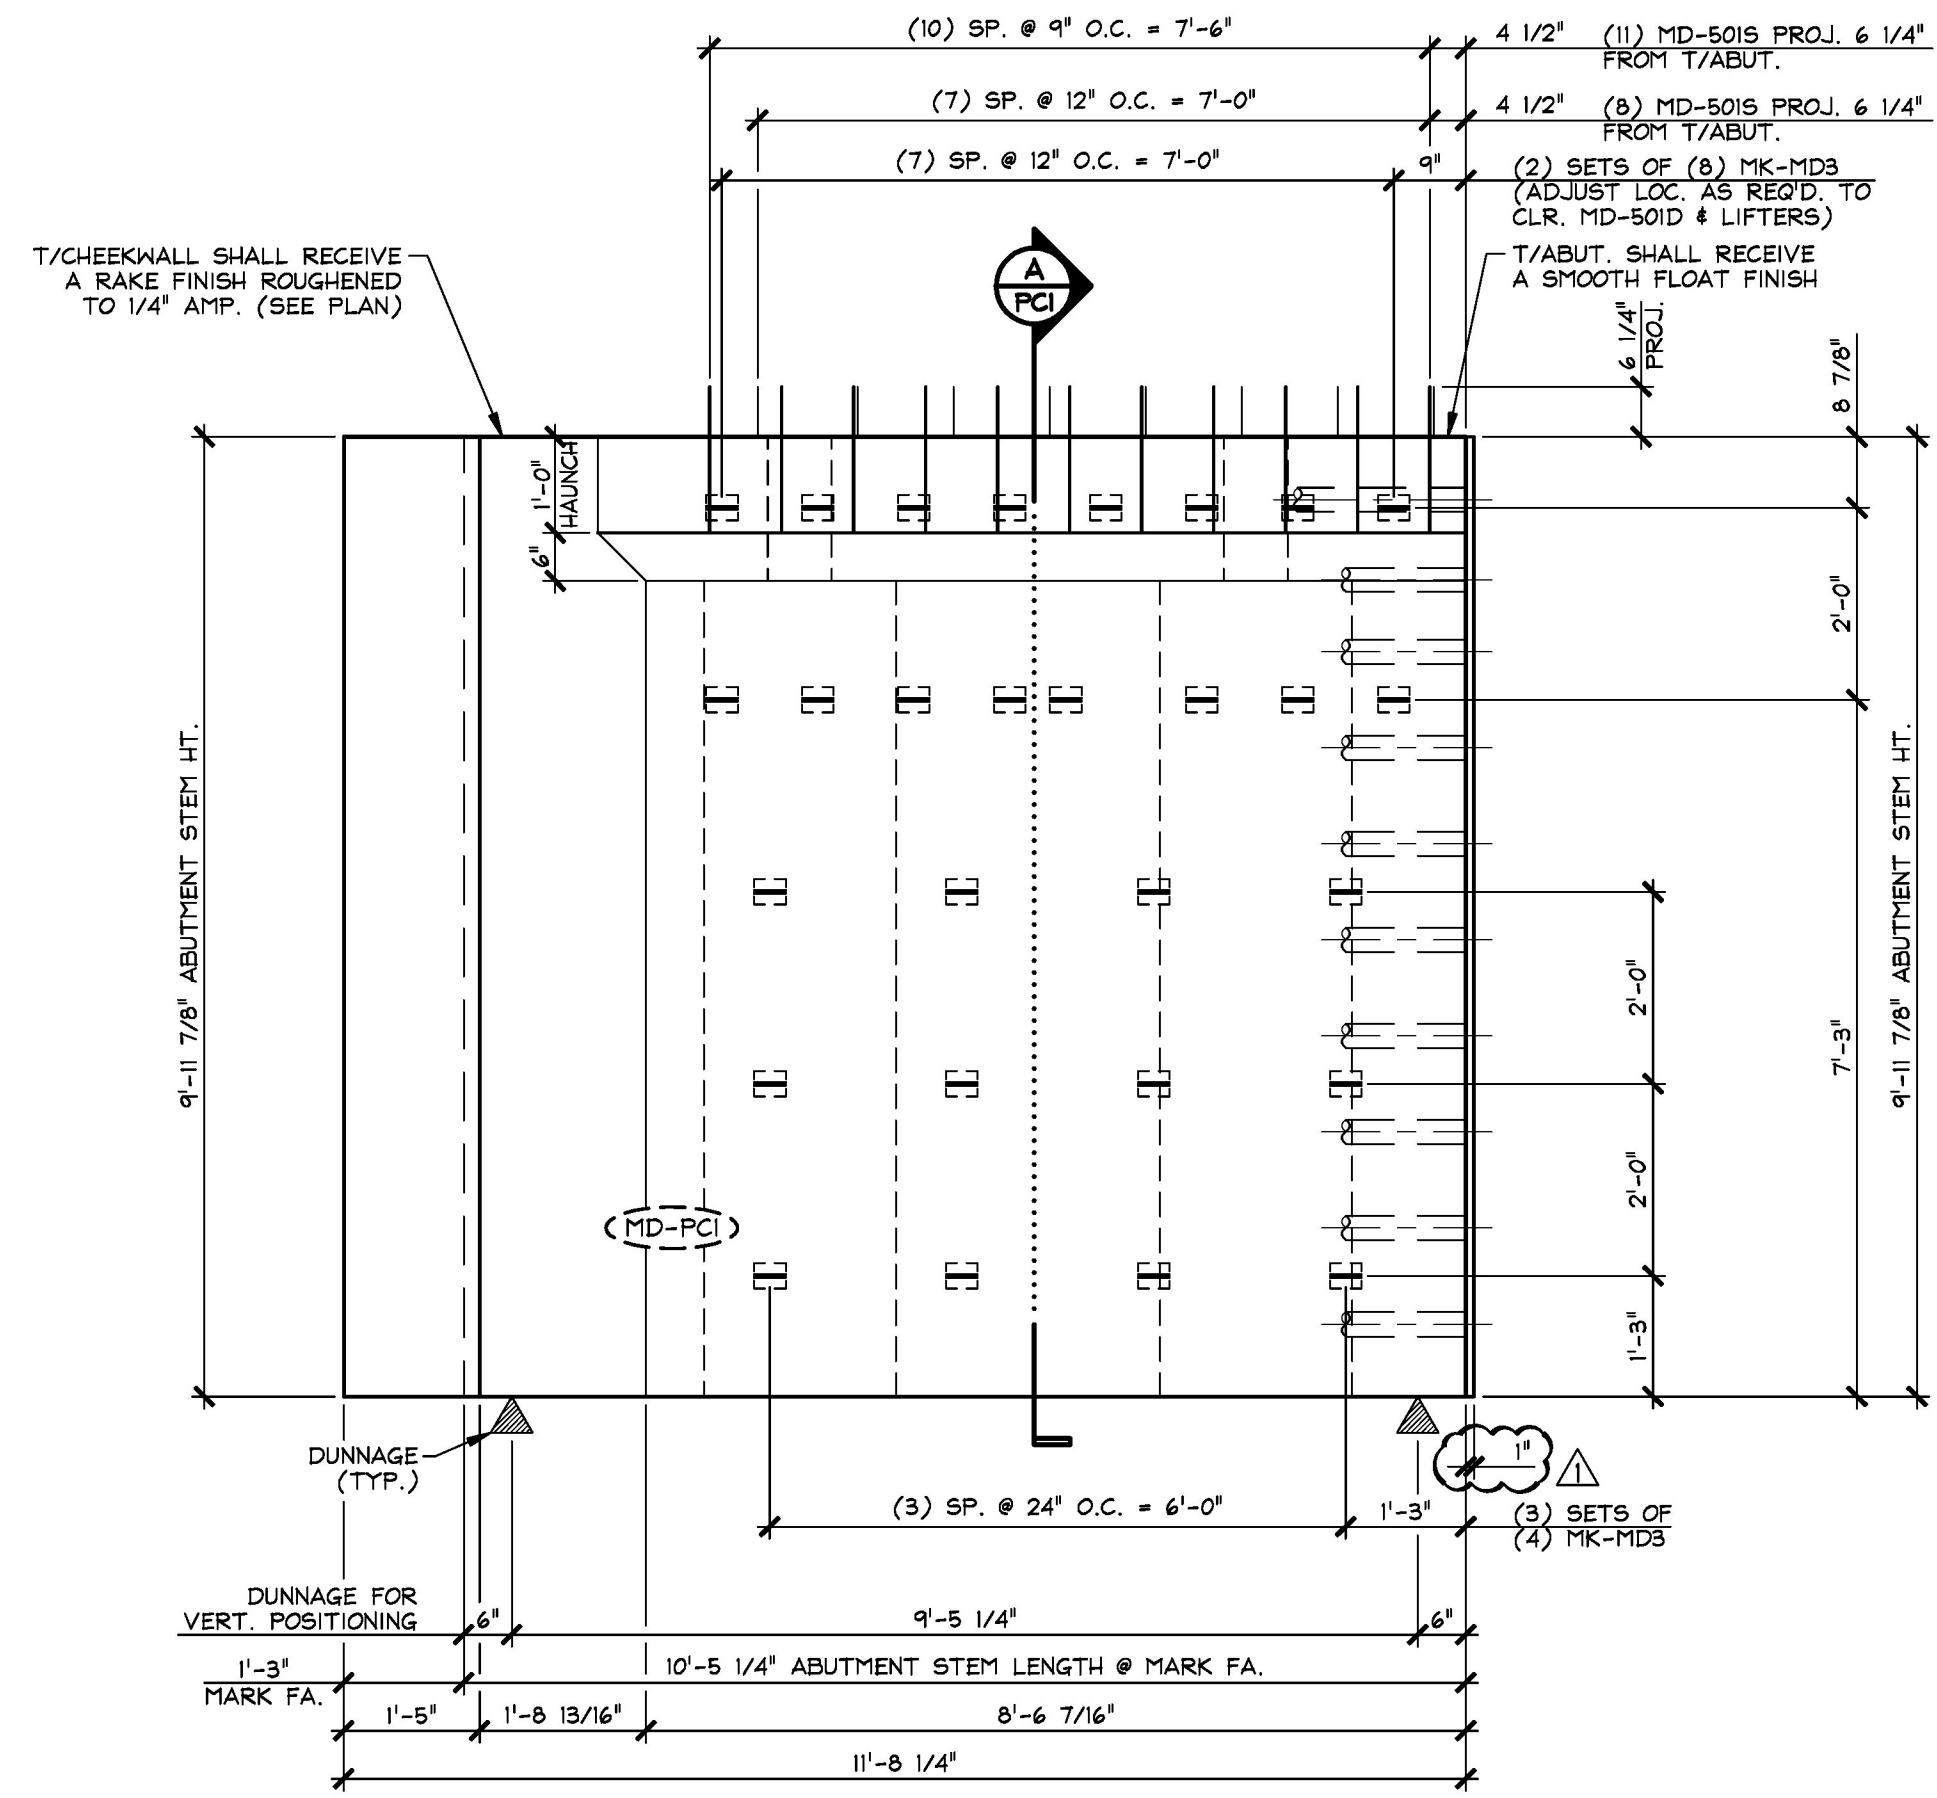

5 DIMENSIONAL ELEVATION
 PCI.1 NON-MARK FACE 1/2" = 1'-0"

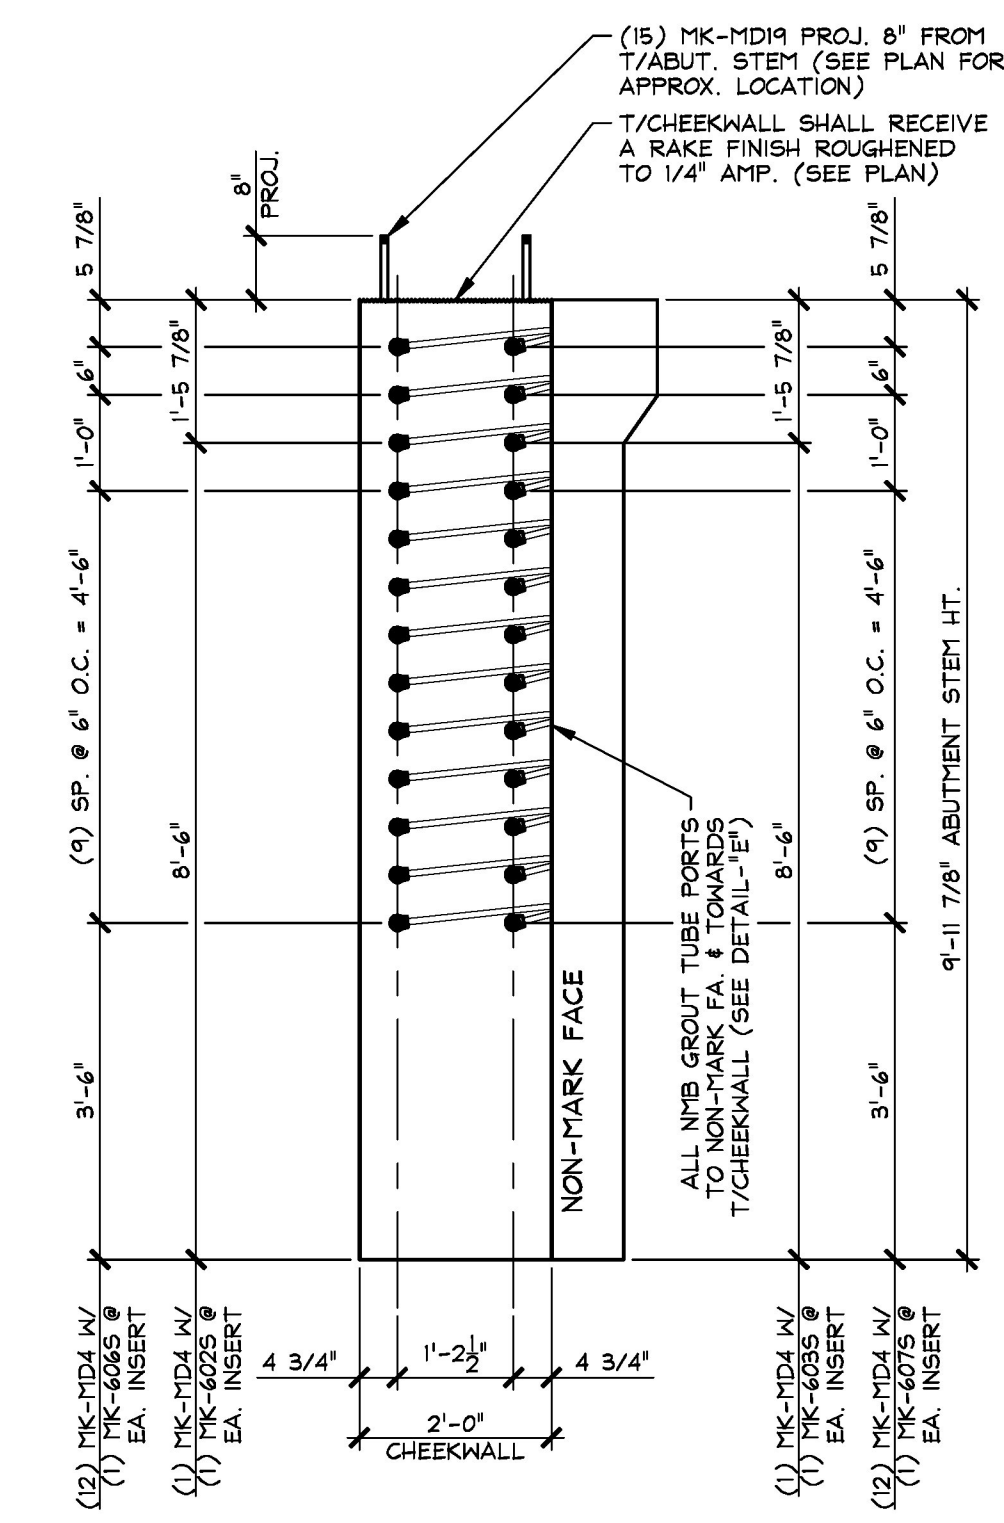

6 CHEEKWALL ELEVATION
 PCI.1 1/2" = 1'-0"

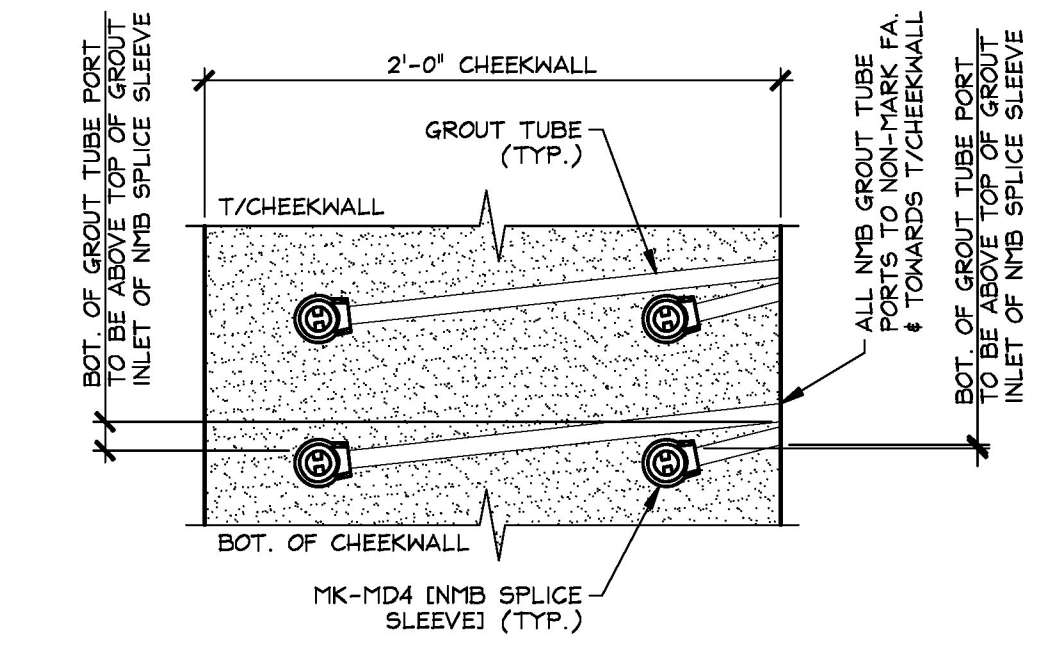

DETAIL - "E"
 1/2" = 1'-0"

5-10-16 REVISED AS NOTED AND OMIT PRECAST CHEEKWALL

Approved	<input checked="" type="checkbox"/> Approved As Noted
Rejected	<input type="checkbox"/>

This review is only for general conformance with the design concept and the information given in the Construction Documents. Corrections or comments made on the shop drawings during the review do not relieve the Contractor from compliance with the requirements of the Plans and Specifications. Review of a specific item shall not include review of an assembly of which an item is a component. The Contractor is responsible for dimensions to be confirmed and corrected at the job site; information that pertains solely to the fabrication process or to the means, methods, techniques, sequences and procedures of construction; coordination of the Work with that of other trades and performing all Work in a safe and satisfactory manner.

Date: 5/13/2016
 By: D. Kull

Vermont Agency of Transportation
RECEIVED
 ON: May 10, 2016
 and Checked for
CONFORMANCE
 BY: Rob Young DATE: 05/18/2016

APPROVAL STAMP:	J.P. CARRARA & SONS INC. Precast & Prestress Manufacturer 2464 CASE STR., MIDDLEBURY, VERMONT 05753 Phone: (802)388-6361 Fax: (802)388-9010	A.L. ST. ONGE CONTRACTOR, INC. CONTRACTOR MONTGOMERY, VERMONT
	STATE OF VERMONT AGENCY OF TRANSPORTATION COUNTY OF WINDSOR	
	TOWN OF WAITSFIELD VT ROUTE 100 (MINOR ARTERIAL) BRIDGE NO.: 177 PROJECT NO.: BRP 013-4(39)	
	PRECAST ABUTMENT STEM DIMENSIONAL ELEVATIONS	
	DATE: JAN. 12, 2016	SCALE: NOTED
	CHKD: -	DFTM: B.L.
	JOB NO: 23480-016	DWG. NO: PC1.1