




**A DIMENSIONAL SECTION**  
PC2  
3/4" = 1'-0"

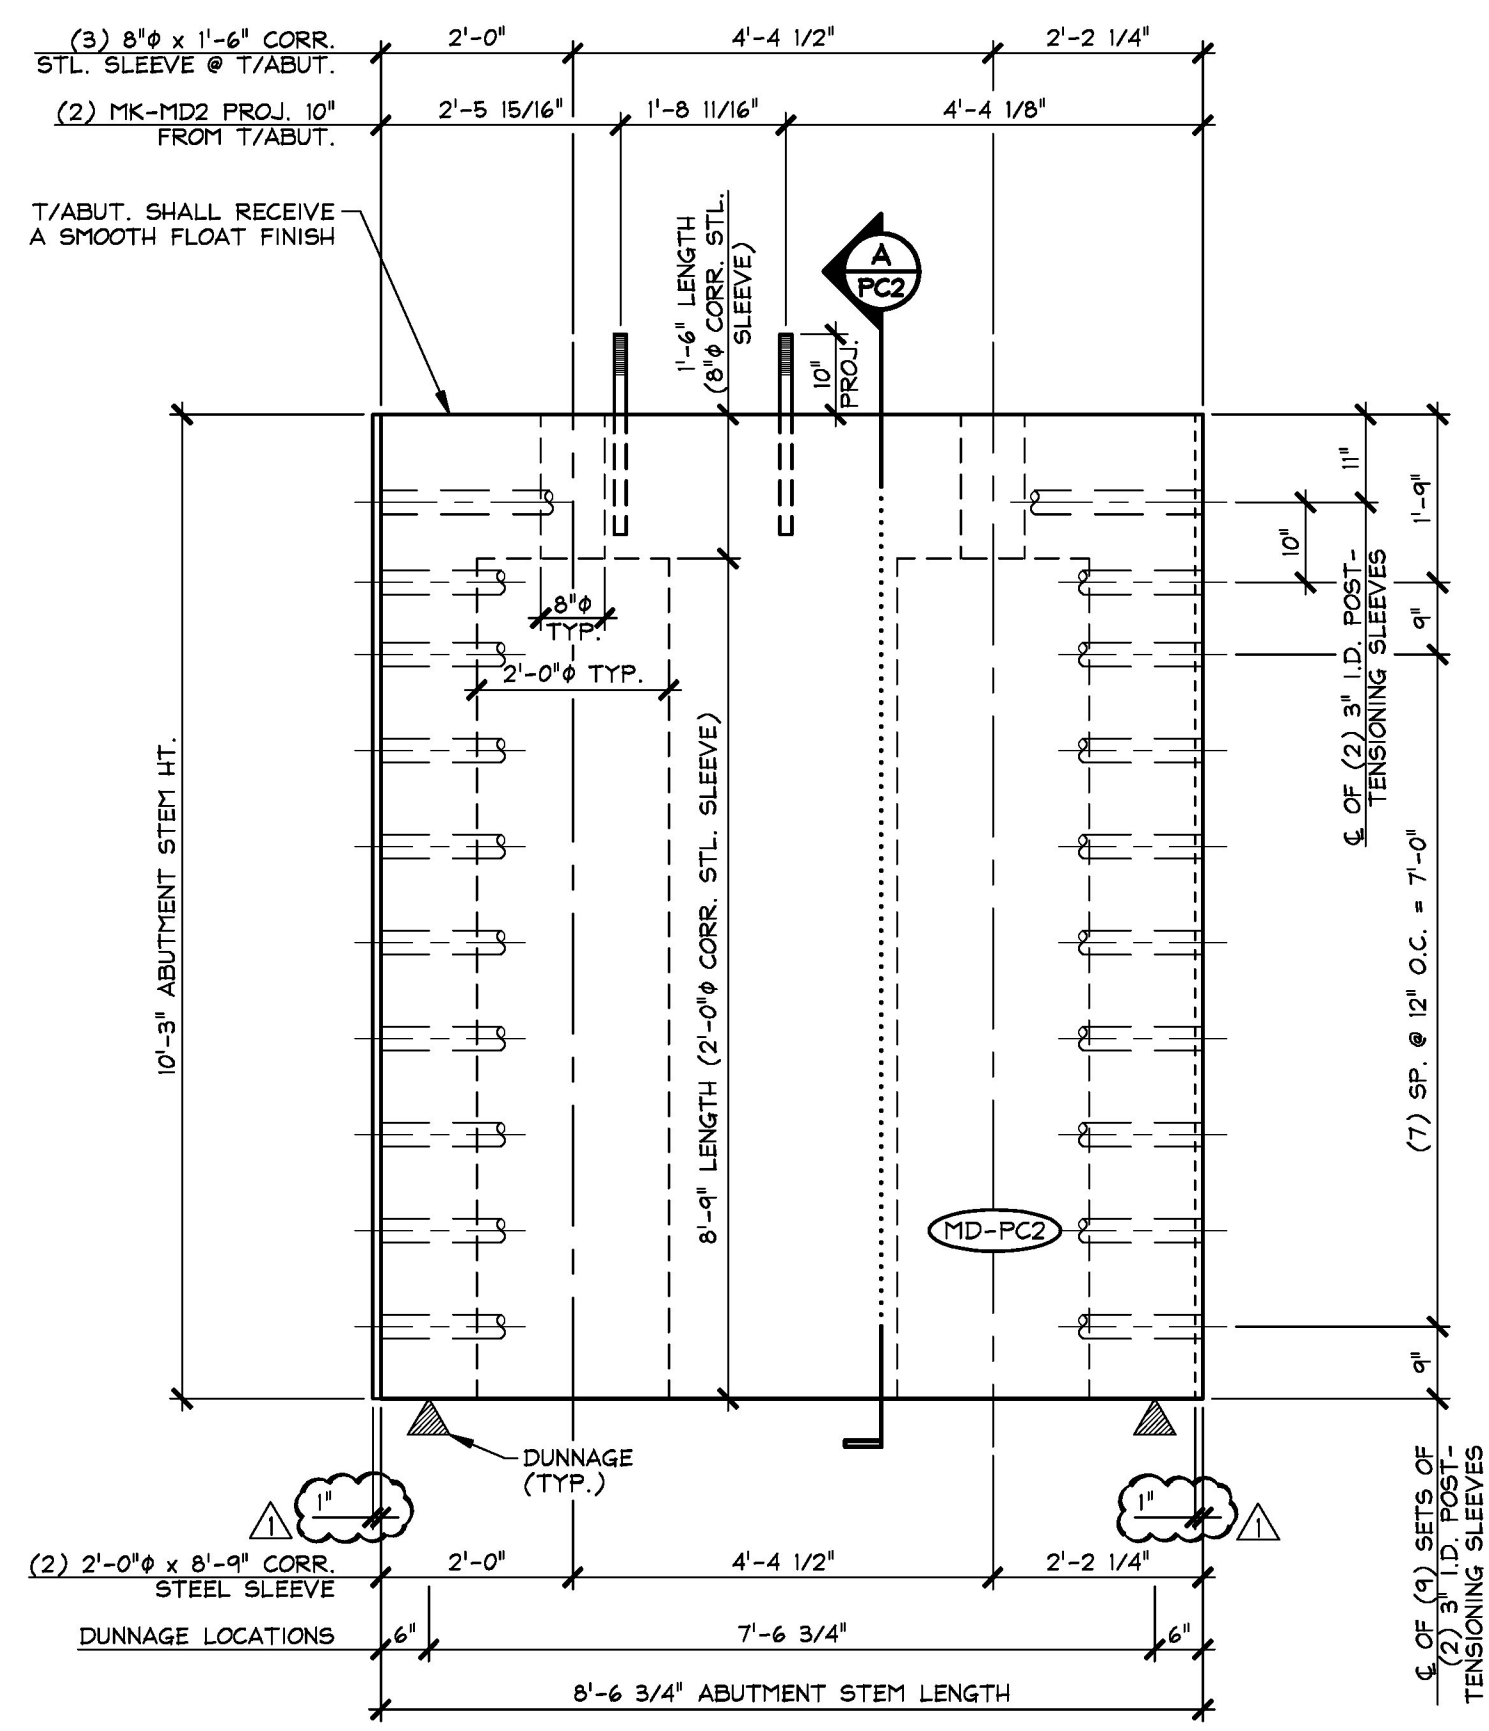

**1 DIMENSIONAL ELEVATION**  
PC2 MARK FACE  
1/2" = 1'-0"

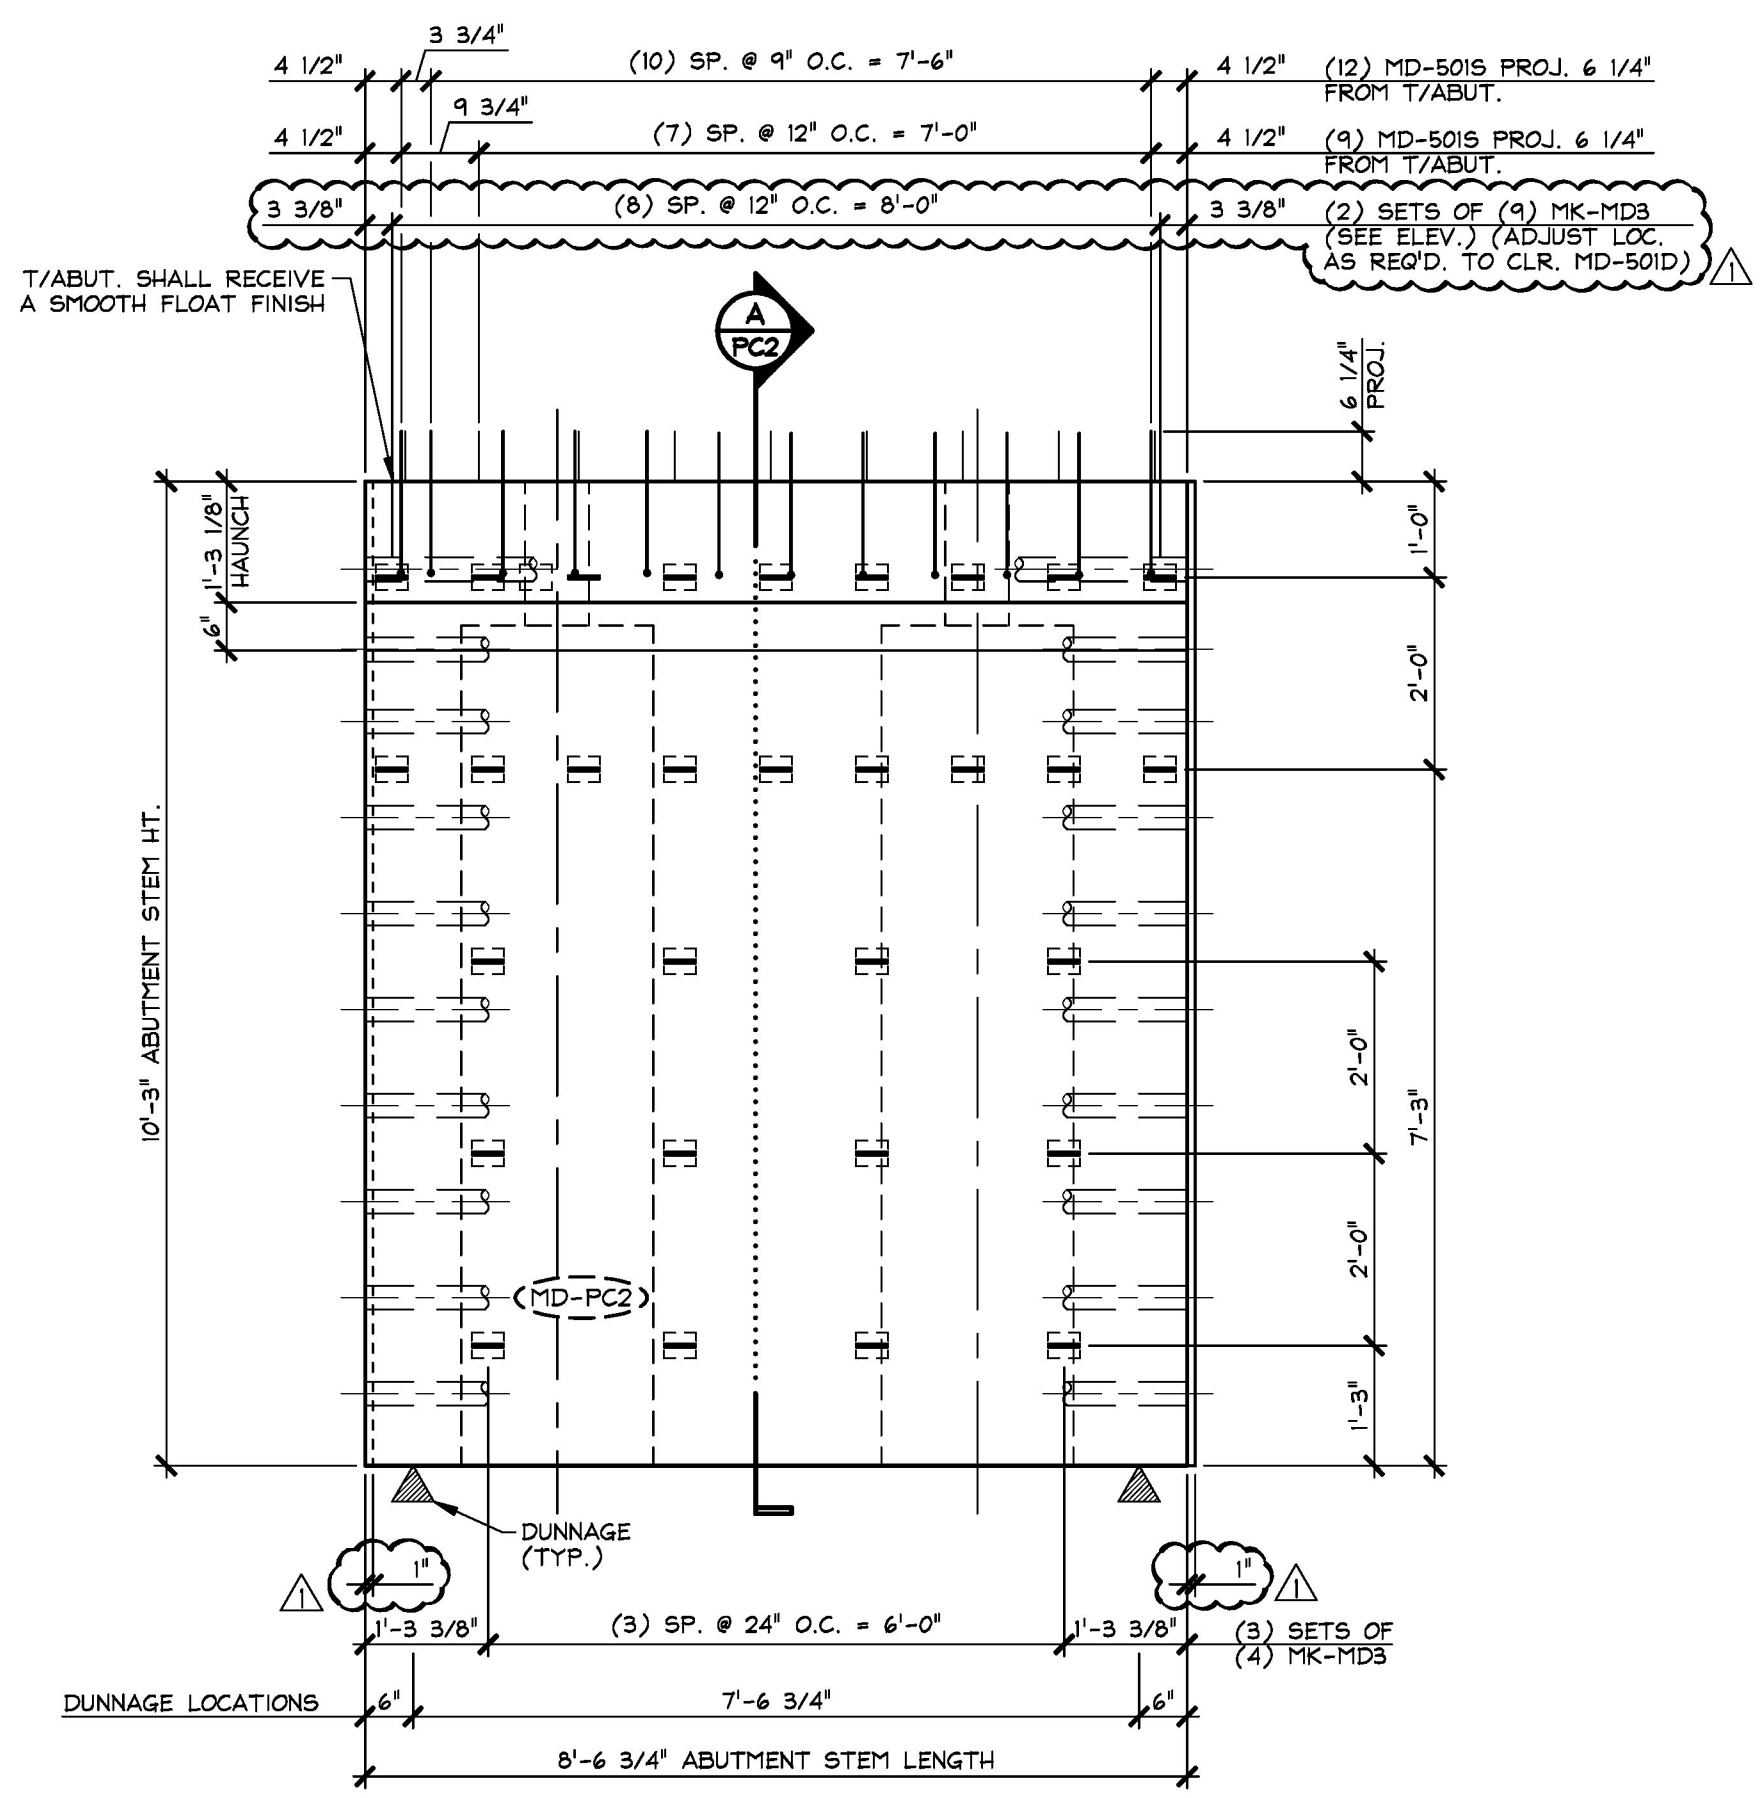

**2 DIMENSIONAL ELEVATION**  
PC2 NON-MARK FACE  
1/2" = 1'-0"

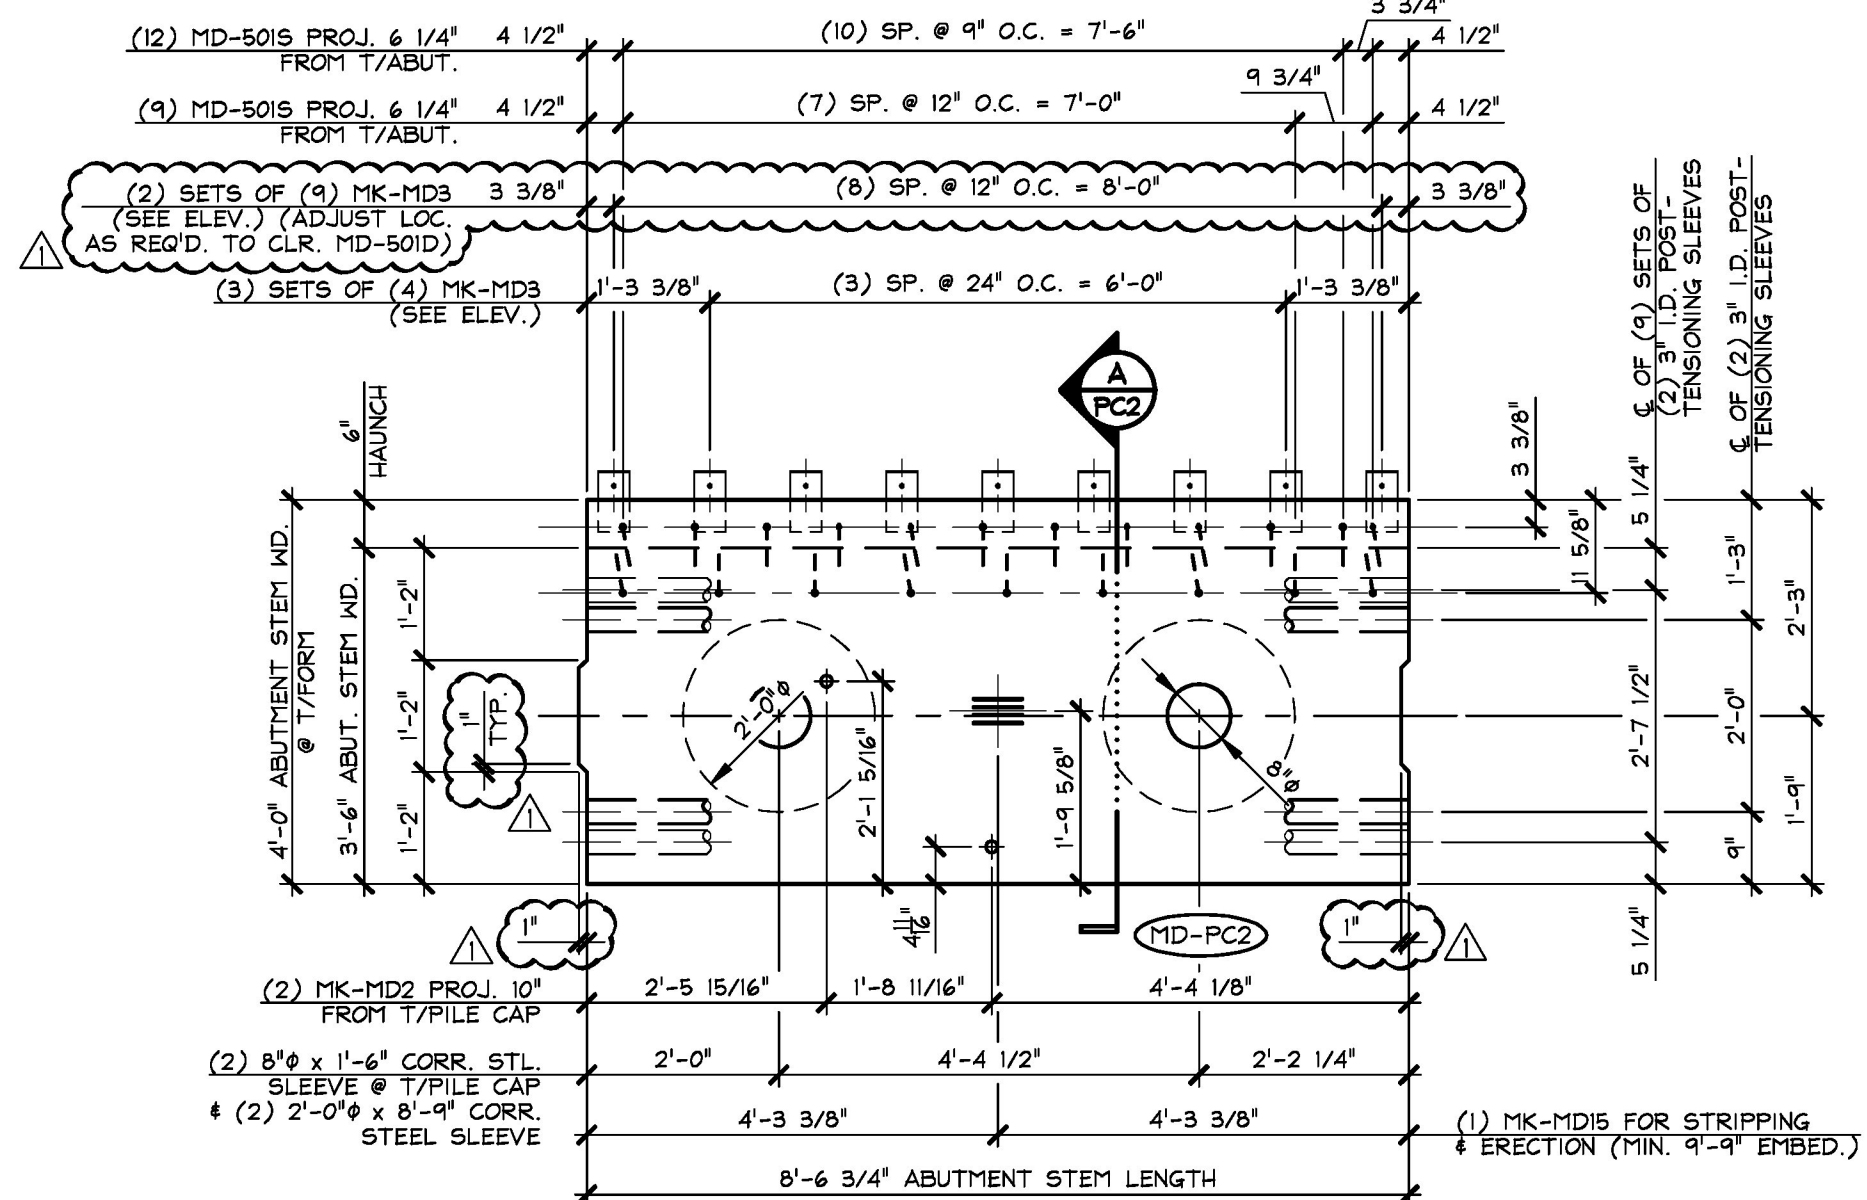

**3 DIMENSIONAL PLAN VIEW IN FORM**  
PC2  
1/2" = 1'-0"

**SHOP NOTE:**  
SEE DRAWING NO. PC2.1 FOR ABUTMENT REINFORCING

**SHOP NOTE:**  
28-DAY STRENGTH = 5,000 PSI  
HANDLING STRENGTH = 3,500 PSI  
MIX #445MSCC

Vermont Agency of Transportation  
**RECEIVED**  
ON: May 10, 2016  
and Checked for  
**CONFORMANCE**  
BY: Rob Young DATE: 05/16/2016

Approved	<input checked="" type="checkbox"/> Approved As Noted
Rejected	<input type="checkbox"/>

This review is only for general conformance with the design concept and the information given in the Construction Documents. Corrections or comments made on the shop drawings during the review do not relieve the Contractor from compliance with the requirements of the Plans and Specifications. Review of a specific item shall not include review of an assembly of which an item is a component. The Contractor is responsible for dimensions to be confirmed and corrected at the job site; information that pertains solely to the fabrication process or to the means, methods, techniques, sequences and procedures of construction; coordination of the Work with that of other trades and performing all Work in a safe and satisfactory manner.

Date: 5/13/2016  
By: D. Kull

MATERIAL LIST / ABUTMENT			
ITEM	MARK	DESCRIPTION	QTY.
1	MD-5015	#5 BENT BAR (STAINLESS STEEL)	21
2			
3			
4			
5			
6			
7		8" x 1'-6" CORRUGATED STEEL SLEEVE (GALV.)	2
8		2'-0" x 8'-9" CORRUGATED STEEL SLEEVE (GALV.)	2
9	MK-MD2	1 1/2" x 2'-1" SHEDGE HANCHOR BOLT W/ 5' THREADS (GALV.)	2
10	MK-MD3	SOIL REINFORCING CONNECTION CLIP (HIGH ADHERENCE RIBBED STEEL REINFORCING STRIP) (GALV.)	30
11	MK-MD5	SET OF (4) 0.60" STRAND LIFTING LOOPS	1
12			
13			
14			
15			

APPROVAL STAMP:	<b>J.P. CARRARA &amp; SONS INC.</b> Precast & Prestress Manufacturer 2464 CASE STR., MIDDLEBURY, VERMONT 05753 Phone: (802)388-6361 Fax: (802)388-9010	<b>A.L. ST. ONGE CONTRACTOR, INC.</b> CONTRACTOR MONTGOMERY, VERMONT
	STATE OF VERMONT AGENCY OF TRANSPORTATION COUNTY OF WINDSOR	
	TOWN OF WAITSFIELD VT ROUTE 100 (MINOR ARTERIAL) BRIDGE NO.: 177 PROJECT NO.: BRP 013-4(39)	
	PRECAST ABUTMENT STEM DIMENSIONAL DETAILS	
	DATE: JAN. 12, 2016	
	SCALE: NOTED	
	CHKD: - DFTM: B.L.	
	JOB NO: 23480-016	
	DWG. NO: PC2	