
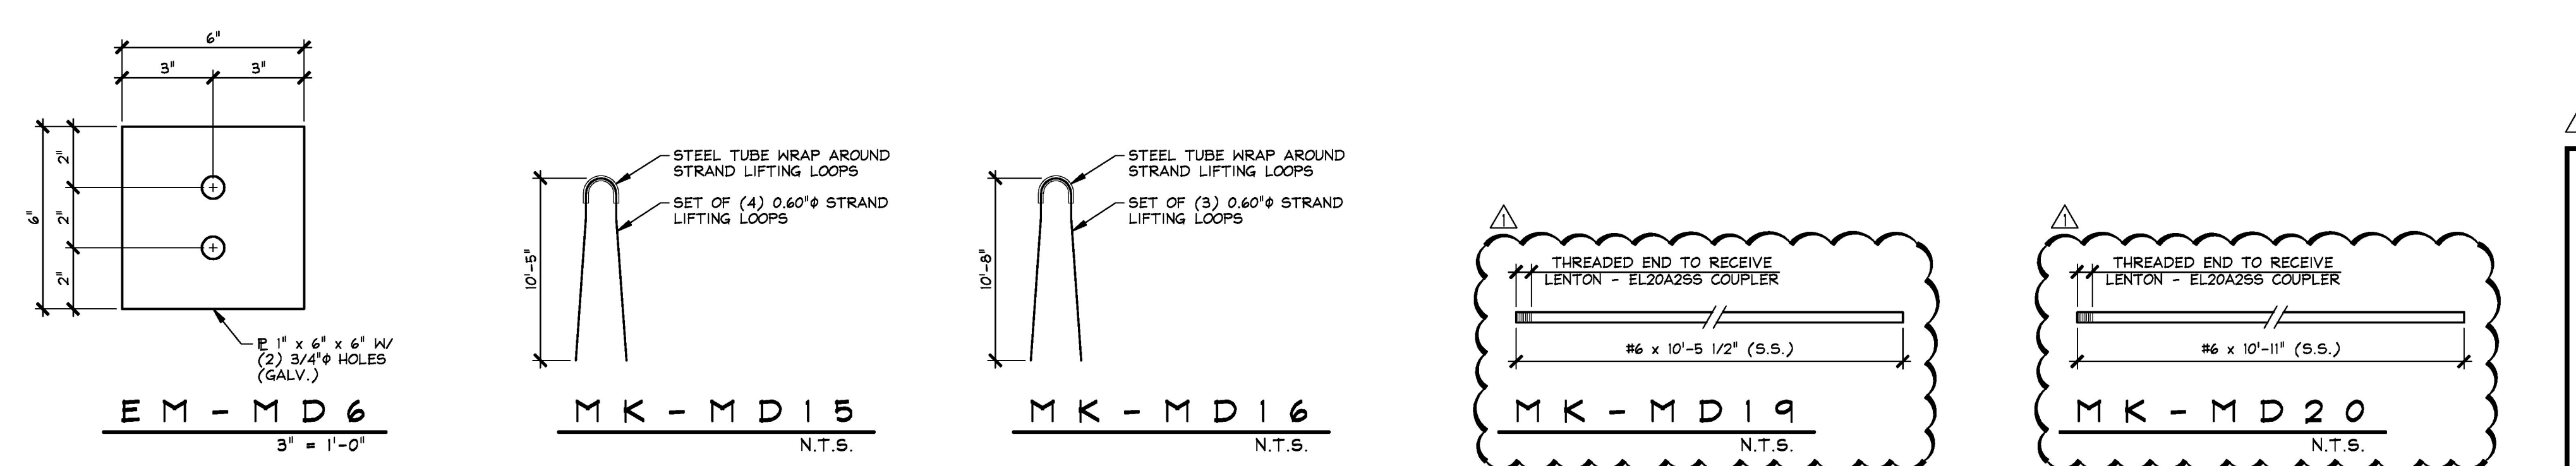


MISCELLANEOUS EMBEDDED MATERIALS

ITEM	MARK	QTY.	DESCRIPTION	REMARKS
1	EM-MD6	40	1" x 6" x 6" W/ (2) 3/4" HOLES (GALV.)	FOR ERECTION; SEE DETAIL THIS SHEET
2		40	1/2" x 270 KSI (LOW LAX) x 52'-3" LONG POLY-STRAND	FOR ERECTION
3		80	1/2" SINGLE USE STRESSING CHUCK	FOR ERECTION
4				
5				
6	MK-MD2	10	1 1/2" x 2'-1" SWEDGE HANCHOR BOLT W/ 5" THREADS (GALV.)	SUPPLIED BY OTHERS
7	MK-MD3	157	SOIL REINFORCING CONNECTION CLIP (HIGH ADHERENCE RIBBED STEEL REINFORCING STRIP) (GALV.)	SUPPLIED BY OTHERS
8	MK-MD4	54	NMB SPLICE SLEEVE 6U-X(PG) (EPOXY COATED)	INCLUDES (3) FOR TESTING
9	MK-MD5	6	SET OF (4) 0.60" STRAND LIFTING LOOPS	SEE DETAIL THIS SHEET
10	MK-MD6	2	SET OF (4) 0.60" STRAND LIFTING LOOPS	SEE DETAIL THIS SHEET
11	MK-MD7	4	DAYTON 7/8" F-42 LOOP FERRULE INSERT	GALVANIZE
12	MK-MD19	15	#6 x 10'-5 1/2" (S.S.) W/ THREADED END TO RECEIVE COUPLER	SEE DETAIL THIS SHEET
13	MK-MD20	15	#6 x 10'-11" (S.S.) W/ THREADED END TO RECEIVE COUPLER	SEE DETAIL THIS SHEET
14				
15				
16				
17		11	8" x 1'-6" CORRUGATED STEEL SLEEVE	GALVANIZE
18		2	2'-0" x 8'-5 7/8" CORRUGATED STEEL SLEEVE	GALVANIZE
19		2	2'-0" x 8'-9" CORRUGATED STEEL SLEEVE	GALVANIZE
20		3	2'-0" x 9'-0" CORRUGATED STEEL SLEEVE	GALVANIZE
21		4	2'-0" x 8'-11 1/16" CORRUGATED STEEL SLEEVE	GALVANIZE
22				
23		38	#5 x 10'-1" (STAINLESS STEEL)	
24		39	#5 x 8'-2 3/4" (STAINLESS STEEL)	INCLUDES (1) FOR TESTING
25		40	#5 x 12'-5" (STAINLESS STEEL)	
26		40	#5 x 8'-2 3/4" (STAINLESS STEEL)	
27		19	#5 x 8'-10" (STAINLESS STEEL)	
28		19	#5 x 8'-3 1/2" (STAINLESS STEEL)	
29		2	#5 x 7'-9" (STAINLESS STEEL)	
30				
31				
32				
33				
34				
35				
36				INCLUDES (1) FOR TESTING
37				
38				
39				
40				

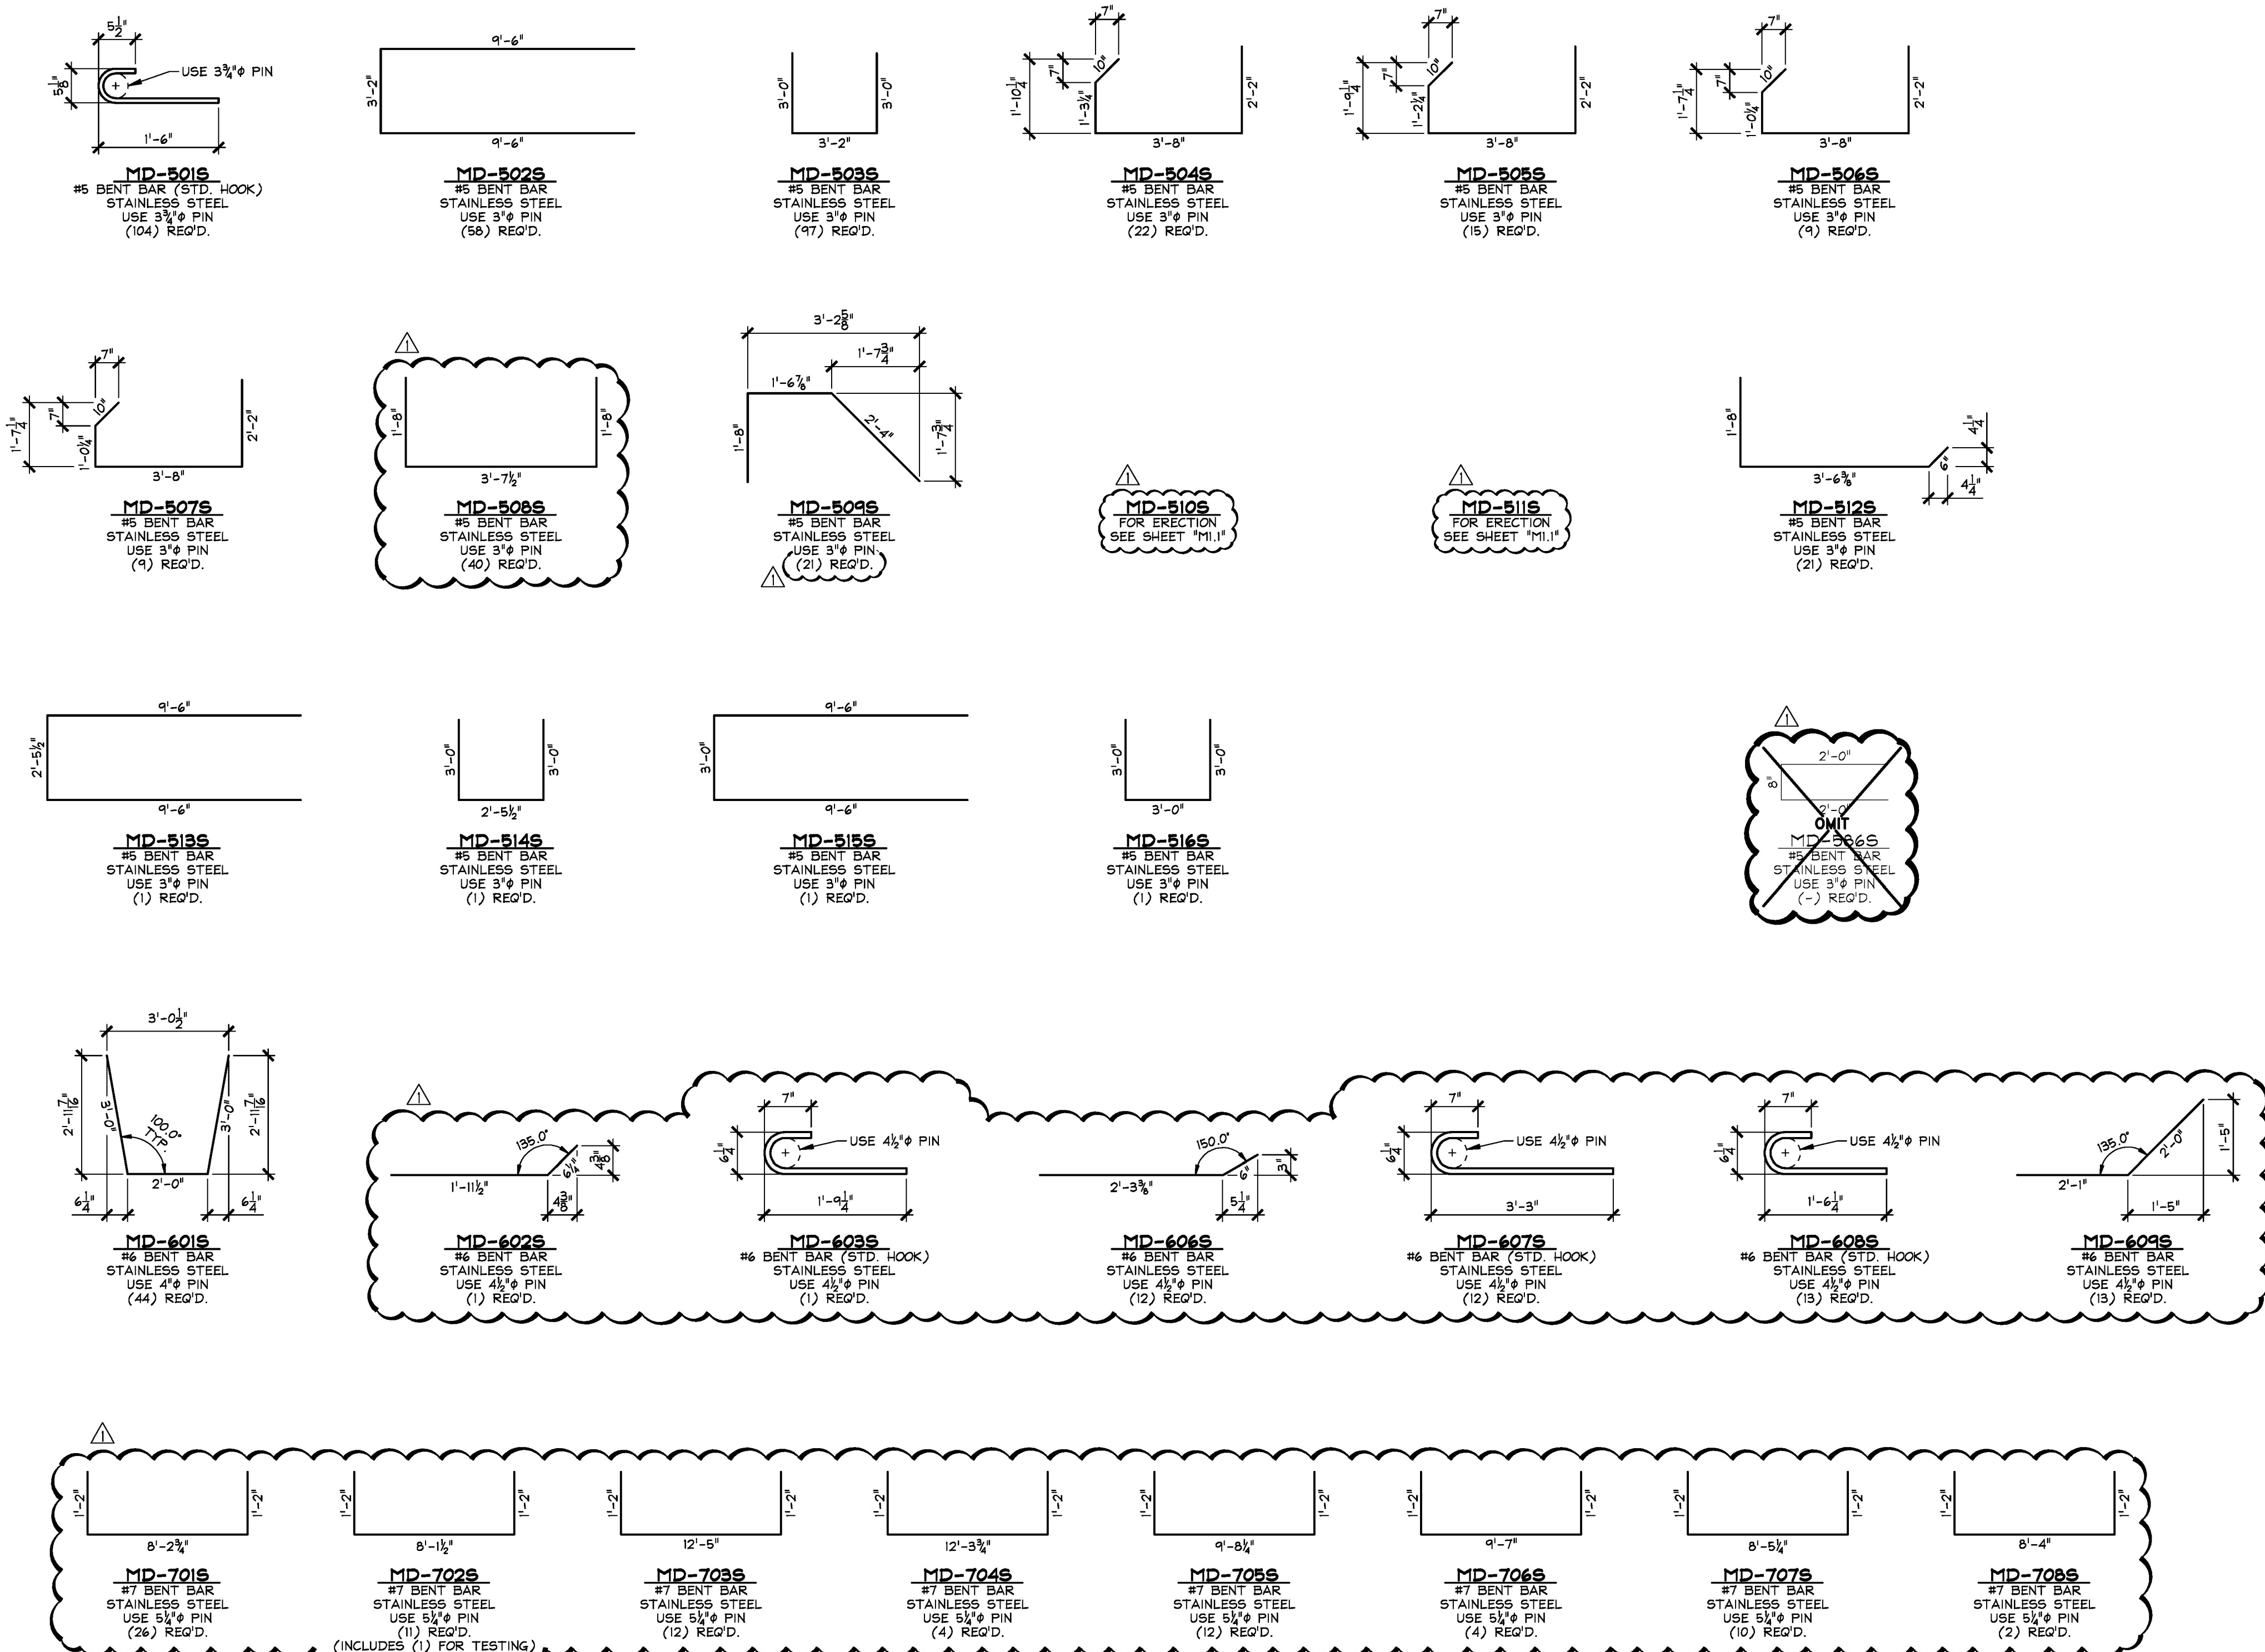

Vermont Agency of Transportation
RECEIVED
 ON: May 10, 2016
 and Checked for
CONFIRMANCE
 BY: Rob Young DATE: 05/16/2016

Approved _____ X Approved As Noted _____
 Rejected _____
 This review is only for general conformance with the design concept and the information given in the Construction Documents. Corrections or comments made on the shop drawings during the review do not relieve the Contractor from compliance with the requirements of the Plans and Specifications. Review of a specific item shall not include review of an assembly of which an item is a component. The Contractor is responsible for dimensions to be confirmed and corrected at the job site; information that pertains solely to the fabrication process or to the means, methods, techniques, sequences and procedures of construction; coordination of the Work with that of other trades and performing all Work in a safe and satisfactory manner.
 Date: 5/13/2016
 By: D. Kull

APPROVAL STAMP: **J.P. CARRARA & SONS INC.** A.L. ST. ONGE CONTRACTOR, INC.
 Precast & Prestress Manufacturer CONTRACTOR
 2484 CASE STR., MIDDLEBURY, VERMONT 05753 Phone: (802)388-6361 Fax: (802)388-8010 MONTGOMERY, VERMONT

STATE OF VERMONT AGENCY OF TRANSPORTATION COUNTY OF WINDSOR DATE: JAN. 12, 2016
 TOWN OF WAITSFIELD VT ROUTE 100 (MINOR ARTERIAL) SCALE: NOTED
 BRIDGE NO.: 177 PROJECT NO.: BRP 013-4(39) CHKD: - DFTM: B.L.
 PRECAST ABUTMENT STEMS EMBEDDED MATERIALS LIST JOB NO: 23480-016
 DWG. NO: M1