




MD-5255
#5 BENT BAR
STAINLESS STEEL
USE 3/8" PIN
(42) REQ'D.

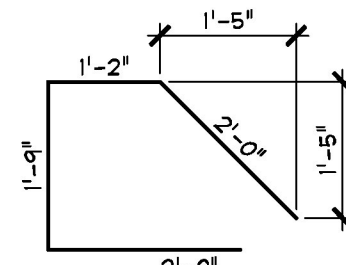


MD-5265
#5 BENT BAR
STAINLESS STEEL
USE 3/8" PIN
(19) REQ'D.

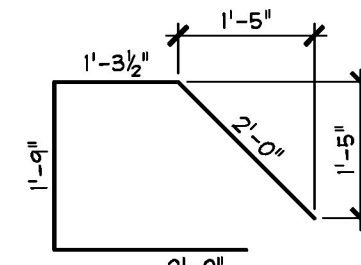


MD-5275
#5 BENT BAR
STAINLESS STEEL
USE 3/8" PIN
(21) REQ'D.

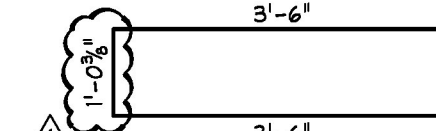


MD-5285
#5 BENT BAR
STAINLESS STEEL
USE 3/8" PIN
(1) REQ'D.

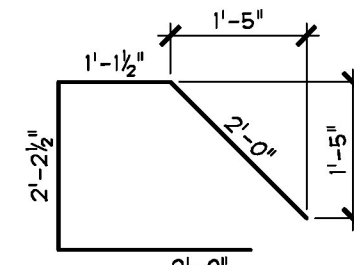

MD-5295
#5 BENT BAR
STAINLESS STEEL
USE 3/8" PIN
(1) REQ'D.

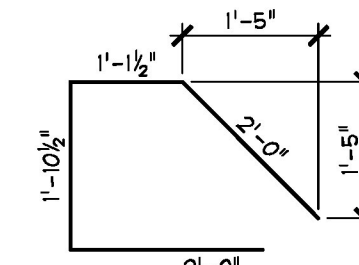


MD-5305
#5 BENT BAR
STAINLESS STEEL
USE 3/8" PIN
(1) REQ'D.

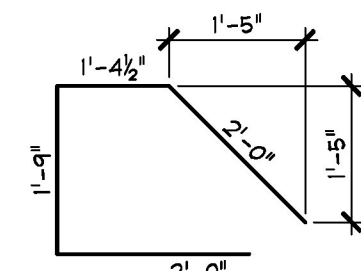


MD-5315
#5 BENT BAR
STAINLESS STEEL
USE 3/8" PIN
(3) REQ'D.



MD-5365
#5 BENT BAR
STAINLESS STEEL
USE 3/8" PIN
(46) REQ'D.

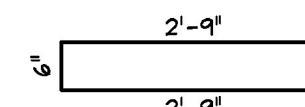

MD-5375
#5 BENT BAR
STAINLESS STEEL
USE 3/8" PIN
(52) REQ'D.

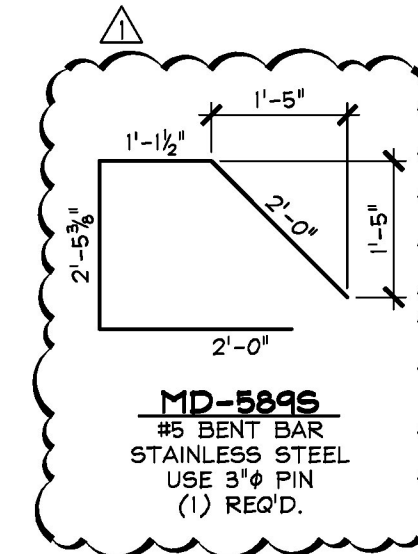

MD-5395
#5 BENT BAR
STAINLESS STEEL
USE 3/8" PIN
(1) REQ'D.

MISCELLANEOUS MATERIALS				
ITEM	MARK	QTY.	DESCRIPTION	REMARKS
1	MK-MD1	204	NMB SPLICE SLEEVE 5U-X(PG) (EPOXY COATED)	INCLUDES (3) FOR TESTING
2	MK-MD5	5	E 1/2" x 8" x 9" W/ (3) 3/8" HOLE & ANCHORS (GALV.)	SUPPLIED BY OTHERS
3				
4	MK-MD7	1	DAYTON 7/8" F-42 LOOP FERRULE INSERT	GALVANIZE
5				
6		43.22 LF	P.V.C. WATERSTOP PER VTAQT 707-10	SUPPLIED BY OTHERS
7				
8		28	4T x 7 1/8" SWIFT LIFT LIFTER (GALV.)	DOMESTIC ORIGIN (BUY AMERICAN)
9		14	8T x 13 3/8" SWIFT LIFT LIFTER (GALV.)	DOMESTIC ORIGIN (BUY AMERICAN)
10				
11				
12		164	#5 x 4'-9" (STAINLESS STEEL)	
13		6	#5 x 13'-10 1/2" (STAINLESS STEEL)	
14		6	#5 x 13'-2" (STAINLESS STEEL)	
15		1	#5 x 13'-10" (STAINLESS STEEL)	
16		3	#5 x 12'-3 1/2" (STAINLESS STEEL)	
17		16	#5 x 12'-2" (STAINLESS STEEL)	
18		10	#5 x 7'-11" (STAINLESS STEEL)	
19		6	#5 x 7'-1" (STAINLESS STEEL)	
20		7	#5 x 7'-10 1/2" (STAINLESS STEEL)	
21		2	#5 x 8'-10" (STAINLESS STEEL)	
22		1	#5 x 7'-2 1/2" (STAINLESS STEEL)	
23		6	#5 x 5'-1" (STAINLESS STEEL)	
24		12	#5 x 6'-0" (STAINLESS STEEL)	
25		6	#5 x 9'-7" (STAINLESS STEEL)	
26		6	#5 x 13'-9 1/2" (STAINLESS STEEL)	
27		12	#5 x 16'-4 1/2" (STAINLESS STEEL)	
28		36	#5 x 4'-5" (STAINLESS STEEL)	
29		4	#5 x 4'-6" (STAINLESS STEEL)	
30		6	#5 x 15'-7" (STAINLESS STEEL)	
31		6	#5 x 17'-3" (STAINLESS STEEL)	
32				
33		48	#8 x 2'-0" (STAINLESS STEEL)	
34				
35				

Vermont Agency of Transportation
RECEIVED
 ON: **May 10, 2016**
 and Checked for
CONFORMANCE
 BY: Rob Young DATE: 05/16/2016

Approved	<input checked="" type="checkbox"/>	Approved As Noted	<input type="checkbox"/>
Rejected	<input type="checkbox"/>		
This review is only for general conformance with the design concept and the information given in the Construction Documents. Corrections or comments made on the shop drawings during the review do not relieve the Contractor from compliance with the requirements of the Plans and Specifications. Review of a specific item shall not include review of an assembly of which an item is a component. The Contractor is responsible for dimensions to be confirmed and corrected at the job site; information that pertains solely to the fabrication process or to the means, methods, techniques, sequences and procedures of construction; coordination of the Work with that of other trades and performing all Work in a safe and satisfactory manner.			
Date: 5/13/2016			
By: D. Kull			

5-10-16 REVISED AS NOTED

APPROVAL STAMP:	J.P. CARRARA & SONS INC. Precast & Prestress Manufacturer 2464 CASE ST., MIDDLEBURY, VERMONT 05753 Phone: (802)388-6361 Fax: (802)388-9010		A.L. ST. ONGE CONTRACTOR, INC. CONTRACTOR MONTGOMERY, VERMONT	
	STATE OF VERMONT AGENCY OF TRANSPORTATION COUNTY OF WINDSOR		DATE: JAN. 12, 2016	SCALE: NOTED
	TOWN OF WAITSFIELD VT ROUTE 100 (MINOR ARTERIAL) BRIDGE NO.: 177 PROJECT NO.: BRP 013-4(39)		CHKD: -	DFTM: B.L.
	PRECAST BACKWALLS MATERIALS LIST		JOB NO: 23480-016	DWG. NO: M3