


MISCELLANEOUS MATERIALS

ITEM	MARK	QTY.	DESCRIPTION	REMARKS
1	MK-MD2	10	1 1/2" x 2-1" SWEDGE HANCHOR BOLT W/ 5' THREADS (GALV.)	SUPPLIED BY OTHERS
2	MK-MD7	13	LEVELING JACK ASSEMBLY	SEE DETAIL, SHEET 'M5.1'
3	MK-MD8	7	LEVELING JACK ASSEMBLY	SEE DETAIL, SHEET 'M5.1'
4	MK-MD9	2	LEVELING JACK ASSEMBLY	SEE DETAIL, SHEET 'M5.1'
5	MK-MD10	2	LEVELING JACK ASSEMBLY	SEE DETAIL, SHEET 'M5.1'
6	MK-MD11	2	LEVELING JACK ASSEMBLY	SEE DETAIL, SHEET 'M5.1'
7	MK-MD14	12	SET OF (2) 1/2" STRAND LIFTING LOOPS	SEE DETAIL THIS SHEET
8				
9		19	4" I.C. x 2'-6" PVC SLEEVE	
10		2	4" I.C. x 3'-1" PVC SLEEVE	
11		9	4" I.C. x 3'-2" PVC SLEEVE	
12		3	4" I.C. x 2'-11" PVC SLEEVE	
13		4	4" I.C. x 2'-8" PVC SLEEVE	
14				
15				
16		20	#5 x 14'-7 1/2" (STAINLESS STEEL)	
17		20	#5 x 15'-6" (STAINLESS STEEL)	
18		4	#5 x 14'-2 1/2" (STAINLESS STEEL)	
19		16	#5 x 19'-7" (STAINLESS STEEL)	
20		8	#5 x 9'-10" (STAINLESS STEEL)	
21				
22				
23				
24				
25				
26				
27				
28				
29				
30				

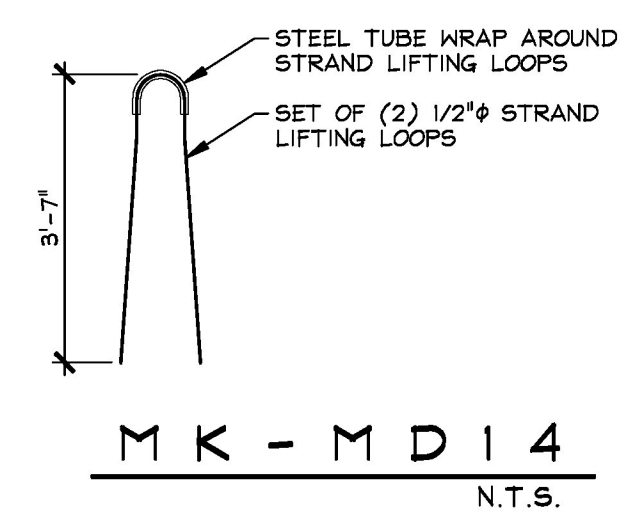

Vermont Agency of Transportation
RECEIVED
 ON: **May 10, 2016**
 and Checked for
CONFORMANCE
 BY: Rob Young DATE: 05/16/2016

Approved	X Approved As Noted
Rejected	

This review is only for general conformance with the design concept and the information given in the Construction Documents. Corrections or comments made on the shop drawings during the review do not relieve the Contractor from compliance with the requirements of the Plans and Specifications. Review of a specific item shall not include review of an assembly of which an item is a component. The Contractor is responsible for dimensions to be confirmed and corrected at the job site; information that pertains solely to the fabrication process or to the means, methods, techniques, sequences and procedures of construction; coordination of the Work with that of other trades and performing all Work in a safe and satisfactory manner.

Date: 5/13/2016
 By: D. Kull

APPROVAL STAMP:	J.P. CARRARA & SONS INC. Precast & Prestress Manufacturer 2464 OSE STR., MIDDLEBURY, VERMONT 05753 Phone: (802)388-6361 Fax: (802)388-9010		A.L. ST. ONGE CONTRACTOR, INC. CONTRACTOR MONTGOMERY, VERMONT	
	STATE OF VERMONT AGENCY OF TRANSPORTATION COUNTY OF WINDSOR		DATE: JAN. 12, 2016	SCALE: NOTED
	TOWN OF WAITSFIELD VT ROUTE 100 (MINOR ARTERIAL) BRIDGE NO.: 177 PROJECT NO.: BF 013-4(39)		CHKD: -	DFTM: B.L.
	PRECAST FOOTING MATERIALS LIST		JOB NO: 23480-016	DWG. NO: M5