




1 ~ x11a

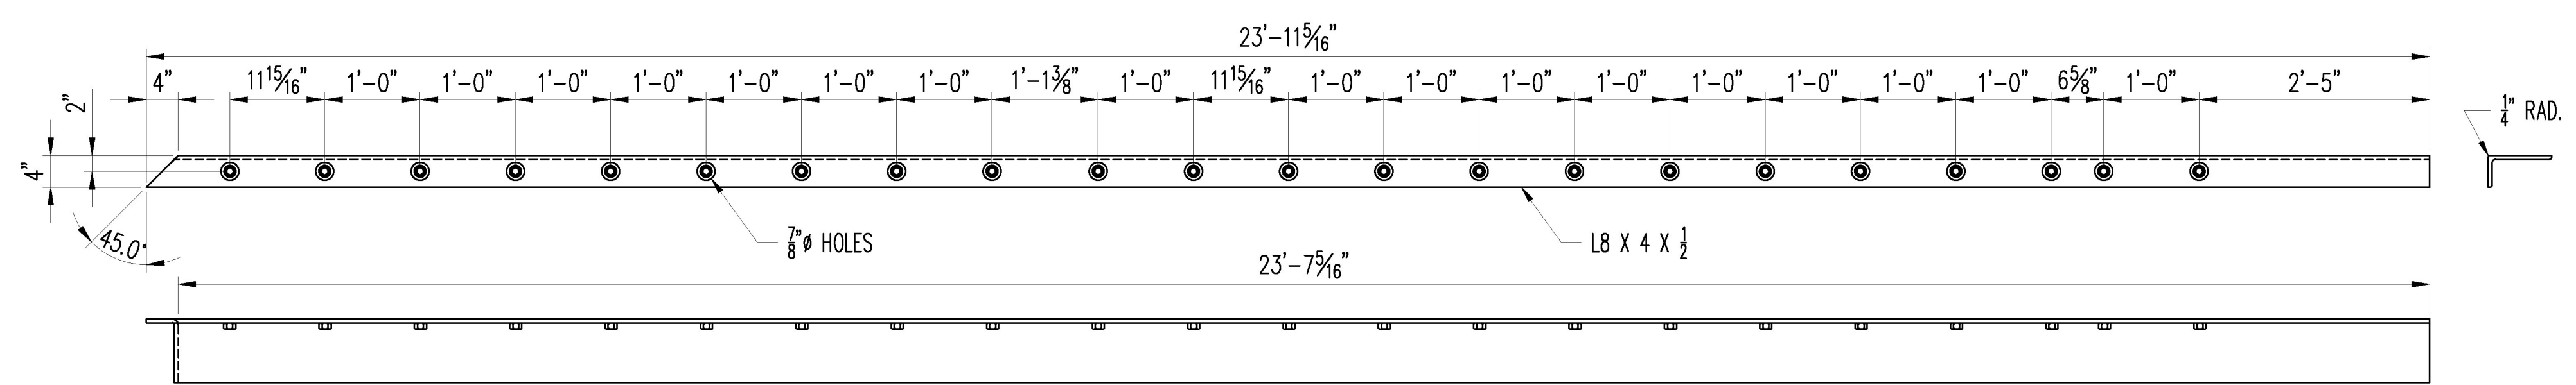


1 ~ x11b

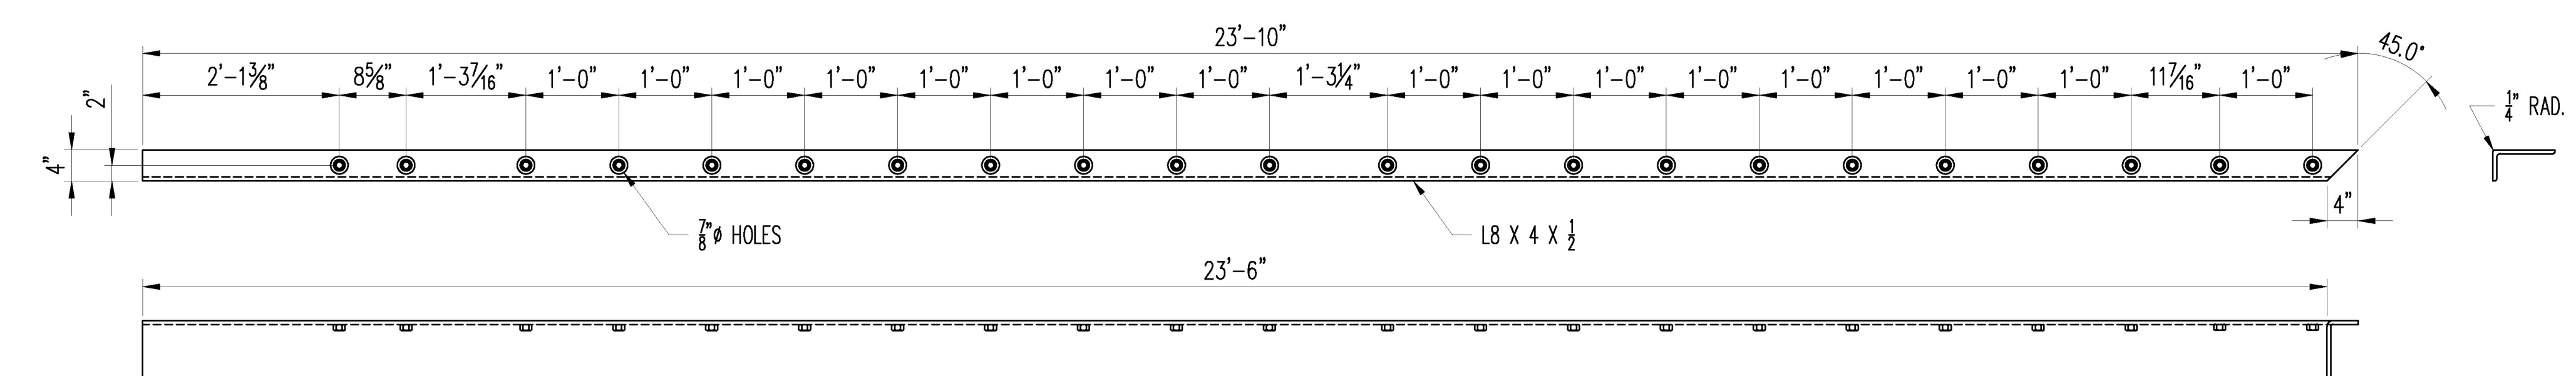

1 ~ x11c

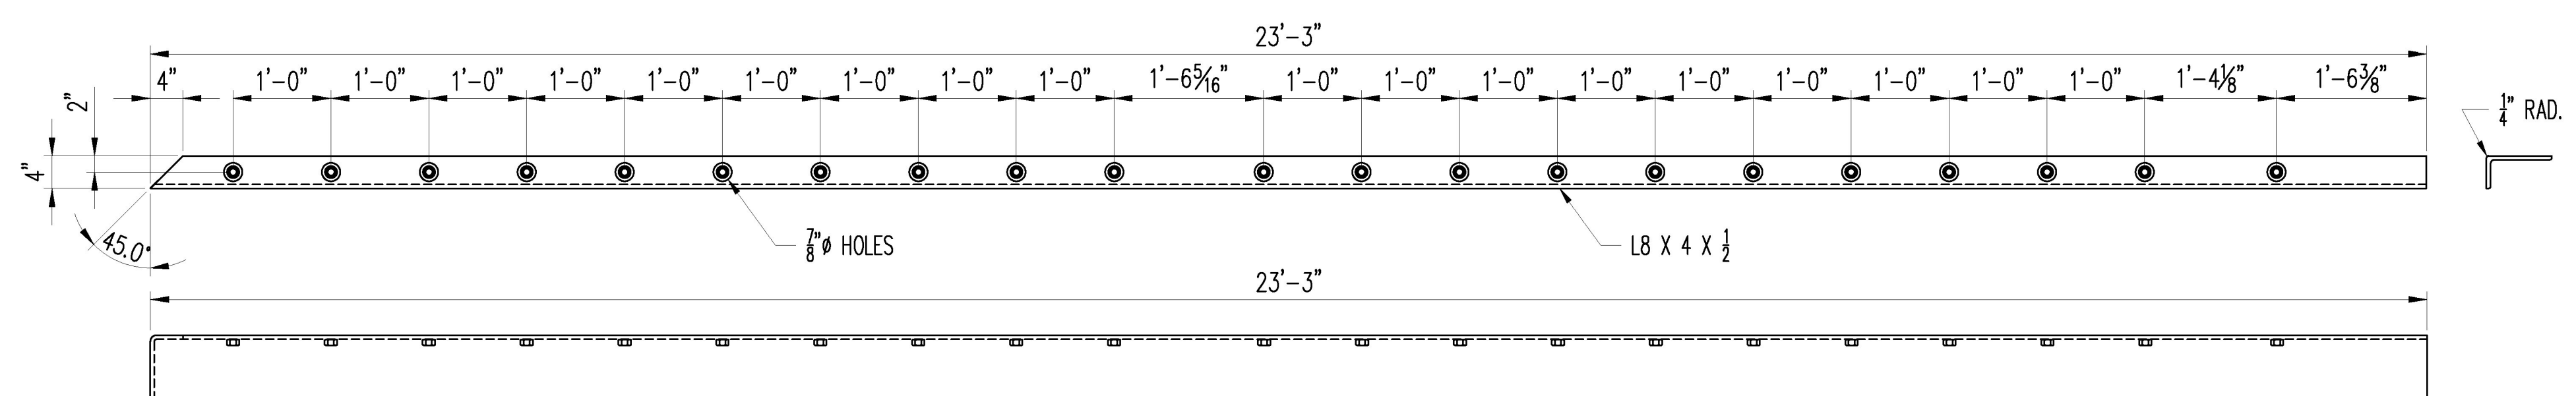

1 ~ x11d

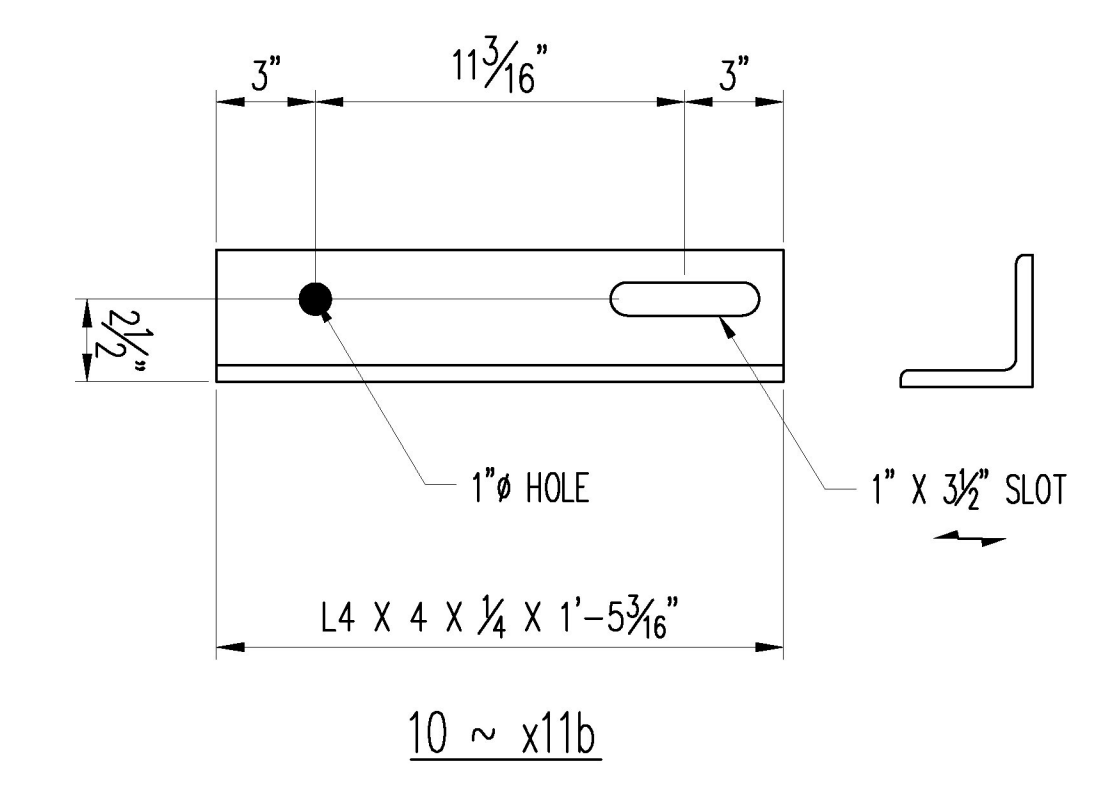

10 ~ x11b

Vermont Agency of Transportation
RECEIVED
 ON: April 26, 2016
 and Checked for
CONFORMANCE
 BY: Rob Young DATE: 05/13/2016

| | |
|----------|---|
| Approved | <input checked="" type="checkbox"/> Approved As Noted |
| Rejected | <input type="checkbox"/> |

This review is only for general conformance with the design concept and the information given in the Construction Documents. Corrections or comments made on the shop drawings during the review do not relieve the Contractor from compliance with the requirements of the Plans and Specifications. Review of a specific item shall not include review of an assembly of which an item is a component. The Contractor is responsible for dimensions to be confirmed and corrected at the job site; information that pertains solely to the fabrication process or to the means, methods, techniques, sequences and procedures of construction; coordination of the Work with that of other trades and performing all Work in a safe and satisfactory manner.

Date: 5/12/2016
 By: D. Kull

McFarland Johnson

| 4/25 | REVISIONS PER APPROVAL | SLB | JEB | | |
|--|------------------------|-------------------------|-------------|-------------|----------------|
| REV. | DATE | REMARKS | DWN | CHK | APVL |
| | | | | | SHOP |
| MATERIAL: | | SURFACE PREP. & PAINT: | | HOLES: | |
| M270M-250(GR36) U.N.O. | | GALV. - PER STD. 726.08 | | AS NOTED | |
| | | | | SHOP BOLTS: | |
| | | | | AS NOTED | |
| DESCRIPTION: EXPANION JOINT - DETAILS | | | | | |
| CASCO BAY STEEL STRUCTURES, INC. | | | | | |
| 1 WALLACE AVE. | | PHONE (207) 780-6722 | | | |
| SOUTH PORTLAND, ME 04106 | | FAX. (207) 780-6726 | | | |
| STRUCTURE: BRIDGE NO. 177 | | | DRAWN: SLB | | DATE: 03/02/16 |
| VT 100 OVER MAD RIVER | | | CHKD: JEB | | DATE: 03/02/16 |
| STATE OF VERMONT AGENCY OF TRANS. | | | | | |
| LOCATION: WAITSFIELD, VT | | | JOB NO. 651 | | DWG NO. X11 |
| PROJ NO. BRF 013-4(39) | | | | | REV. A |
| CUSTOMER: A.L. ST. ONGE CONTRACTOR, INC. | | | | | |