




1 ~ x13a

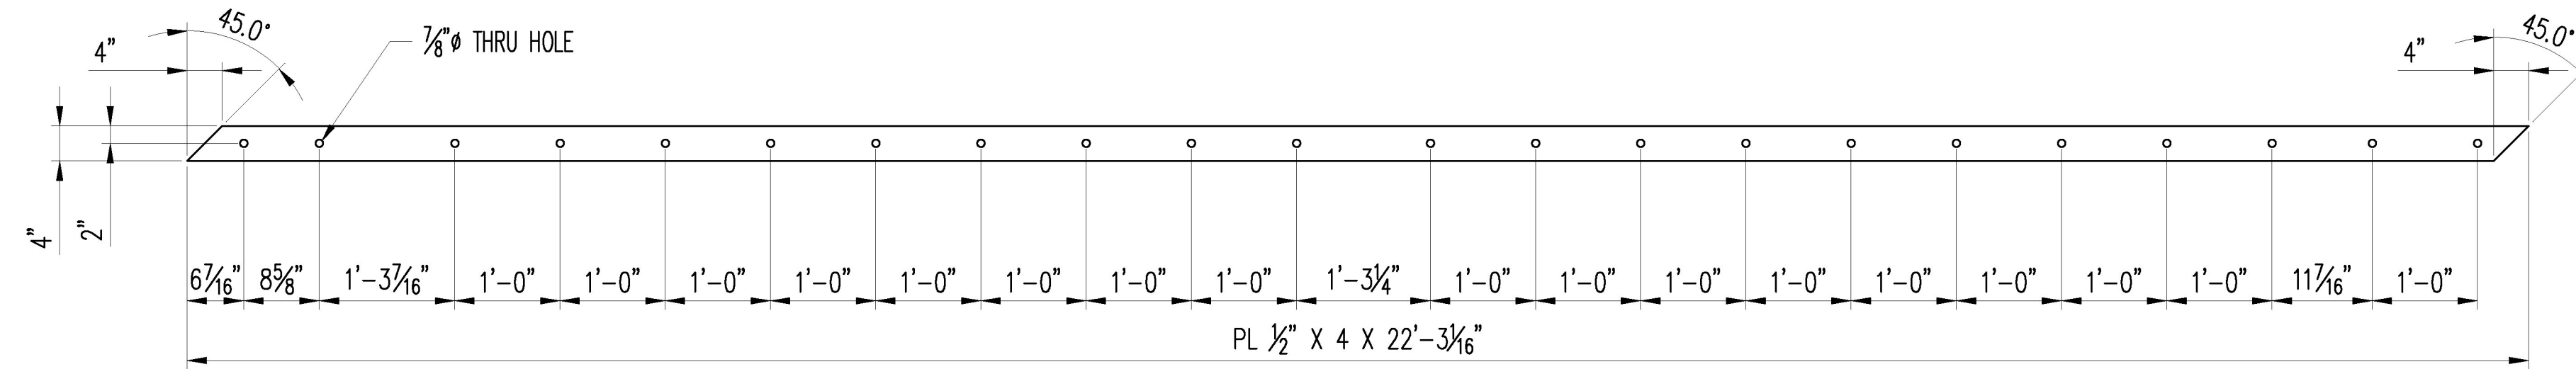

1 ~ x13b

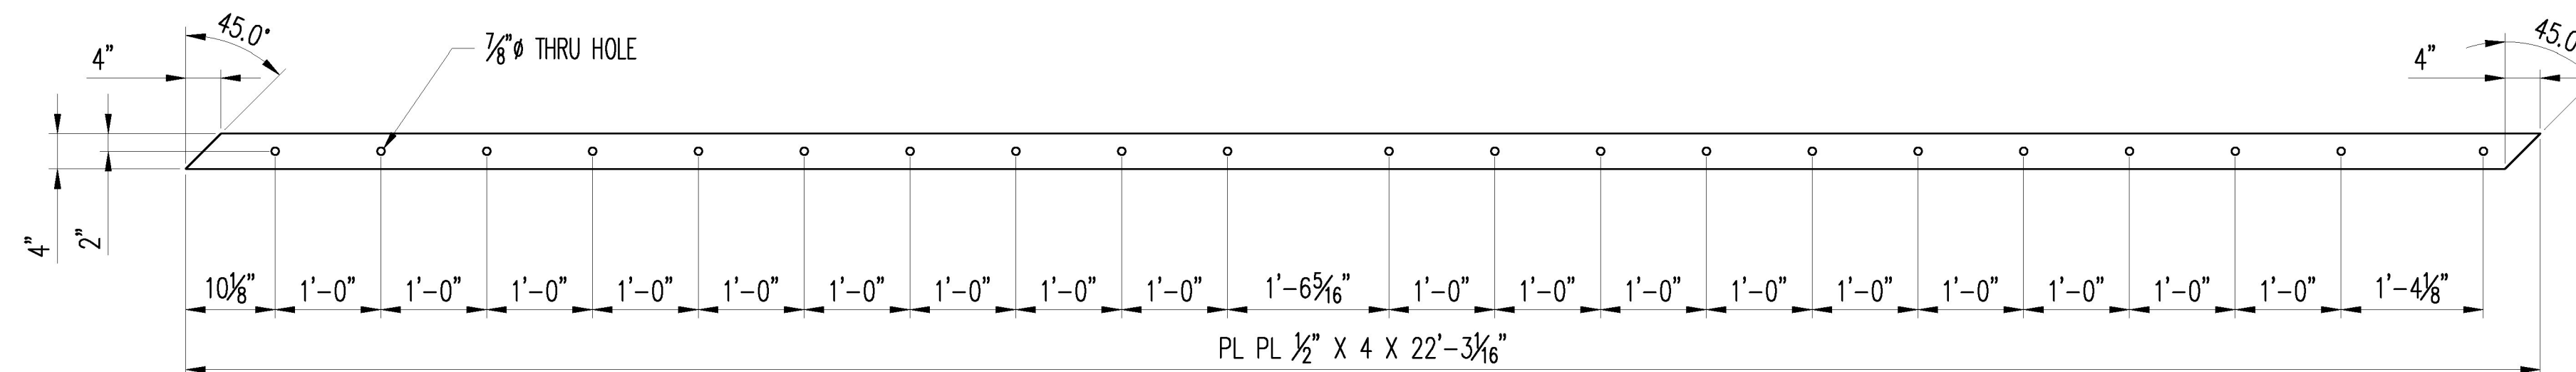

1 ~ x13c

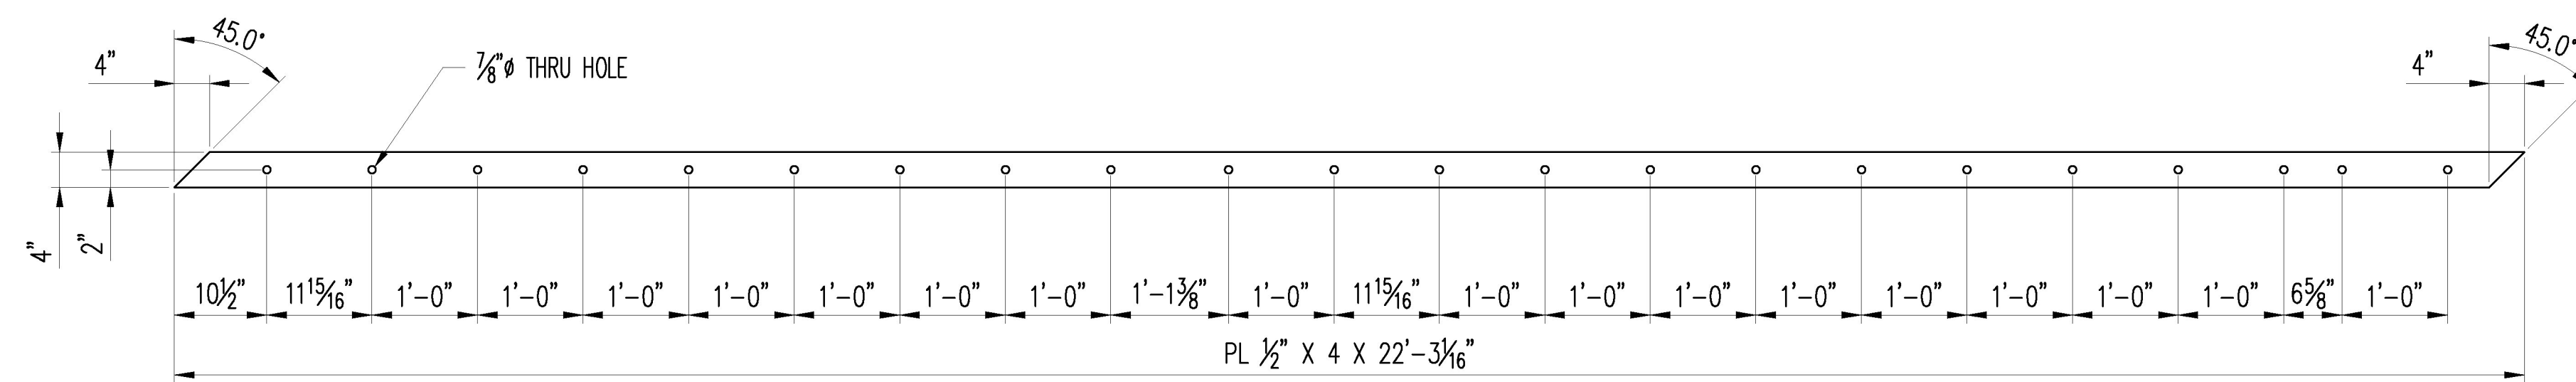

1 ~ x13d

Vermont Agency of Transportation

RECEIVED

ON: **April 26, 2016**

and Checked for
CONFORMANCE

BY: Rob Young DATE: 05/13/2016

<input type="checkbox"/> Approved	<input checked="" type="checkbox"/> Approved As Noted
<input type="checkbox"/> Rejected	

This review is only for general conformance with the design concept and the information given in the Construction Documents. Corrections or comments made on the shop drawings during the review do not relieve the Contractor from compliance with the requirements of the Plans and Specifications. Review of a specific item shall not include review of an assembly of which an item is a component. The Contractor is responsible for dimensions to be confirmed and corrected at the job site; information that pertains solely to the fabrication process or to the means, methods, techniques, sequences and procedures of construction; coordination of the Work with that of other trades and performing all Work in a safe and satisfactory manner.

Date: 5/12/2016
By: D. Kull

McFarland Johnson

4/25	REVISIONS PER APPROVAL	SLB	JEB			
REV.	DATE	REMARKS	DWN	CHK	APVL	SHOP
MATERIAL:		SURFACE PREP. & PAINT:		HOLES:		SHOP BOLTS:
M270M-250(GR36) U.N.O.		GALV. - PER STD. 726.08		AS NOTED		AS NOTED
DESCRIPTION: EXPANION JOINT - DETAILS						
CASCO BAY STEEL STRUCTURES, INC.						
1 WALLACE AVE. PHONE (207) 780-6722						
SOUTH PORTLAND, ME 04106 FAX. (207) 780-6726						
STRUCTURE: BRIDGE NO. 177				DRAWN:	DATE:	
VT 100 OVER MAD RIVER				SLB	03/02/16	
STATE OF VERMONT AGENCY OF TRANS.				CHKD:	DATE:	
				JEB	03/02/16	
LOCATION: WAITSFIELD, VT			JOB NO.		DWG NO.	
PROJ NO. BRF 013-4(39)			651		X13	
CUSTOMER: A.L. ST. ONGE CONTRACTOR, INC.					REV. A	