



STATE OF VERMONT AGENCY OF TRANSPORTATION

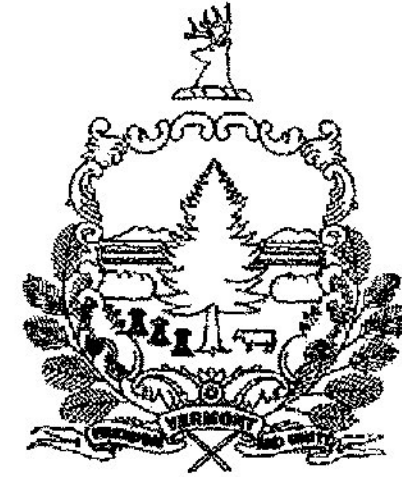

PROPOSED IMPROVEMENT BRIDGE PROJECT

TOWN OF CASTLETON
COUNTY OF RUTLAND
VT ROUTE 30 (RURAL MINOR ARTERIAL), BRIDGE NO 93

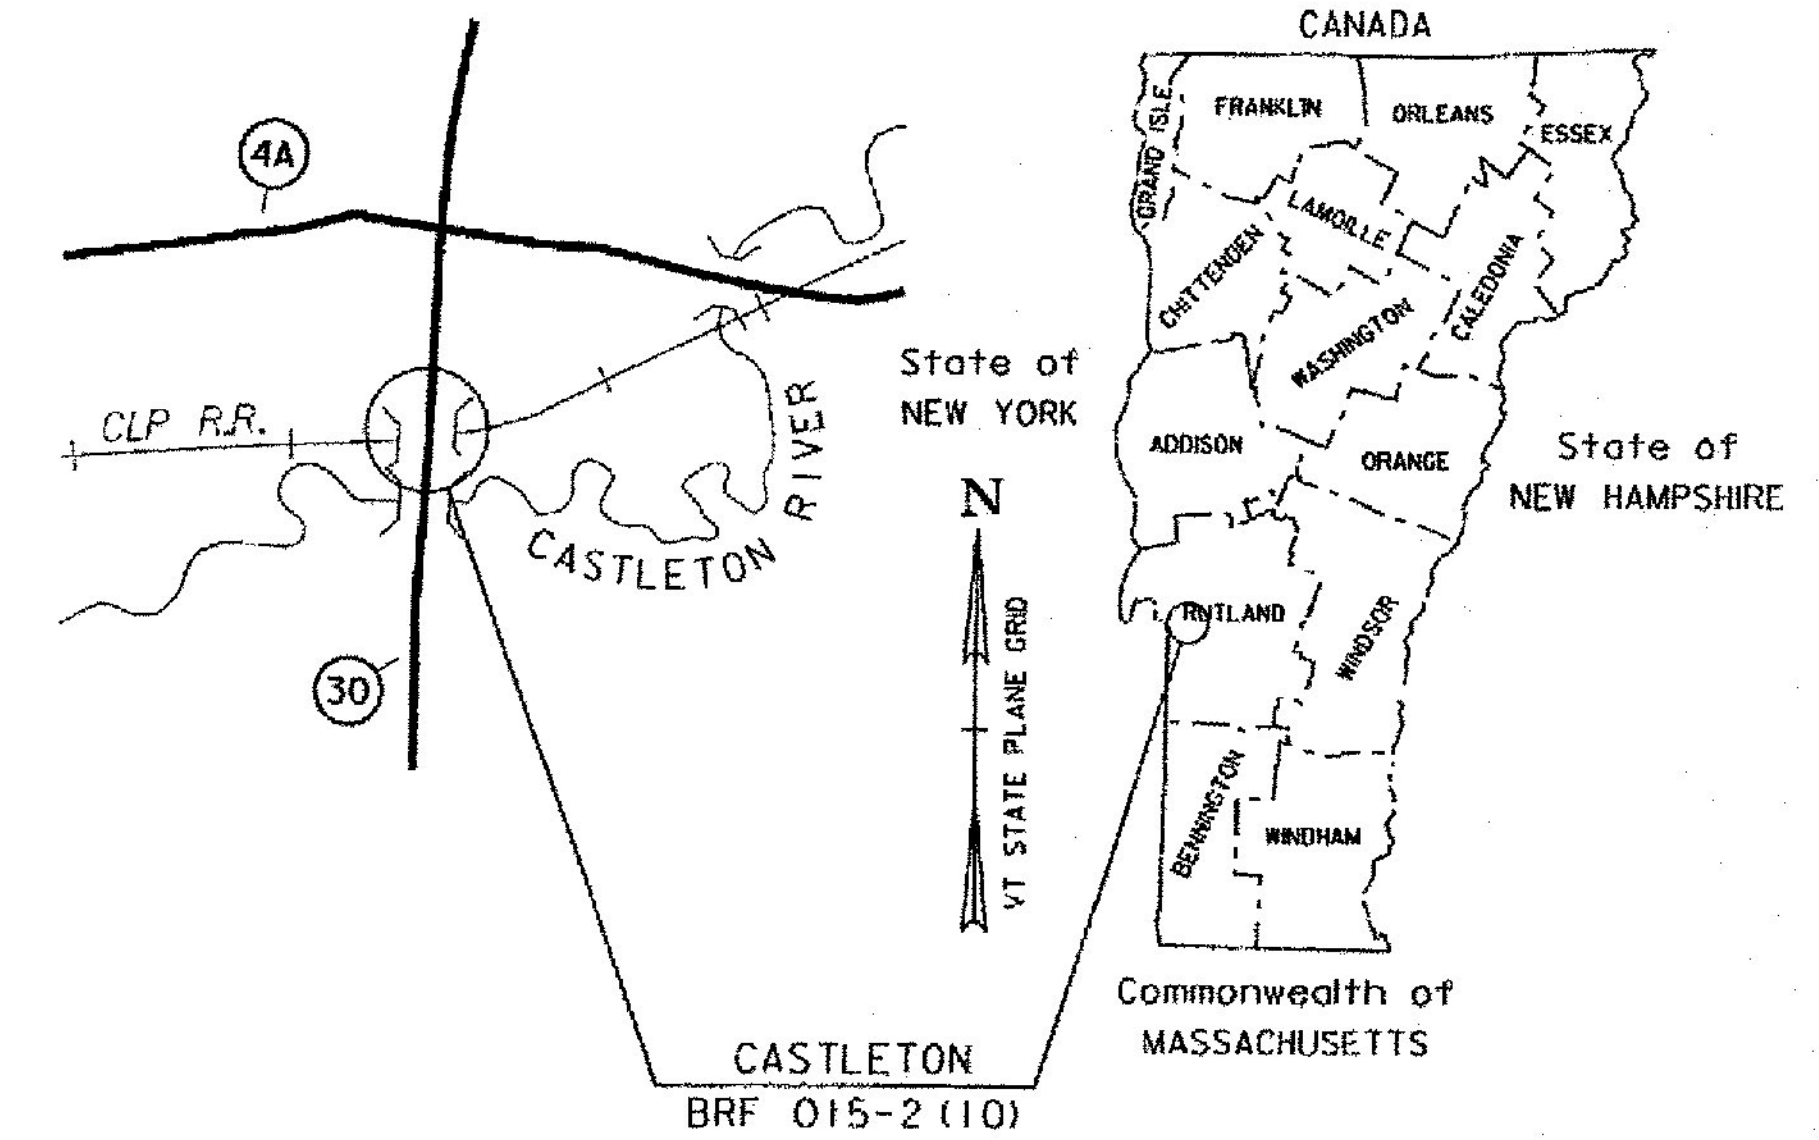


| RECORD PLANS | |
|--|--|
| CONTRACTOR: | W.M. SCHULTZ CONSTRUCTION, INC. - BOSTON, MA |
| RESIDENT ENGINEER: | CHRISTOPHER D. WILLIAMS |
| CONSTRUCTION BEGAN: | JUNE 15, 2015 |
| CONSTRUCTION COMPLETE: | AUGUST 21, 2015 |
| RECORD PLANS BY: | CHRISTOPHER D. WILLIAMS & KEVIN KING |
| I HEREBY CERTIFY THAT ALL THE CONSTRUCTION REQUIRED BY THIS SET OF DRAWINGS HAS BEEN ACCOMPLISHED AS INDICATED HEREIN. | |
| BY: | RESIDENT ENGINEER |
| DATE: | 3/2/2017 |
| NOTE: Any further information concerning final quantities, amounts or other details relative to this project may be found at Central Files in the electronic archives. | |

PROJECT LOCATION: LOCATED IN THE COUNTY OF RUTLAND, TOWN OF CASTLETON, ON VT ROUTE 30; BRIDGE NO. 93 OVER THE CLARENDON AND PITTSFORD RAILROAD; APPROXIMATELY 0.3 MILES SOUTH OF INTERSECTION OF VT ROUTE 30 AND VT ROUTE 4A.


PROJECT DESCRIPTION: WORK TO BE PERFORMED UNDER THIS PROJECT INCLUDES THE REMOVAL AND REPLACEMENT OF BRIDGE NO. 93 ON THE EXISTING ALIGNMENT, WITH ASSOCIATED ROADWAY AND RAIL WORK.

LENGTH OF STRUCTURE: 70.10 FEET
LENGTH OF ROADWAY: 314.90 FEET
LENGTH OF PROJECT: 385.00 FEET

LENGTH OF RAIL WORK: +126.00 FEET
 1049.00

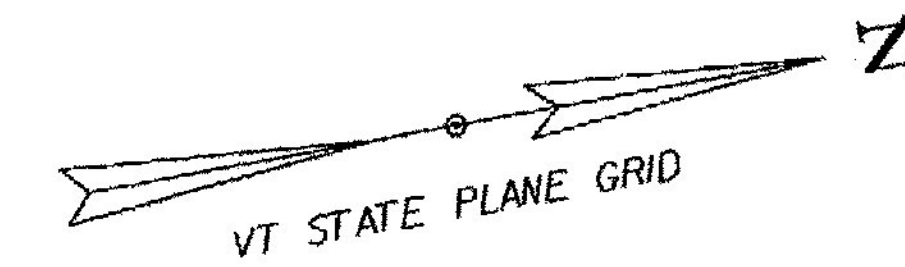

CONSTRUCTION IS TO BE CARRIED ON IN ACCORDANCE WITH THESE PLANS AND THE STANDARD SPECIFICATIONS FOR CONSTRUCTION DATED 2011, AS APPROVED BY THE FEDERAL HIGHWAY ADMINISTRATION ON JULY 20, 2011 FOR USE ON THIS PROJECT, INCLUDING ALL SUBSEQUENT REVISIONS AND SUCH REVISED SPECIFICATIONS AND SPECIAL PROVISIONS AS ARE INCORPORATED IN THESE PLANS.

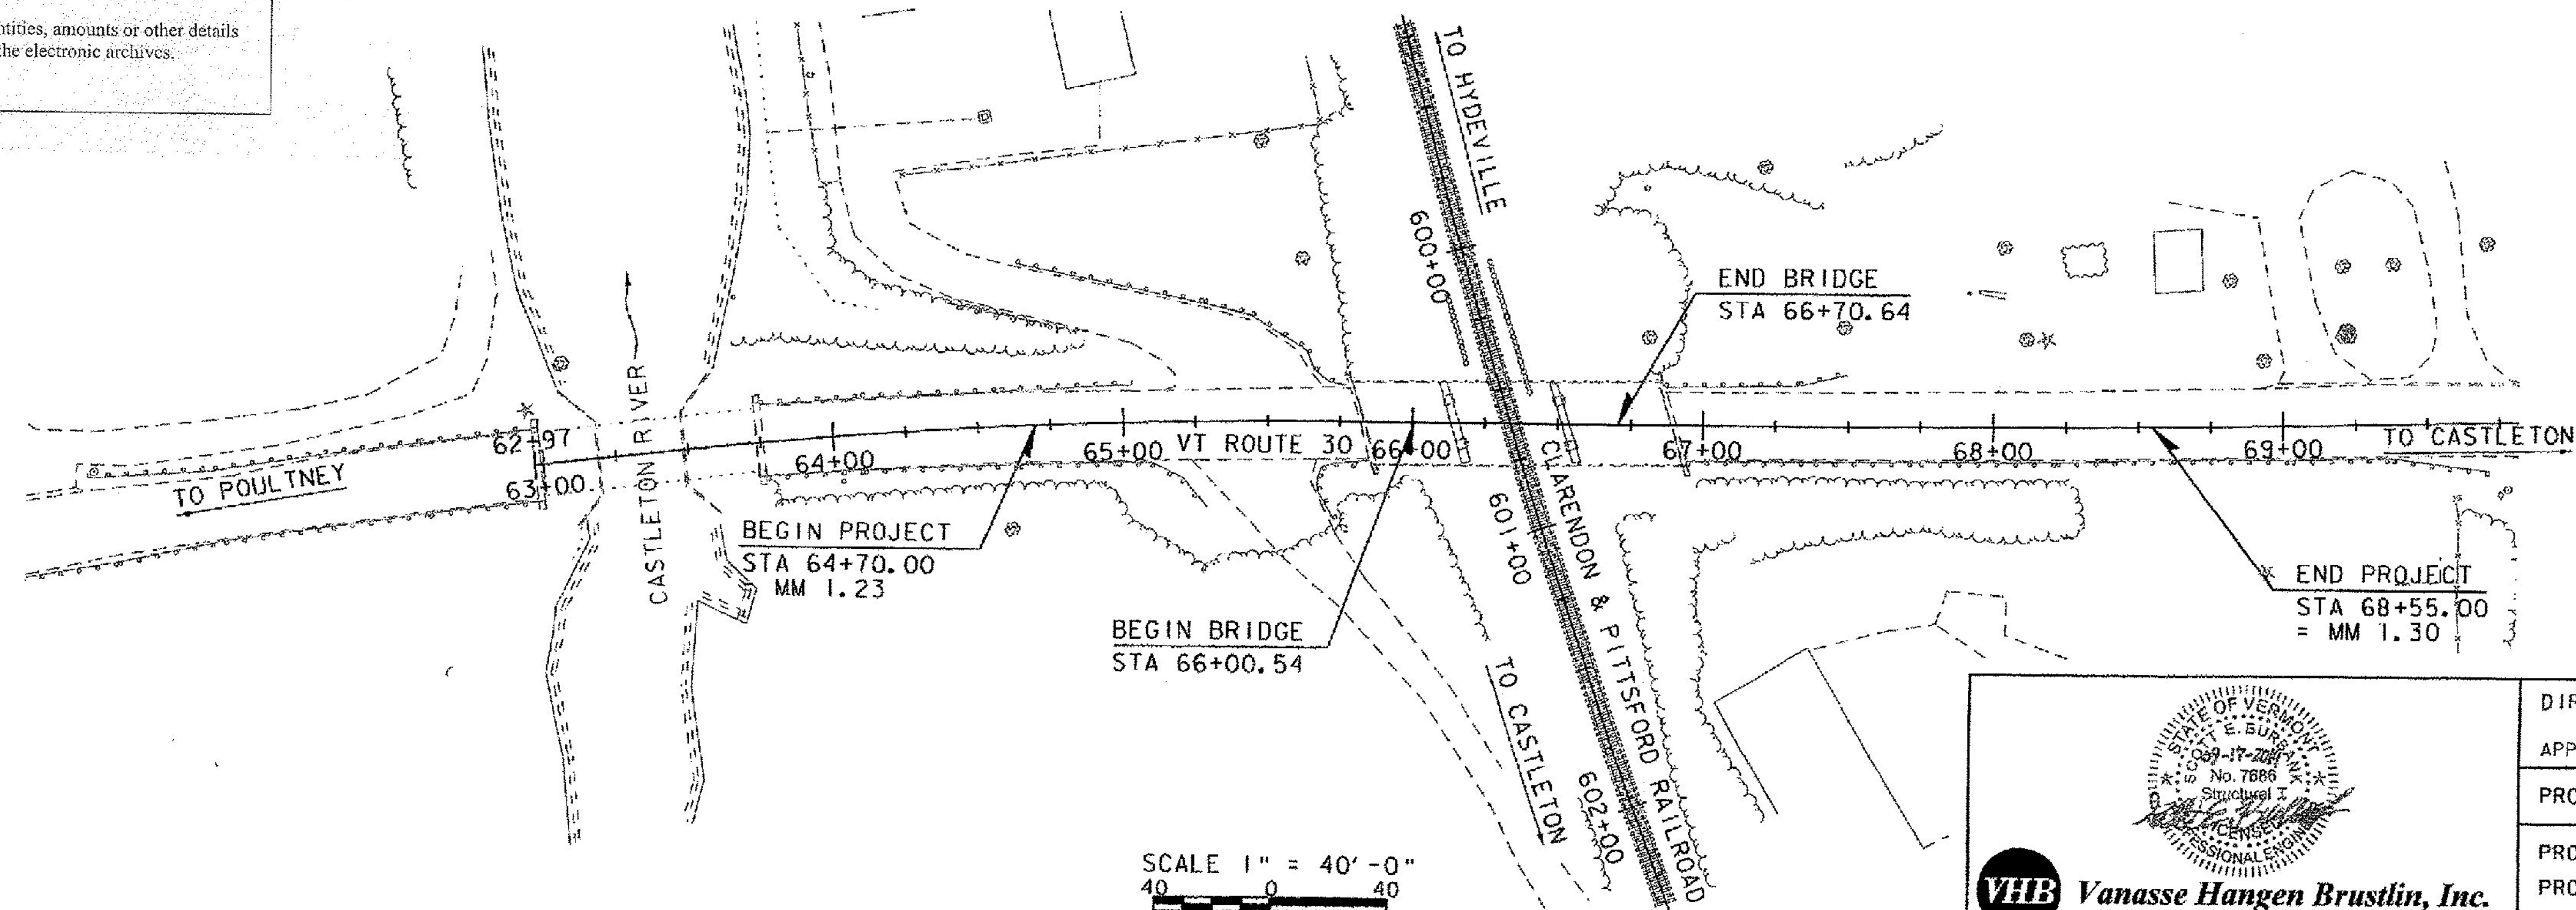

| | |
|-------------------------------------|--------------|
| QUALITY ASSURANCE PROGRAM : LEVEL 2 | |
| SURVEYED BY : | L. ORVIS |
| SURVEYED DATE : | 03-28-2012 |
| DATUM | |
| VERTICAL | NAVD 88 |
| HORIZONTAL | NAD83 (1992) |

SCALE 1" = 40'-0"

VHB Vanasse Hangen Brustlin, Inc.

| | |
|------------------------------|---------------------------|
| DIRECTOR OF PROJECT DELIVERY | |
| APPROVED: | DATE 3/16/2017 |
| PROJECT MANAGER : | JENNIFER M.V. FITCH, P.E. |
| PROJECT NAME : | CASTLETON |
| PROJECT NUMBER : | BRF 015-2 (10) |
| SHEET 1 OF 81 SHEETS | |