



BUILT AS DESIGNED

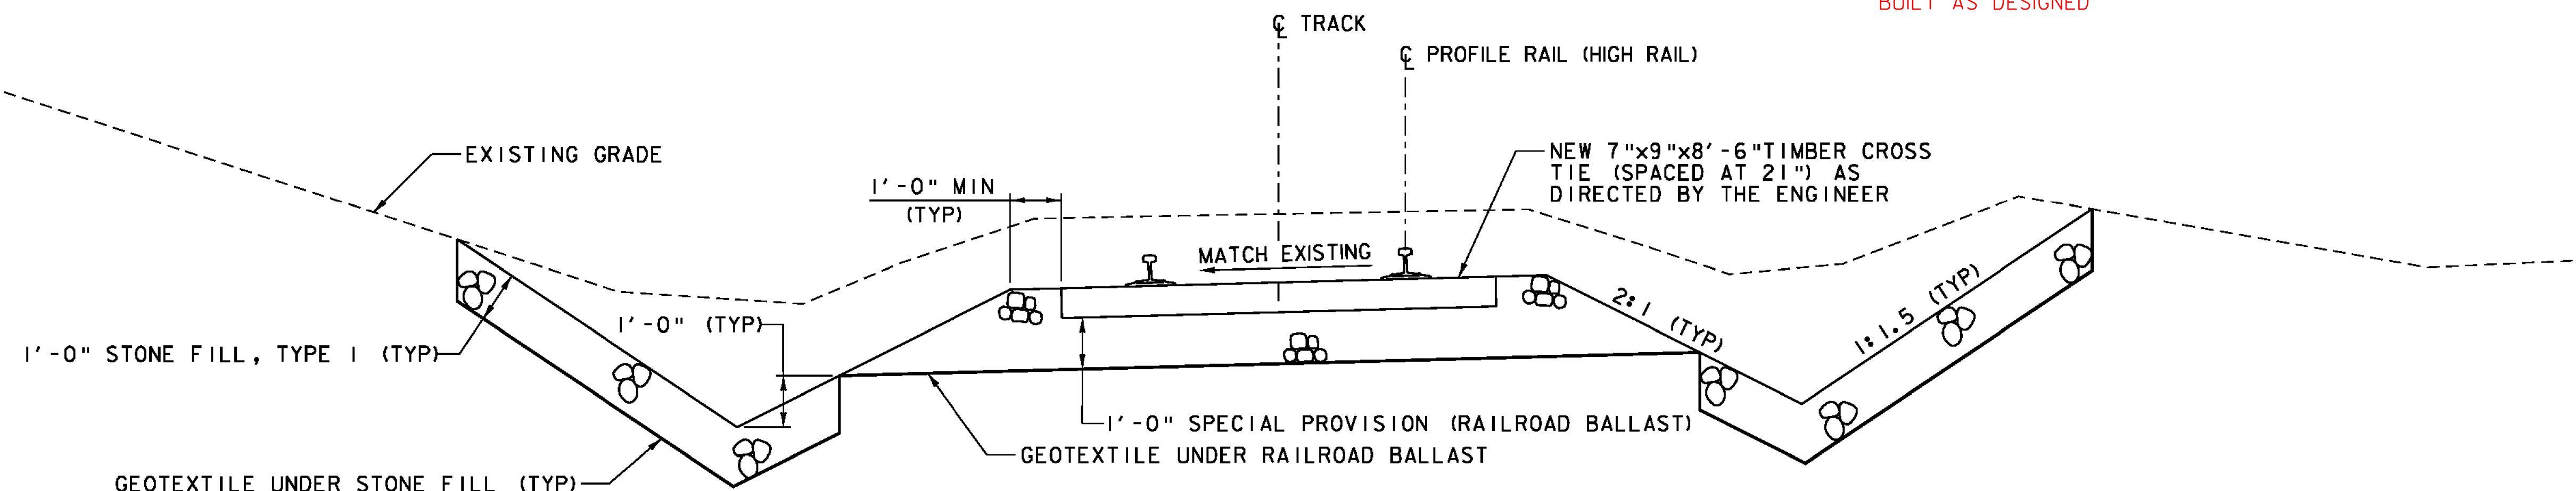


STA. 598+58 - 599+79, LT
 STA. 598+58 - 600+14, RT
 STA. 600+99 - 603+20, RT
 STA. 601+20 - 603+20, LT

TYPICAL RAIL DITCH SECTION
 SCALE 1/2" = 1'-0"

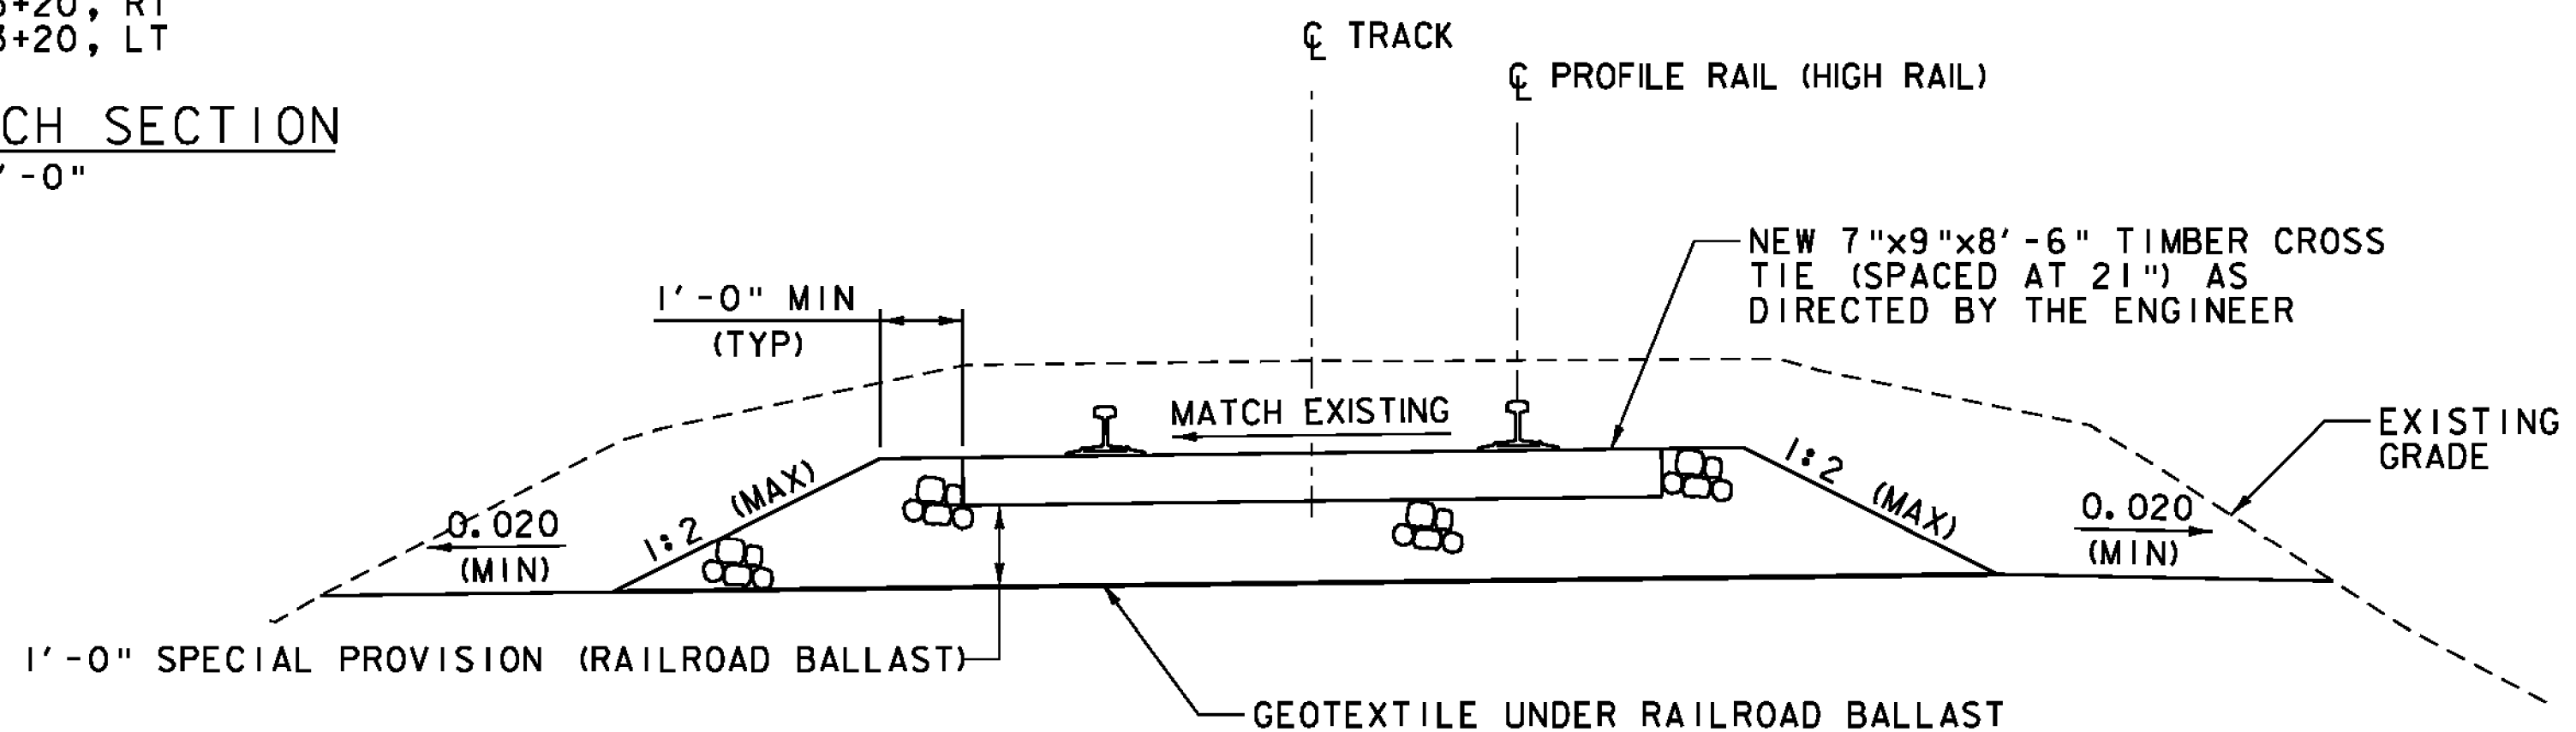

STA. 594+94 - 598+58, LT & RT
 STA. 603+20 - ~~606+20~~, LT & RT
 605+43

TYPICAL RAIL CUT SECTION
 SCALE 1/2" = 1'-0"

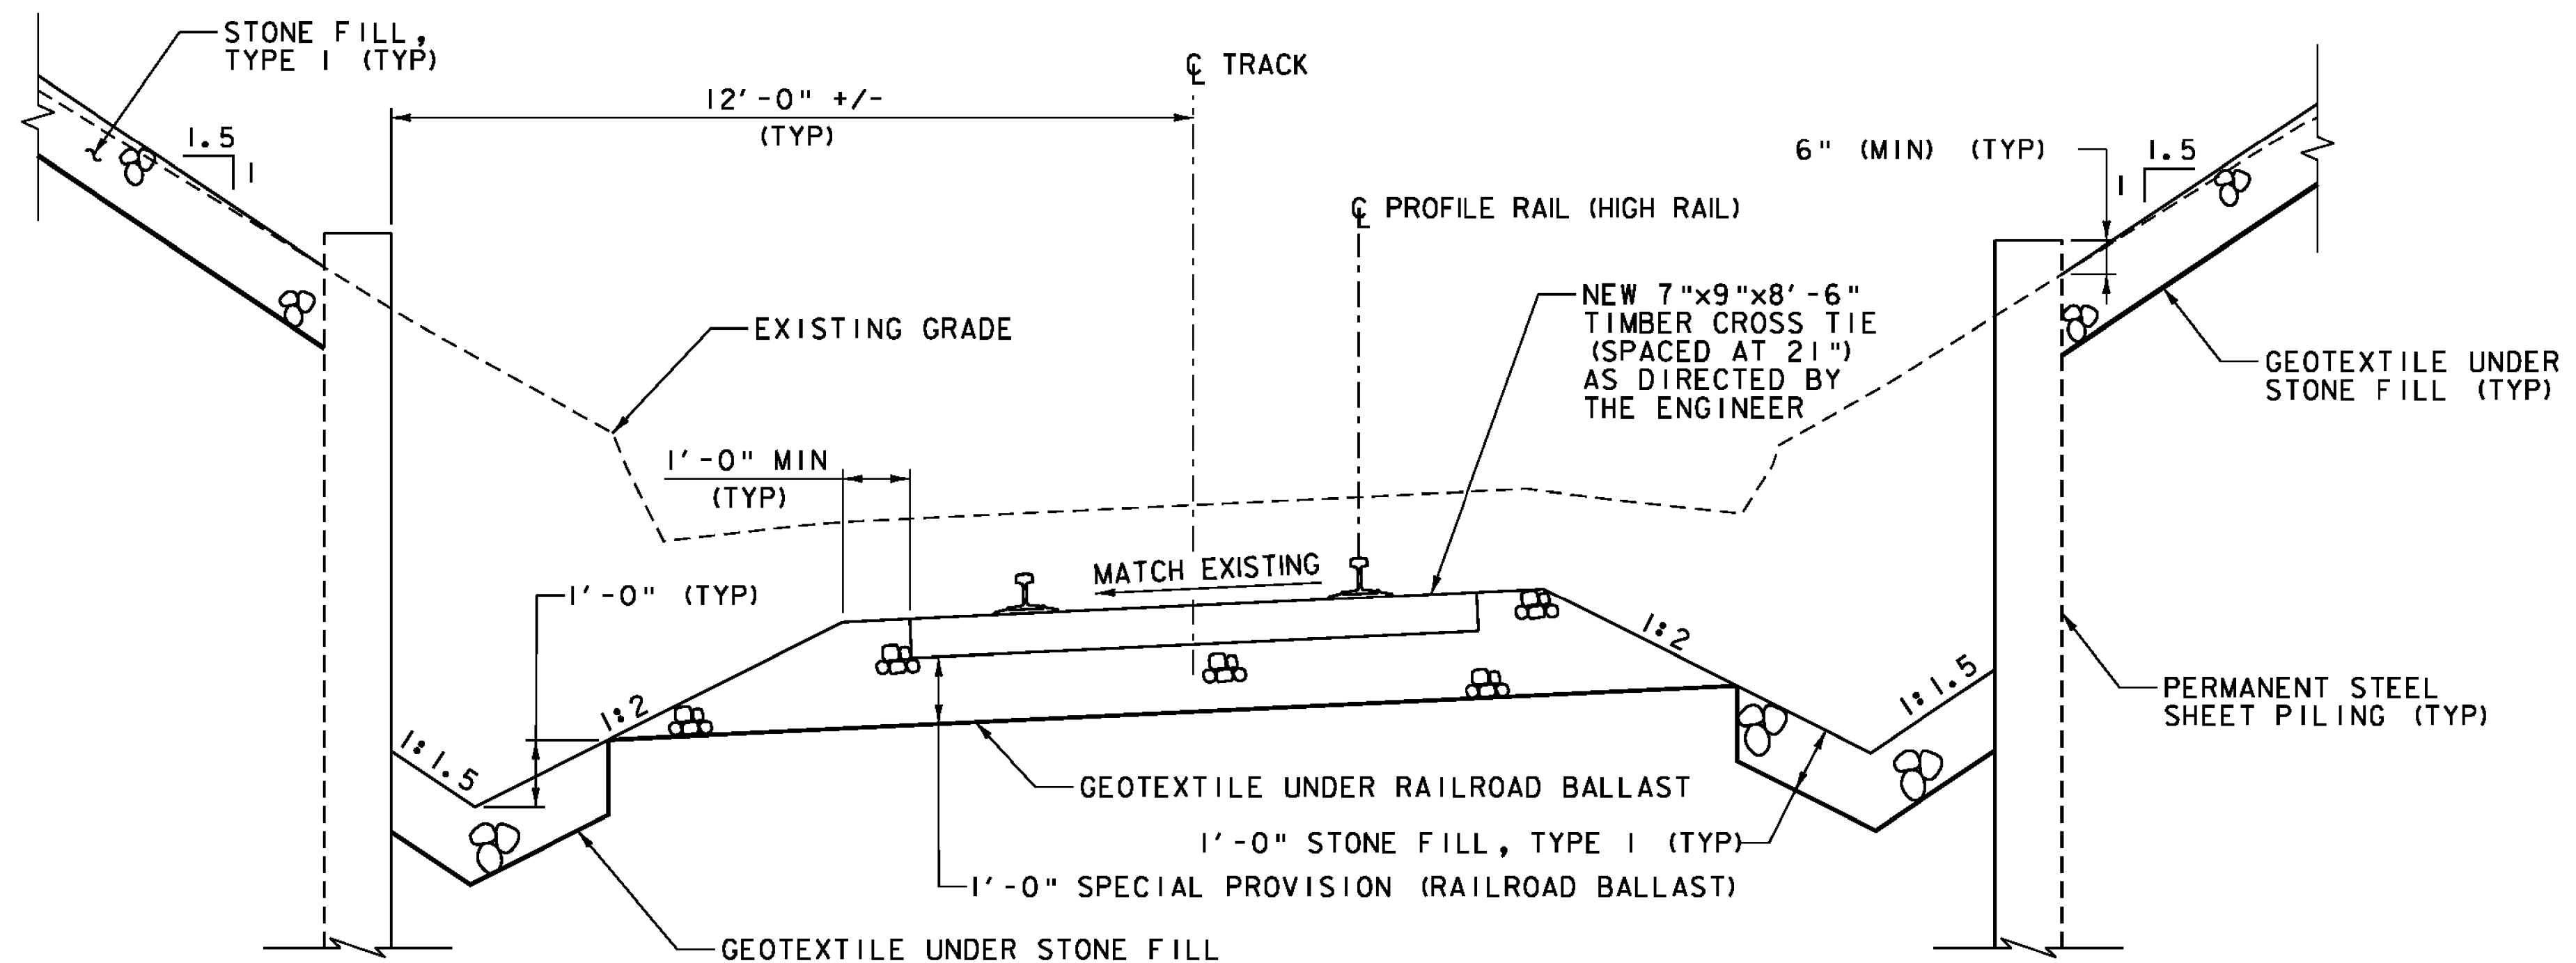

STA. 599+79 - 601+20, LT
 STA. 600+14 - 600+99, RT

TYPICAL RAIL SHEETING SECTION
 SCALE 1/2" = 1'-0"

| | | |
|-------------------------------|------------------------------|--------------------------|
| PROJECT NAME: CASTLETON | FILE NAME: z12b138typ.dgn | PLOT DATE: 10/23/2014 |
| PROJECT NUMBER: BRF 015-2(10) | PROJECT LEADER: S.E. BURBANK | DRAWN BY: E.A. FIALA |
| | DESIGNED BY: E.A. FIALA | CHECKED BY: S.E. BURBANK |
| | TYPICAL SECTIONS (3 OF 3) | SHEET 6 OF 82 |

