


SNOW BARRIER STA. 66+04 - 66+56, LT STA. 66+15 - 66+67, RT	REMOVAL AND DISPOSAL OF GUARDRAIL STA. 64+11 - 65+03, LT STA. 64+31 - 65+29, RT STA. 65+66 - 65+77, LT STA. 65+68 - 65+86, RT STA. 66+87 - 67+49, LT STA. 66+95 - 68+79, RT 69+70	GUARDRAIL APPROACH SECTION, GALVANIZED 2 RAIL BOX BEAM STA. 65+67 - 65+95, LT STA. 65+77 - 66+06, RT STA. 66+65 - 66+95, LT STA. 66+76 - 67+05, RT	STONE FILL, TYPE I STA. 64+05 - 64+51, LT STA. 66+90 - 68+75, RT
REMOVE AND RESET GUARDRAIL STA. 63+92 - 64+11, LT STA. 64+12 - 64+31, RT STA. 68+79 - 68+98, RT	ANCHOR FOR STEEL BEAM RAIL STA. 64+98, LT STA. 65+13, RT STA. 65+57, LT STA. 67+51, LT	BRIDGE RAILING, GALVANIZED 2 RAIL BOX BEAM STA. 65+95 - 66+65, LT STA. 66+06 - 66+76, RT	EDGE OF PAVEMENT ROADWAY WIDTH TRANSITION STA. 64+11.00, 11.92' LT STA. 64+31.00, 12.29' RT STA. 65+11.11, 16.00' LT STA. 65+19.00, 16.00' RT STA. 67+51.06, 16.00' LT STA. 67+64.00, 16.00' RT STA. 68+94.00, 13.02' LT STA. 68+94.00, 10.84' RT
	LIMITS OF COLD PLANING 63+75 STA. 63+90 - 64+30, RT & LT 64+27 STA. 68+95 - 69+35, RT & LT 68+90.5	STEEL BEAM GUARDRAIL, GALVANIZED STA. 64+97 - 65+09, LT STA. 65+13 - 65+25, RT STA. 65+45 - 65+67, LT STA. 65+62 - 65+77, RT STA. 66+95 - 67+63, LT STA. 67+05 - 68+79, RT 69+55	CONSTRUCT 30.0' PAVED DRIVE STA. 65+11 - 65+77, LT
	PRECAST REINFORCED CONCRETE CAST IN PLACE CURB, TYPE B STA. 65+59 - 65+96, LT STA. 65+72 - 66+06, RT STA. 66+66 - 67+05, LT STA. 66+76 - 67+16, RT	STEEL BEAM GUARDRAIL, GALV. W/ 8 FEET POSTS STA. 64+11 - 64+97, LT STA. 64+31 - 65+13, RT	CONSTRUCT 5.0' PAVED APRON STA. 65+13 - 65+70, RT STA. 68+95 - 69+34, LT
			CONSTRUCT 10.5' GRAVEL DRIVE STA. 65+25 - 65+66, RT

EXISTING BRIDGE DATA
 THREE SPAN STEEL BEAM WITH CAST-IN-PLACE
 CONCRETE DECK BUILT IN 1938
 SPAN LENGTH = 3-SPAN, 36'-0" MAX SPAN
 STRUCTURE LENGTH = 109'-0"
 DECK WIDTH OUT TO OUT = 29'-0"
 BRIDGE WIDTH CURB TO CURB = 25'-6"



PROJECT NAME: CASTLETON	PROJECT NUMBER: BRF 015-2(10)
FILE NAME: z12b138bdr_nul.dgn	PLOT DATE: 9/21/2014
PROJECT LEADER: S.E. BURBANK	DRAWN BY: E.A. FIALA
DESIGNED BY: E.A. FIALA	CHECKED BY: S.E. BURBANK
ROADWAY LAYOUT SHEET	SHEET 16 OF 82

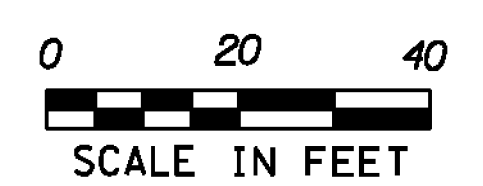