


STONE FILL, TYPE I  
 STA. 598+58 - 599+50, LT & RT  
 STA. 598+58 - 599+16.5, LT

15" CPEP (SL)  
 STA. 599+16.5 - 599+50.0, LT

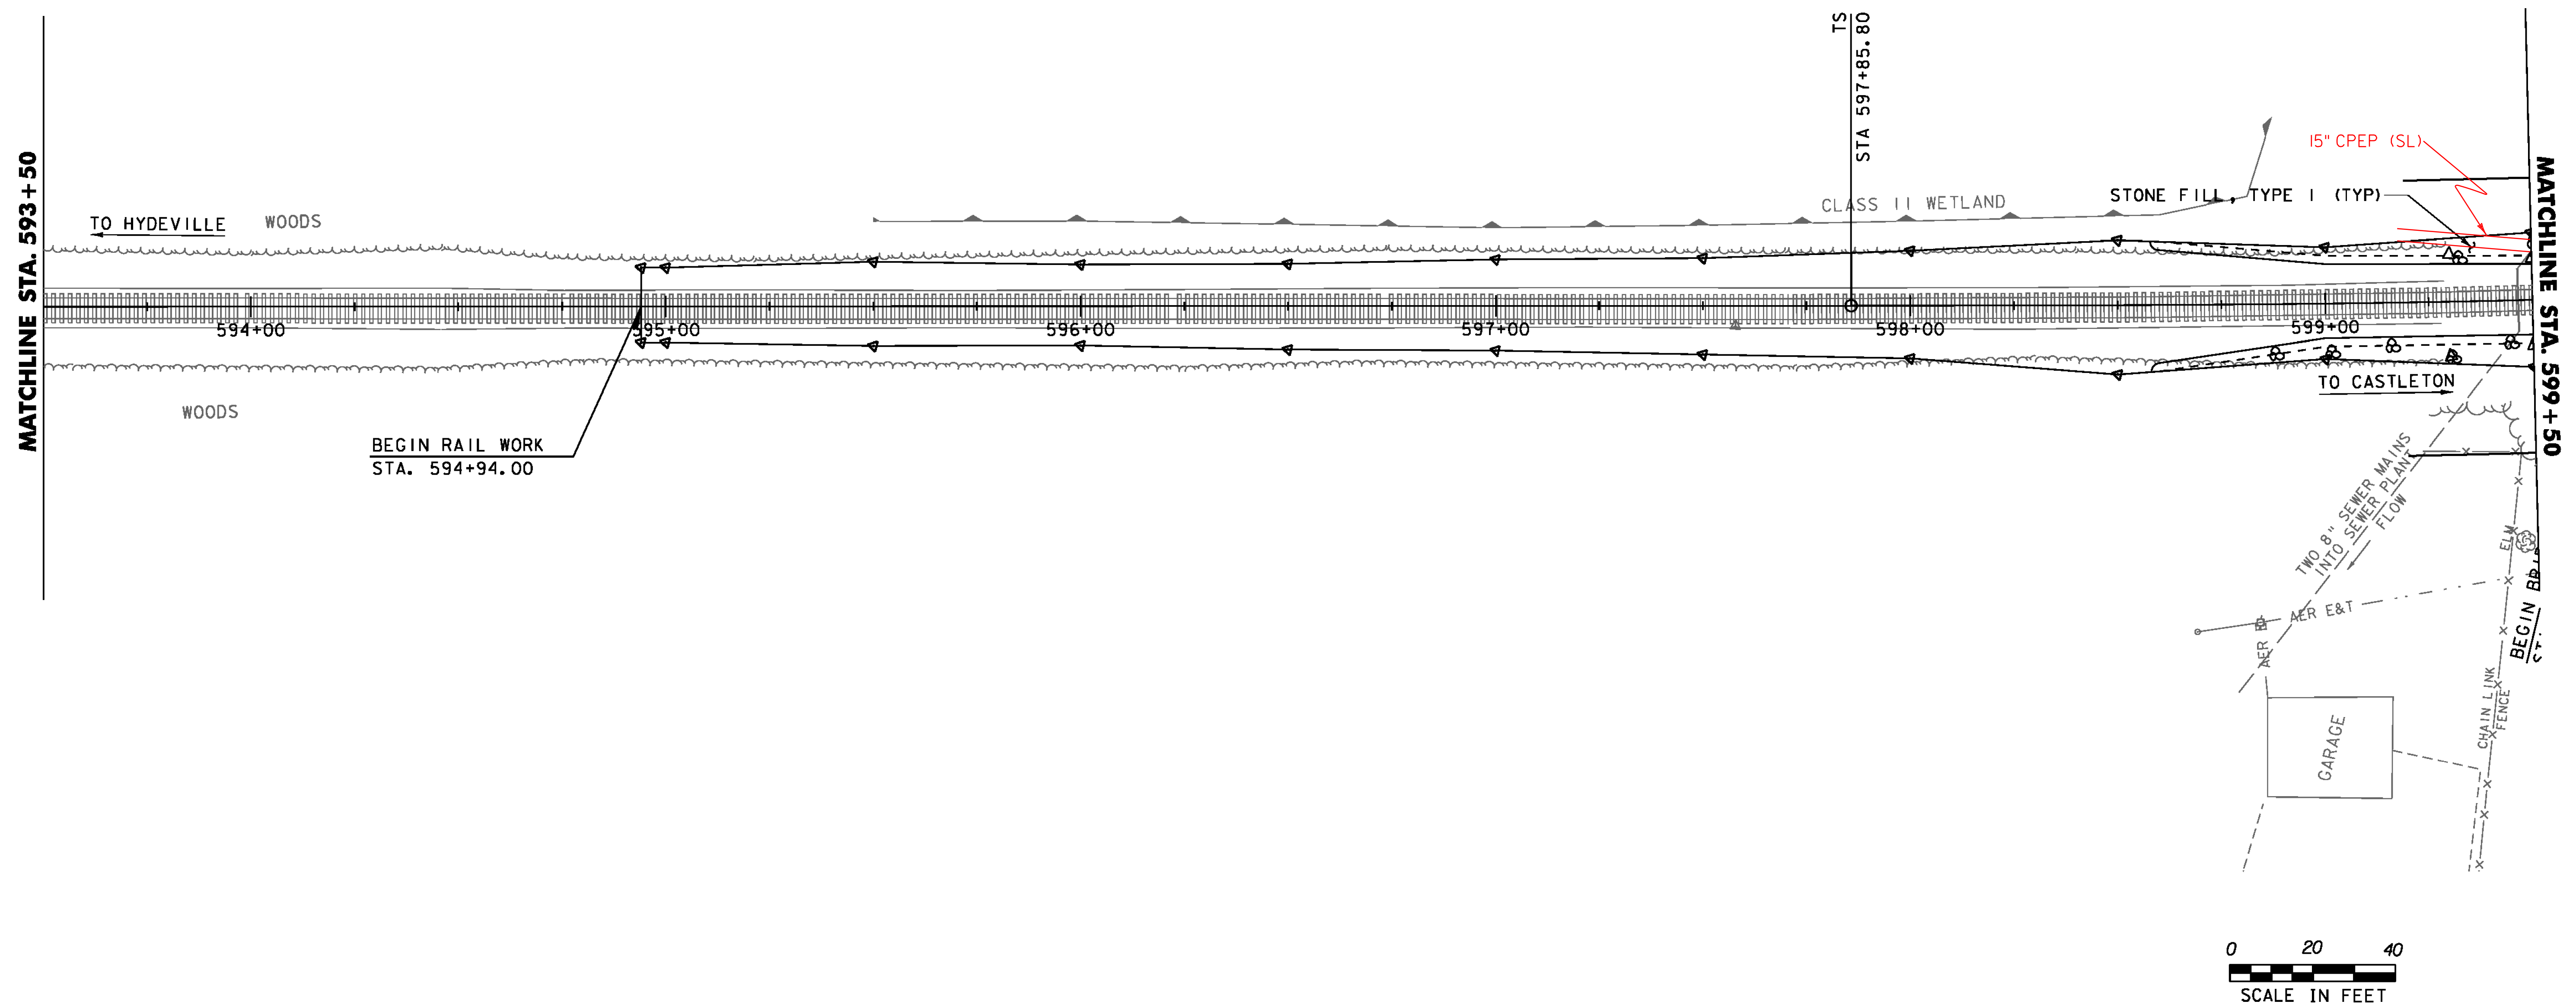

PROJECT NAME:	CASTLETON
PROJECT NUMBER:	BRF 015-2(10)
FILE NAME:	z12b138bdr_nul.dgn
PROJECT LEADER:	S.E. BURBANK
DESIGNED BY:	E.A. FIALA
RAIL LAYOUT SHEET (2 OF 4)	
PLOT DATE:	9/19/2014
DRAWN BY:	E.A. FIALA
CHECKED BY:	S.E. BURBANK
SHEET	19 OF 82

